




PLAN VIEW

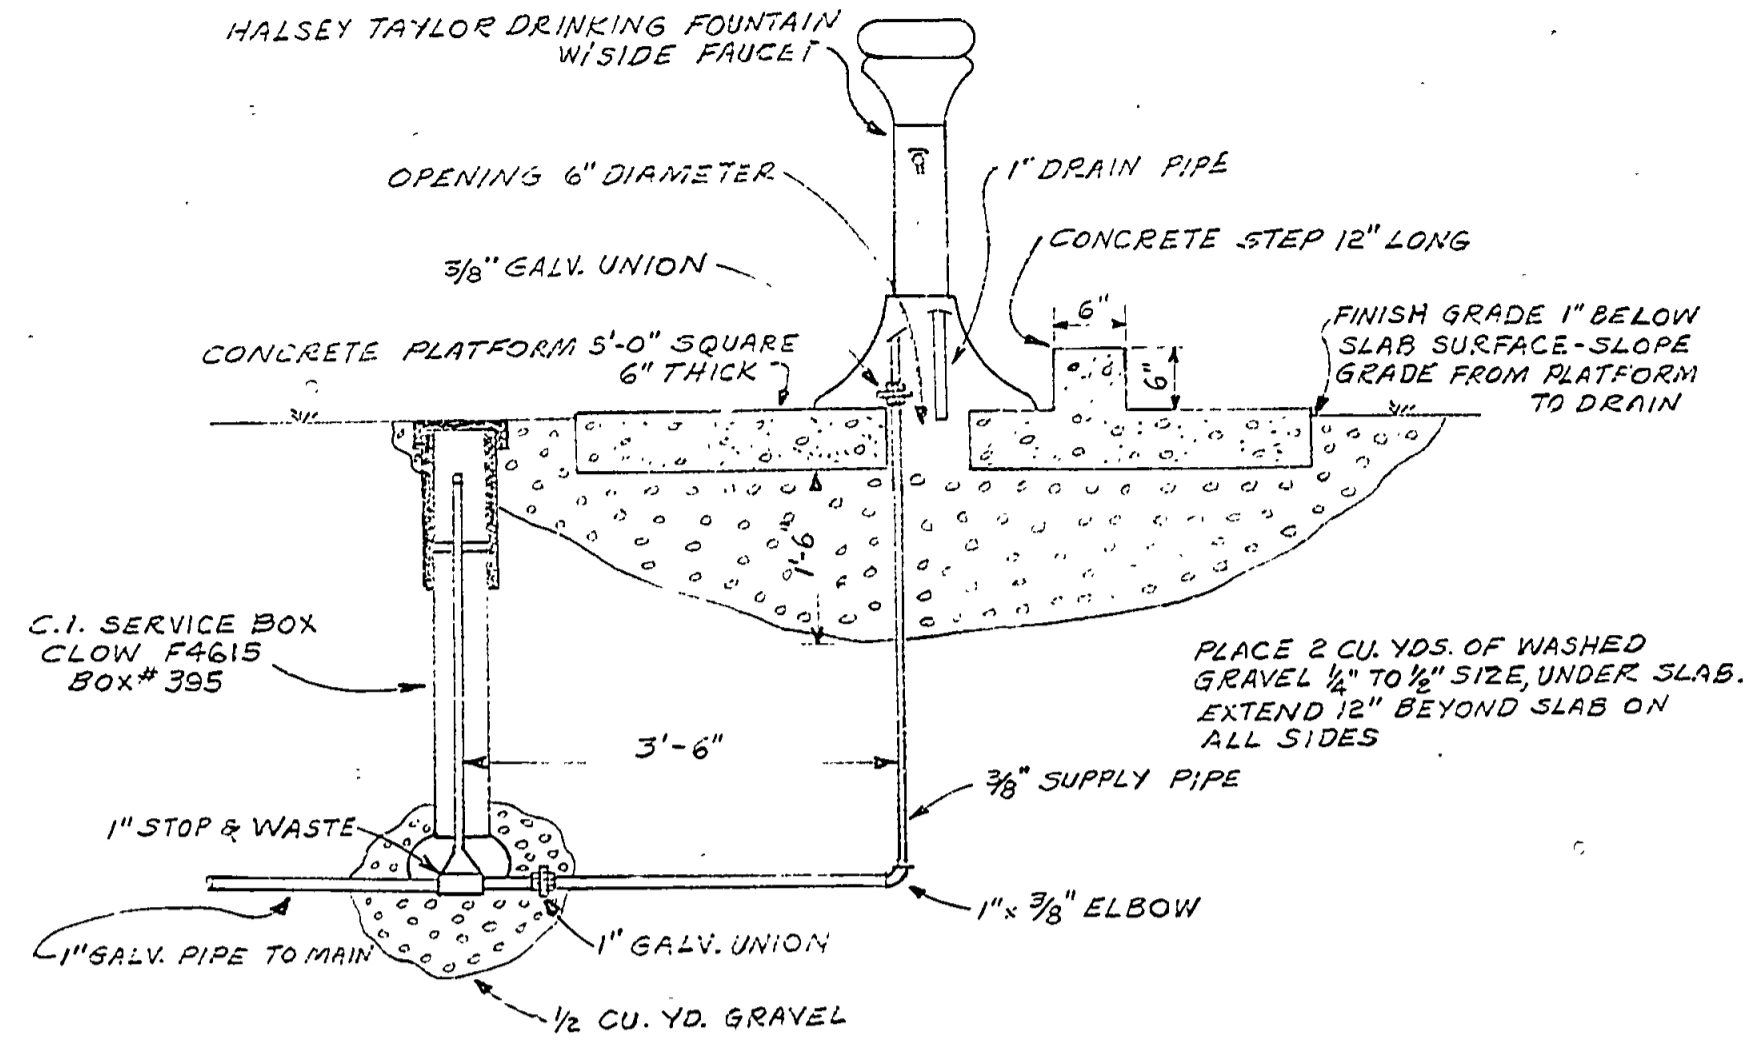


DRINKING FOUNTAIN DETAIL NOT TO SCALE

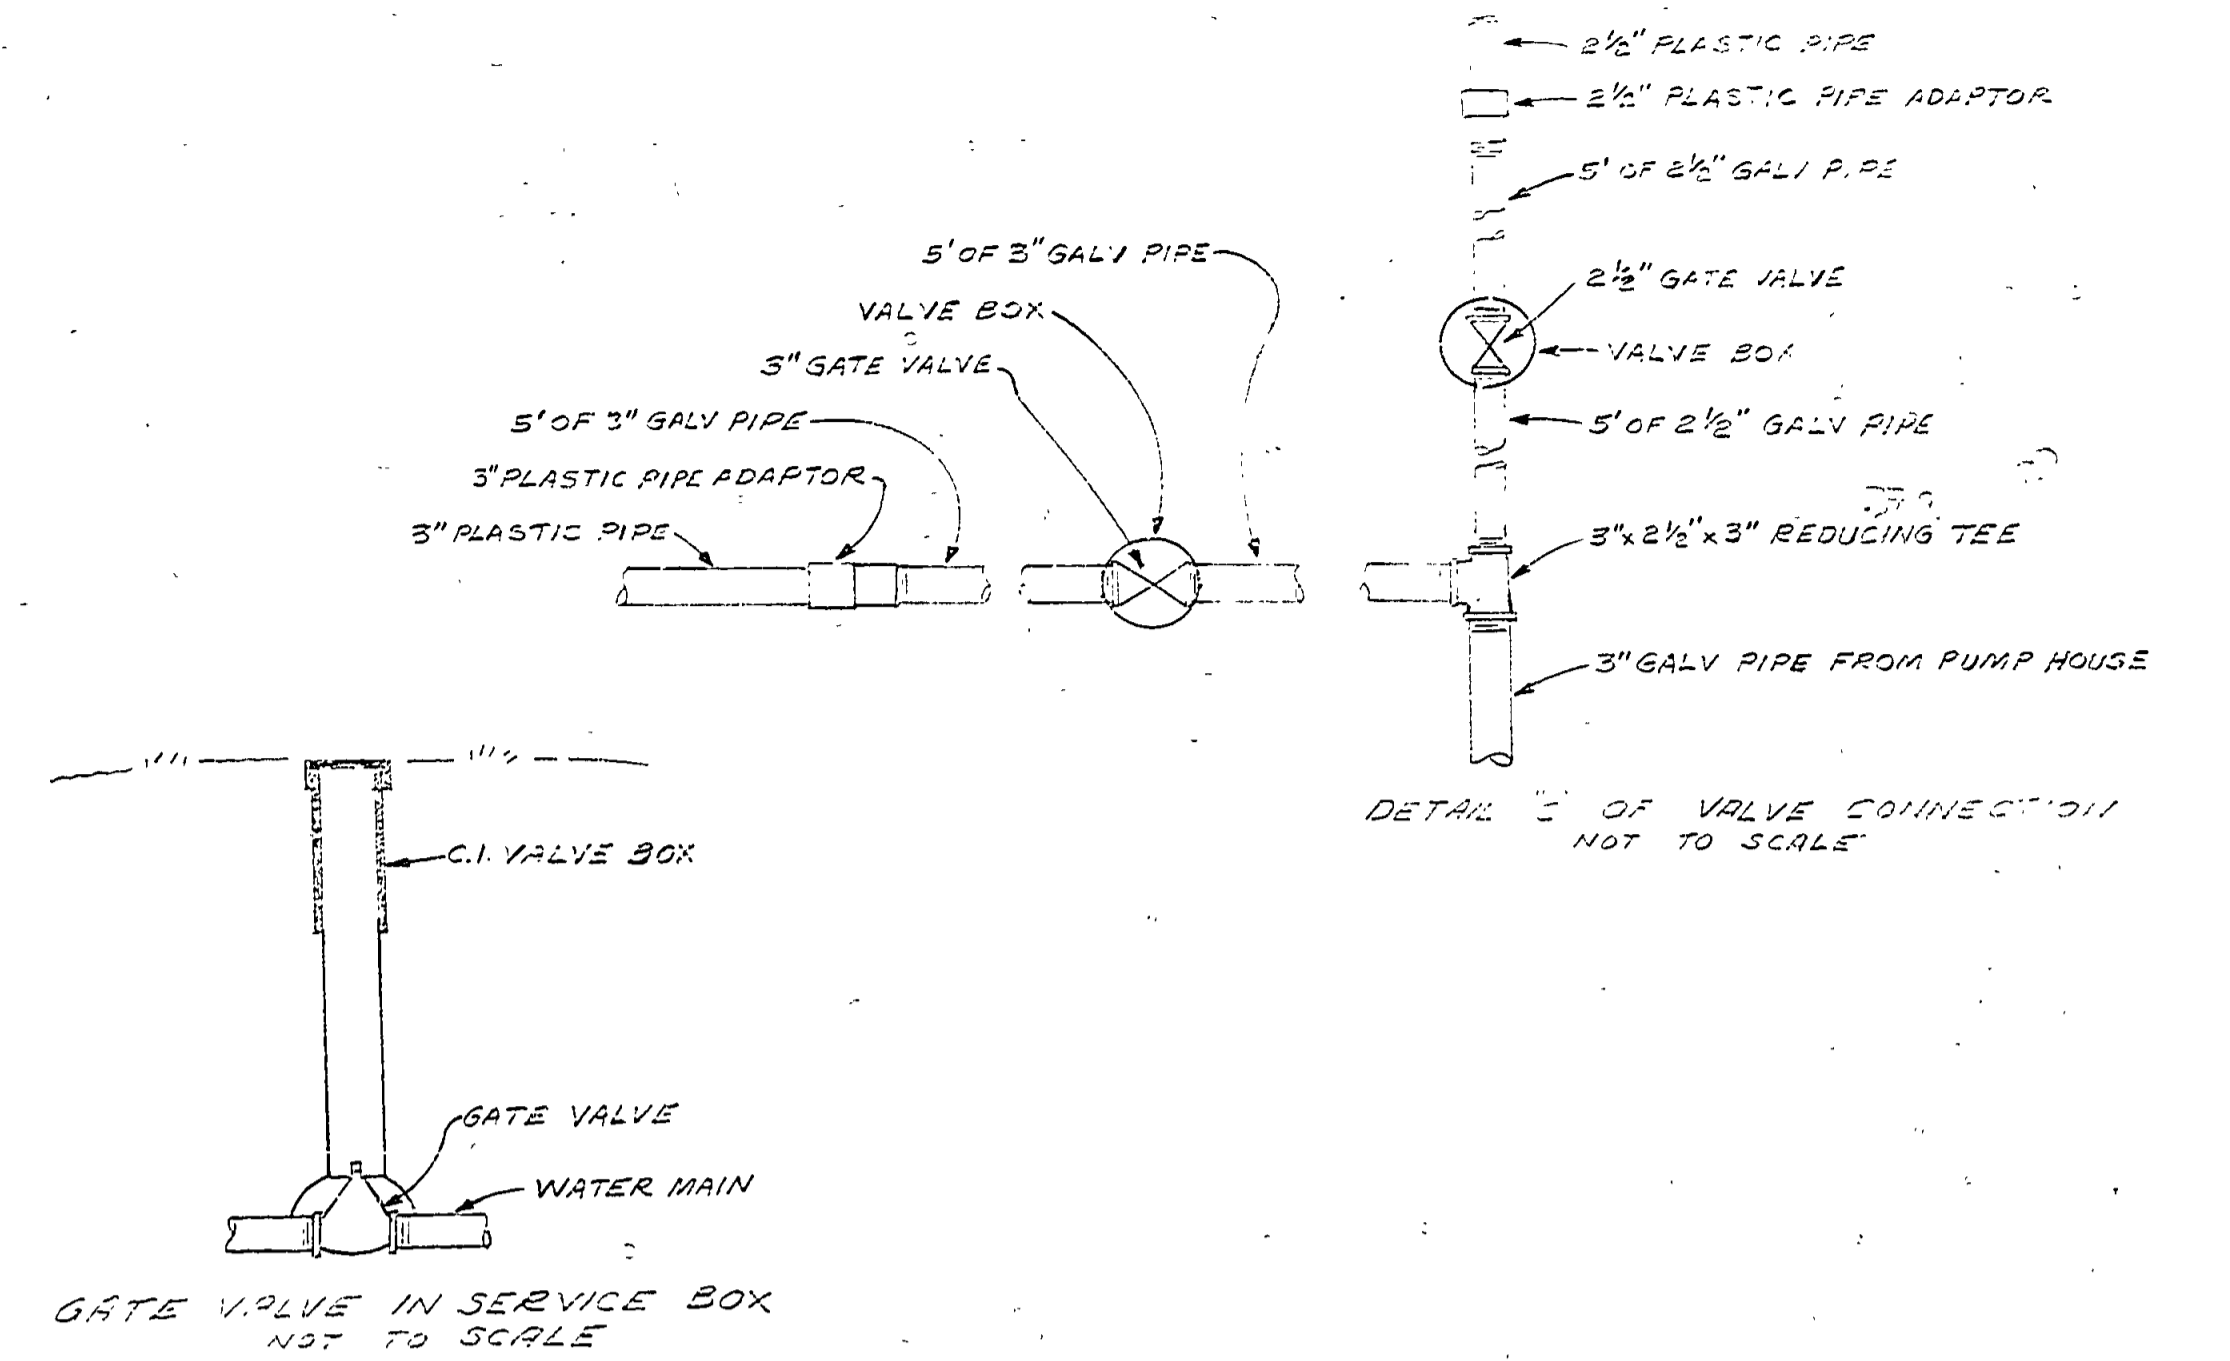


GATE VALVE IN SERVICE BOX NOT TO SCALE

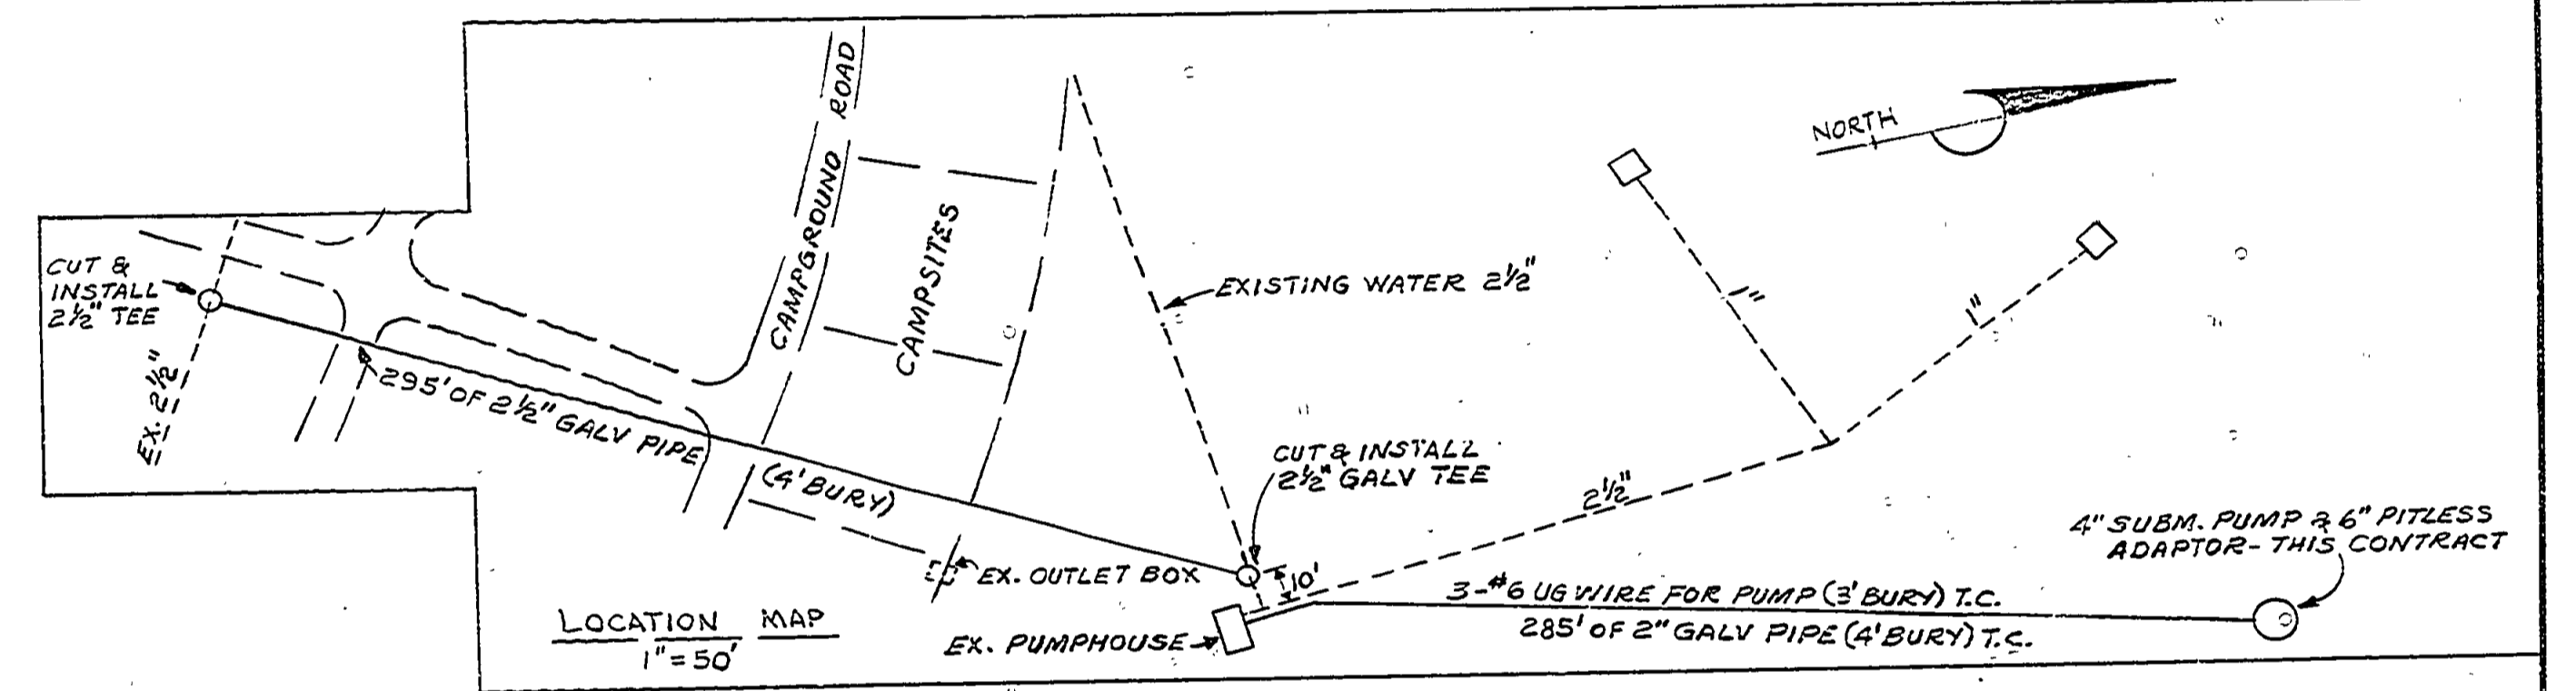


LOCATION MAP 1\"/>

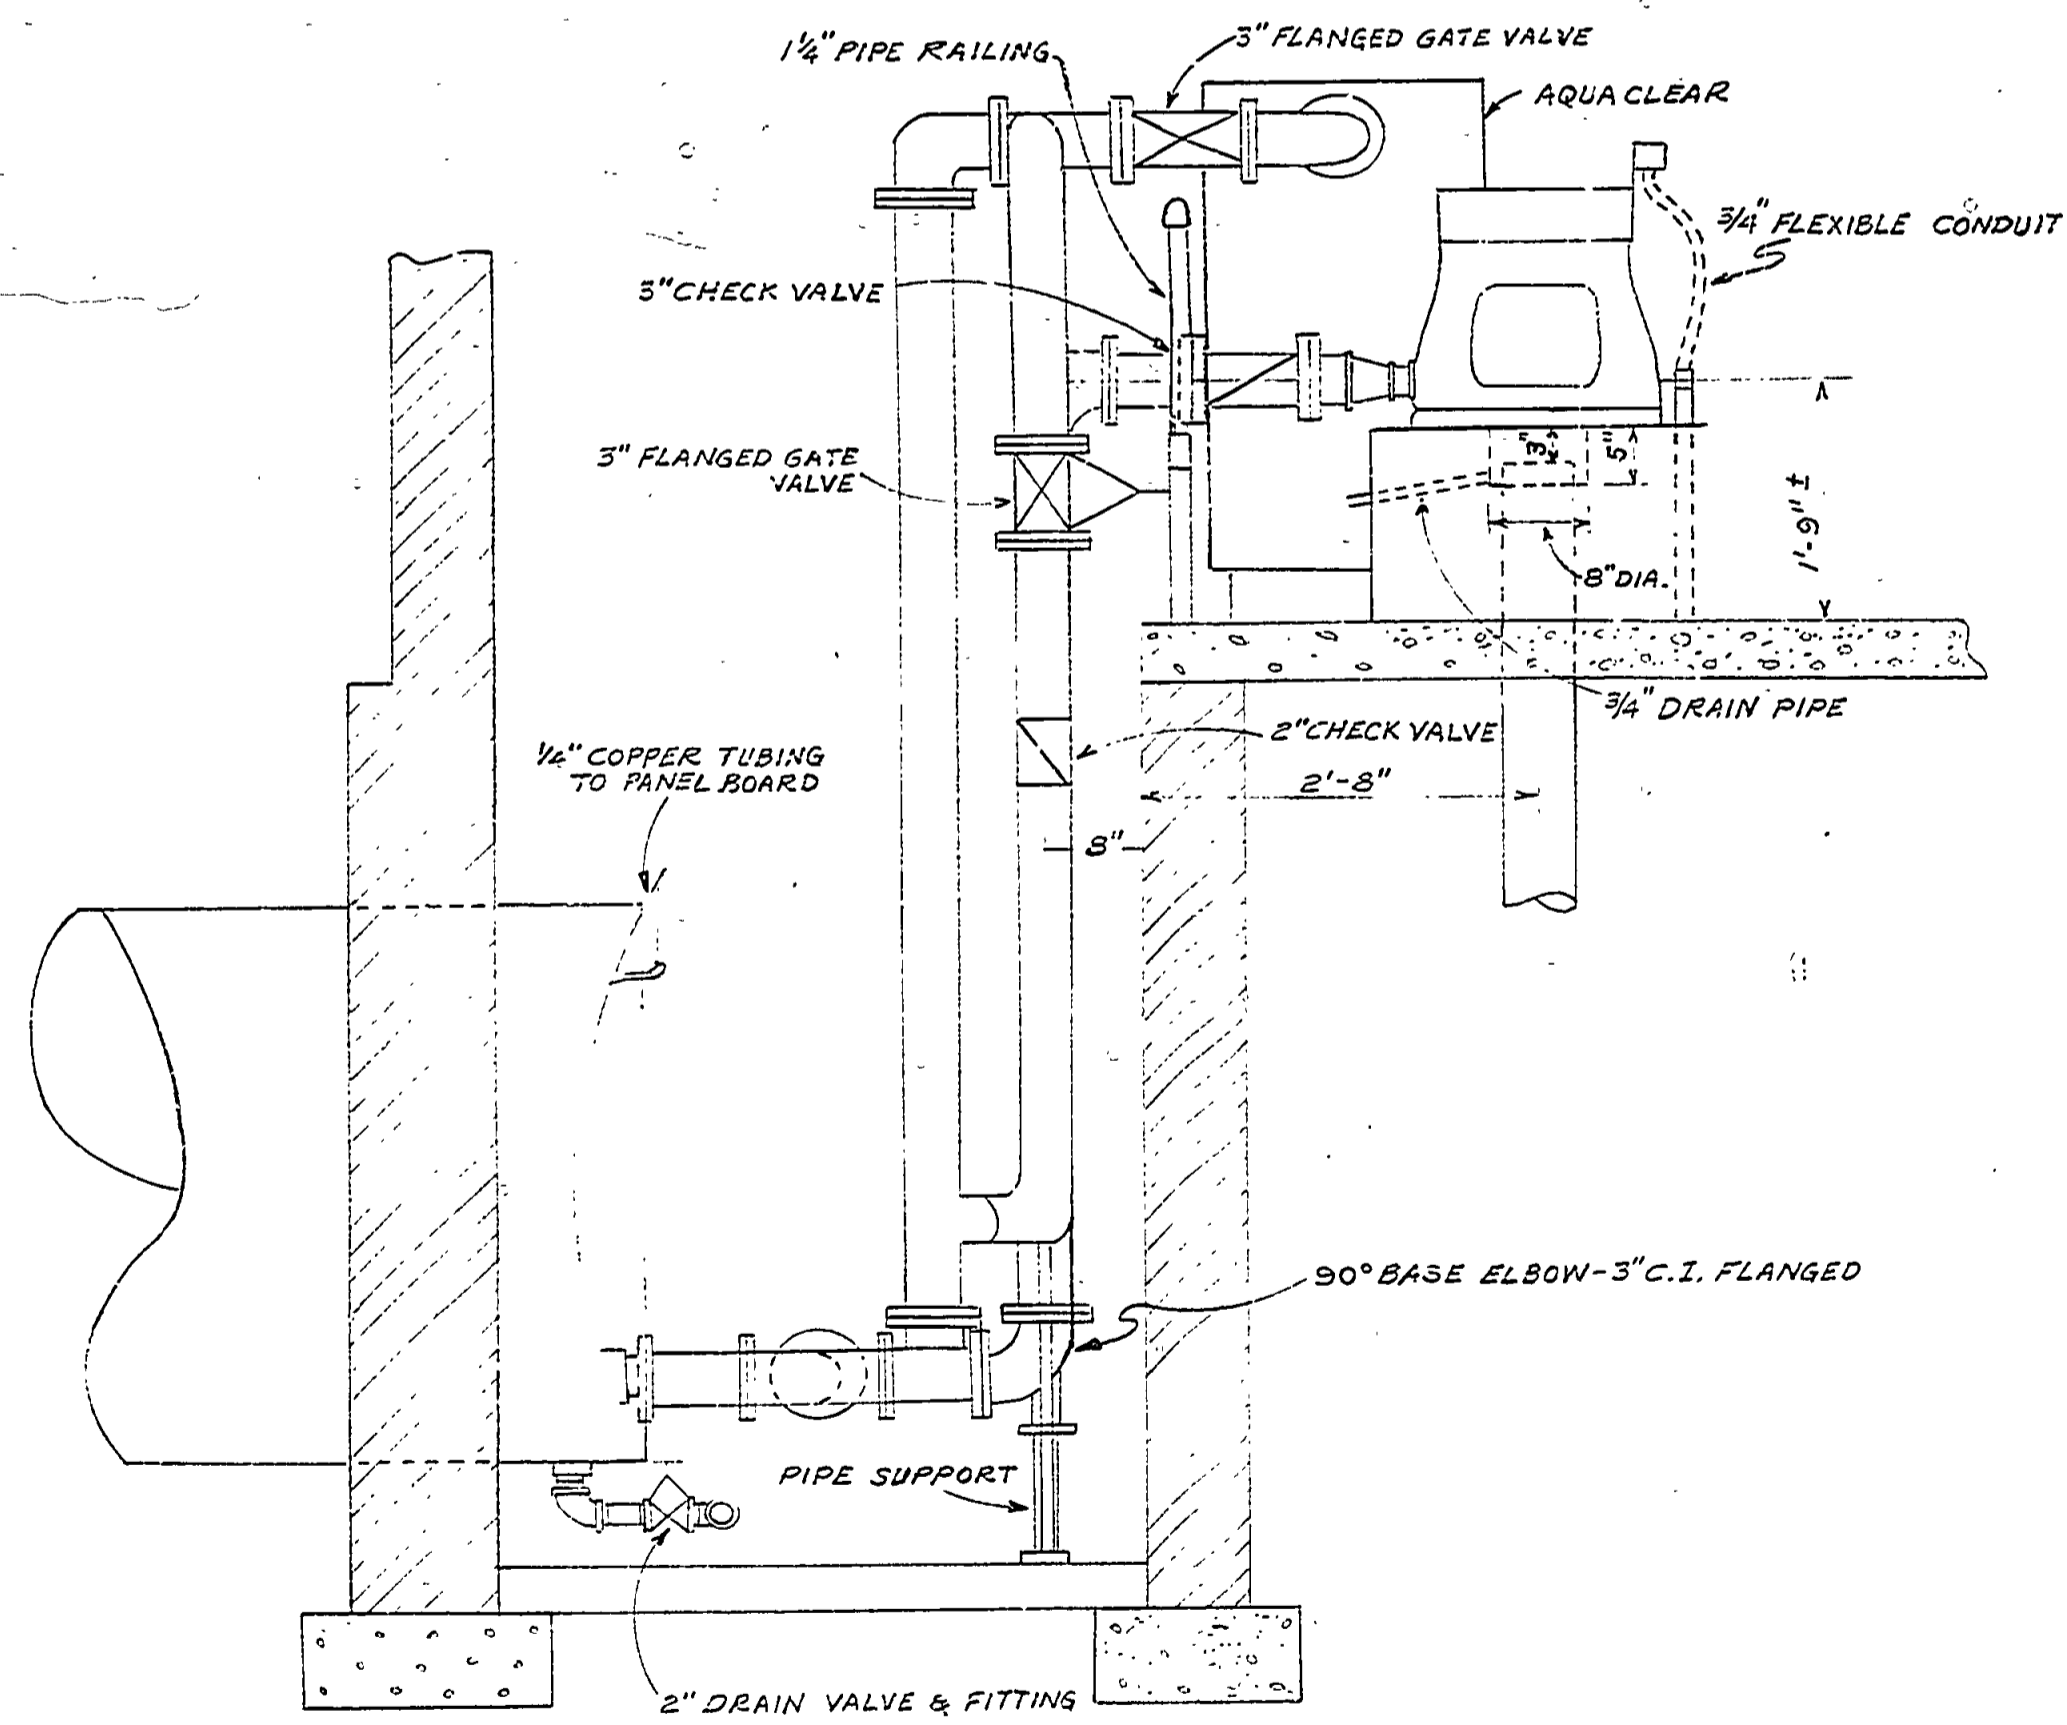

SECTION A-A

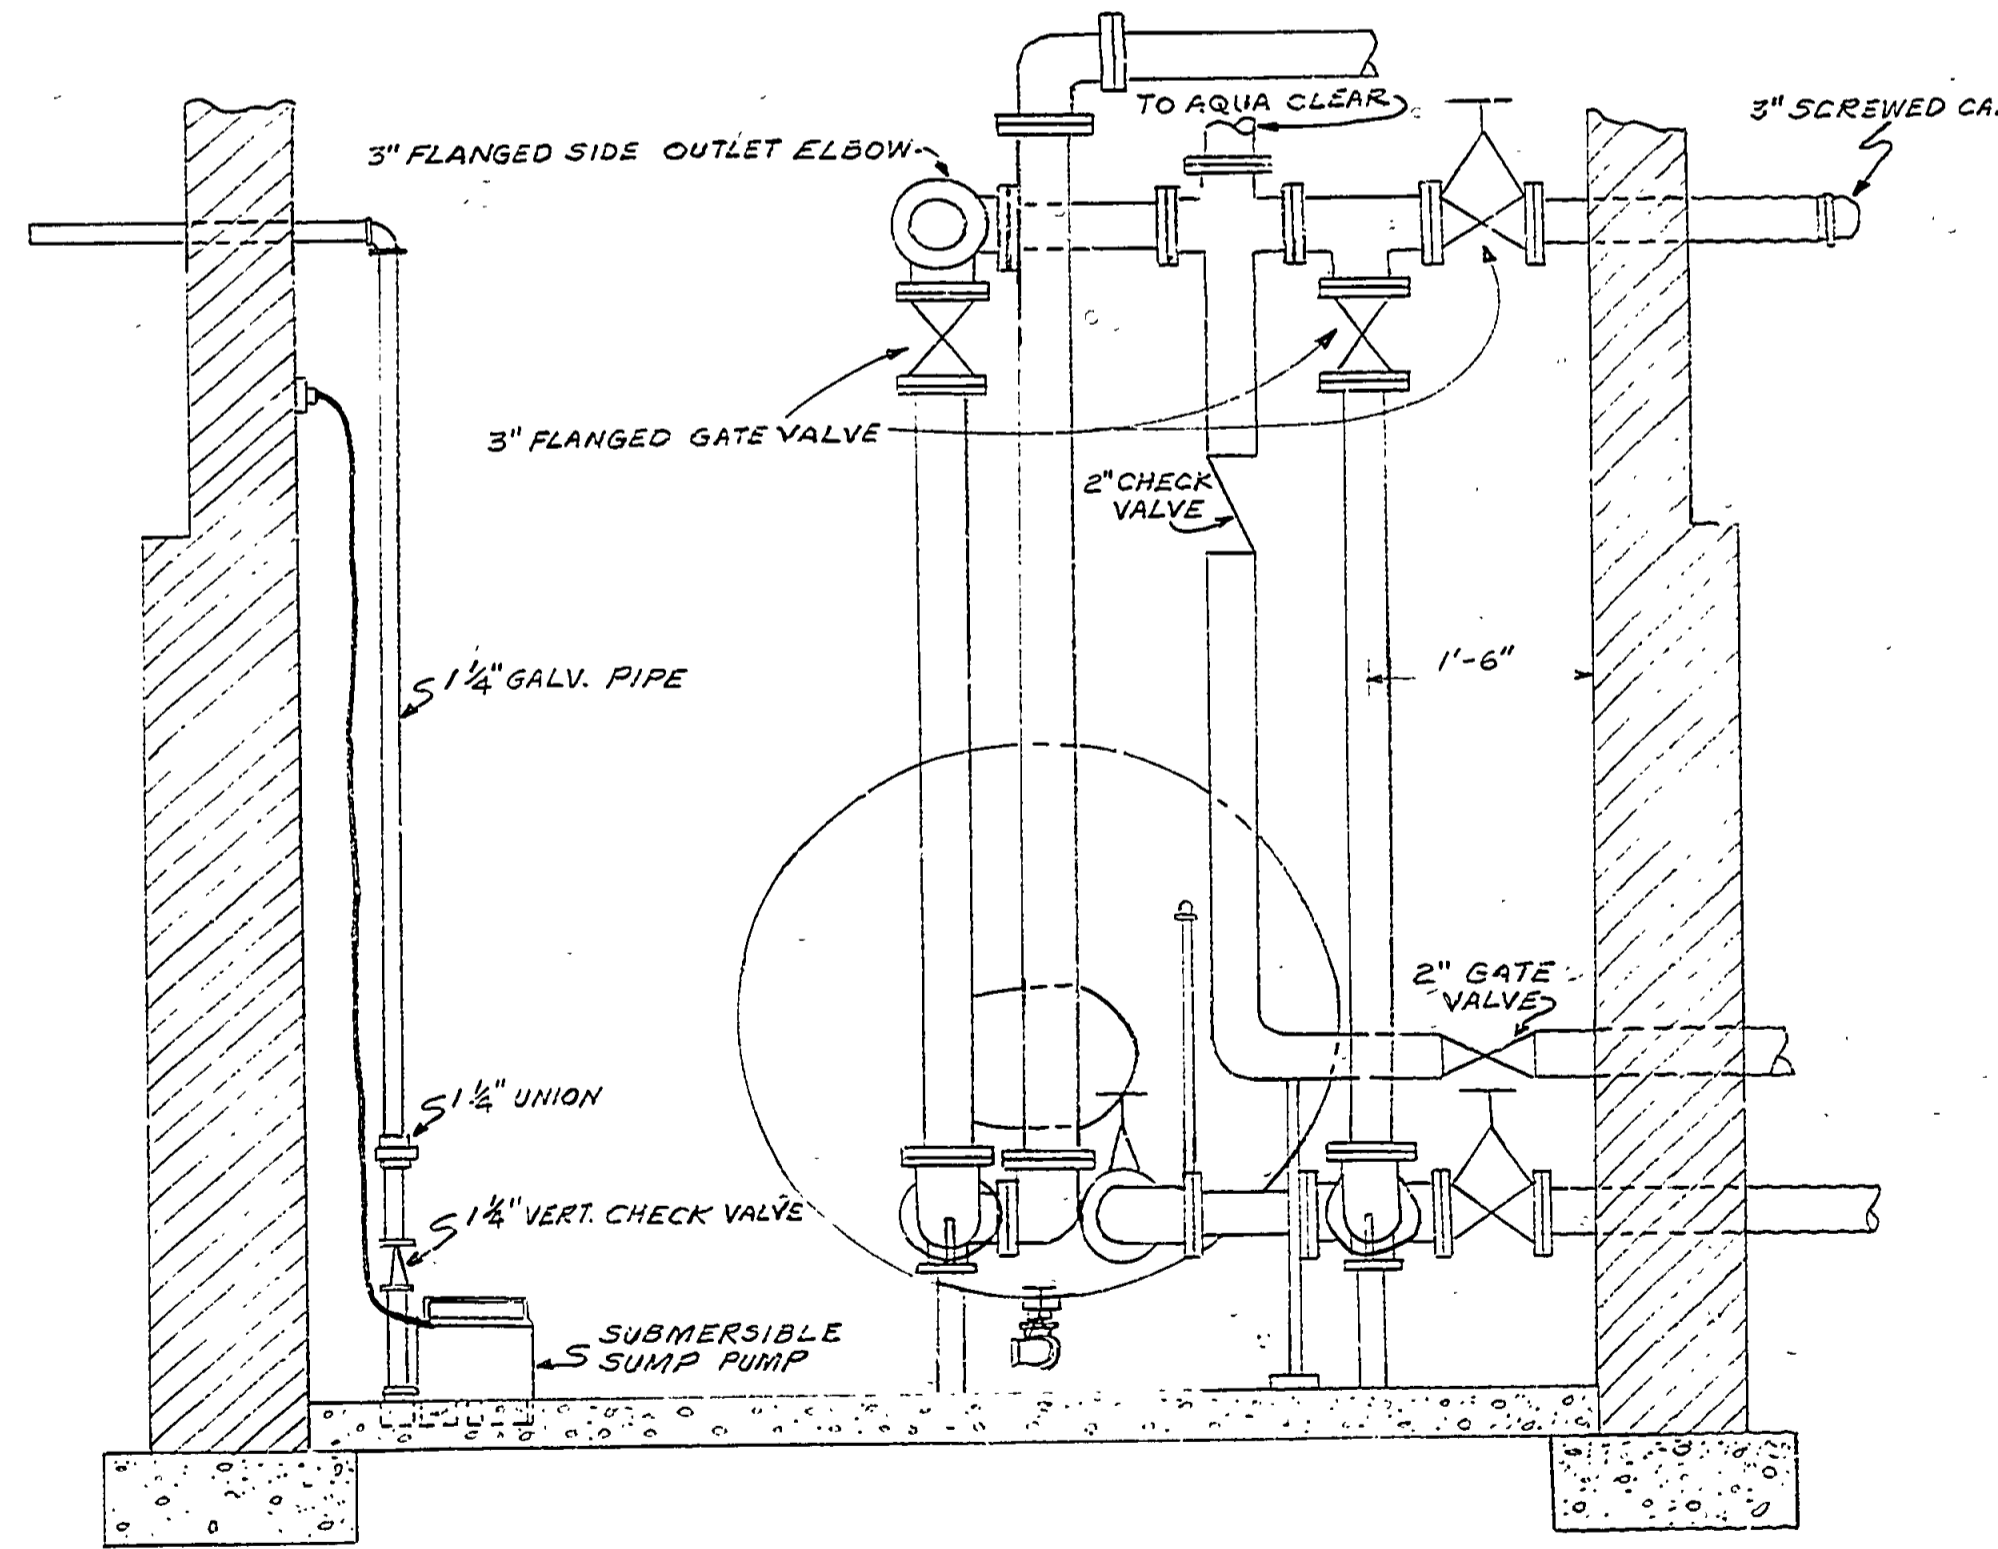

SECTION B-B

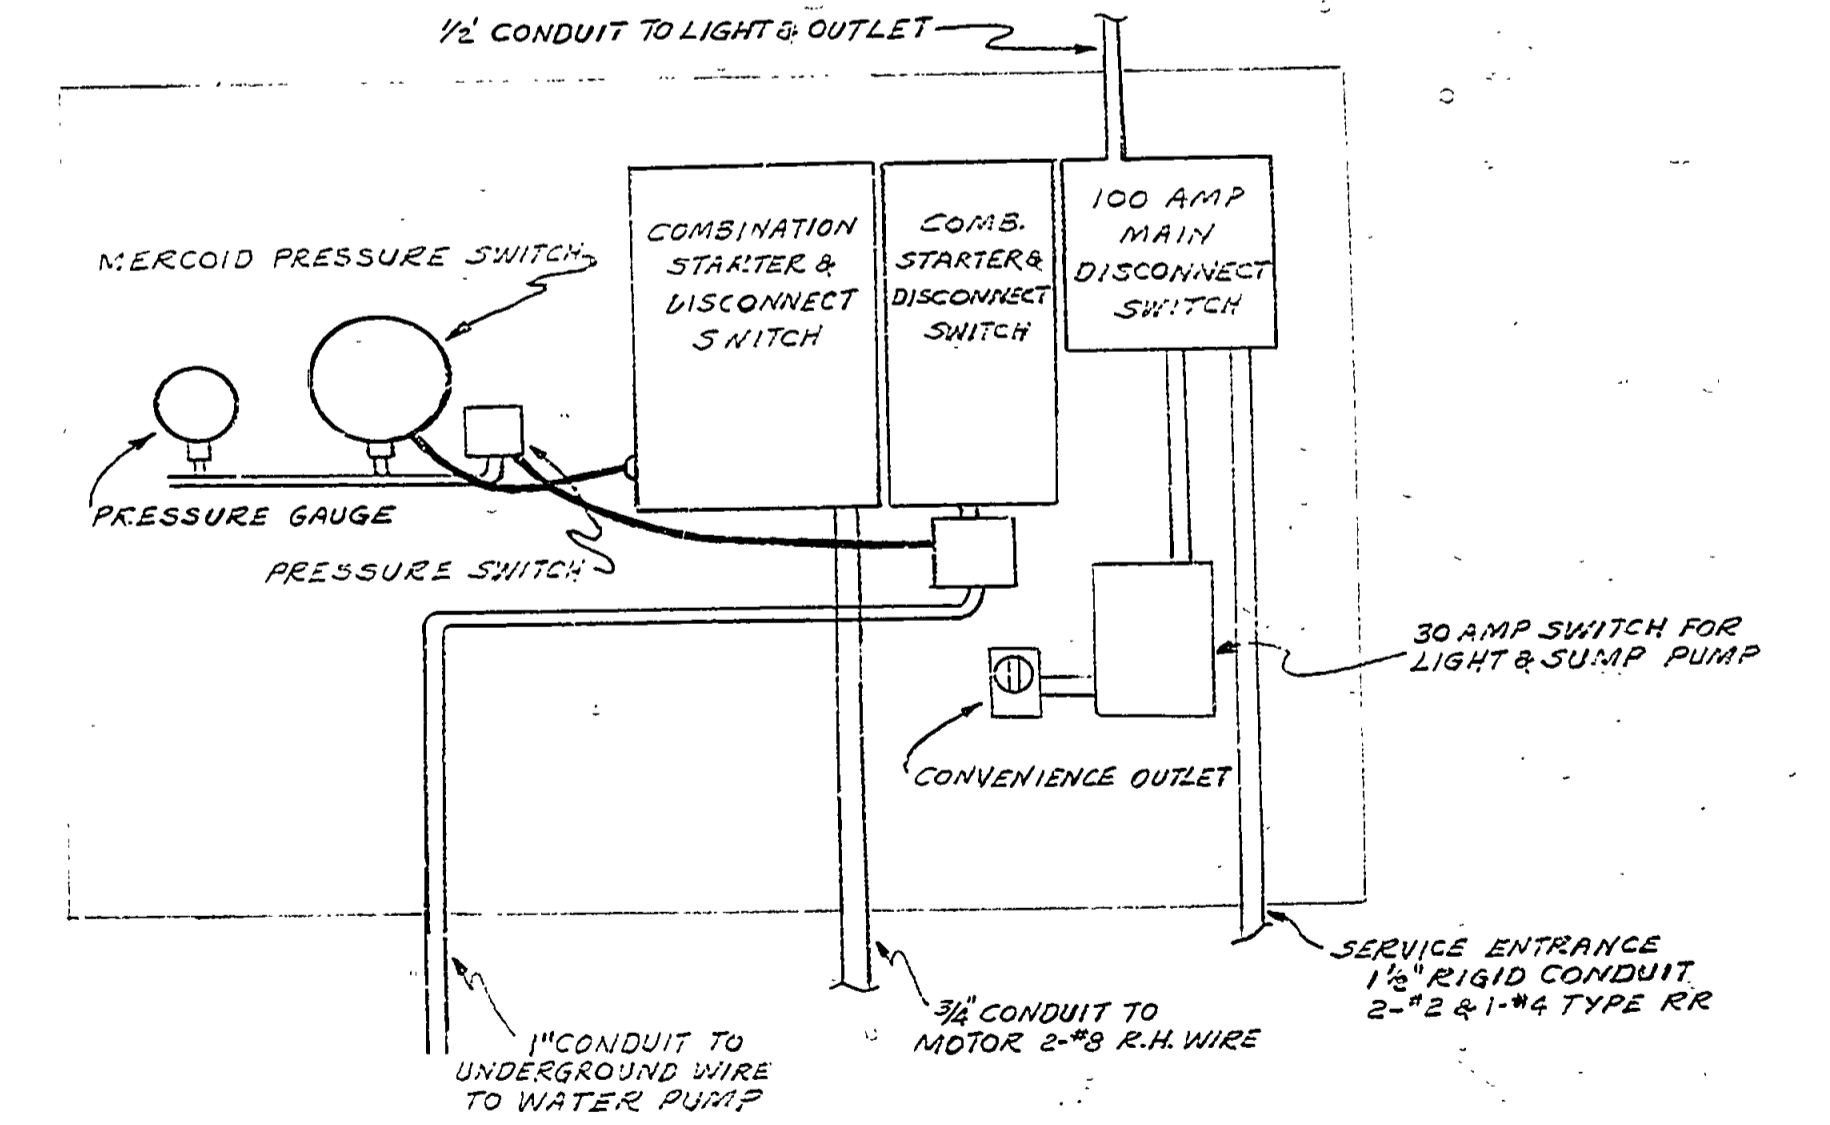

SWITCH PANEL BOARD SCALE 1/2\"/>

SURVEYED BY		DRAWN BY R.C. BENNETT		NO. DATE BY		REVISIONS		NO. DATE BY		REVISIONS		MICHIGAN DEPARTMENT OF NATURAL RESOURCES		WATER SYSTEM - PUMPHOUSE		VAN RIPER STATE PARK		PROJECT NO.	
DESIGNED BY		CHECKED BY E.J.R.		1-30-57 1. 9-71 D.B.		REDRAWN TO AS BUILT PLANS (12-15-69)		3.				DEPARTMENT OF NATURAL RESOURCES		SHEET TITLE		AREA OR PARK		SHEET 4 OF 4	
DATE		DATE		2.		Replaces sheet 3 of 4 Plan E-109		4.				PROJECT		PLAN NO. E-101					