



**muskallonge lake state park : toilet & shower building**  
**work completed under contract no. 24-1472 : may 1974**



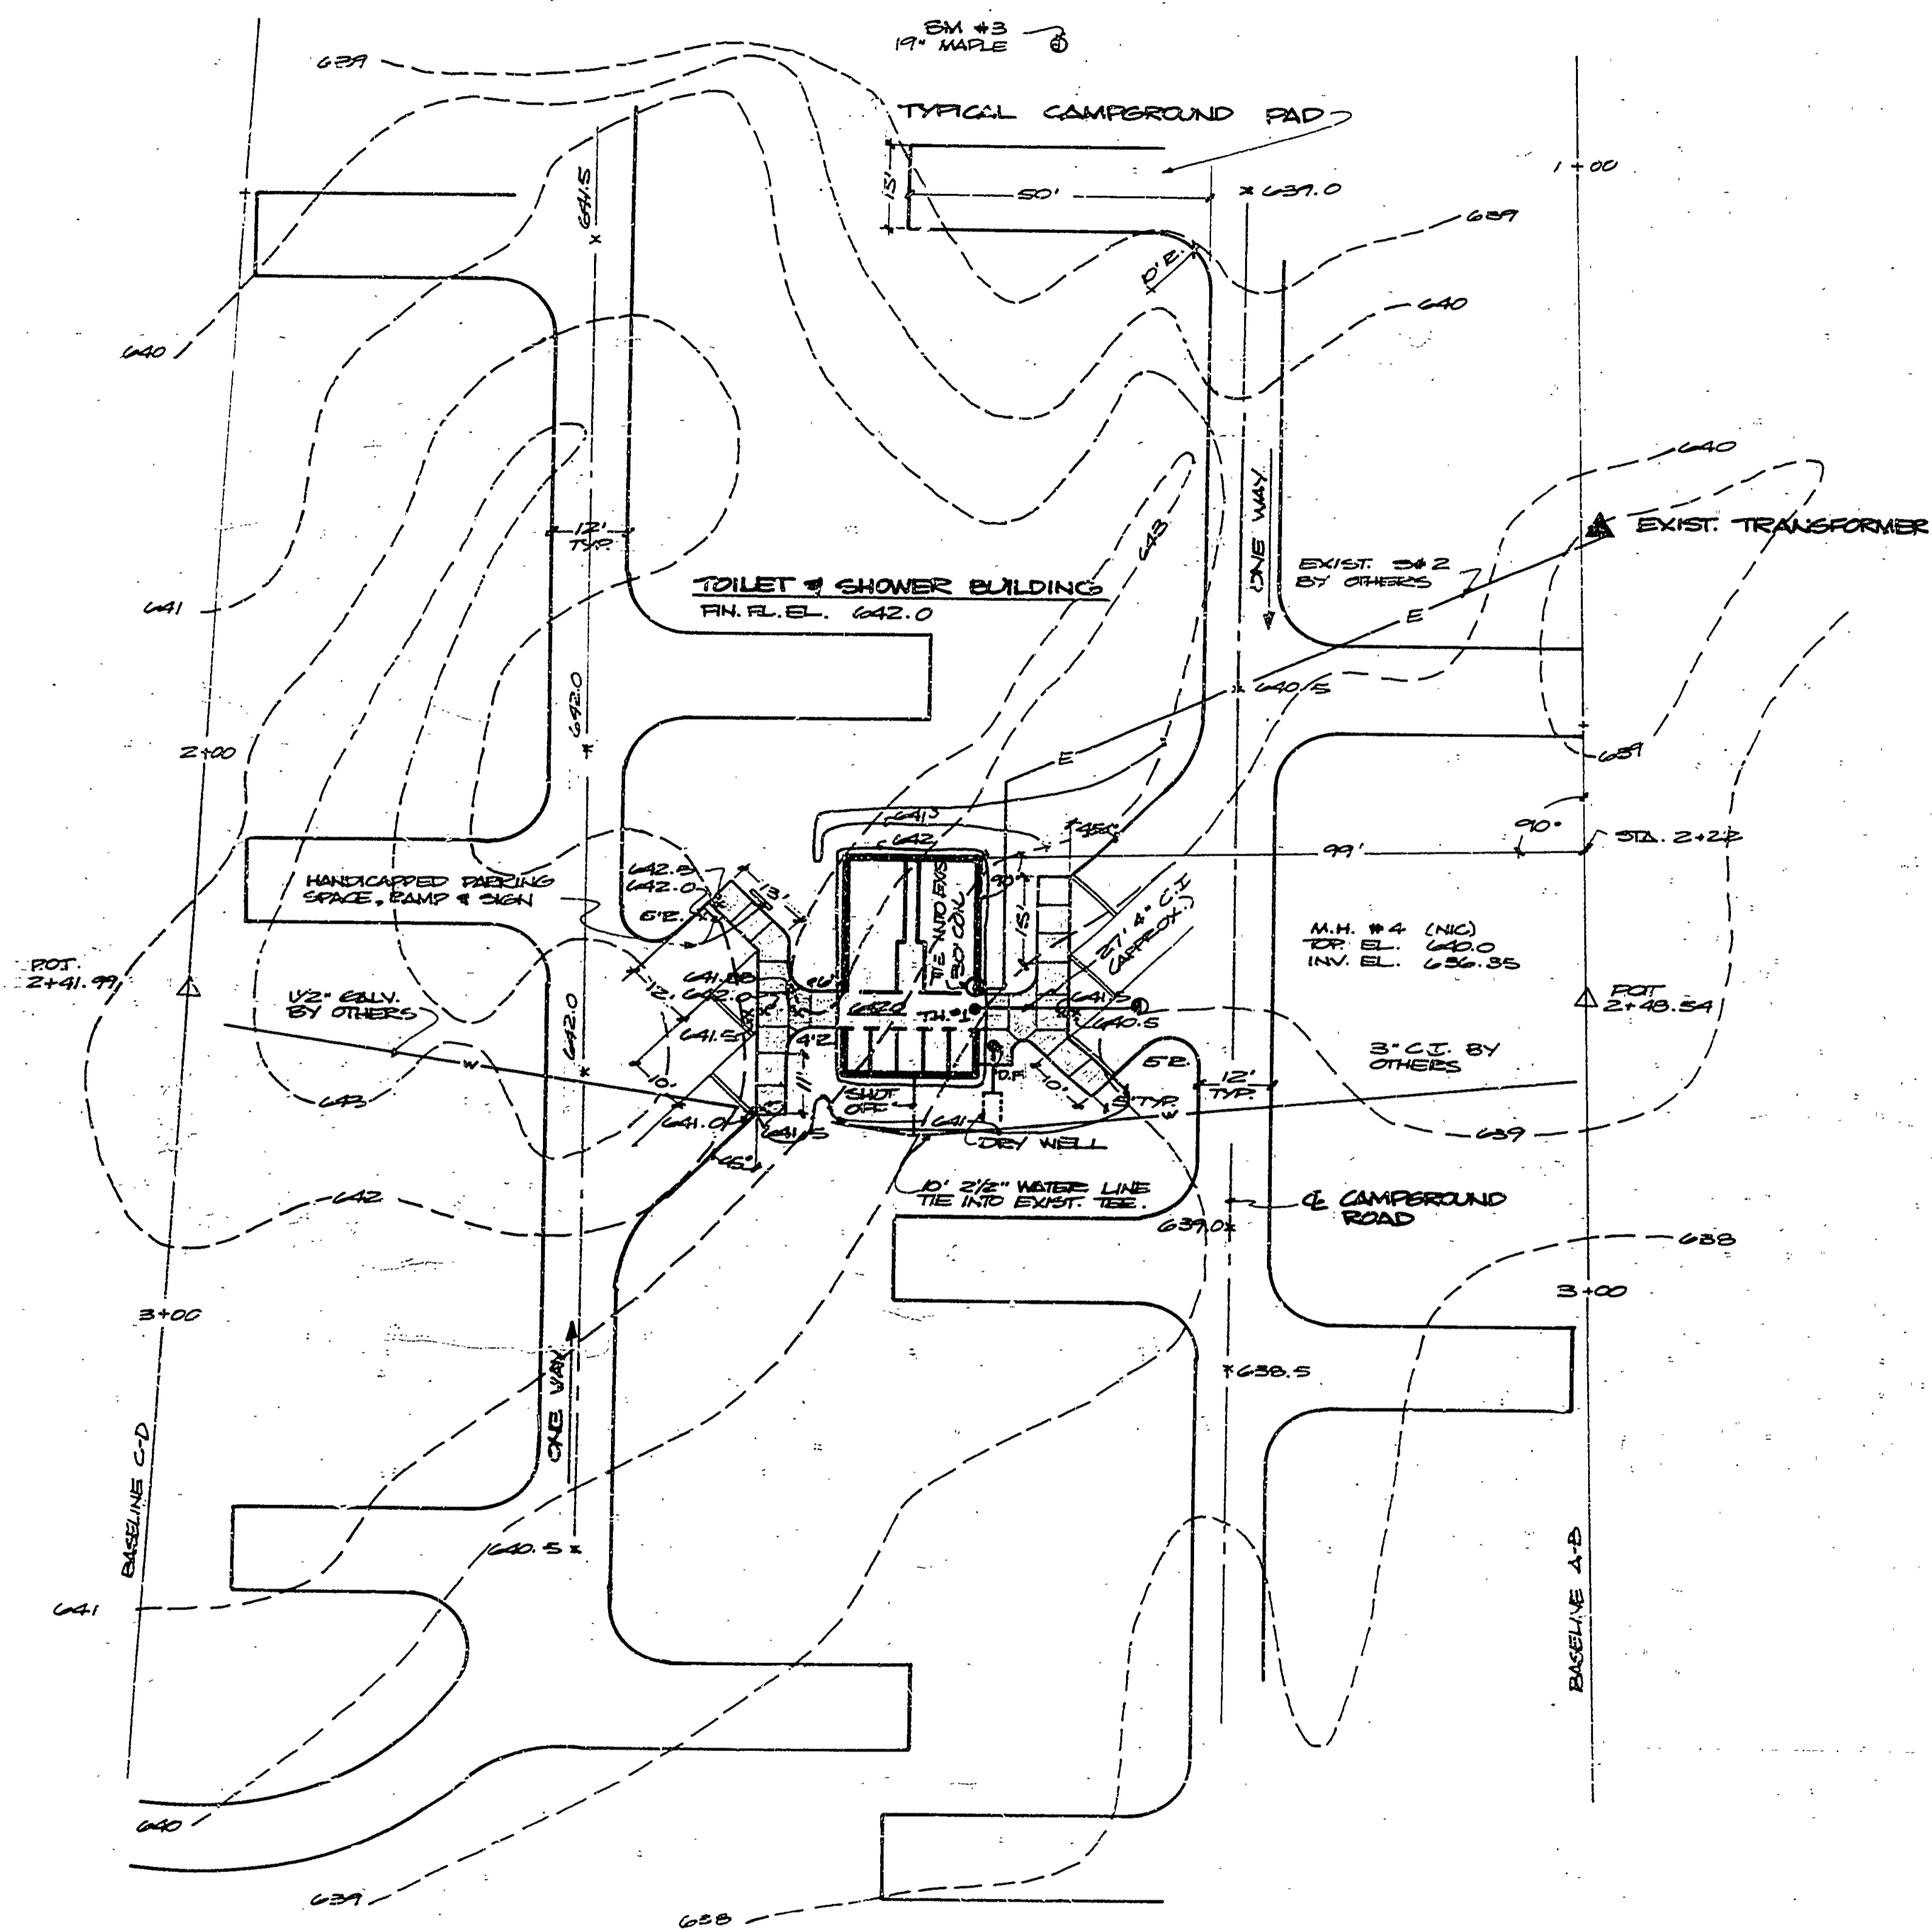


**site plan**  
**scale : 1 in. = 20 ft.**


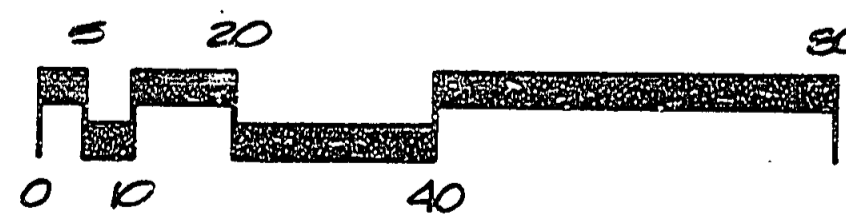


**north**

**elevations**

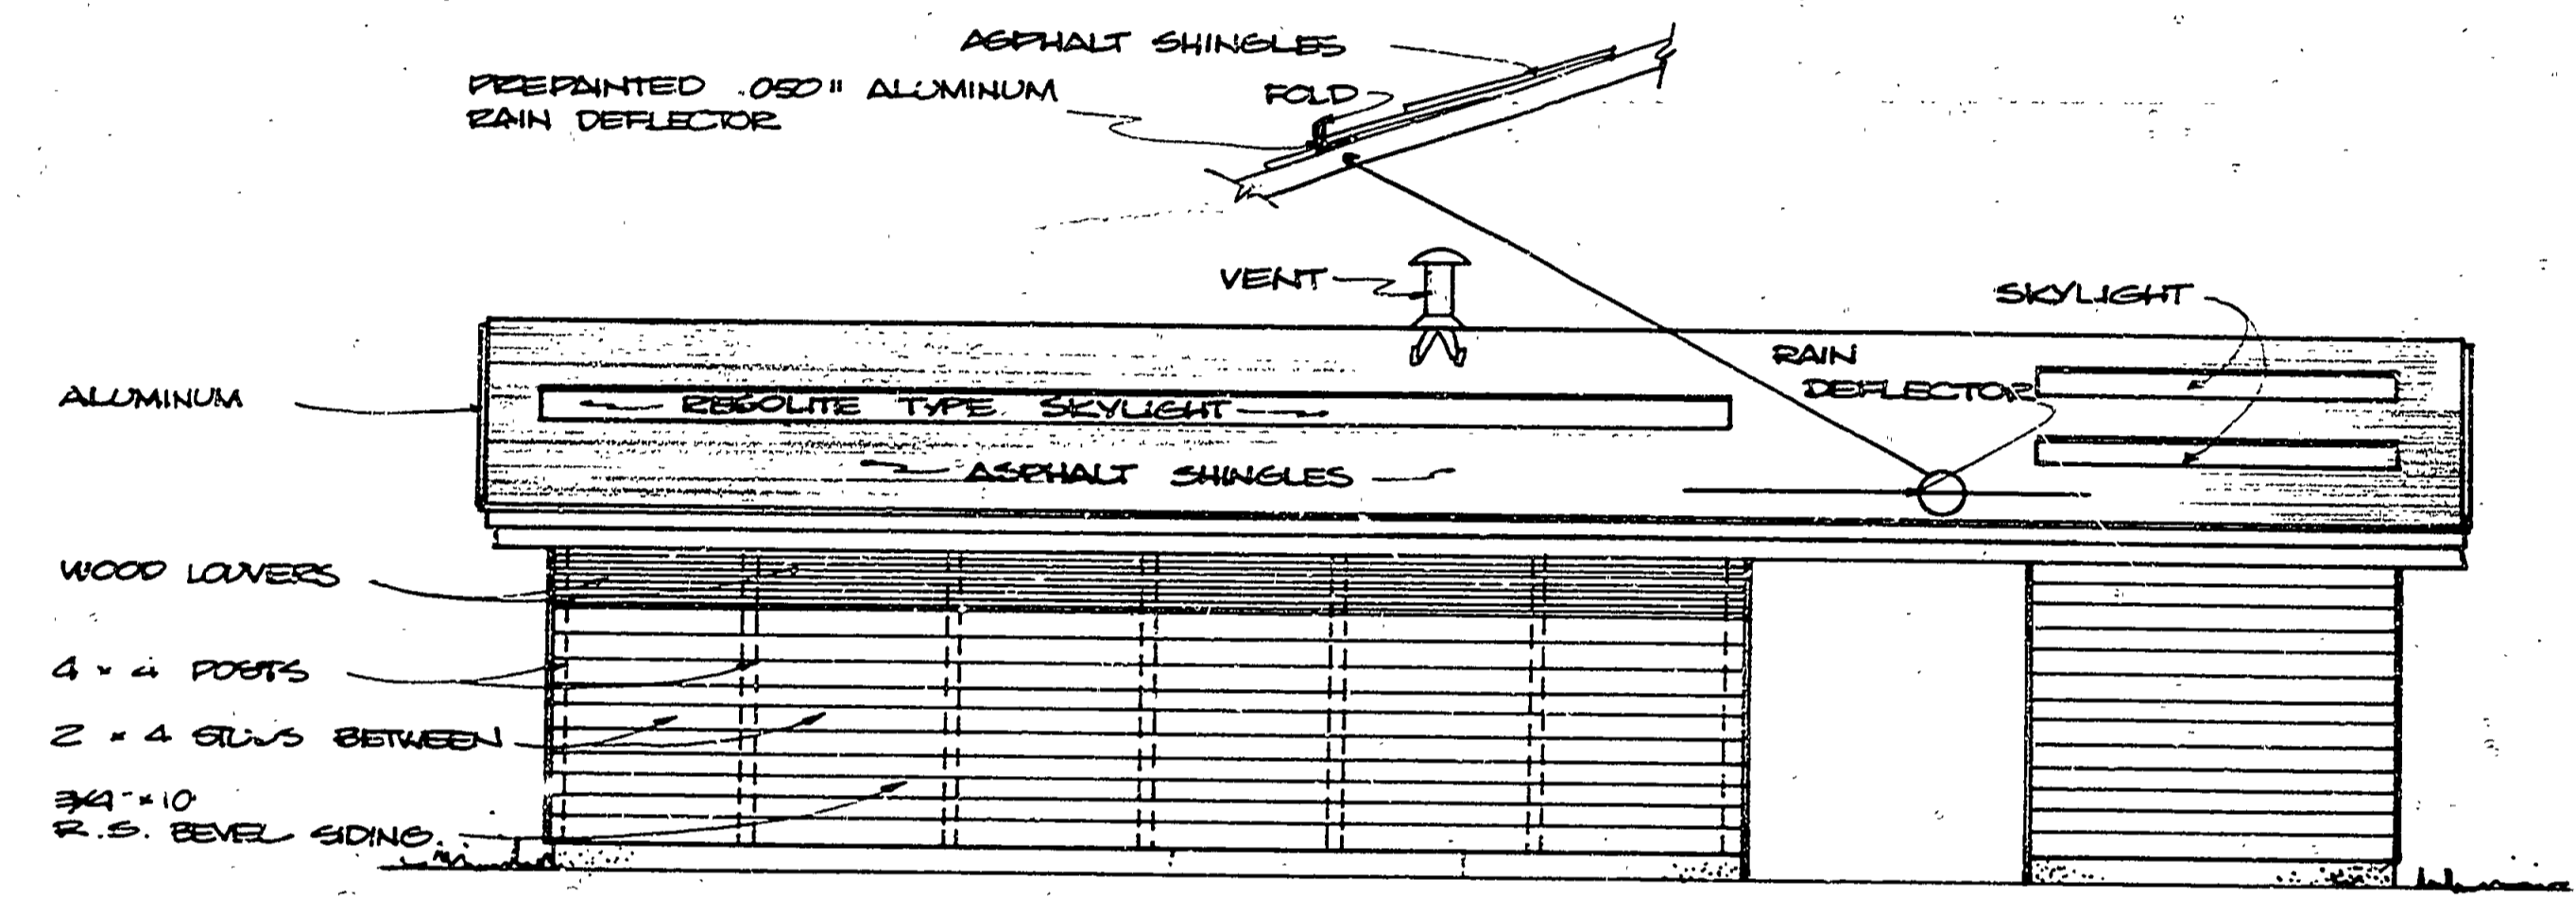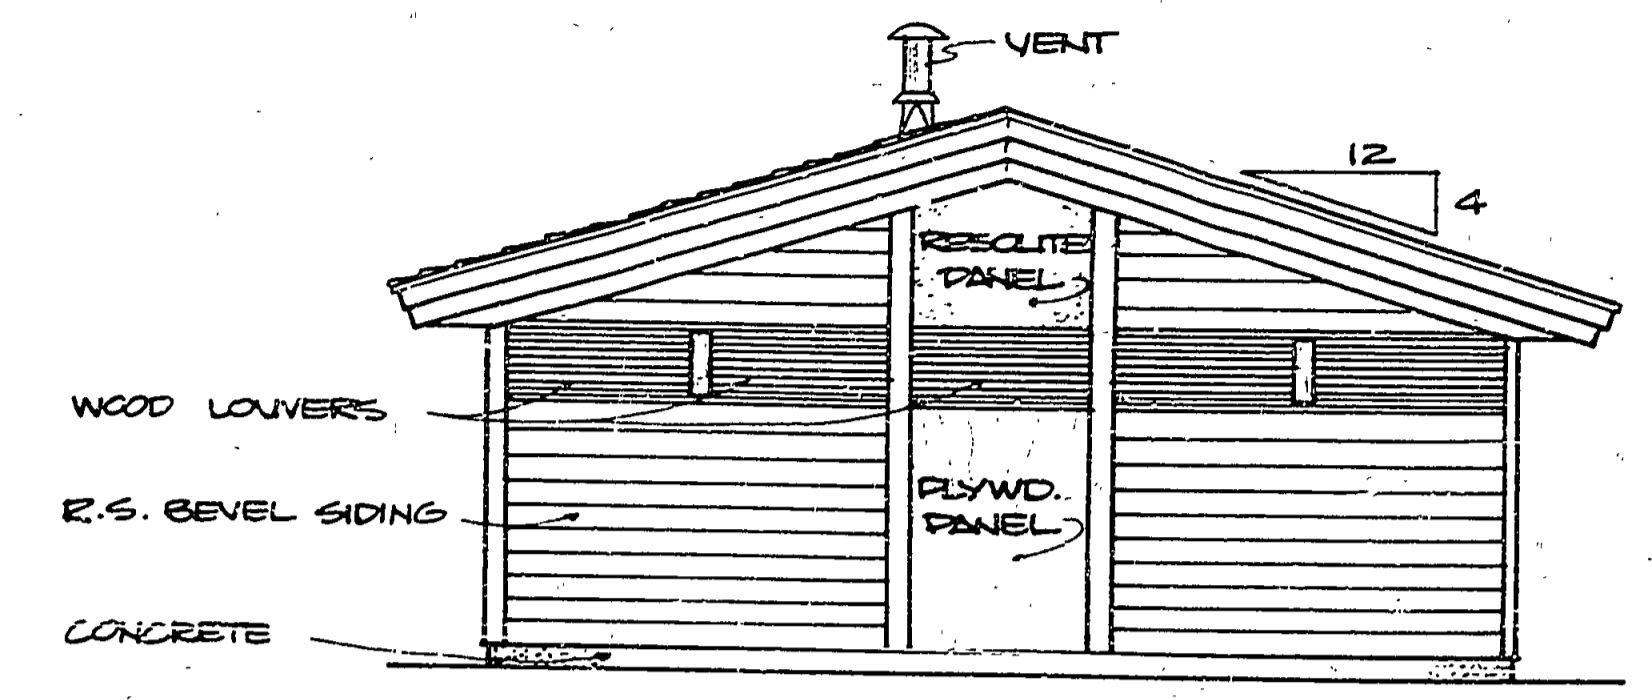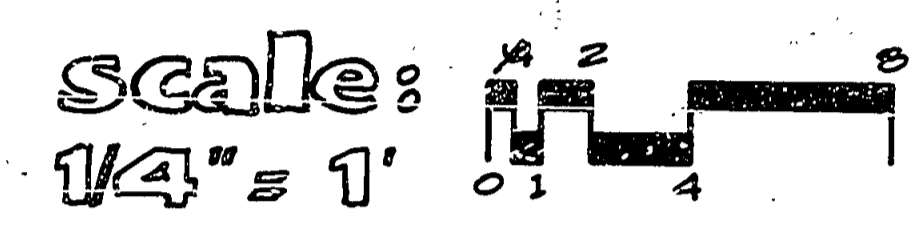

**floor plan**

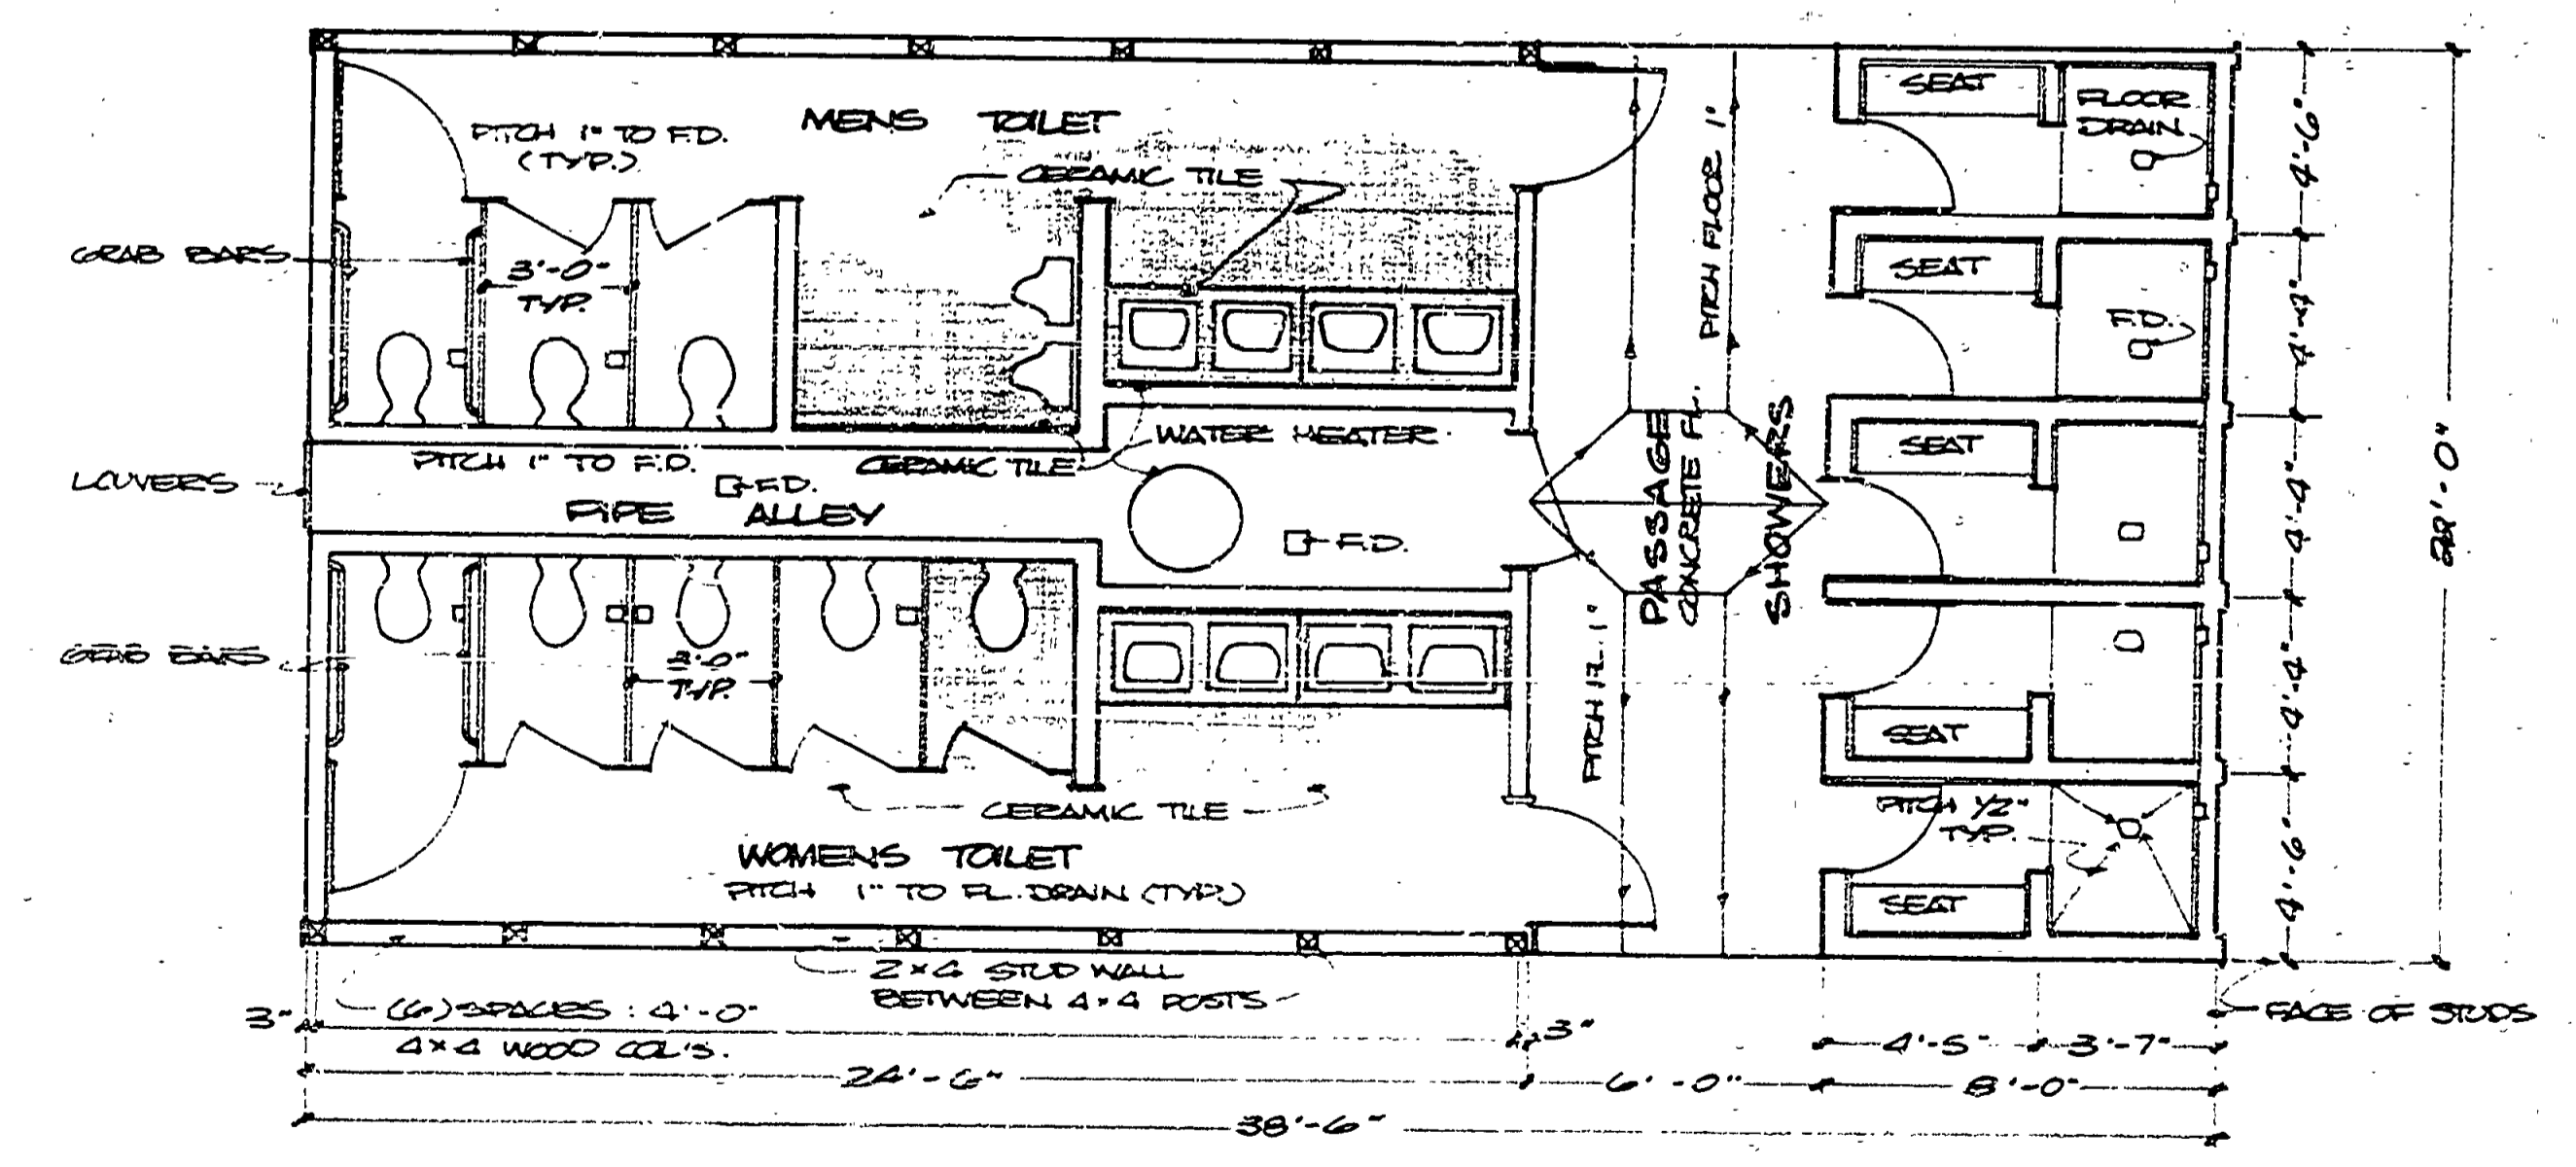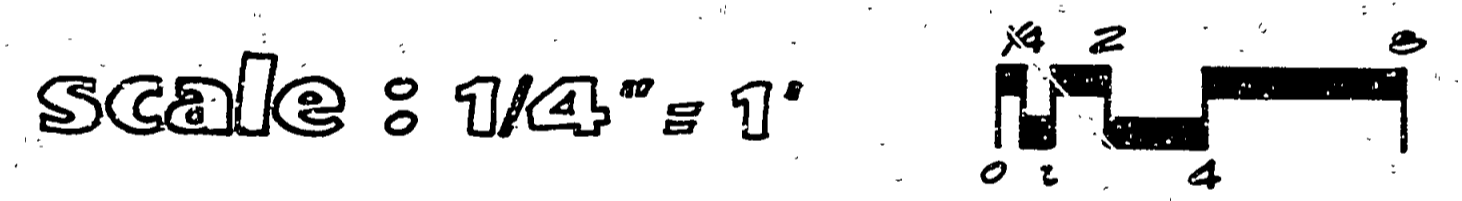

SURVEYED BY	DRAWN BY J. DOBAIN	11/16/73	NO.	DATE	BY	REVISIONS	NO.	DATE	BY	REVISIONS	MICHIGAN DEPARTMENT OF NATURAL RESOURCES	AS BUILT - SITE PLAN FLOOR PLAN & ELEVATIONS SHEET TITLE	MUSKALLONGE LAKE S. P. AREA OR PARK	PROJECT NO. 24-1472
DESIGNED BY	CHECKED BY		1.				3.						TOILET & SHOWER BUILDING PROJECT	SHEET 2 OF 2 PLAN NO. L-100