


MUSKALLONGE LAKE STATE PARK

CAMPGROUND WATER SYSTEM CONTRACT NO. 975-8-C1

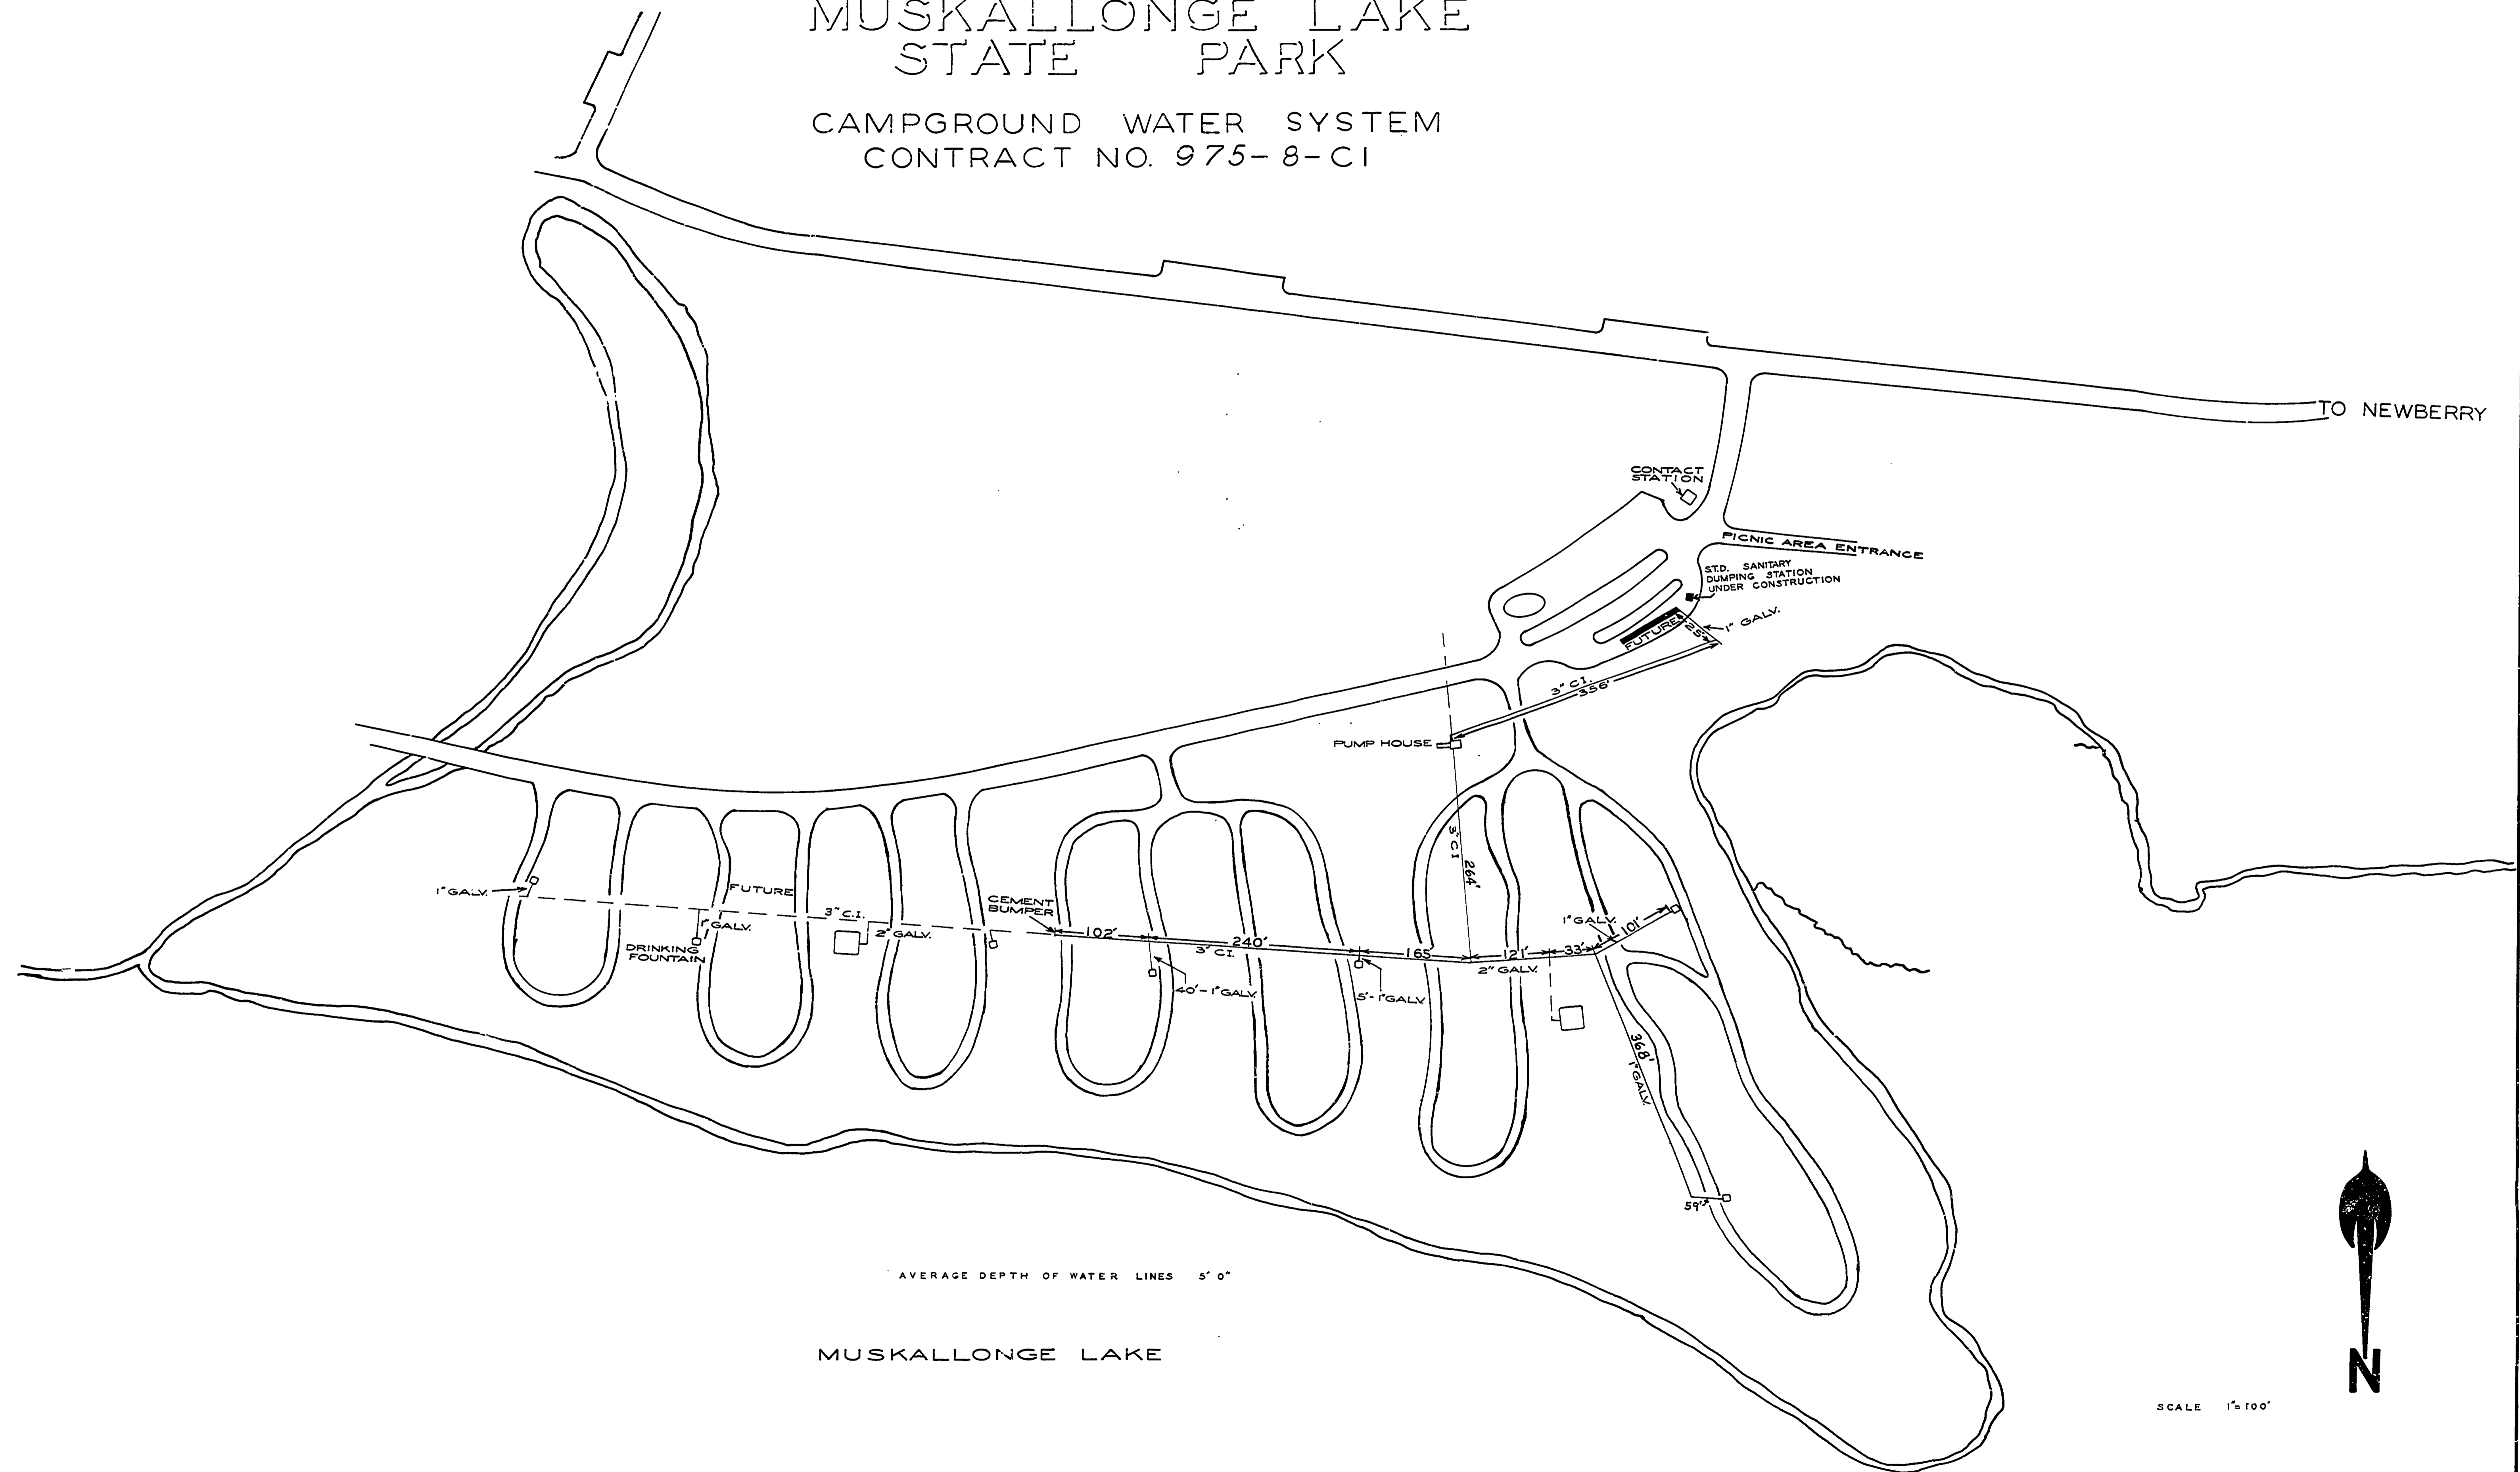

AVERAGE DEPTH OF WATER LINES 5' 0"

MUSKALLONGE LAKE

SCALE 1" = 100'

SEE L-102 FOR SHEETS 1-3

SURVEYED BY	DRAWN BY COLIER	9-67	NO. DATE	REVISIONS	NO. DATE BY	REVISIONS	MICHIGAN DEPARTMENT OF CONSERVATION	MUSKALLONGE LAKE STATE PARK CAMPGROUND, SECTION 2	SHEET NO. ____ OF ____ FOR PROJECT NO. _____	WATER DISTRIBUTION SYSTEM SHEET 4 OF 8 PLAN NO. E-102
DESIGNED BY	CHECKED BY	DATE	1.		3.	J.D.C. BROUGHT UP TO DATE				
			2.		4.					