
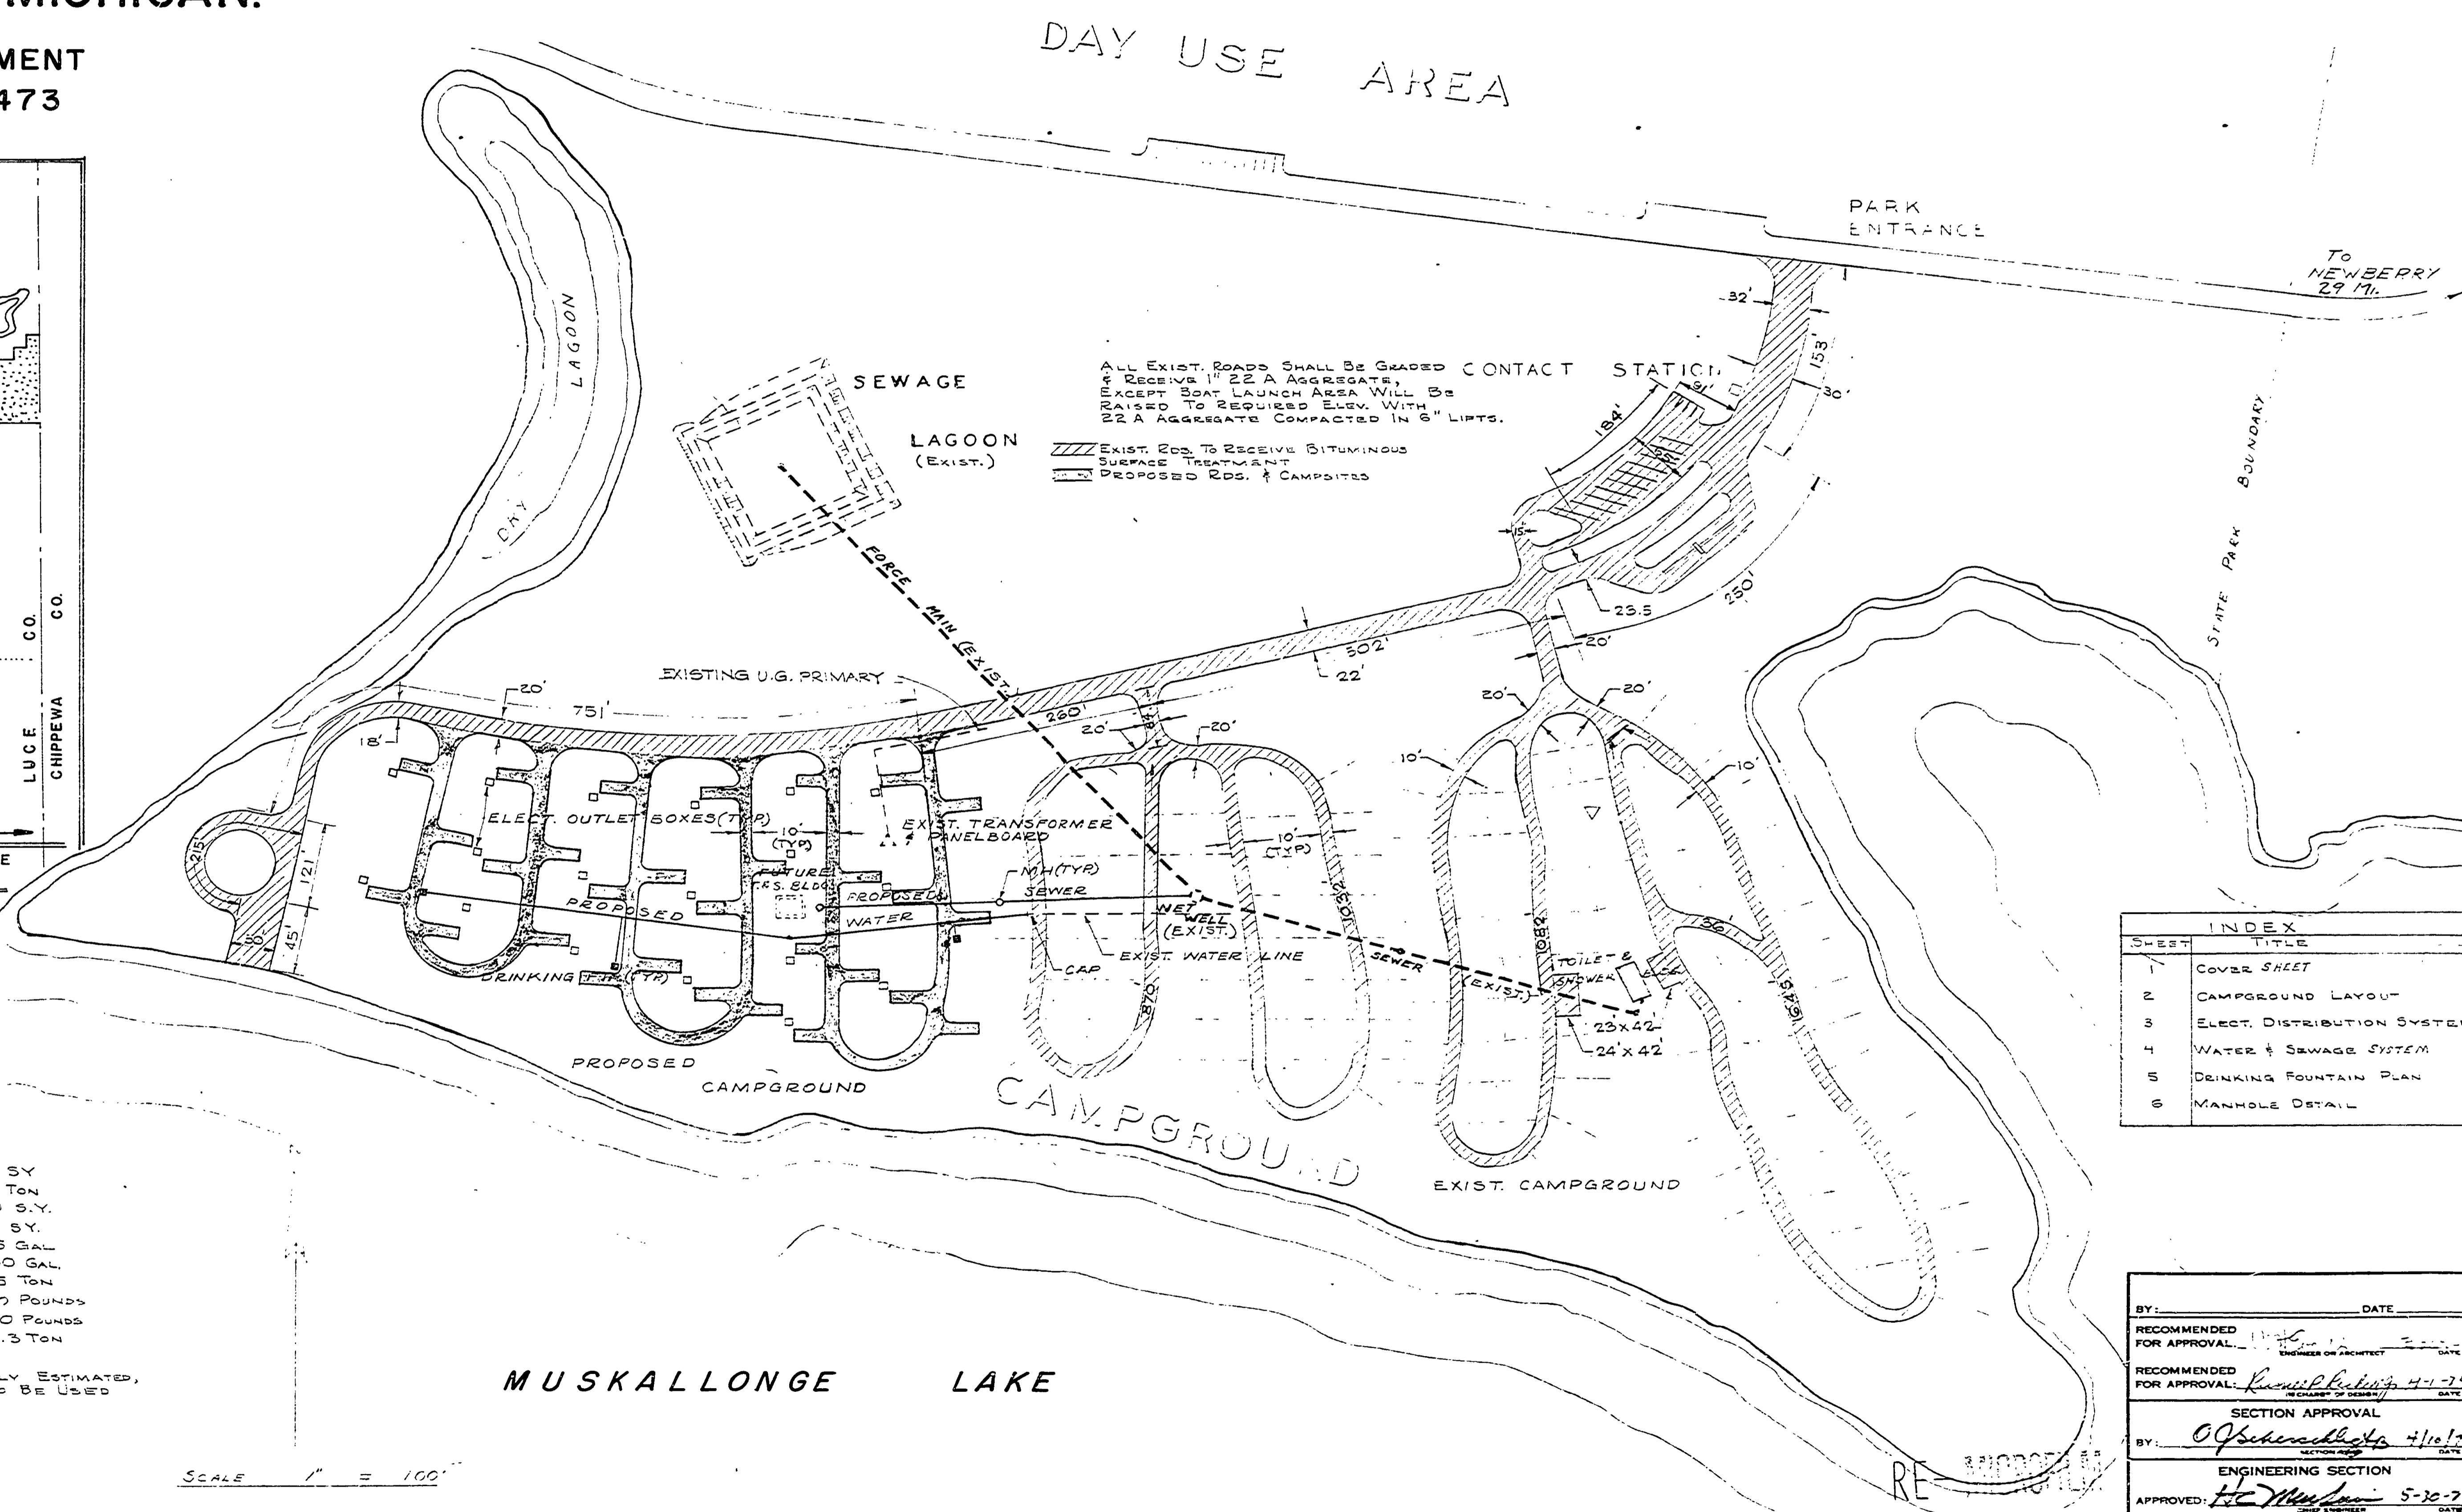


CONSTRUCTION PLANS FOR MUSKALLONGE LAKE STATE PARK NEWBERRY, MICHIGAN.

CAMPGROUND DEVELOPMENT
PROJECT NO. 24-1473

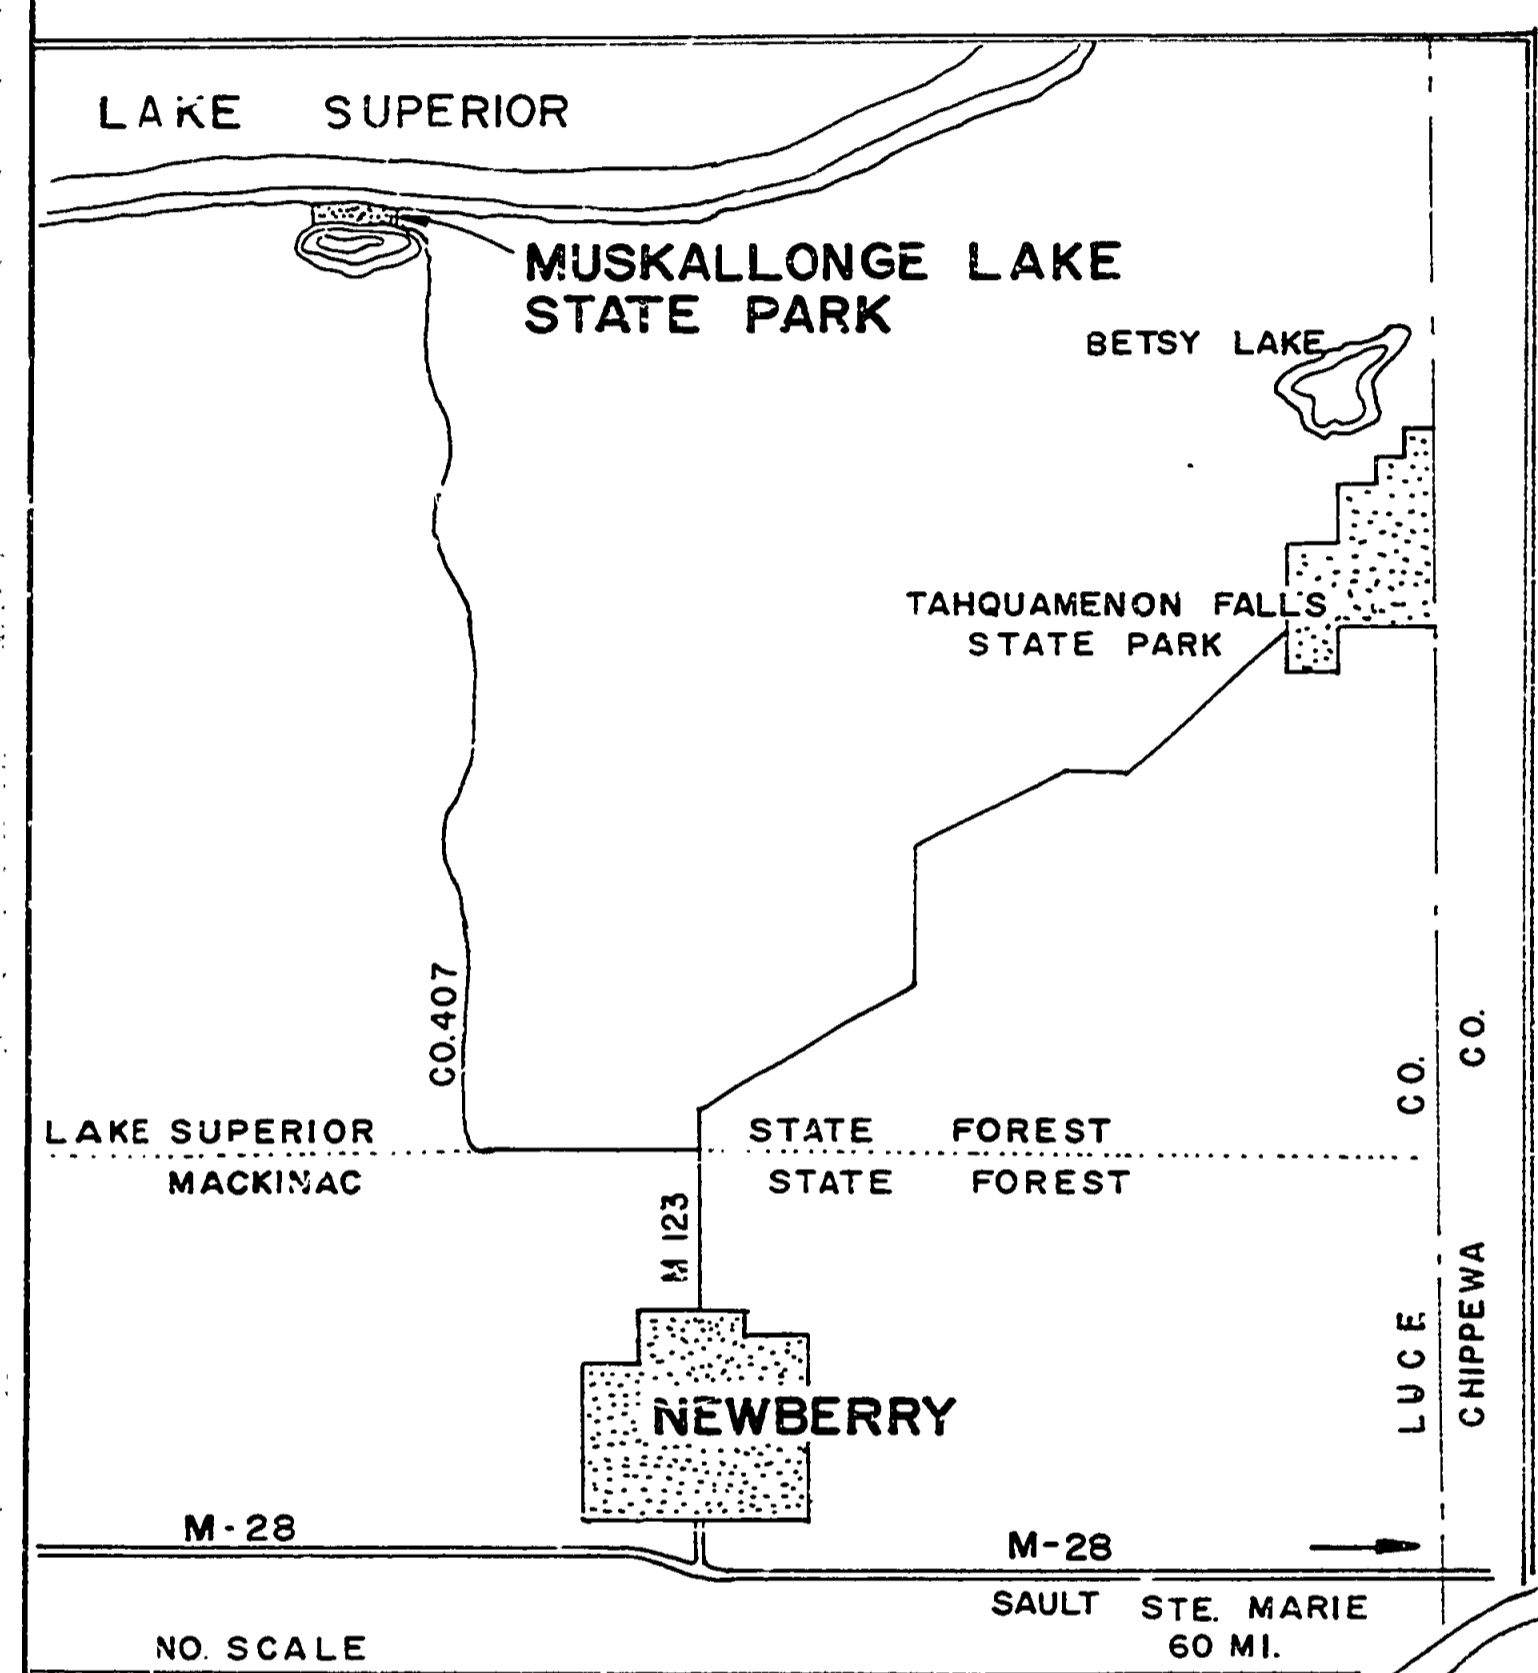

ALL EXIST. ROADS SHALL BE GRADED CONTACT STATION
& RECEIVE 1" 22-A AGGREGATE.
EXCEPT BOAT LAUNCH AREA WILL BE
RAISED TO REQUIRED ELEV. WITH
22-A AGGREGATE COMPACTED IN 6" LIFTS.

EXIST. RDS. TO RECEIVE BITUMINOUS
SURFACE TREATMENT
PROPOSED RDS. & CAMPSITES

QUANTITIES

EXCAVATION	800 C.Y.
CLEARING & GRUBBING	1.5 A
CONDITIONING AGGREGATE SURFACE	14,400 SY
CONDITIONING AGGREGATE 22-A	1310 TON
AGGREGATE BASE COURSE 22-A	3000 S.Y.
GRAVEL & TOPSOIL MIX	2415 SY.
BITUMINOUS PRIME COAT	4125 GAL.
BITUMINOUS SURFACE COAT	11,550 GAL.
COVER AGGREGATE 31-A	495 TON
ROADSIDE SEEDING	57 POUNDS
CHEMICAL FERTILIZER NUTRIENT	120 POUNDS
MULCH	1.3 TON

THESE QUANTITIES HAVE BEEN CAREFULLY ESTIMATED,
BUT ARE NOT GUARANTEED, & ARE NOT TO BE USED
AS BASIS OF PAYMENT.

SCALE 1" = 100'

INDEX	
SHEET	TITLE
1	COVER SHEET
2	CAMPGROUND LAYOUT
3	ELECT. DISTRIBUTION SYSTEM
4	WATER & SEWAGE SYSTEM
5	DRINKING FOUNTAIN PLAN
6	MANHOLE DETAIL

BY:	DATE
RECOMMENDED FOR APPROVAL:	DATE
RECOMMENDED FOR APPROVAL:	DATE
SECTION APPROVAL	DATE
BY:	DATE
ENGINEERING SECTION	DATE
APPROVED:	DATE

SURVEYED BY	DATE	DRAWN BY	DATE	NO.	DATE	BY	REVISIONS	NO.	DATE	BY	REVISIONS
V. MC GINN	JAN '74	J. YPMA	MAY '74	1.	5-23-74	J.Y.	BOAT LAUNCH & BIT. SUKR. ADDD	3.	2/78	DDP	AS BUILT
R. H. MERRILL	MAY '74			2.	4-8-76	J.S.	WINGS	4.			