






NO.	DATE	BY	REVISIONS
1	4-15-51	J.V.E.	File add to show for steel work (Left) & details.
2			
3			

APPROVED BY	DATE	REVIEWED BY SECTIONS	DATE
<i>[Signature]</i>	2-16-51	J.T.R.	2-16-51
ASSISTANT CHIEF IN CHARGE		H.C.M.	1/16/51
OF DESIGN	DATE 2-23-51	J.T.R.	2-16-51

DRAWN BY	DATE
J.M.F.	
TRACED BY	
W.M.F.	
CHECKED BY	
DATE	



TILE LAYOUT  
Scale 1/2" = 1'-0"

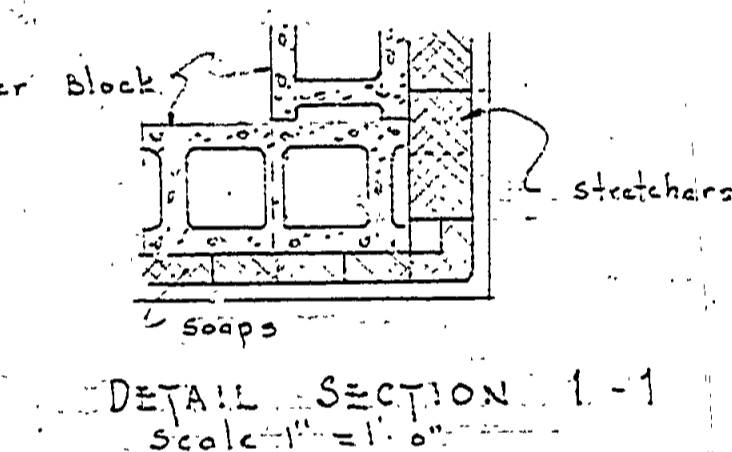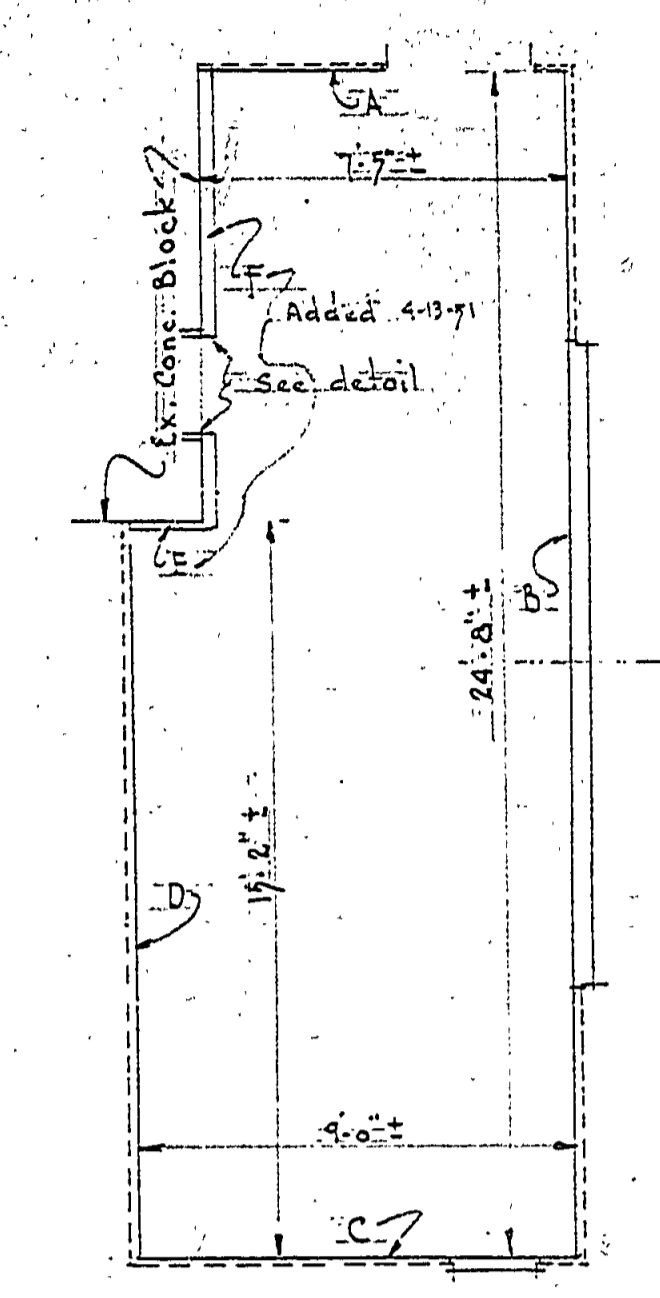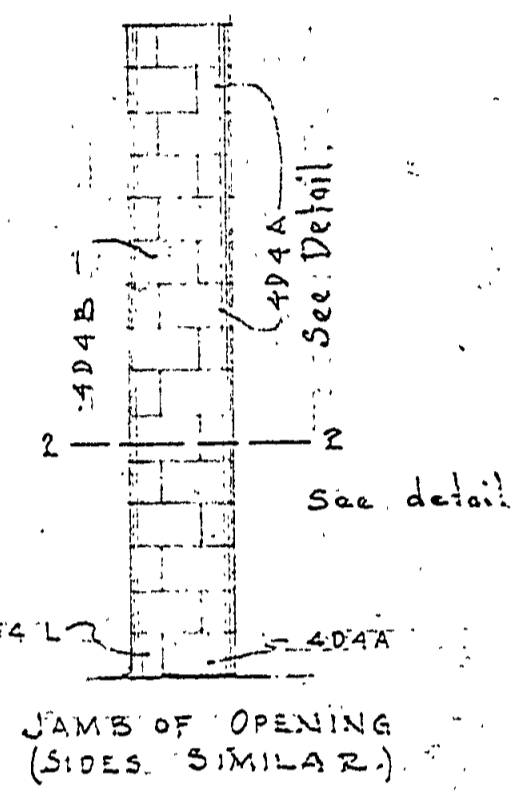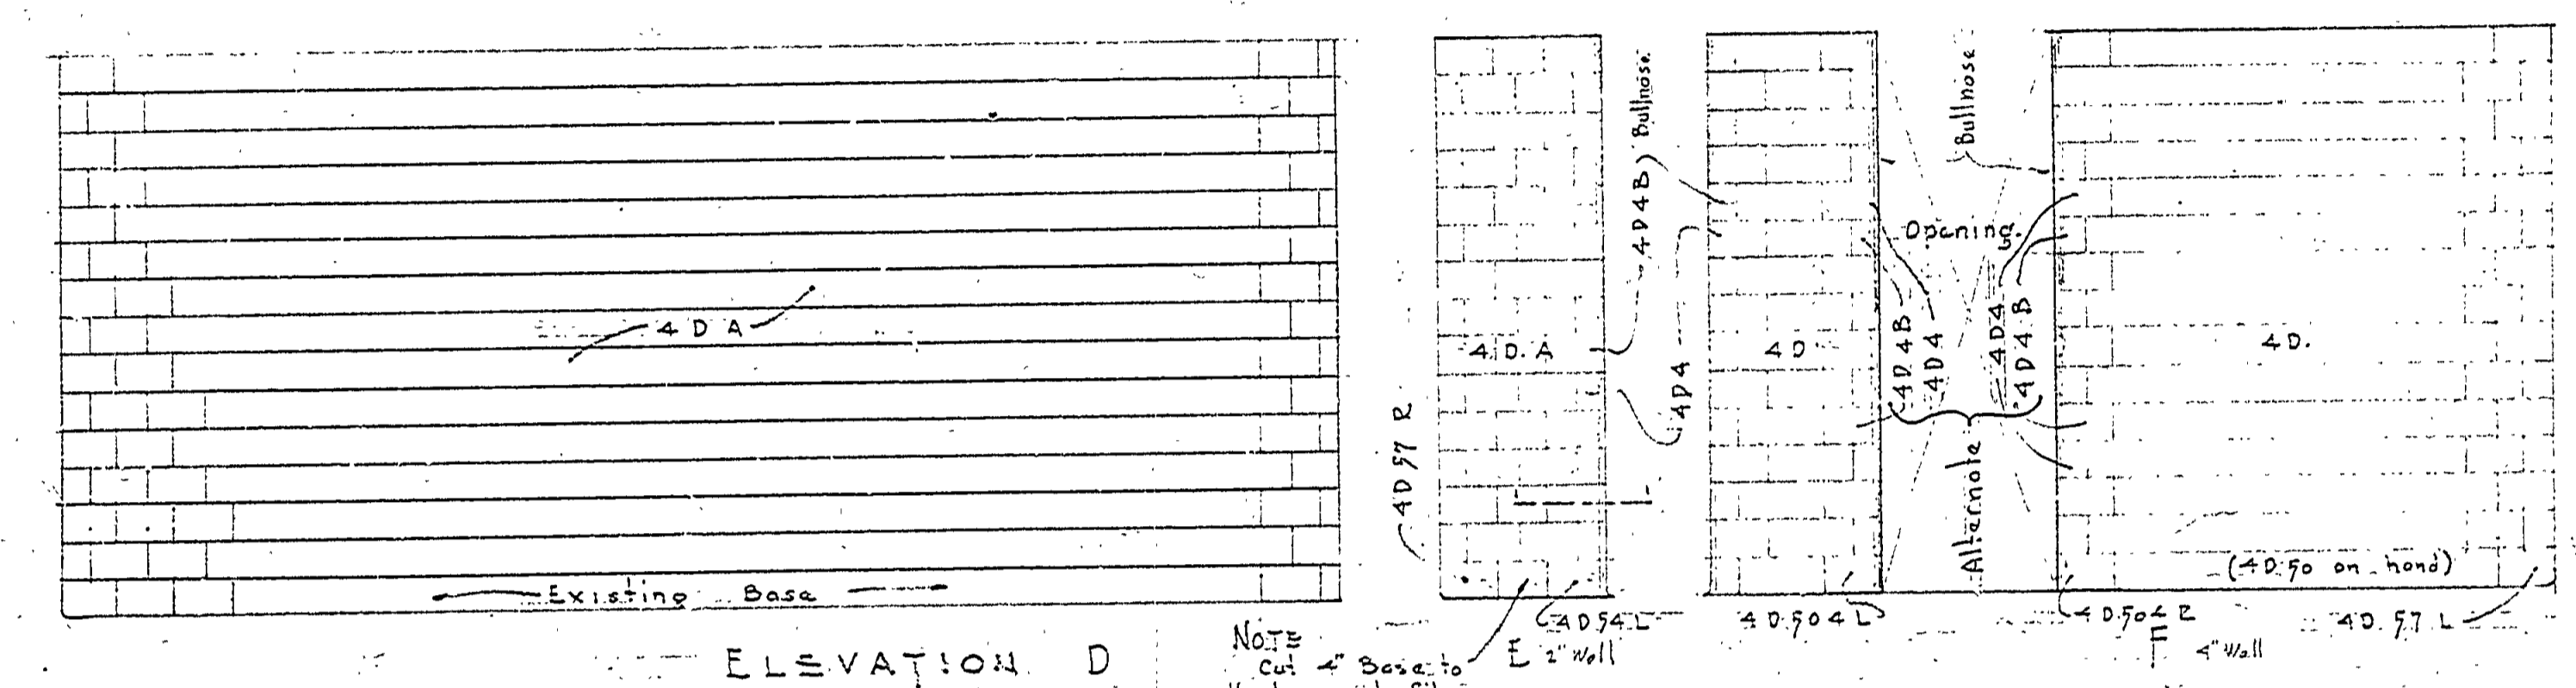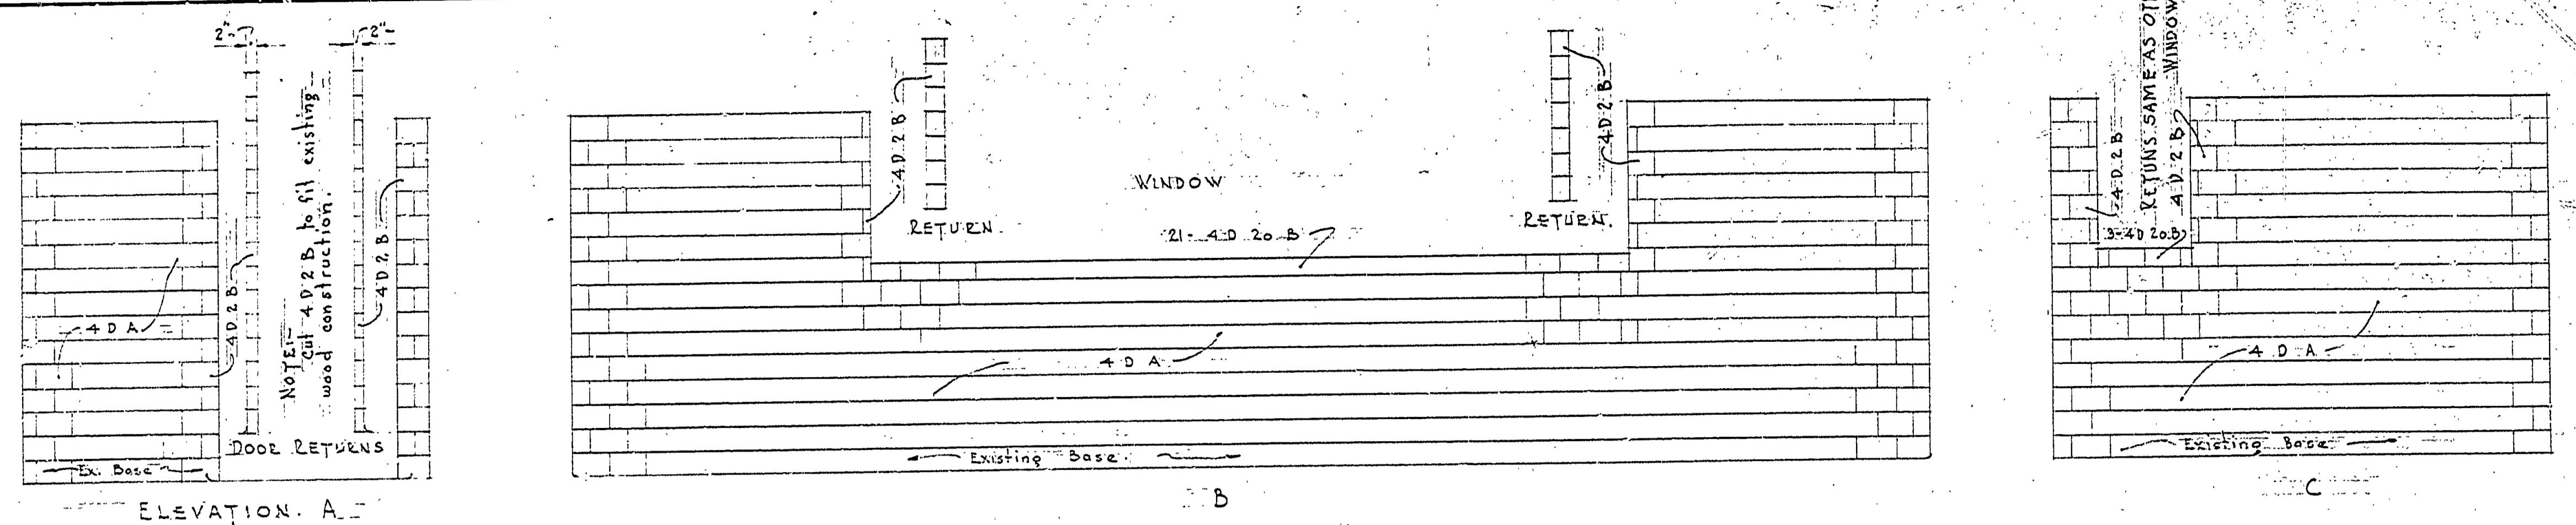