


DESIGNED BY	DATE	REVIEWED	DATE	APPROVED	DATE	NO.	DATE	BY	REVISIONS
B.H.G.	10/14/62	ARCHITECTURAL	10/14/62	<i>[Signature]</i>	10/14/62	1	10/14/62	B.H.G.	Revised To Show Connection From New Well. Reproduct. Plan E-102 For S.C. 404
B.H.G.	10/14/62	ENGINEERING	10/14/62	<i>[Signature]</i>	10/14/62	2			4
E.J.P.	11/17/62	LANDSCAPE	11/17/62	<i>[Signature]</i>	11/17/62	3			5
									6

W H I T E F I S H  
B A Y

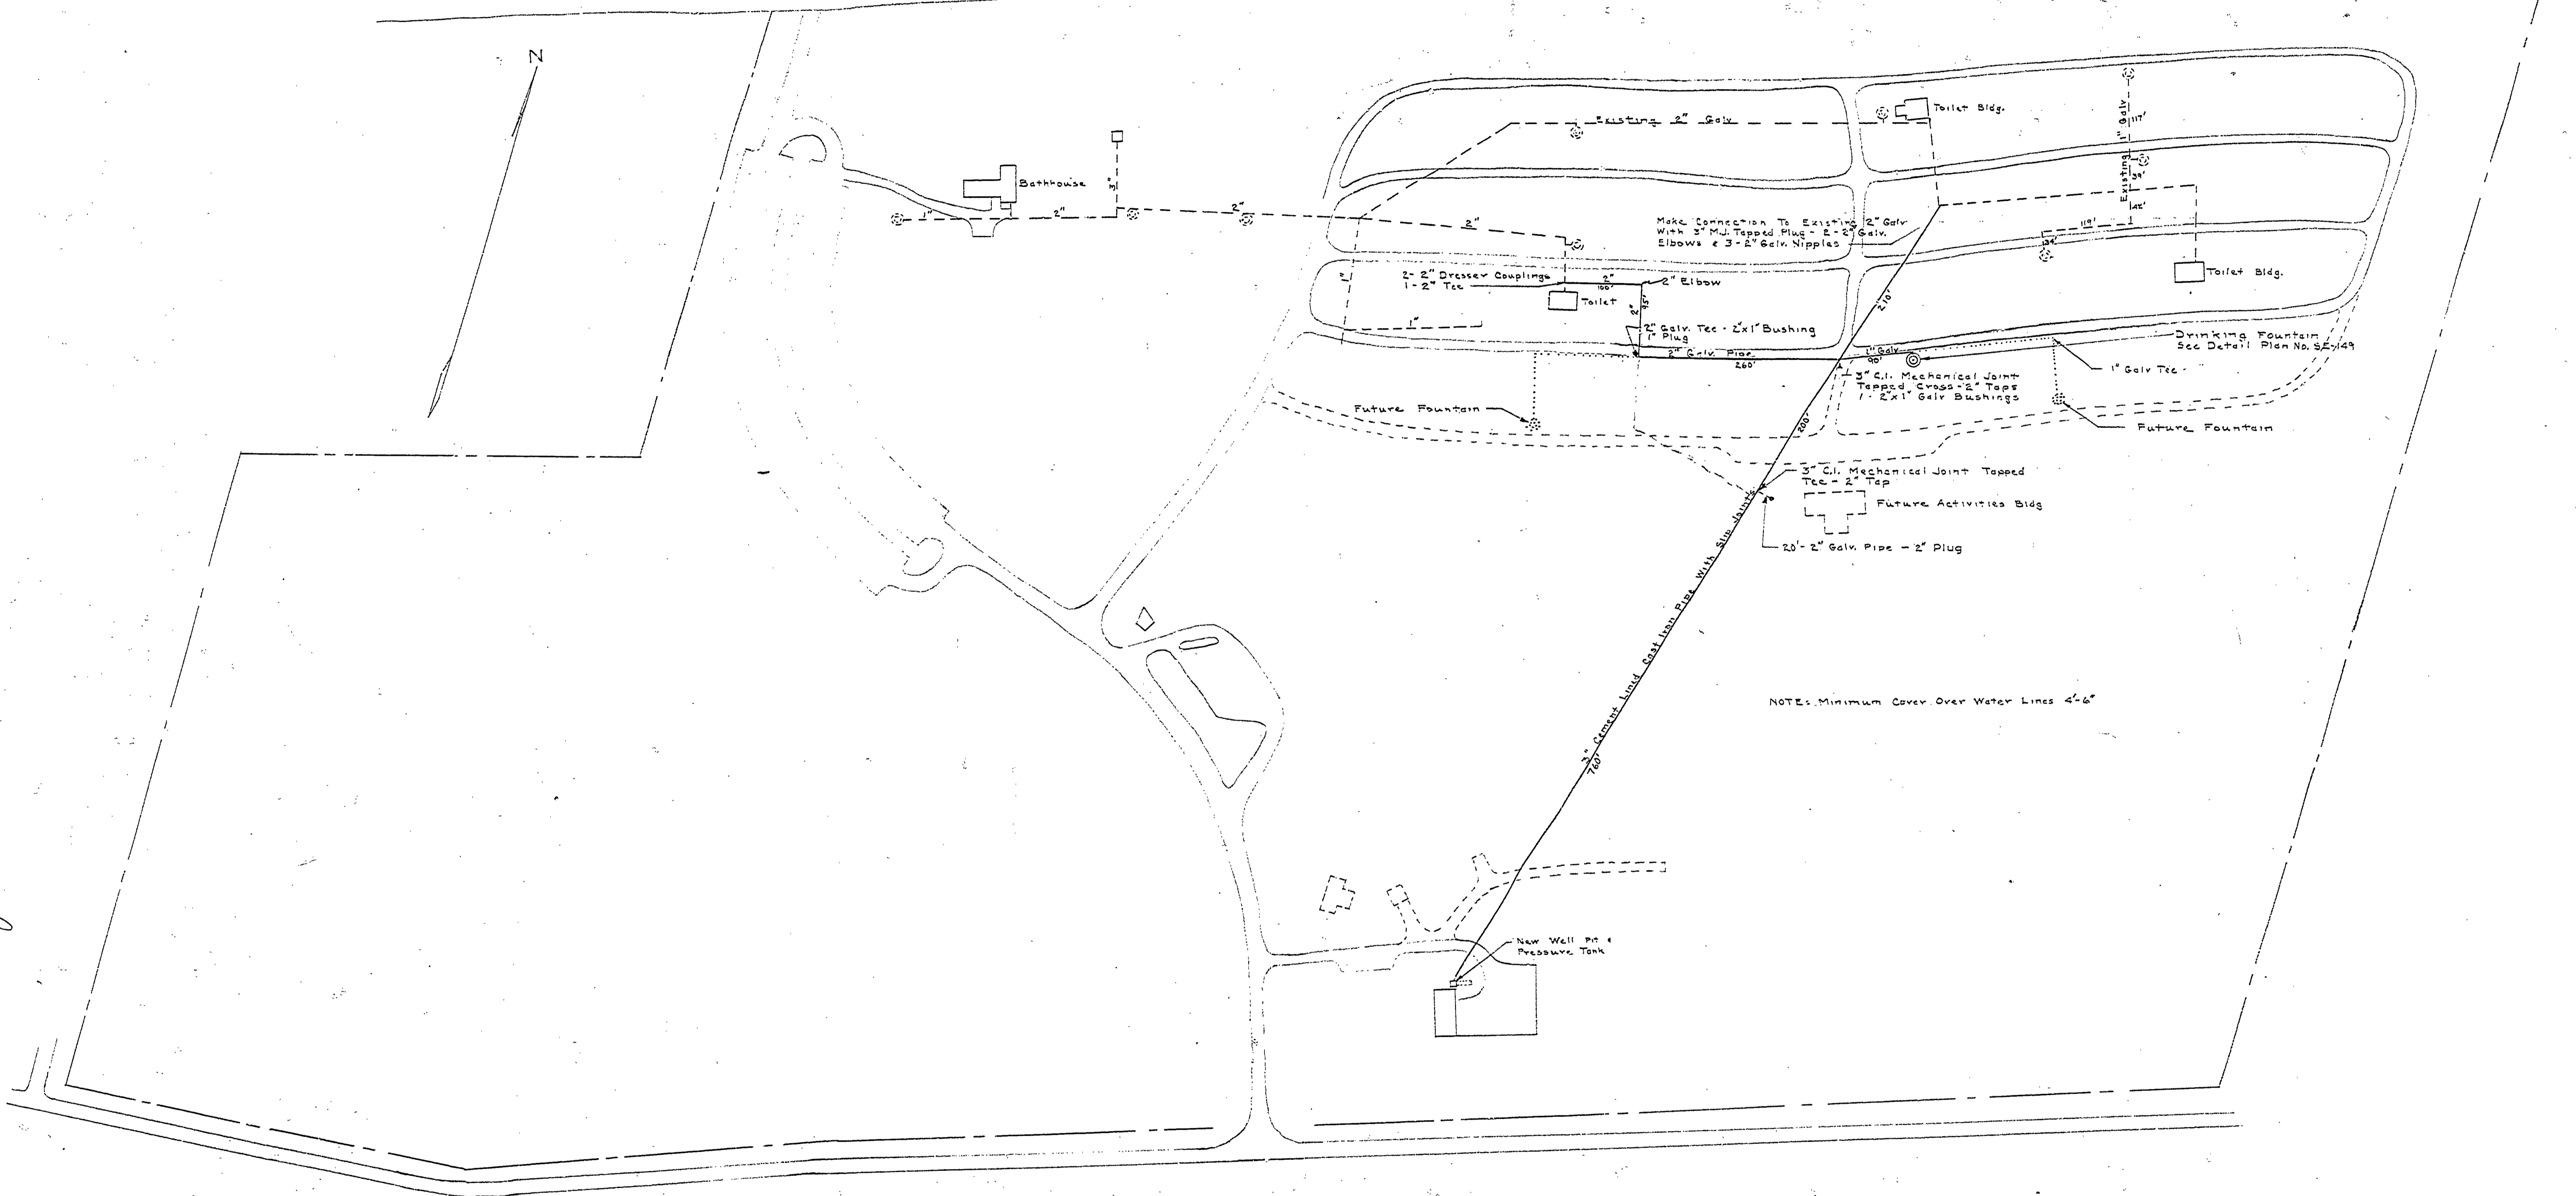

PLAN  
Scale 1" = 100'