



DATE	1-5-60
CHECKED BY	R.V. Beck
TRACED BY	J.R. J.R.
DATE	1-29-60
REVIEWED BY SECTIONS	ARCHITECTURAL ENGINEERING LANDSCAPE
APPROVED BY	H.C. McLaughlin ASSISTANT CHIEF IN CHARGE OF DESIGN
DATE	1-29-60
NO.	1
DATE	
NO.	2
DATE	
NO.	3
DATE	
NO.	4
DATE	
NO.	5
DATE	
NO.	6
DATE	

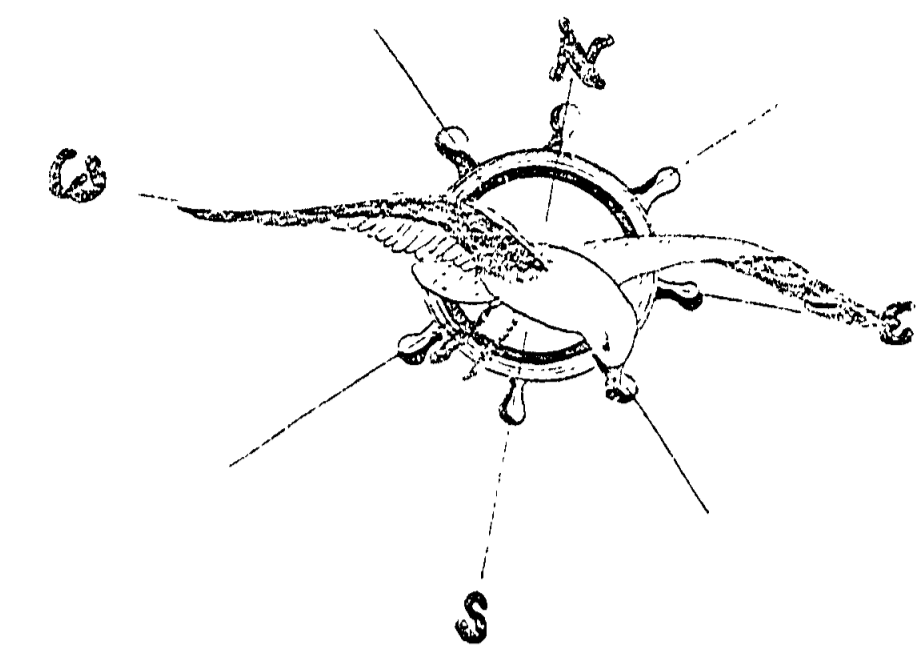

WHITEFISH BAY

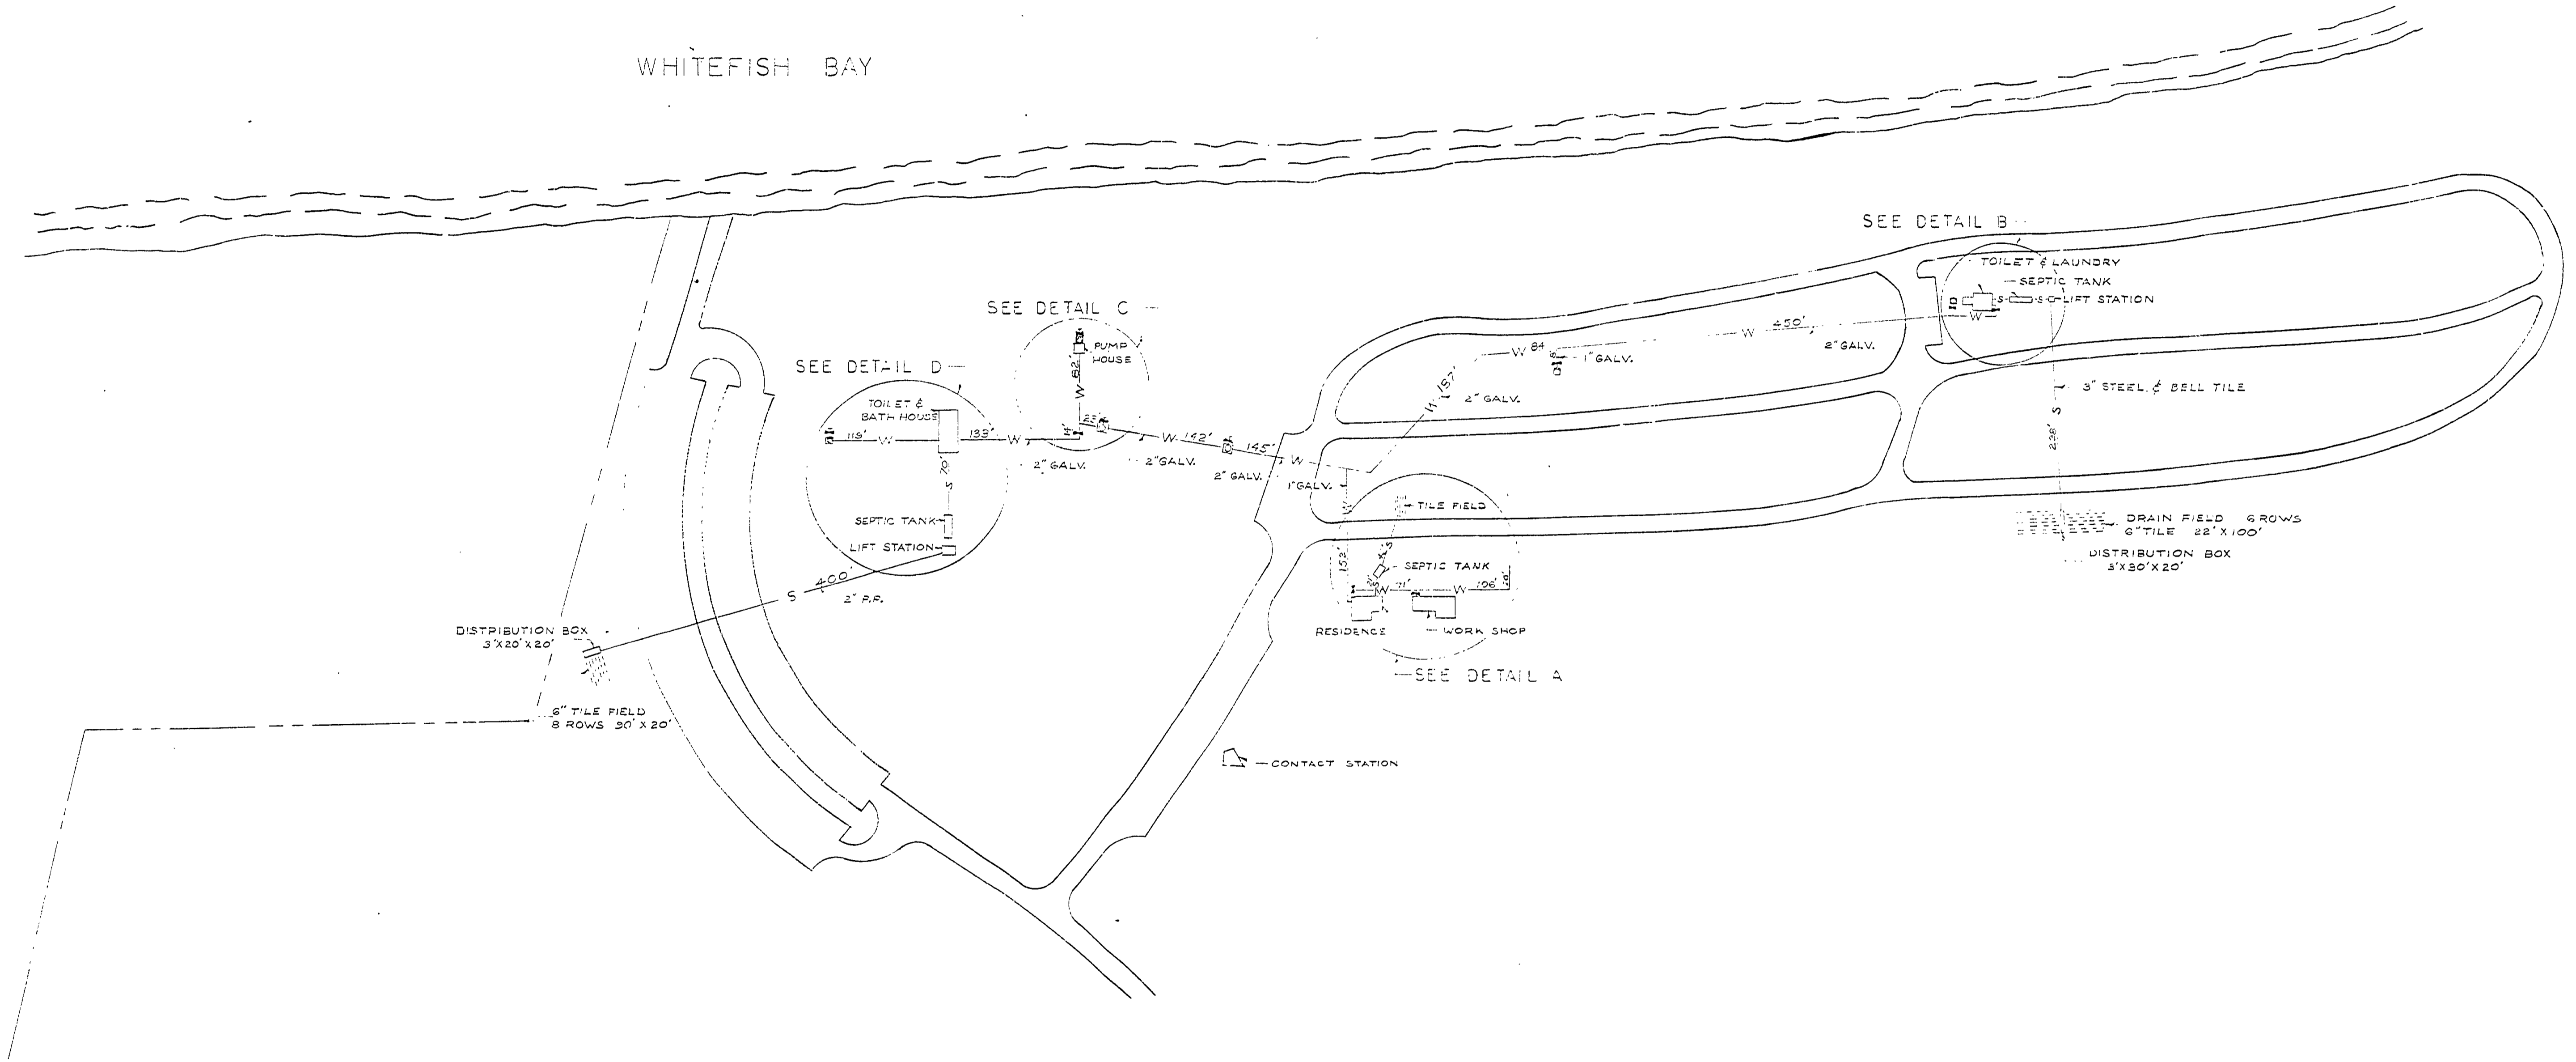

BUILDINGS	
RESIDENCE	34' x 32'
WORK SHOP	50' x 28'
TOILET & LAUNDRY	38' x 24'
PUMP HOUSE	10' x 8'
TOILET & BATH	50' x 24'

LEGEND	
—W—	WATER LINE
—S—	SEWAGE LINE
⊠	WATER FOUNTAIN
⊠	STOP & DRAIN VALVE
GALV.	GALVANIZED PIPE
PP	PLASTIC PIPE
---	BOUNDARY LINE

BRIMLEY STATE PARK

SCALE 1"=100'

MICHIGAN
DEPARTMENT OF CONSERVATION
PARKS AND RECREATION DIVISION

BRIMLEY STATE PARK
UTILITY MAP
WATER & SEWAGE

SHEET
NO. 2
OF 3

PLAN NO.
U-1
R-9