
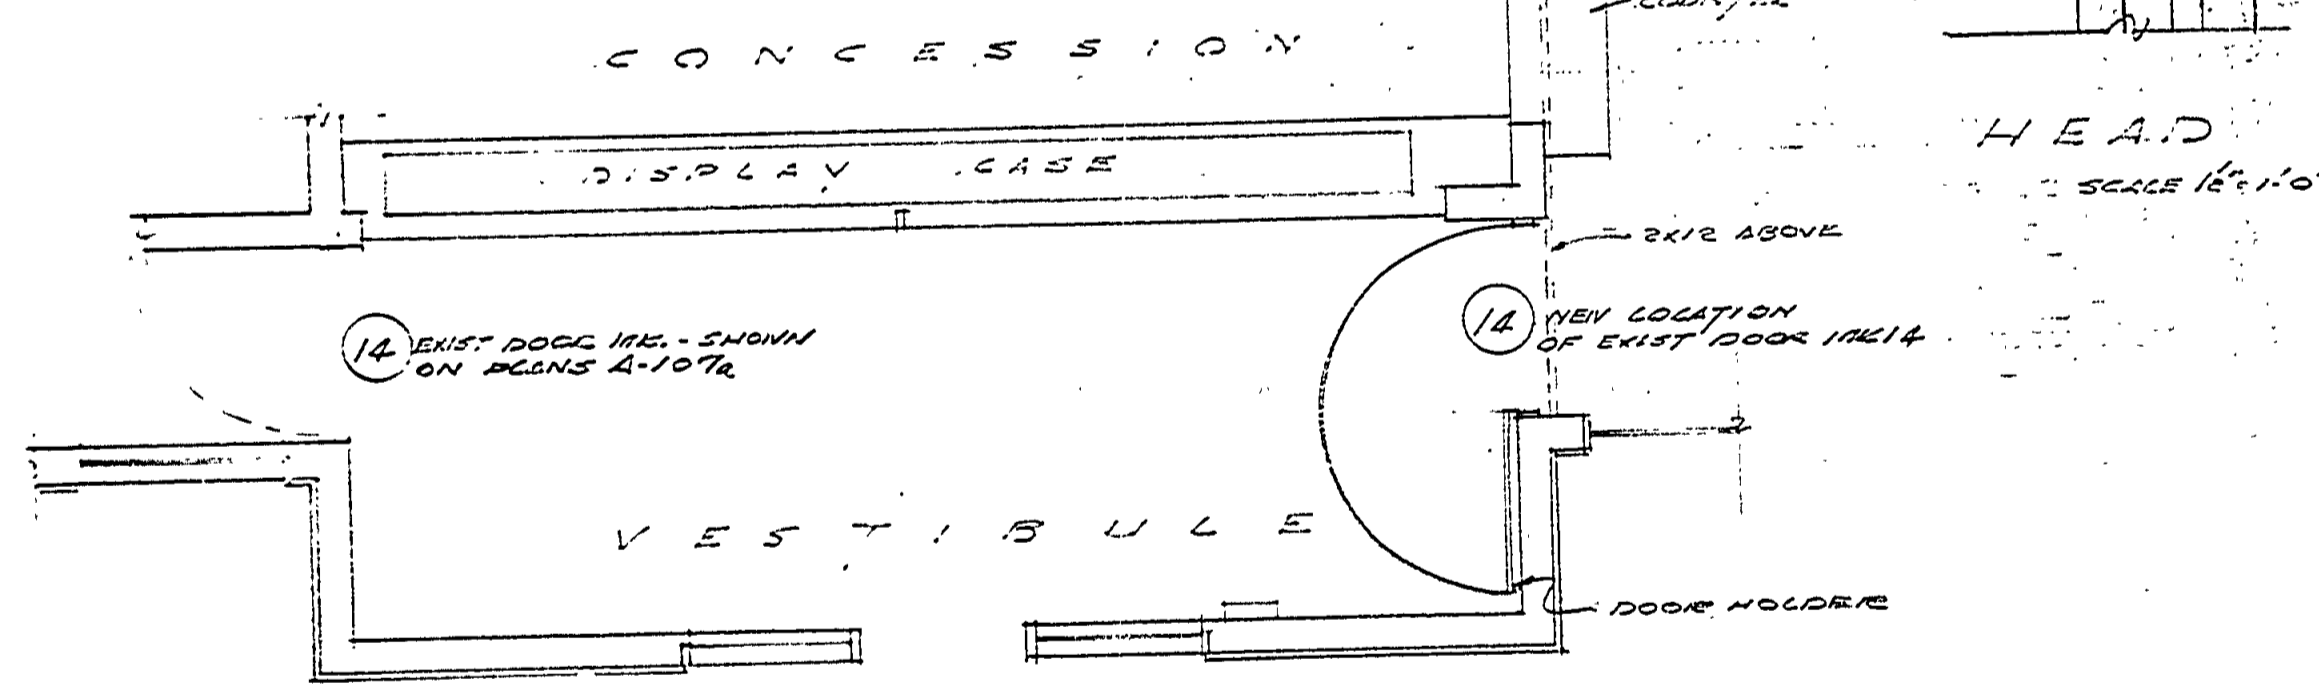


JAMB

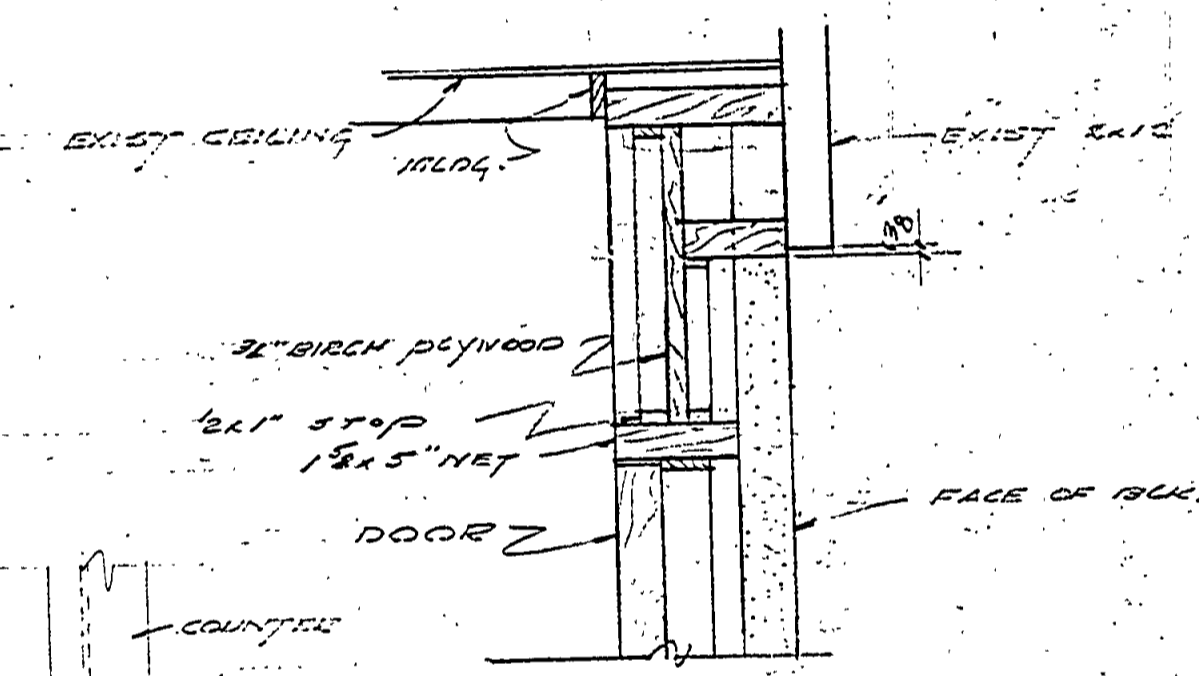

FLOOR PLAN

SCALE 1/4"=1'-0"

BATHHOUSE & CONCESSION	
INTERLOCHEN STATE PARK	
RELOCATE DOOR IN	
VESTIBULE	
9/20/66	AKC

A-107