

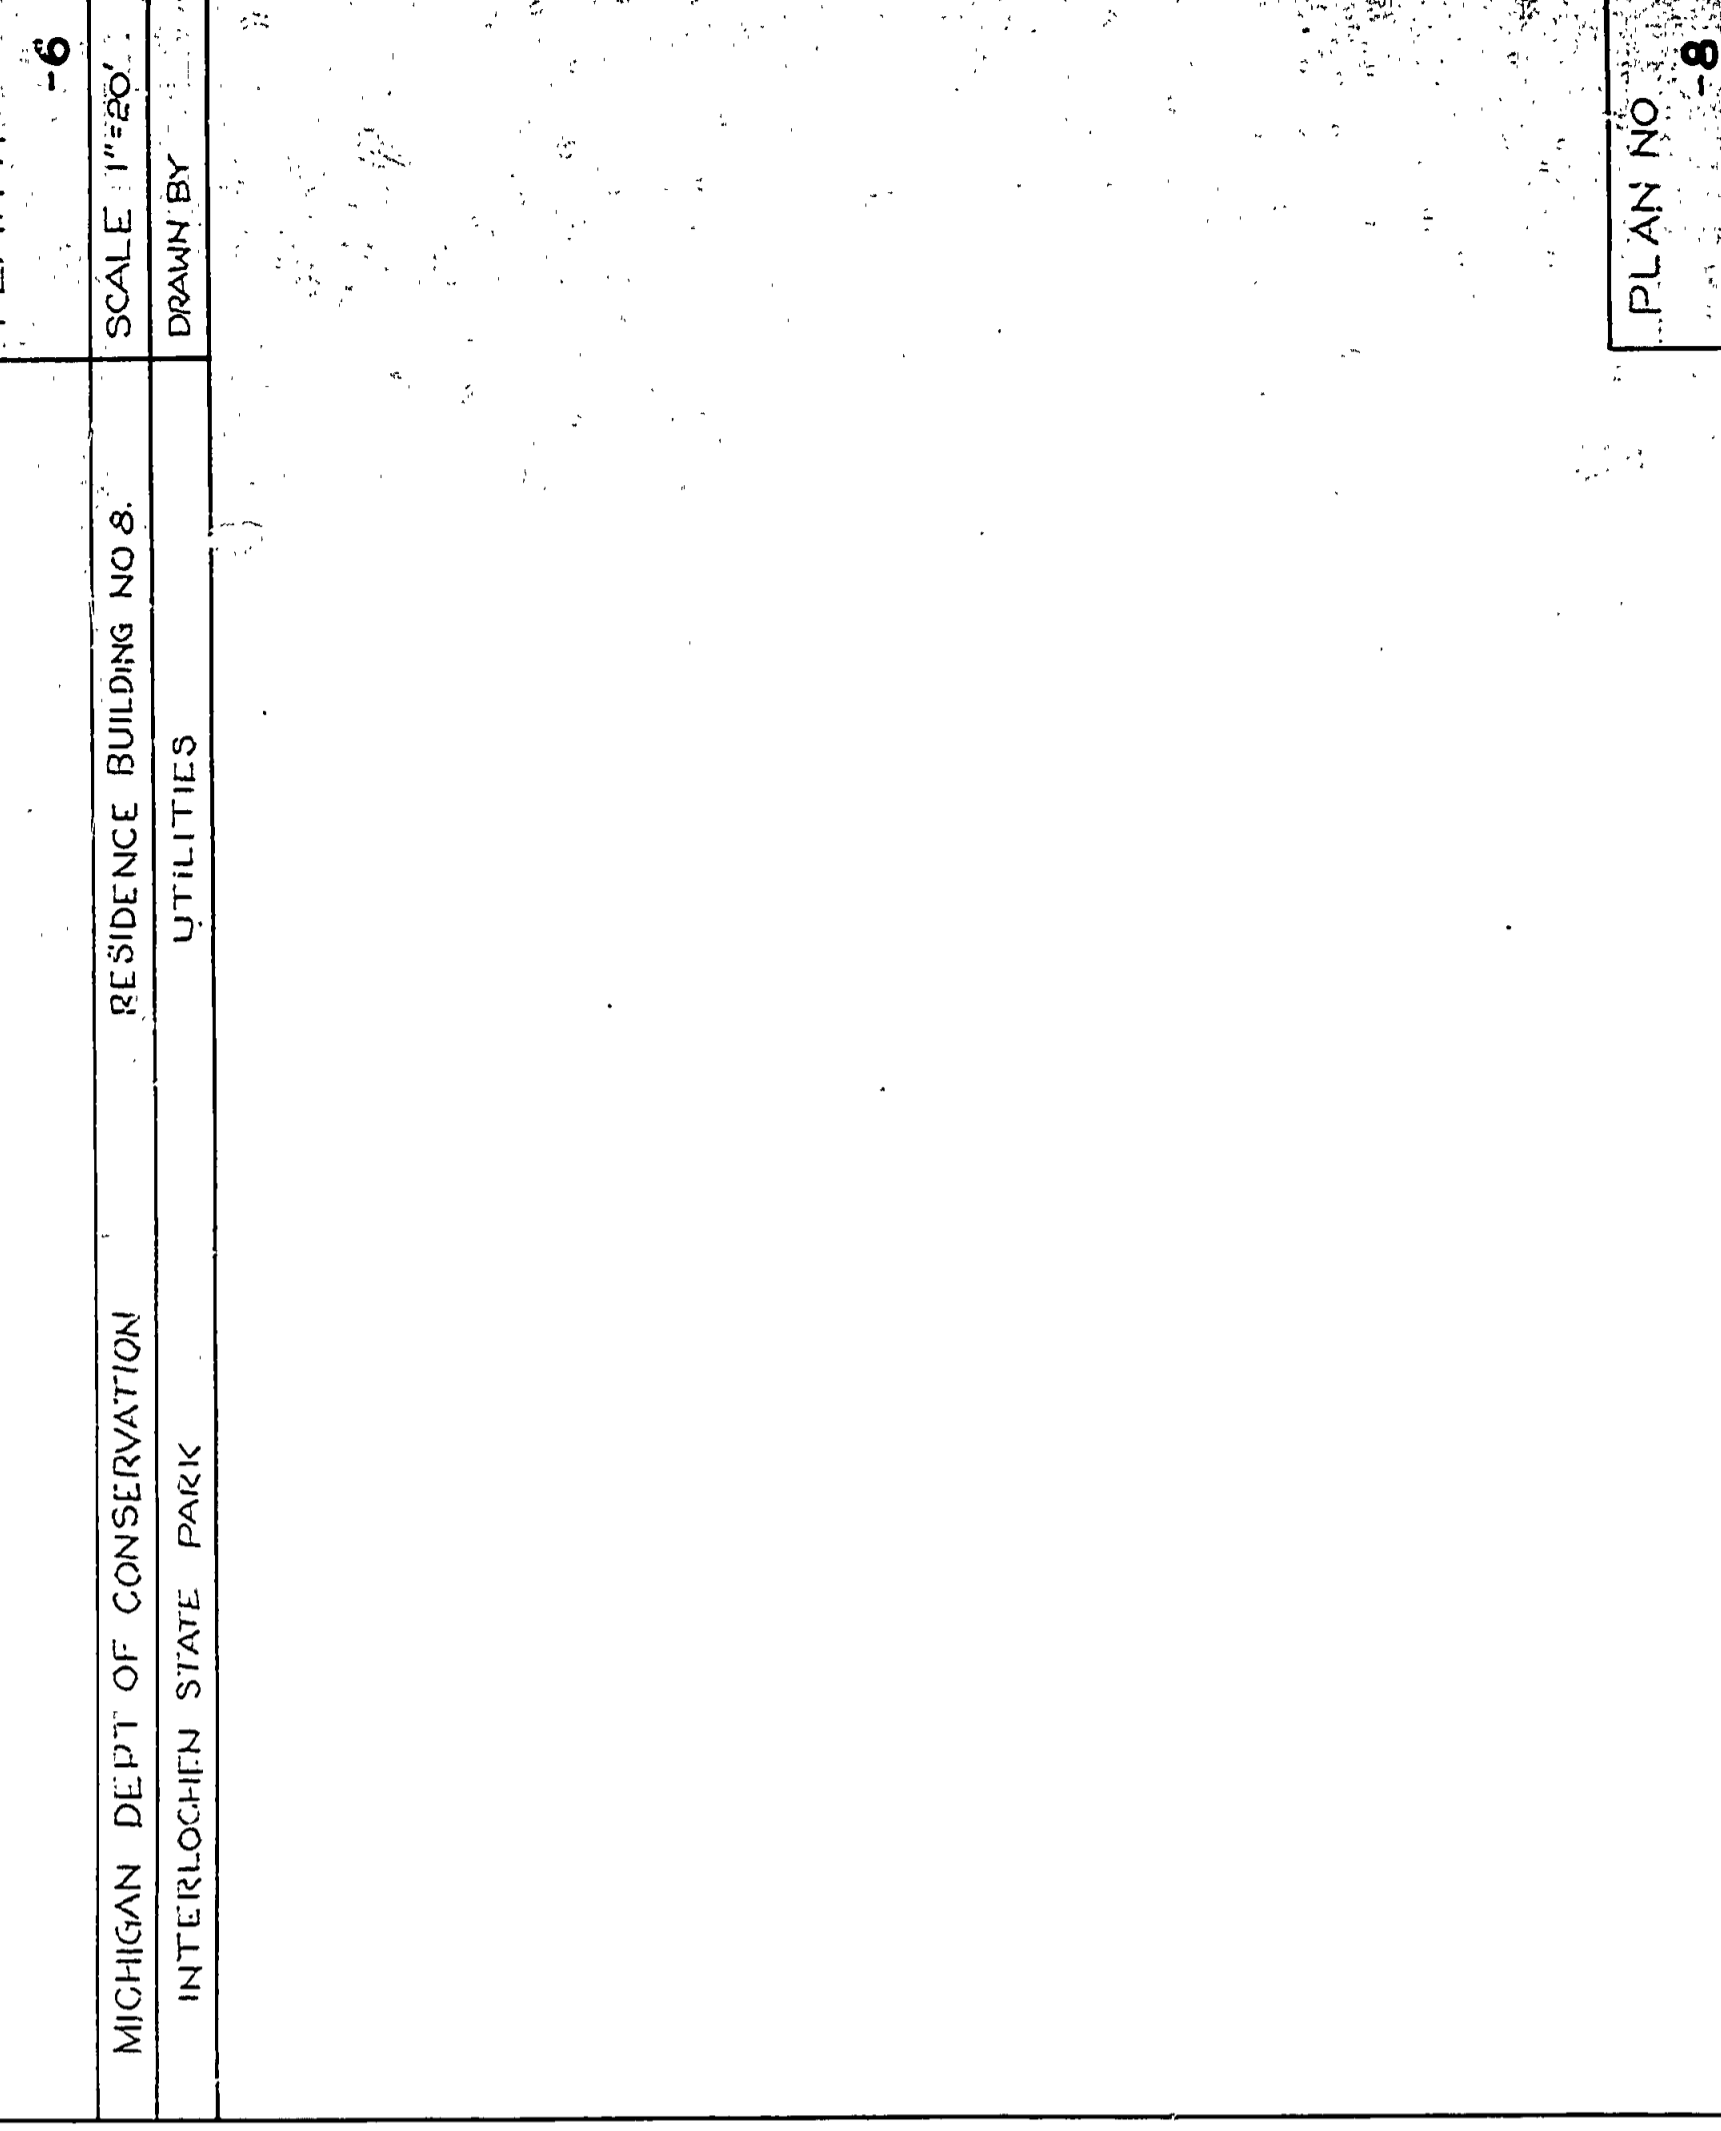
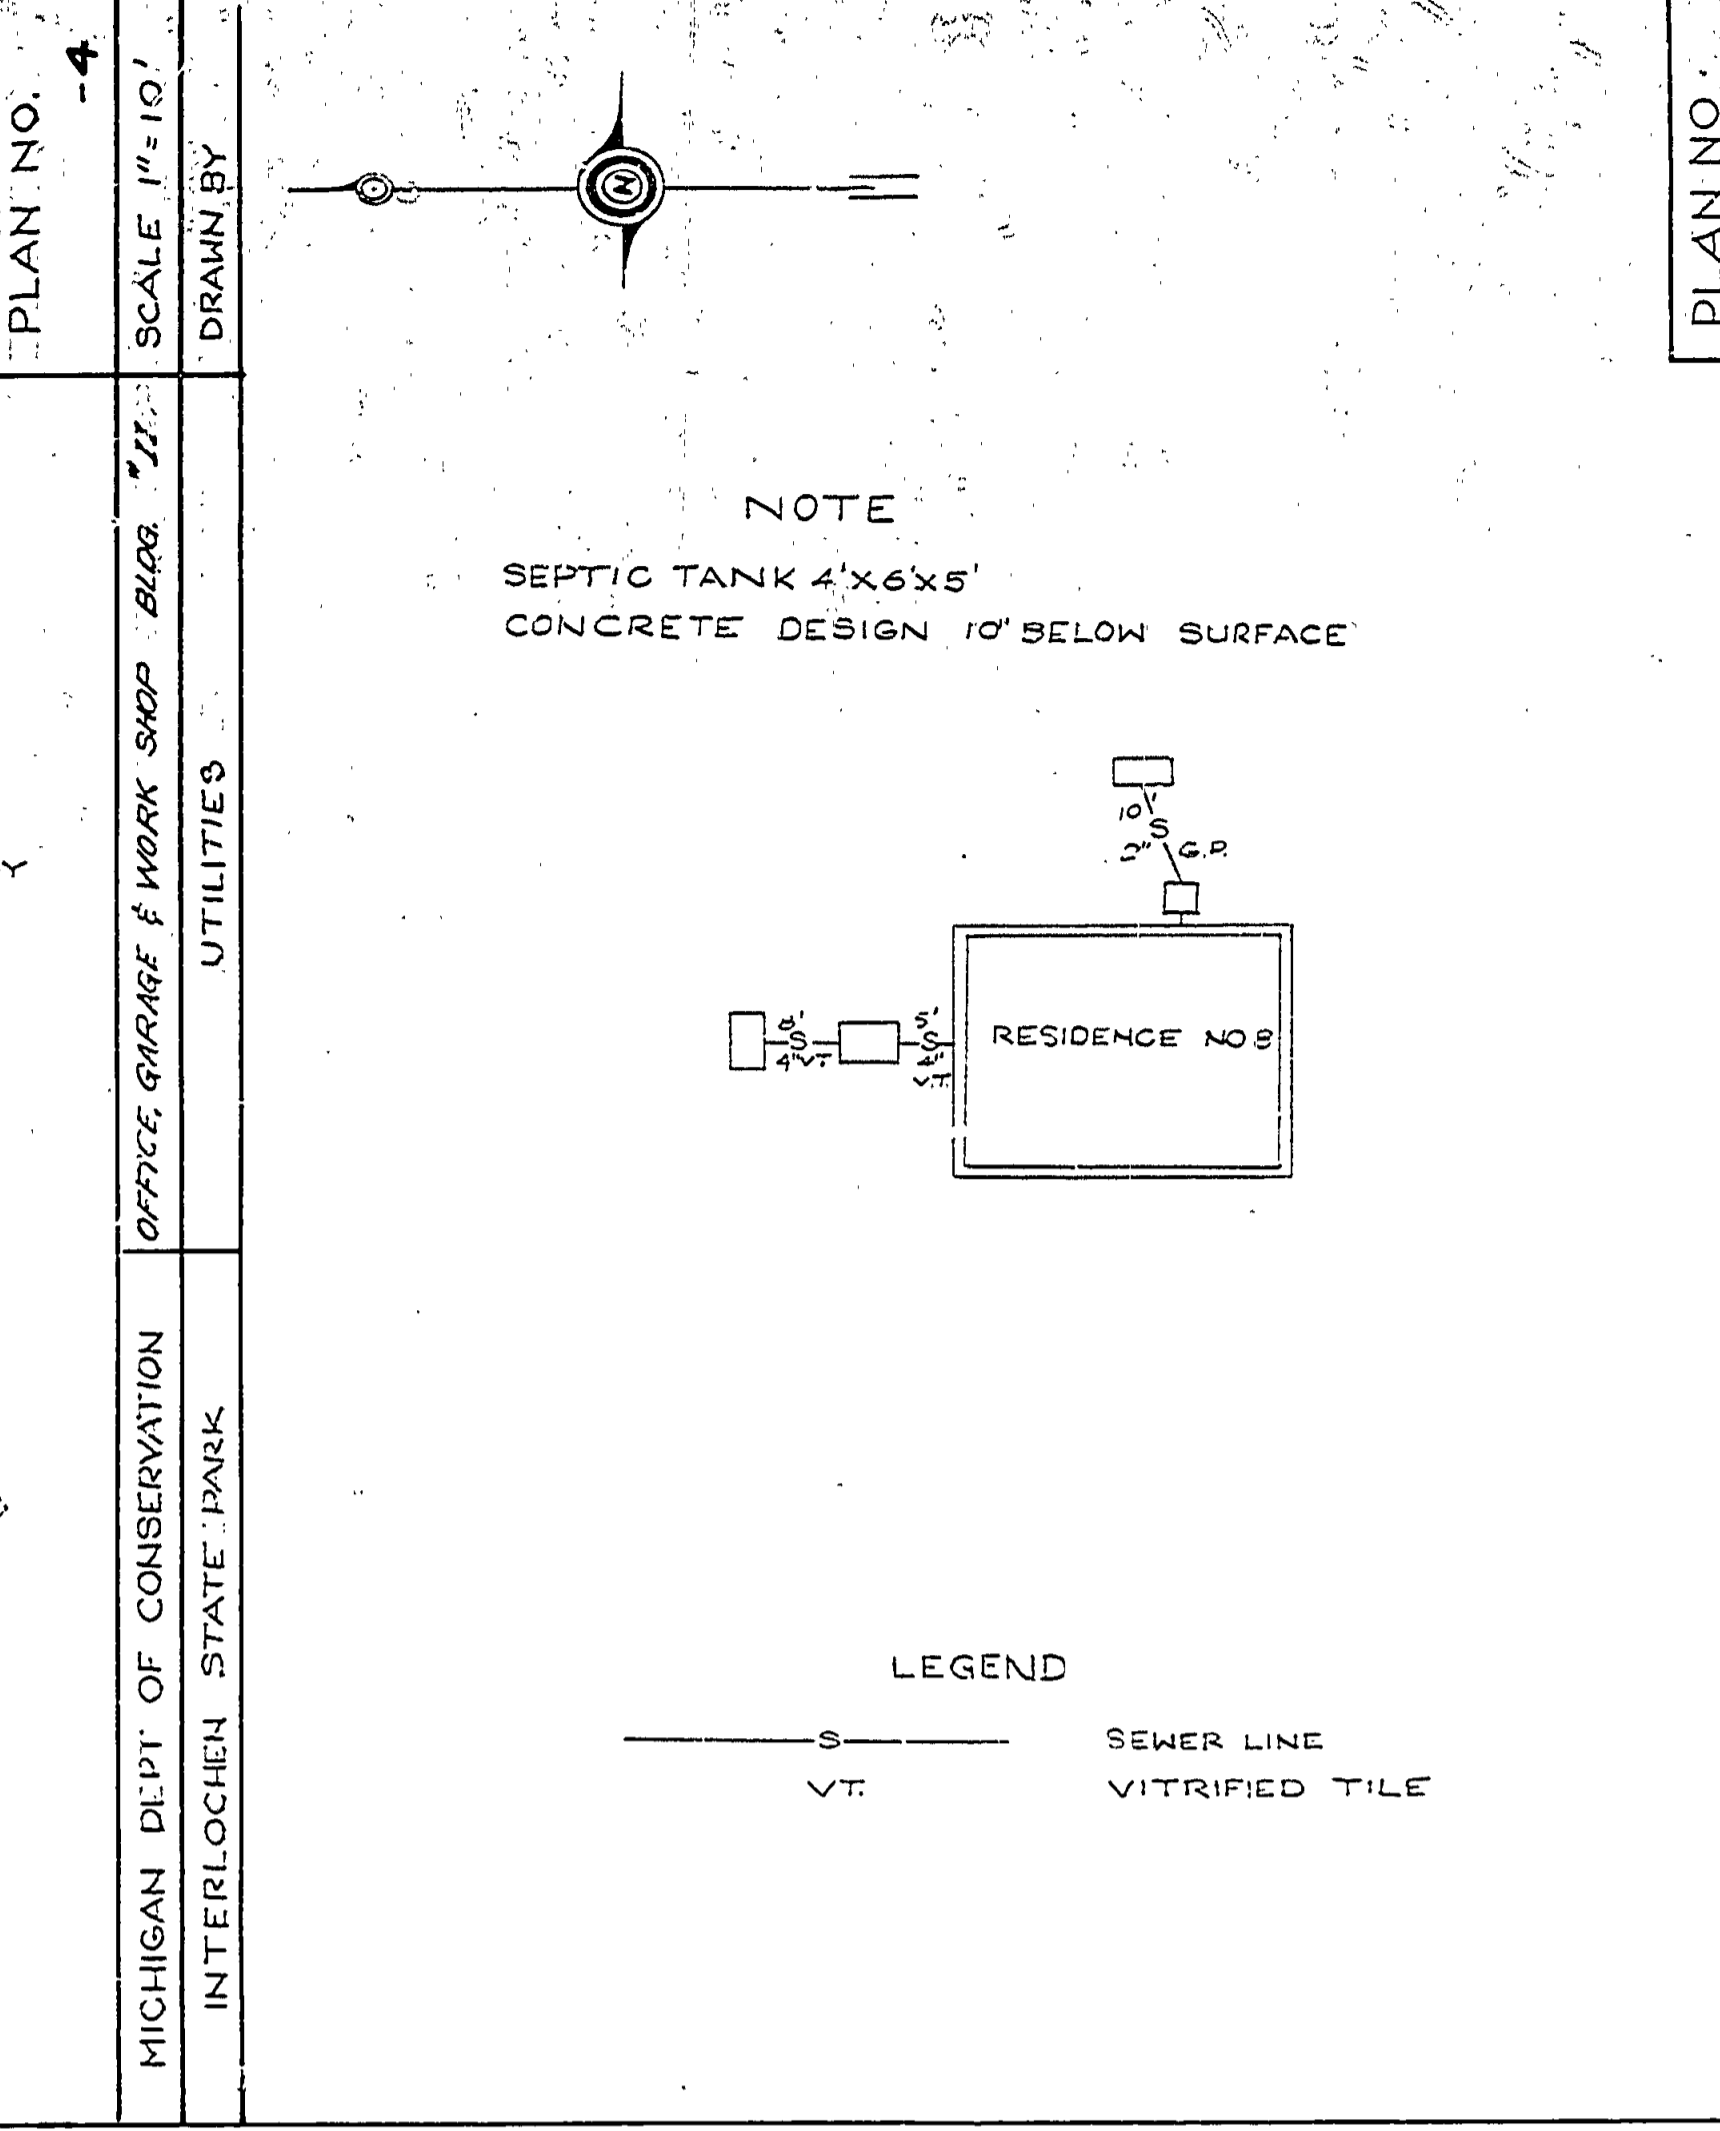
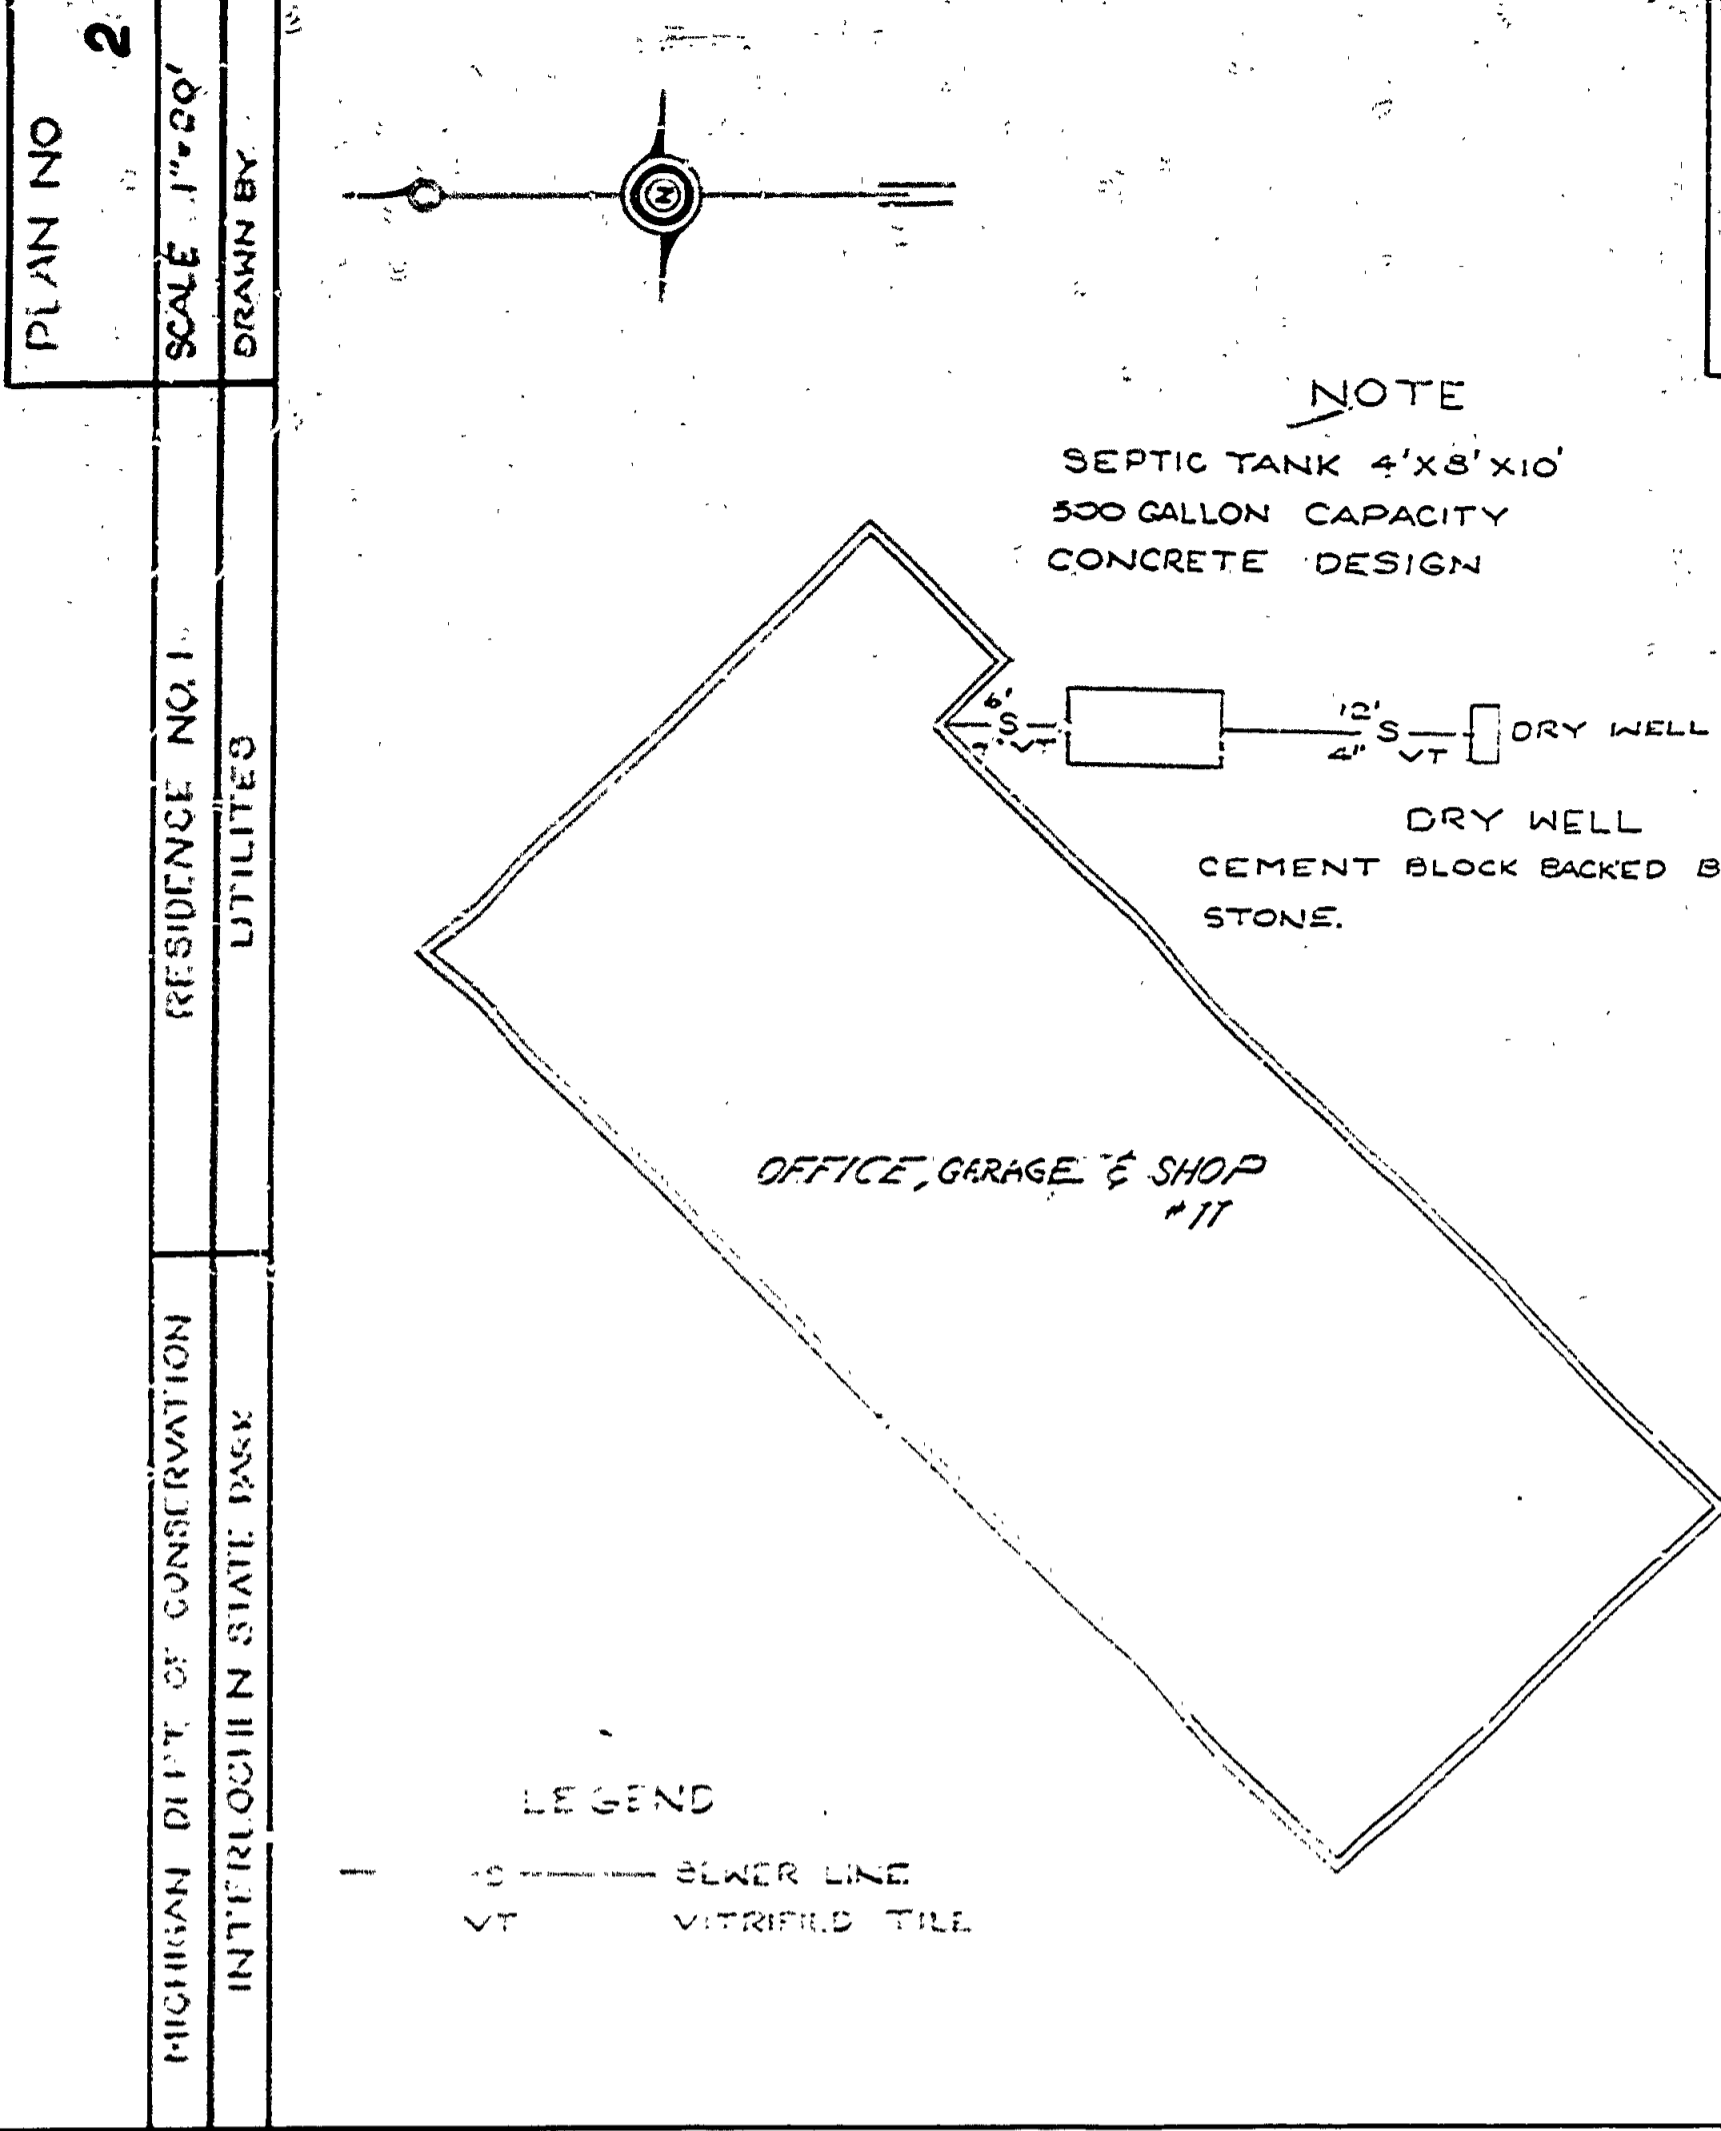
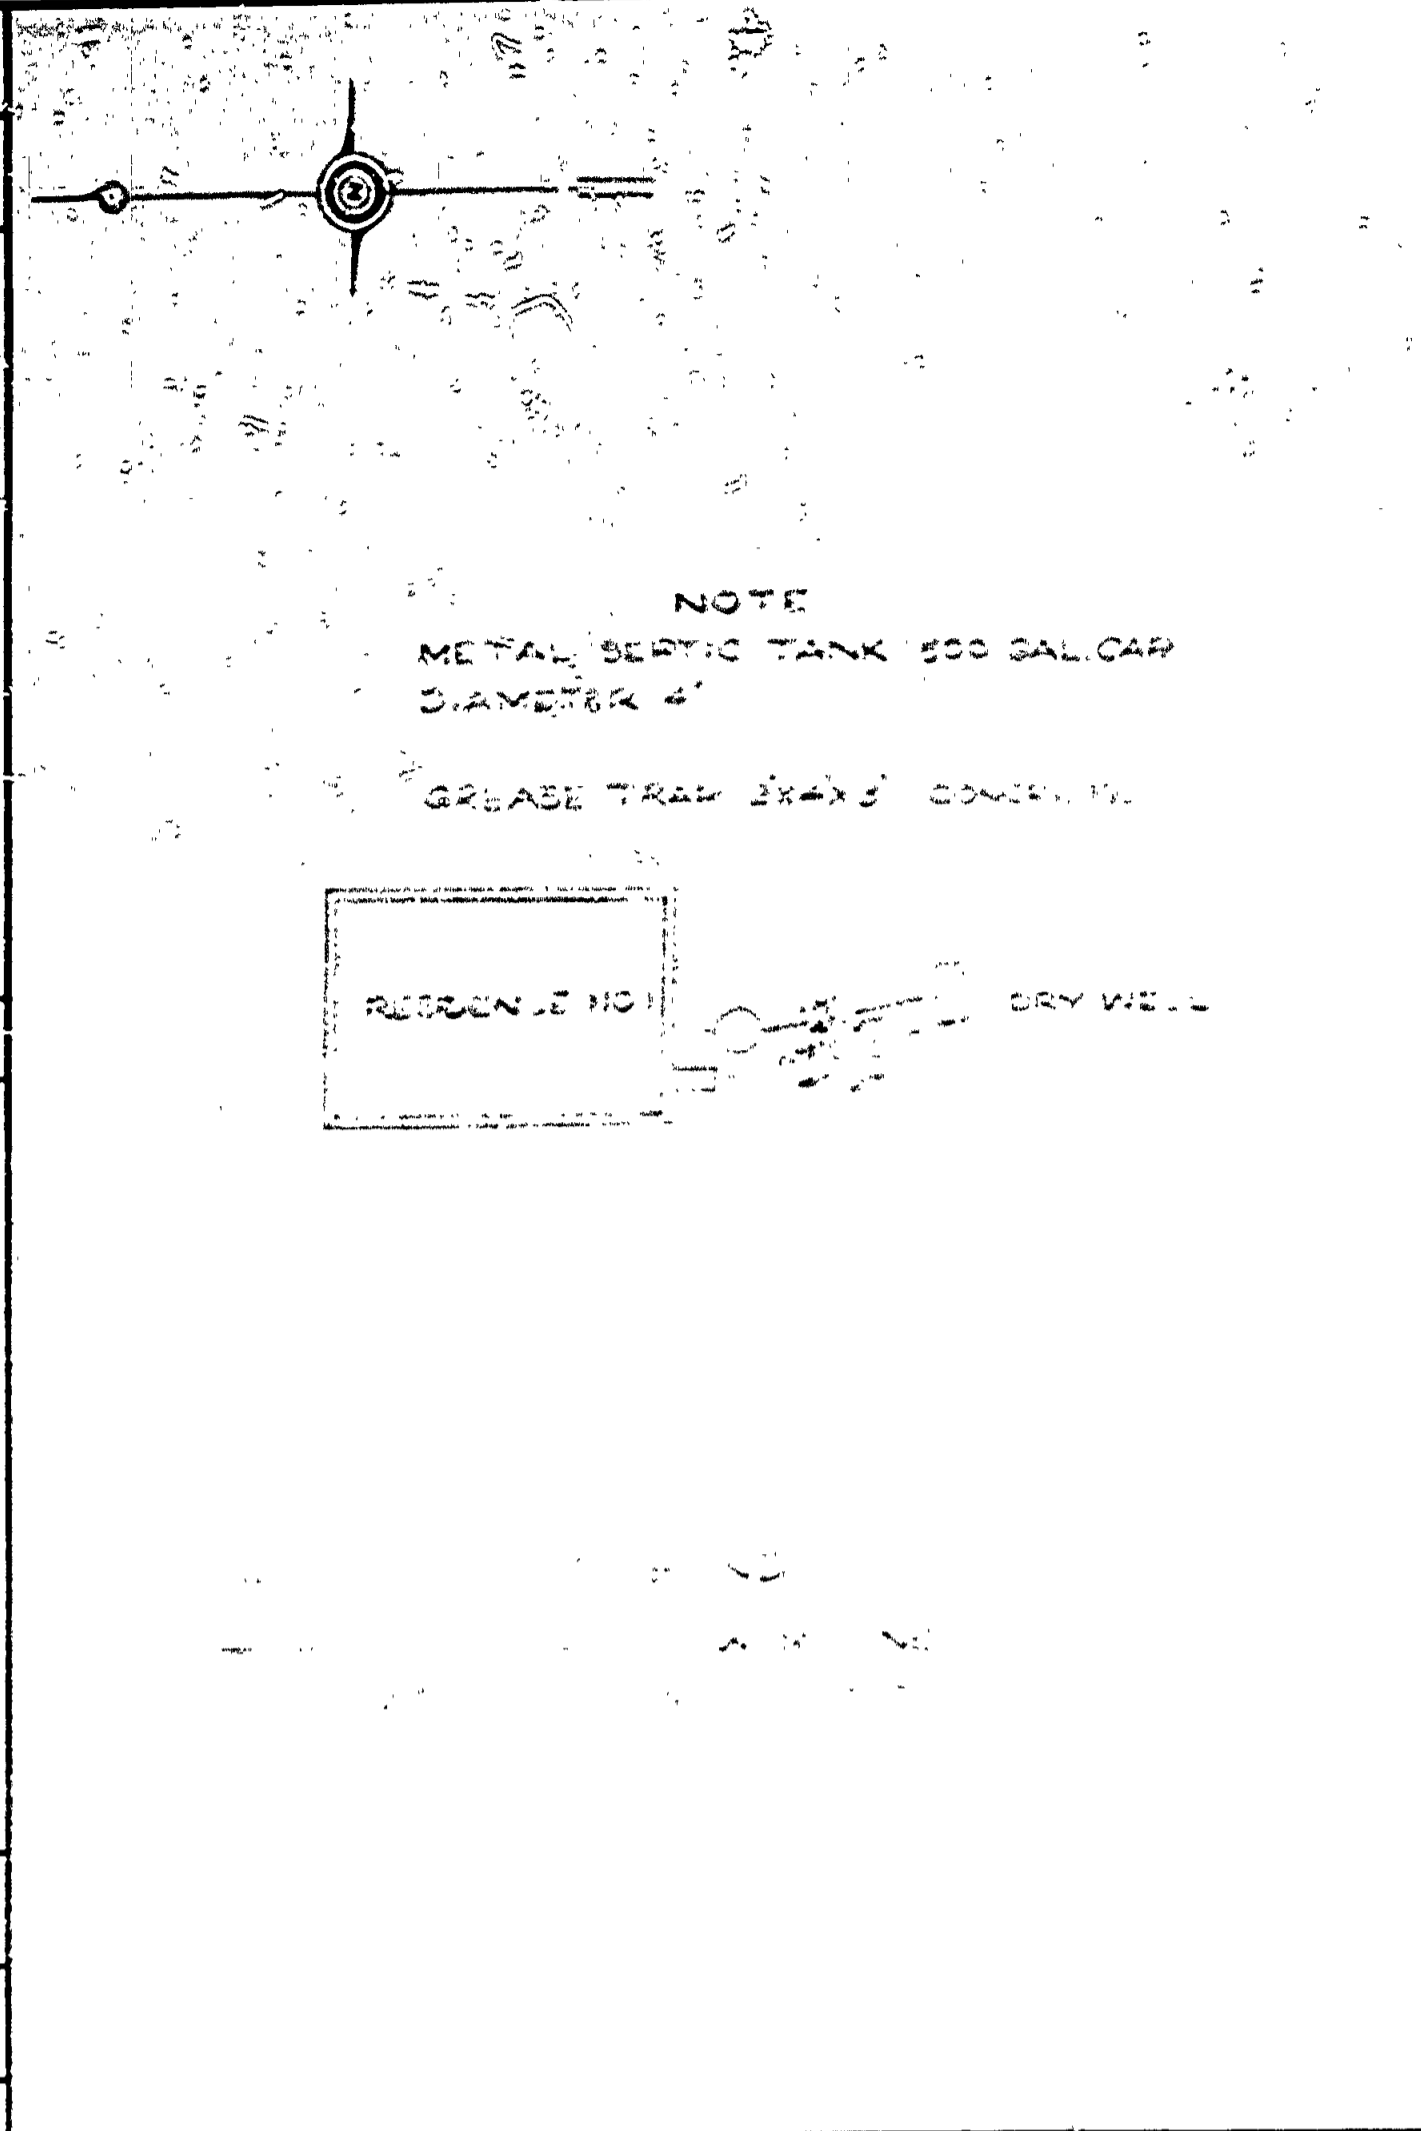
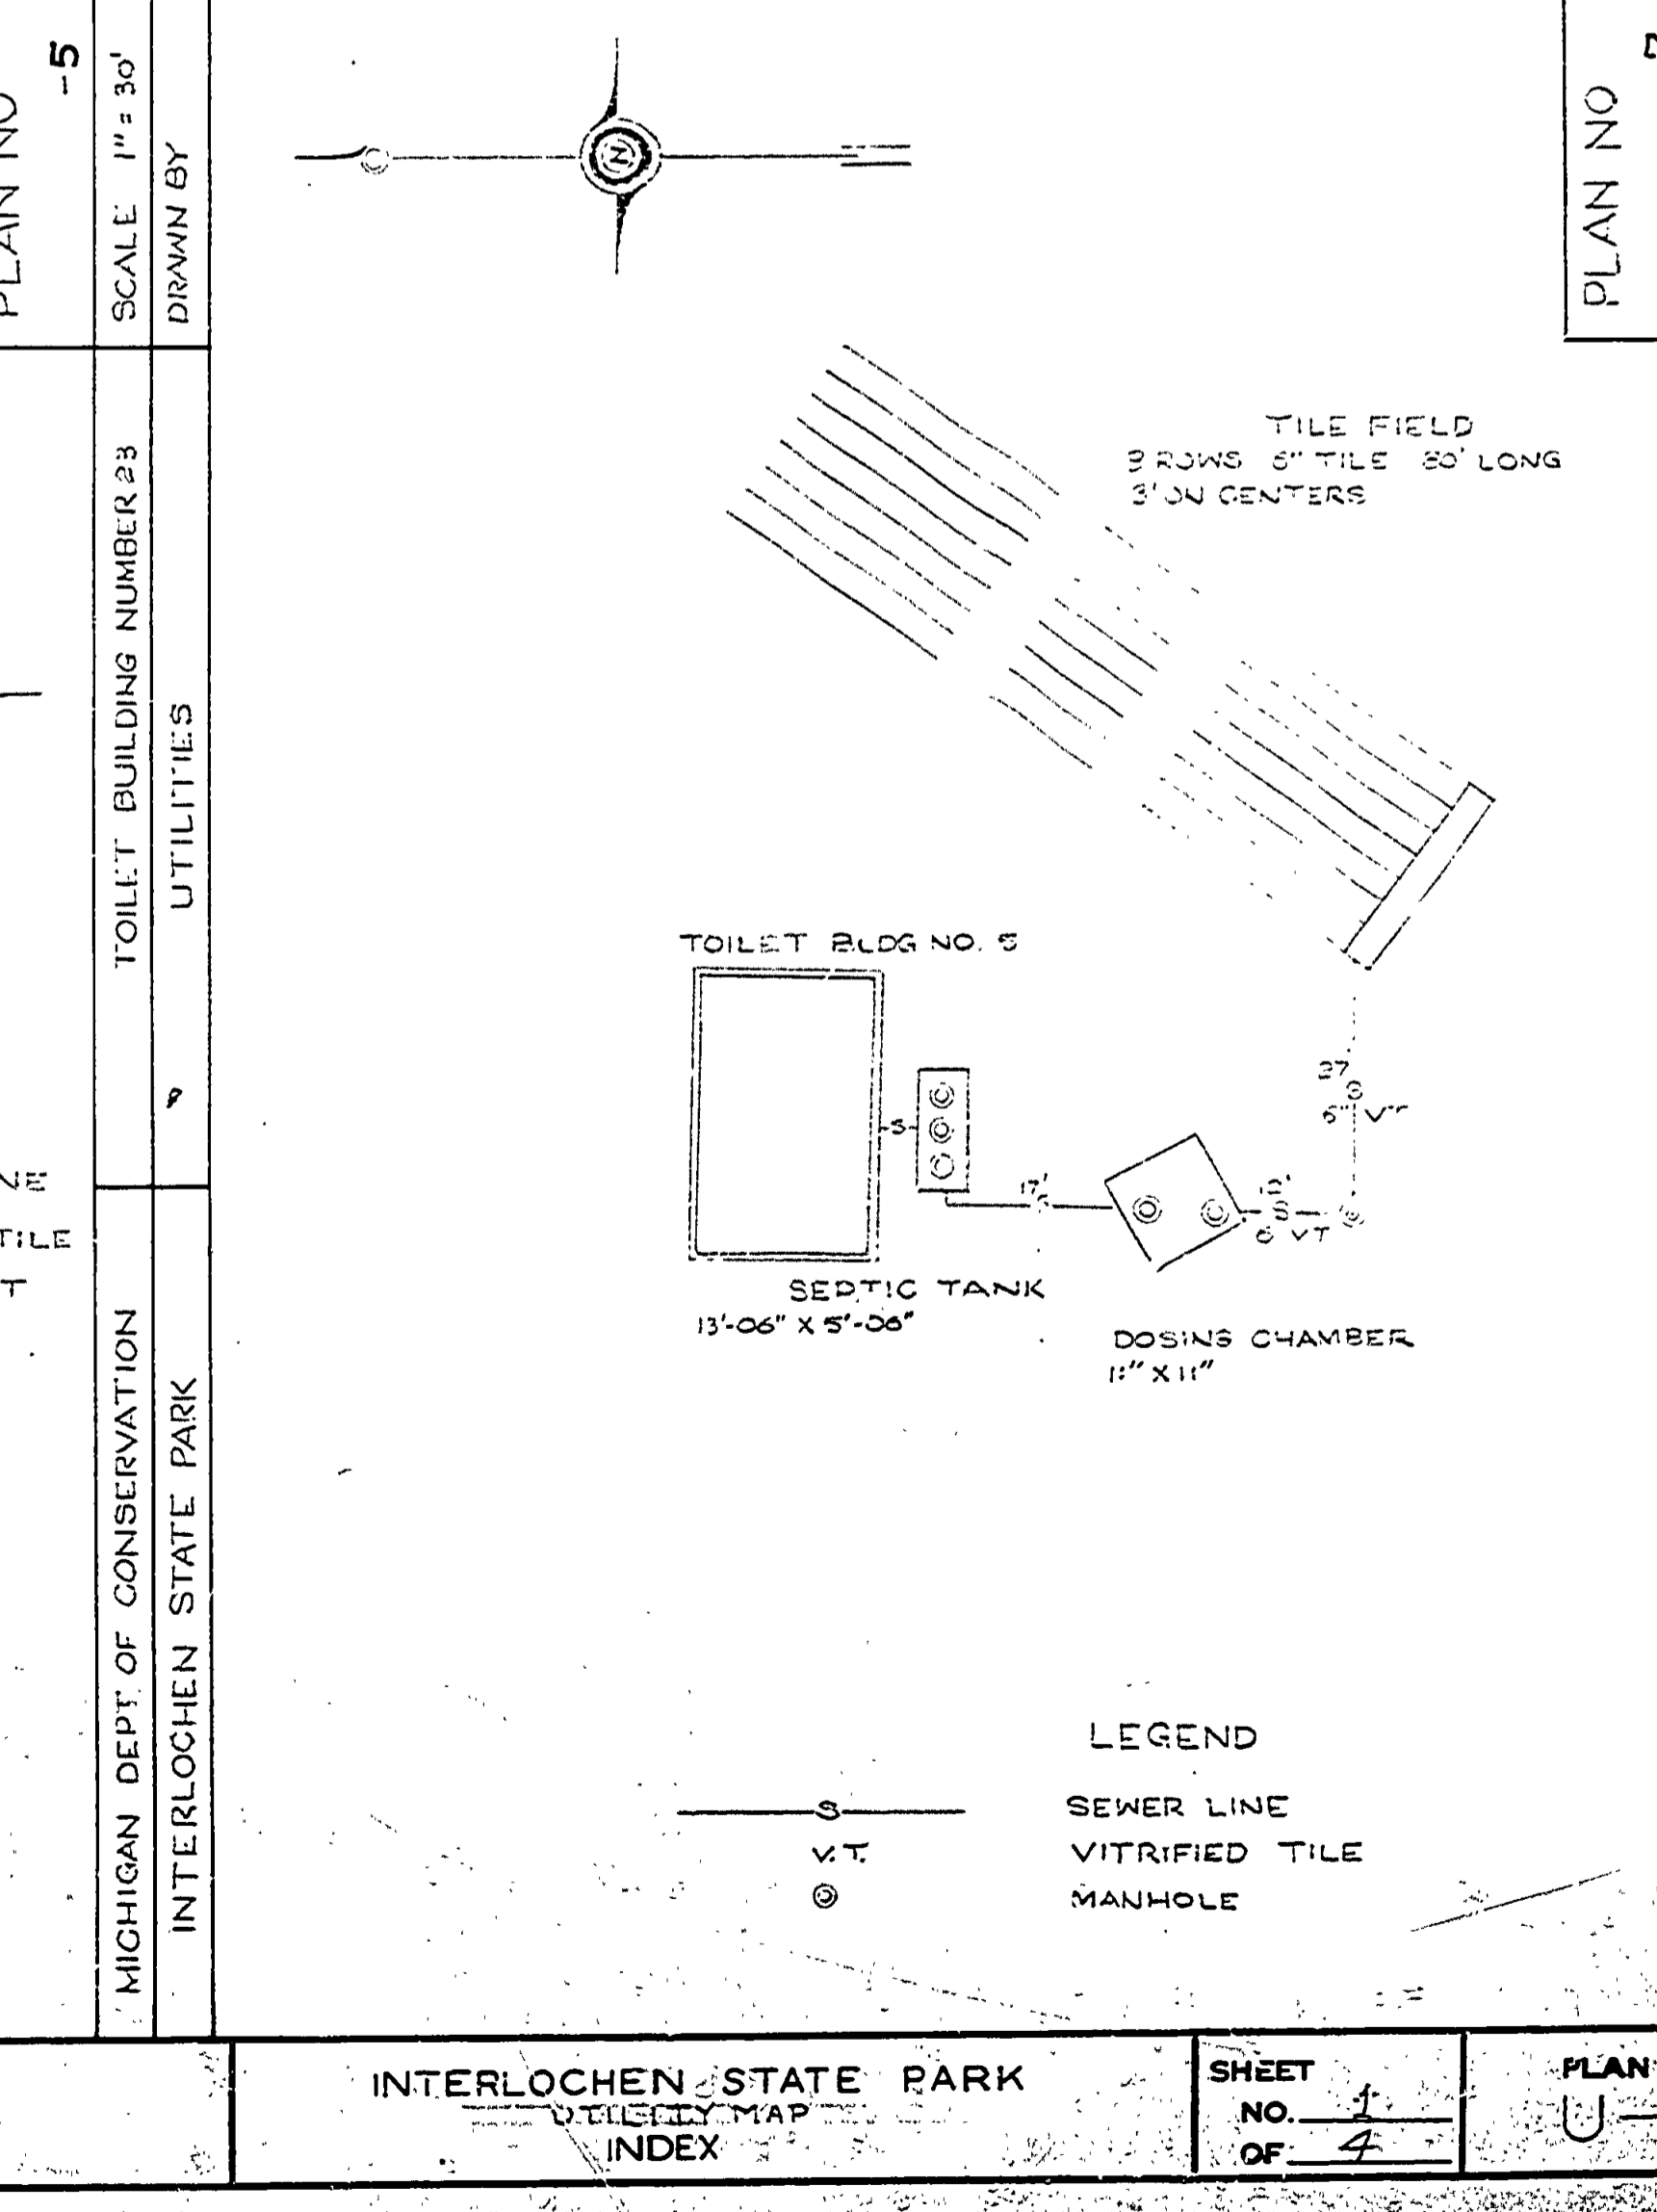


NO.	DATE	BY	REVISIONS
1			
2			
3			

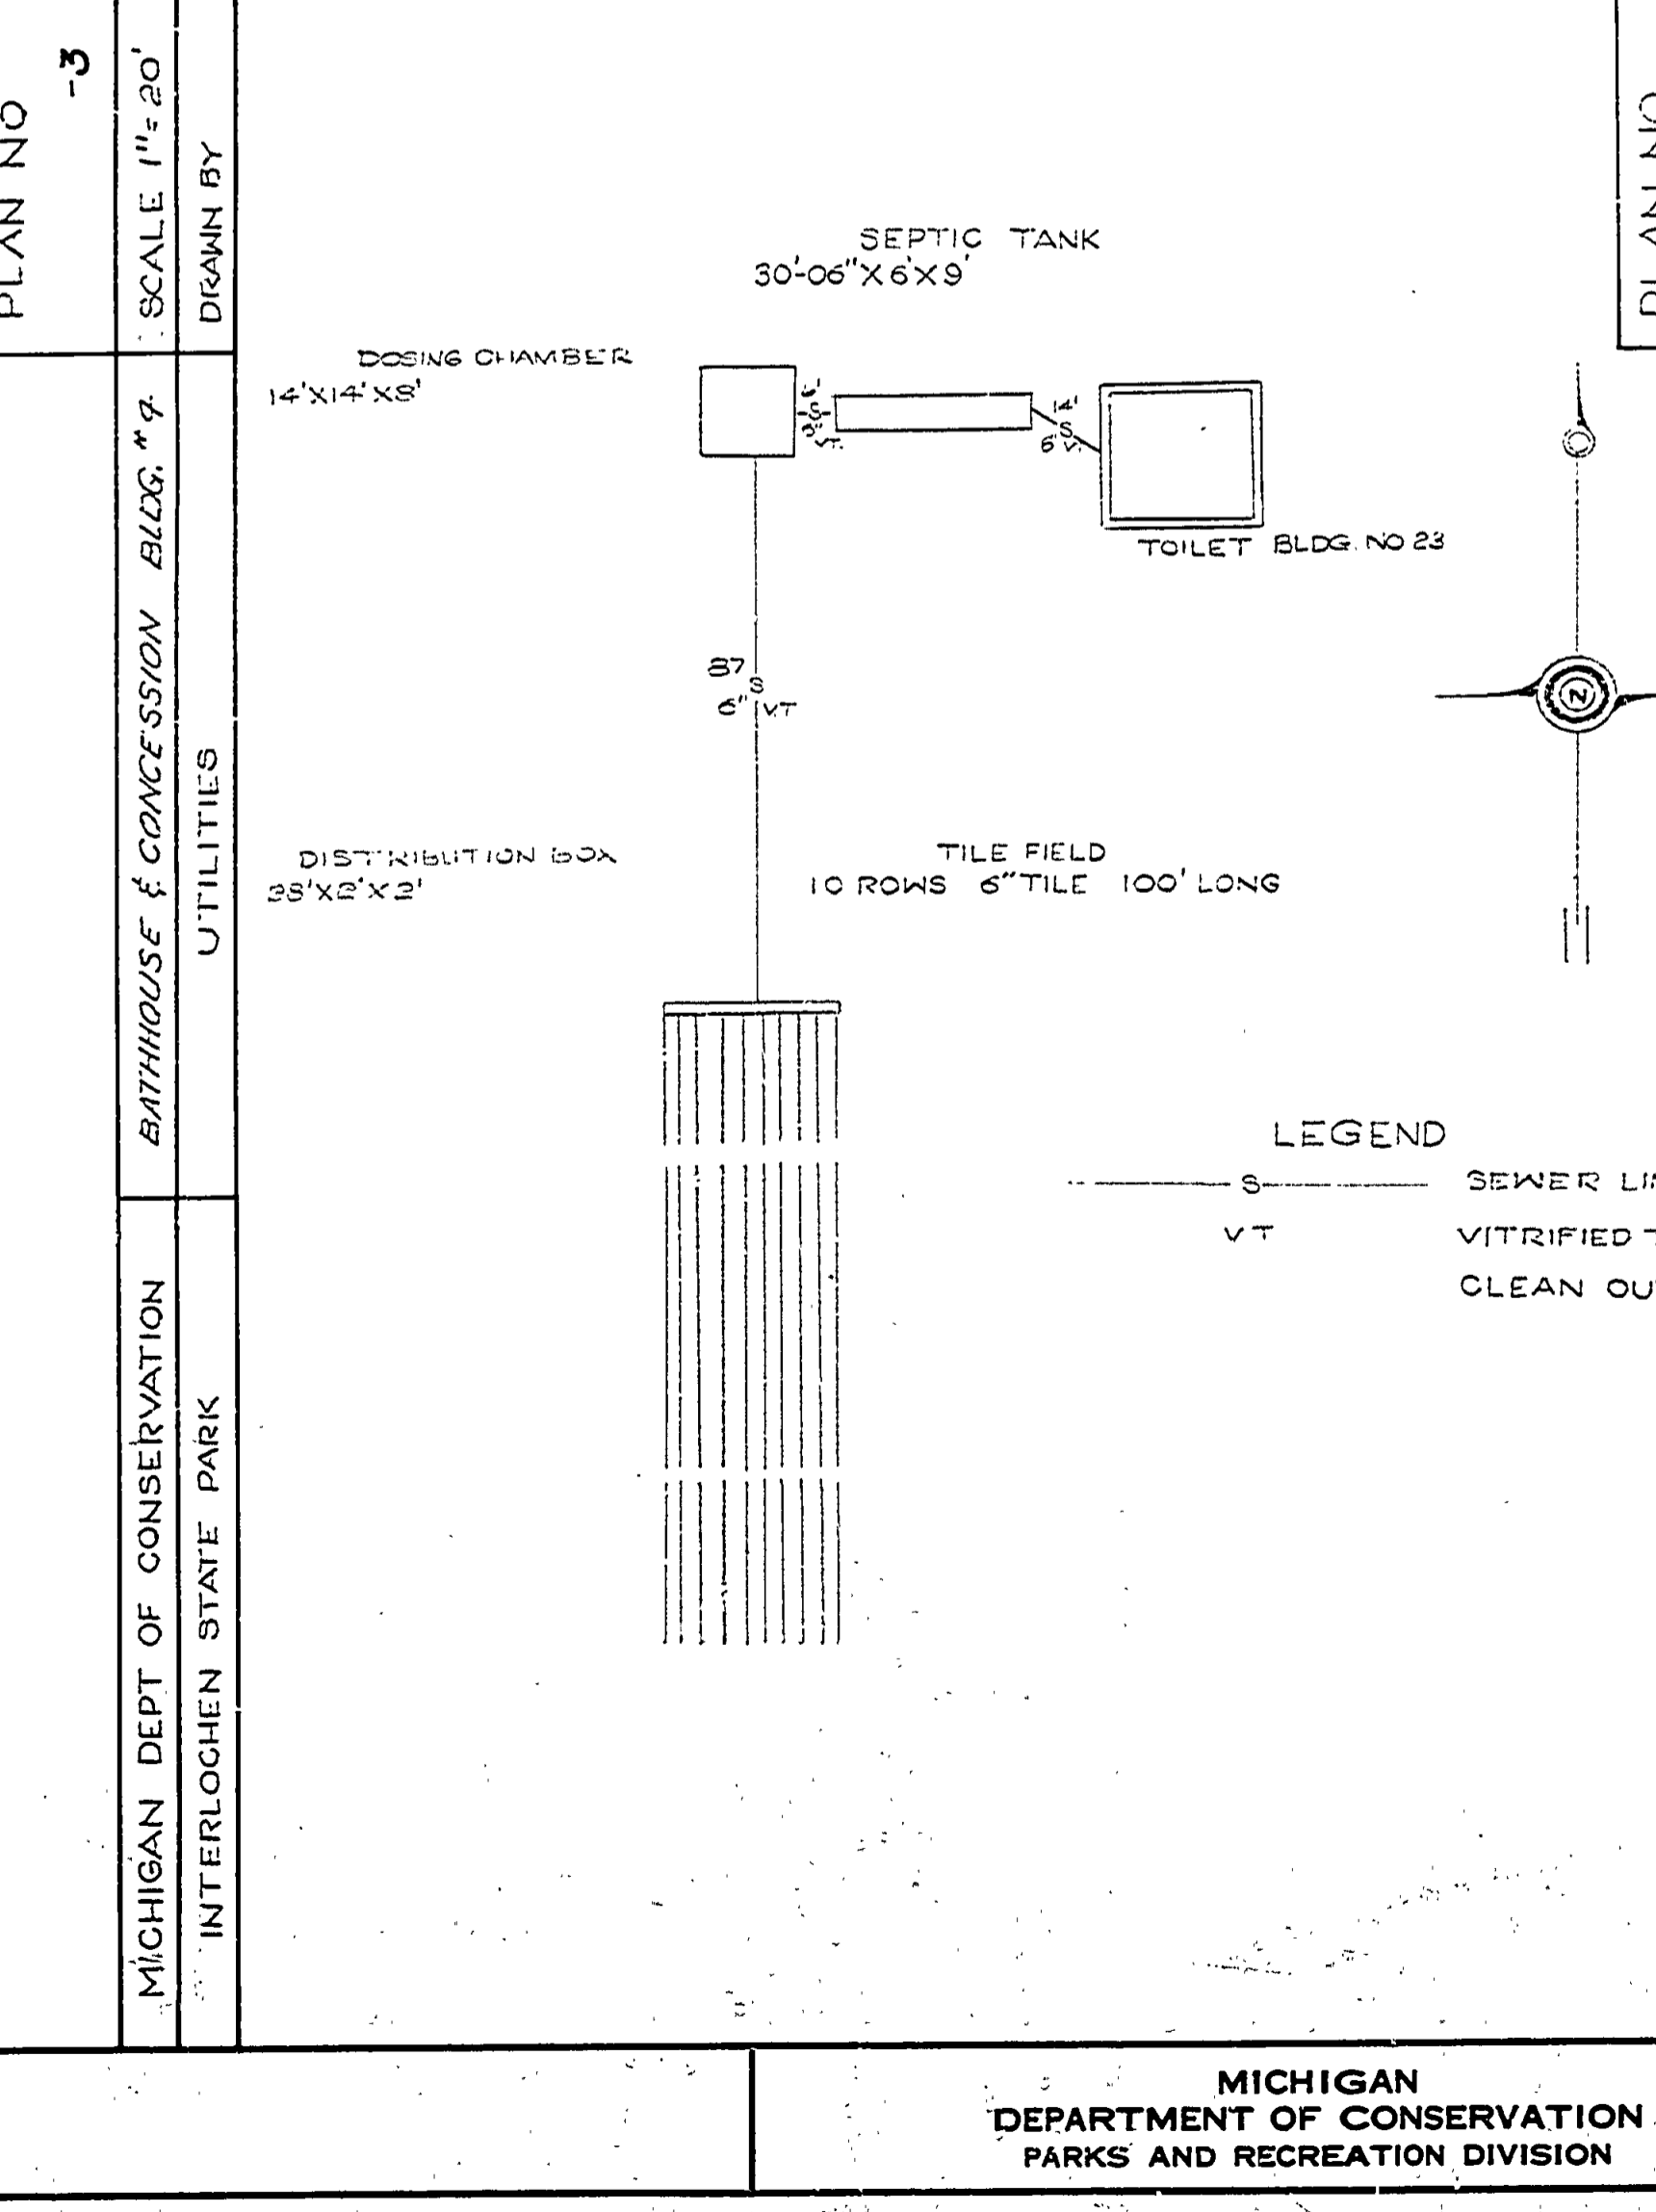

NO.	DATE	BY	REVISIONS
1			
2			
3			

DWS DASH NO.	BLDG. NO.	INDEX	DATE	APPROVED BY
-1	1	INDEX	3-9-59	A.C. Williams
-2	2	INDEX	3-9-59	A.C. Williams
-3	3	INDEX	3-9-59	A.C. Williams
-4	4	INDEX	3-9-59	A.C. Williams
-5	5	INDEX	3-9-59	A.C. Williams
-6	6	INDEX	3-9-59	A.C. Williams
-7	7	INDEX	3-9-59	A.C. Williams
-8	8	INDEX	3-9-59	A.C. Williams
-9	9	INDEX	3-9-59	A.C. Williams
-10	10	INDEX	3-9-59	A.C. Williams
-11	11	INDEX	3-9-59	A.C. Williams
-12	12	INDEX	3-9-59	A.C. Williams

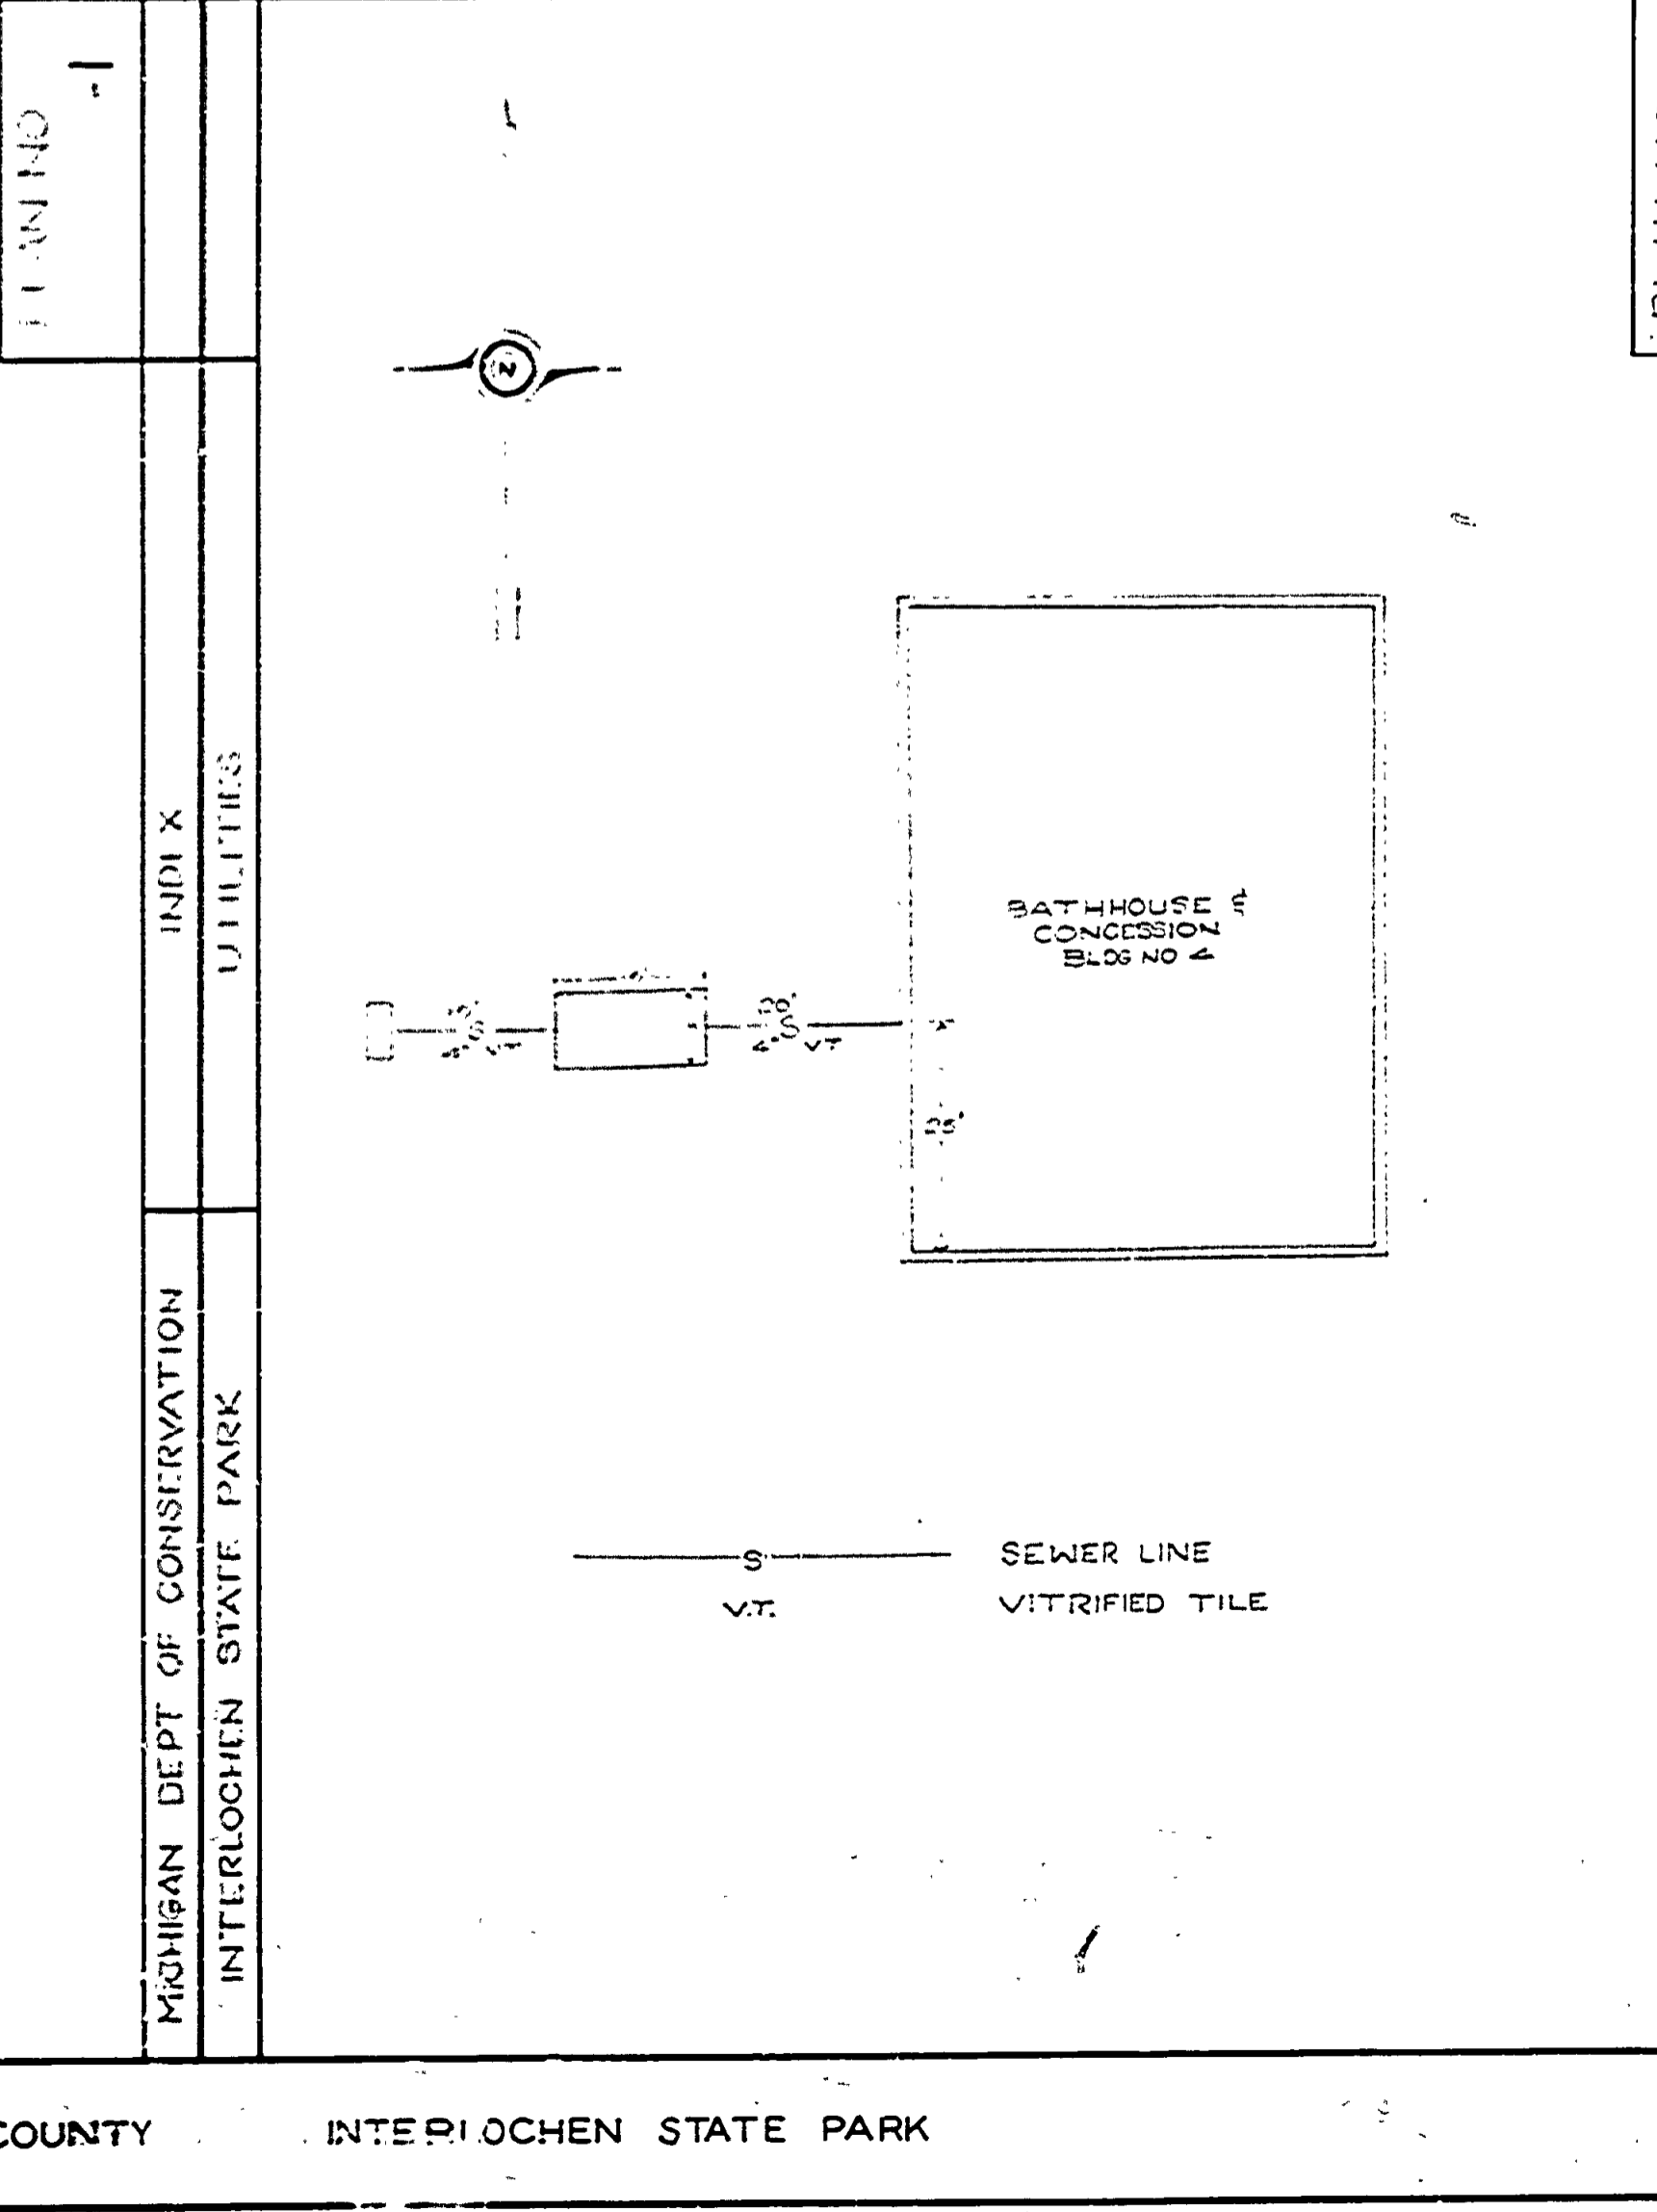

GRAND TRAVERSE COUNTY INTERLOCHEN STATE PARK

MICHIGAN DEPARTMENT OF CONSERVATION PARKS AND RECREATION DIVISION

INTERLOCHEN STATE PARK UTILITY MAP INDEX

SHEET NO. 4 OF 4

PLAN NO. 8