

P. H. HOEFT STATE PARK


Note on Pump house equipment.
Water Pump:
Make: Deming (turbine) 3 h.p. master motor.

Note on equipment at the Managers residence.
Water pump (electrical) K.C. type, 1 phase
1/2 h.p. - 115/230 Volts - 3450 r.p.m.
Model # SKC-18 E.D. AX w/ 30 gallon storage tank.
G.E. motor - Ser. # SJ4309 - Fig # 4950.

Water heater (electric)
Make: Sepco - 1951 model - 52 gallon capacity
PS 52 DT - Serial # A 42083

CAMPGROUND AREA

PICNIC AREA

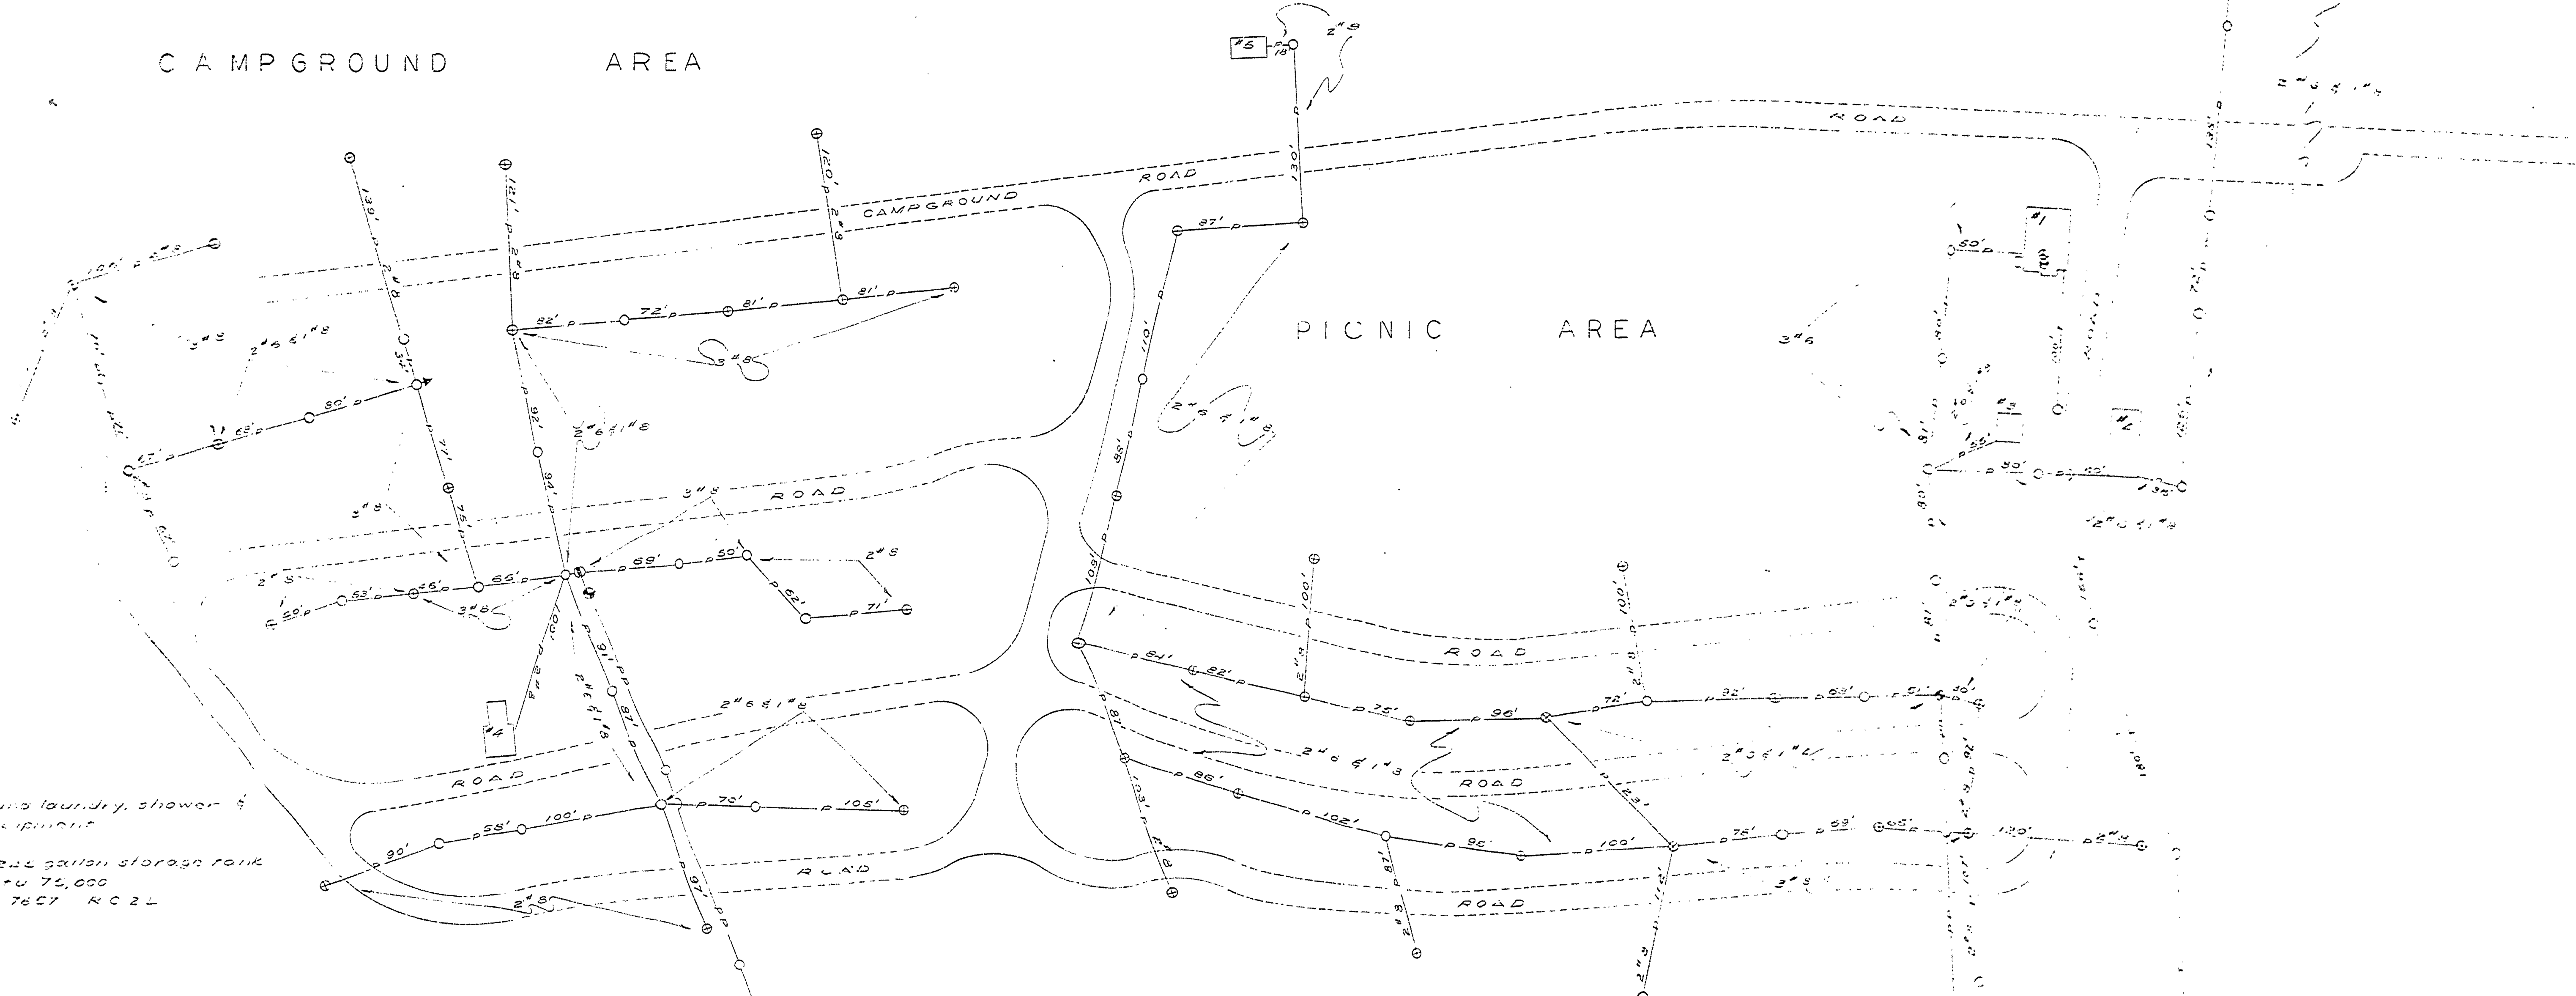

Note on Campground laundry, shower & toilet building equipment.
No heater.
Make: R-420M 42 gallon storage tank
Mount: 22-100, B-F 75,000
Serial: 12 6652 7657 RC 2 L

- BUILDING LEGEND**
- 1 MANAGERS RESIDENCE
 - 2 GARAGE & WORKSHOP
 - 3 UTILITY BUILDING & GARAGE
 - 4 CAMPGROUND LAUNDRY, SHOWER & TOILET
 - 5 CAMPGROUND LIBRARY
 - 6 PUMP HOUSE

- LEGEND**
- P — PUBLIC POWER LINE
 - P — PARK POWER LINE
 - UTILITY POLE
 - T — TELEPHONE LINE
 - UTILITY POLE w/ TRANSFORMER
 - UTILITY POLE w/ MAIN SWITCH & METER
 - UTILITY POLE w/ OUTLET BOX
 - UTILITY POLE w/ STREET LIGHT
 - ELECTRIC HEATER
 - ELECTRIC WATER PUMP
 - GAS HEATER (WATER)

DATE	REVIEWED	DATE	APPROVED	DATE	NO.	DATE	BY	REVISIONS	DATE	BY
	ARCHITECTURAL				1			4		
	ENGINEERING				2			5		
	LANDSCAPE				3			6		
DESIGNED BY										
DRAWN BY										
CHECKED BY										

P. H. HOEFT STATE PARK

SCALE: 1" = 60'-0"

MICHIGAN
DEPARTMENT OF CONSERVATION
PARKS AND RECREATION DIVISION

P. H. HOEFT STATE PARK
UTILITY MAP
ELECTRICAL DISTRIBUTION SYSTEM

SHEET NO. OF
PLAN NO.