

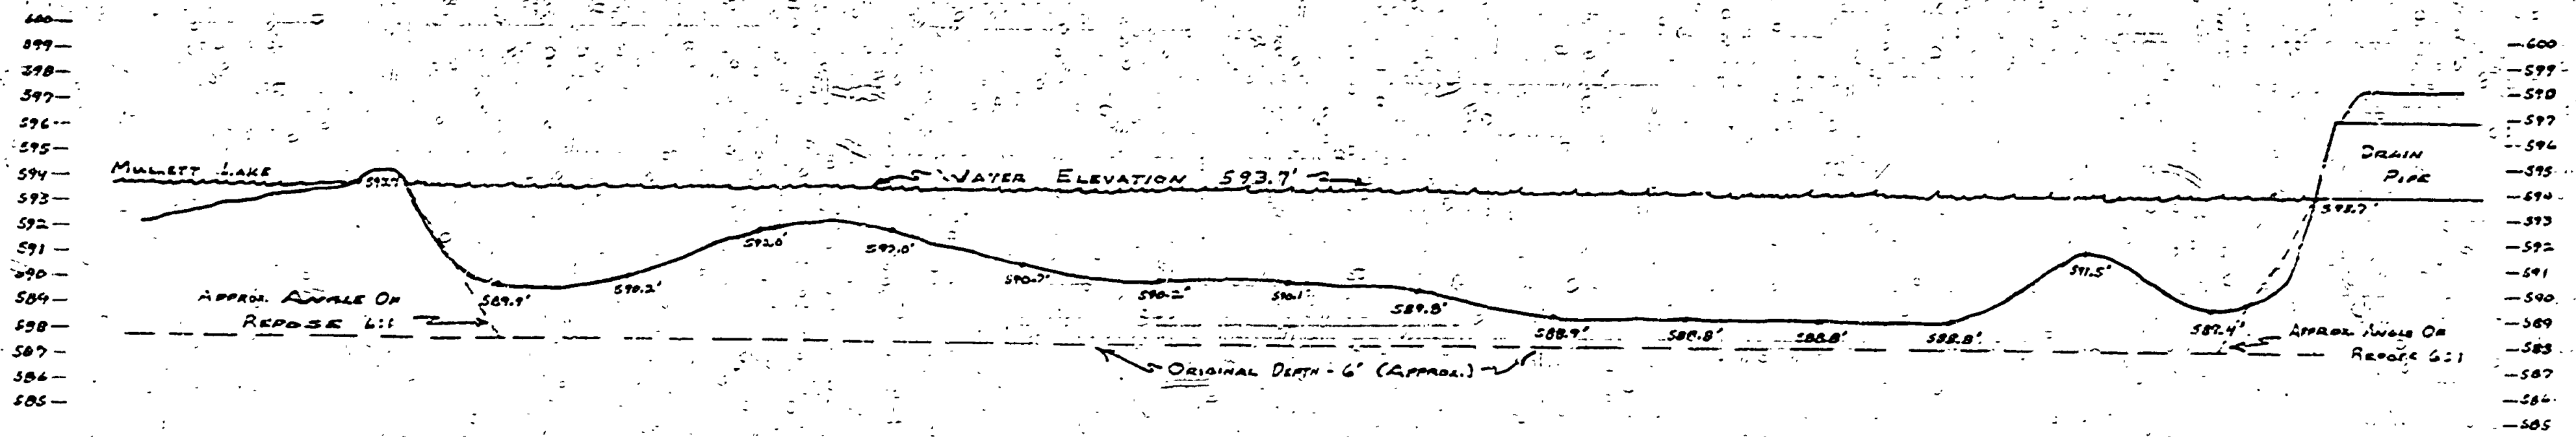


DRAWN BY	CHECKED BY	DATE	REVIEWED BY SECTIONS			DATE	APPROVED BY	NO.	DATE	BY	REVISIONS			DATE	BY
			ARCHITECTURAL	ENGINEERING	LANDSCAPE						1	2	3		

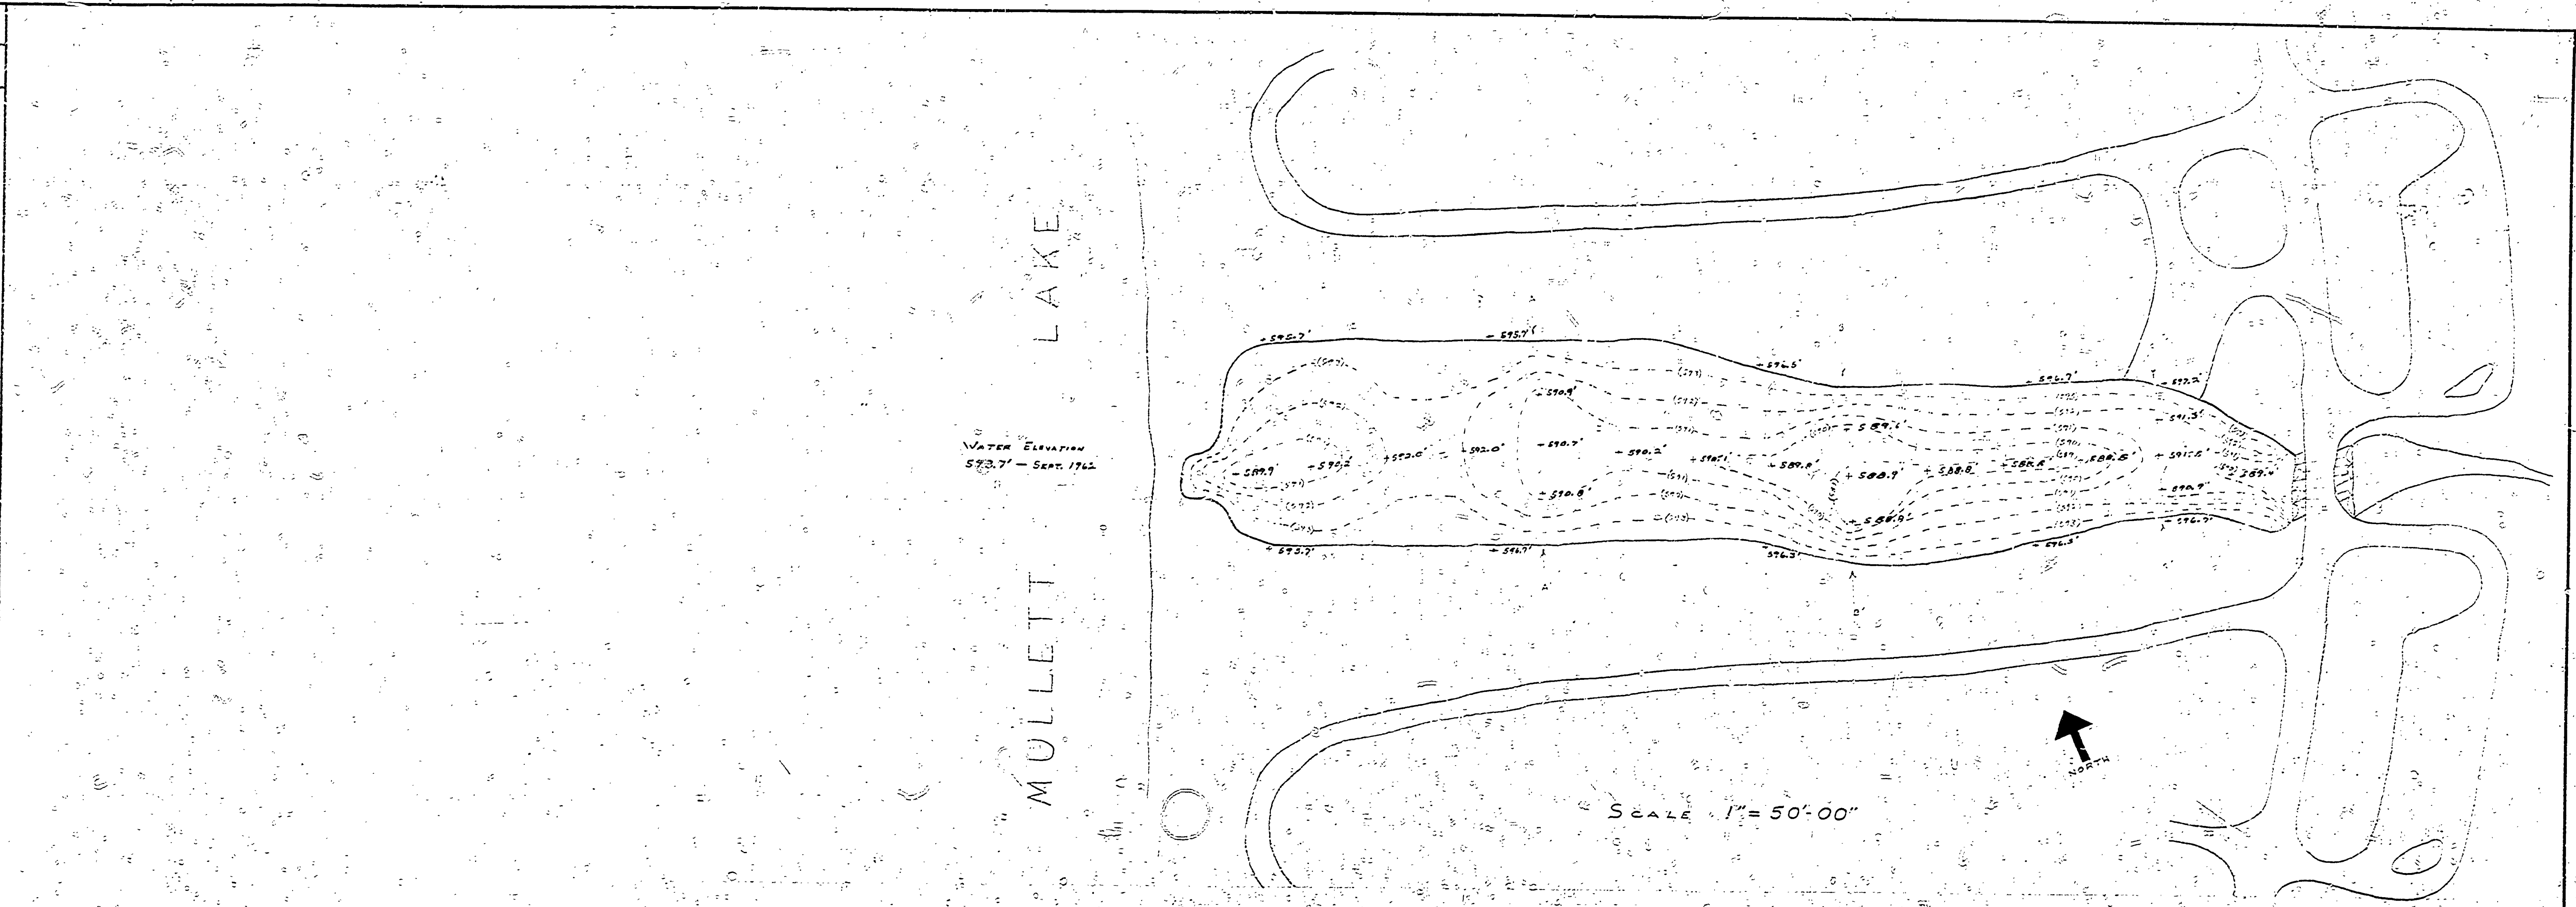

NOTE - CONTOURS BASED ON NEW DEPTHS SUPPLIED BY PARK MANAGER. SOUNDINGS TAKEN 1ST WEEK IN SEPTEMBER, 1970. CORRECTIONS MADE FROM LAKE ELEVATION OF 593.7' - SEPT. 1962. ORIGINALLY LAGOON WAS APPROX. 6' DEEP WITH ANGLE OF REPOSE OF 1:4 TO 1:10.

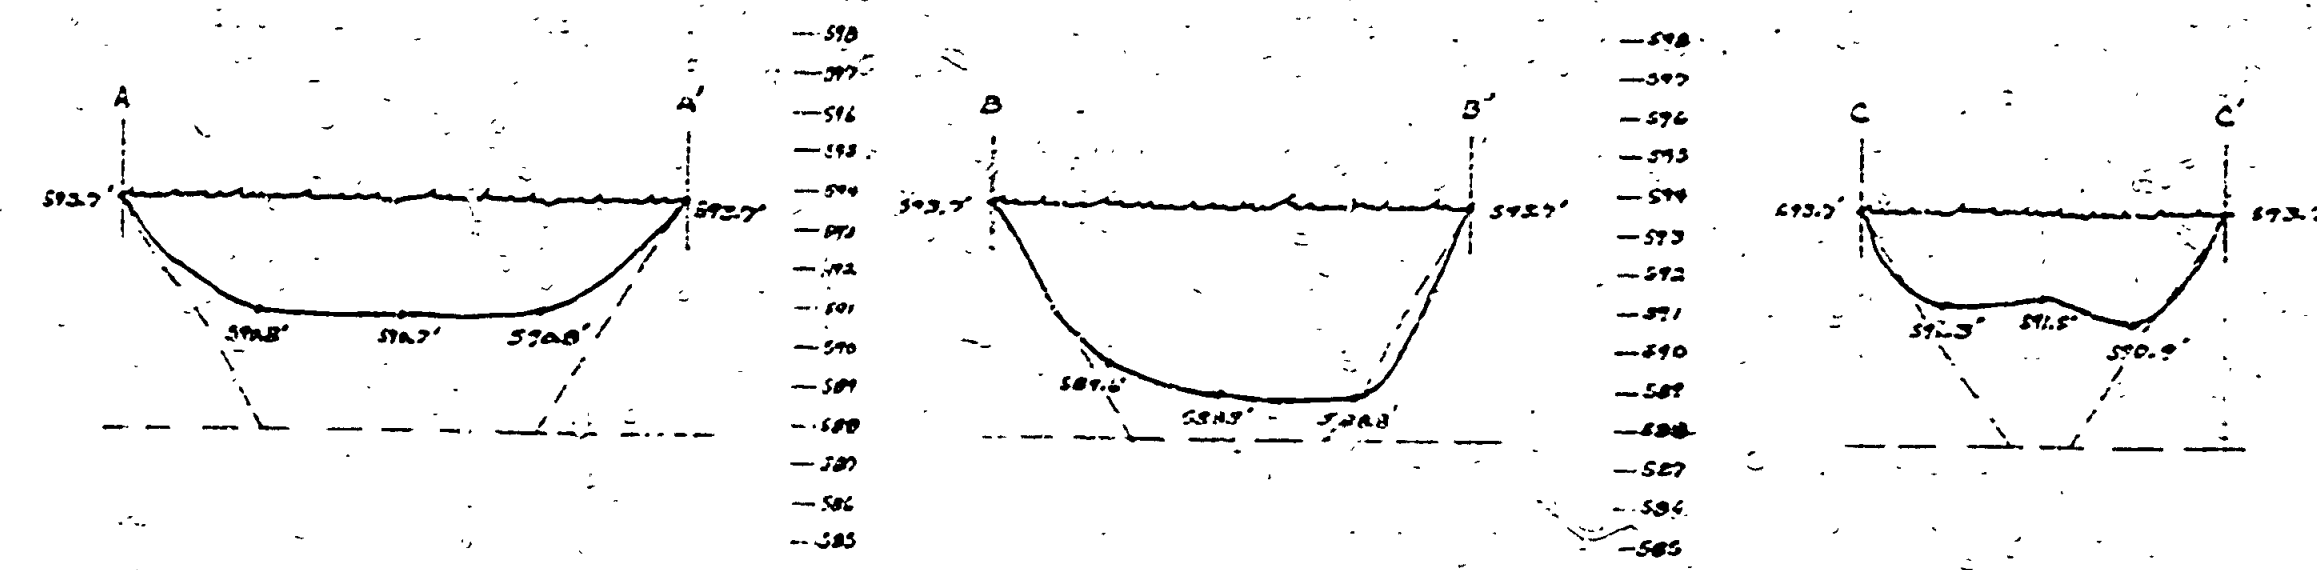

SCALE: HORIZONTAL - 1" = 50'-00"
VERTICAL - 1" = 5'-00"

BOAT BASIN - ALOHA STATE PARK

MICHIGAN DEPARTMENT OF CONSERVATION PARKS AND RECREATION DIVISION

SHEET NO. 2 OF 2 PLAN NO. L-108