



DESIGNED BY	DATE	REVIEWED	DATE	APPROVED	DATE NO.	DATE BY	REVISIONS
B.H.G.	Oct. 62	ARCHITECTURAL	10/12/62		1	10/13/62	Revised As Shown Ex. Construction
D.M.G.	Oct. 62	ENGINEERING	10/12/62		2	10/13/62	Sanitation Station Added
B.H.G.	Dec. 62	LANDSCAPE	12/18/62		3	1/24/63	
					4		
					5		
					6		

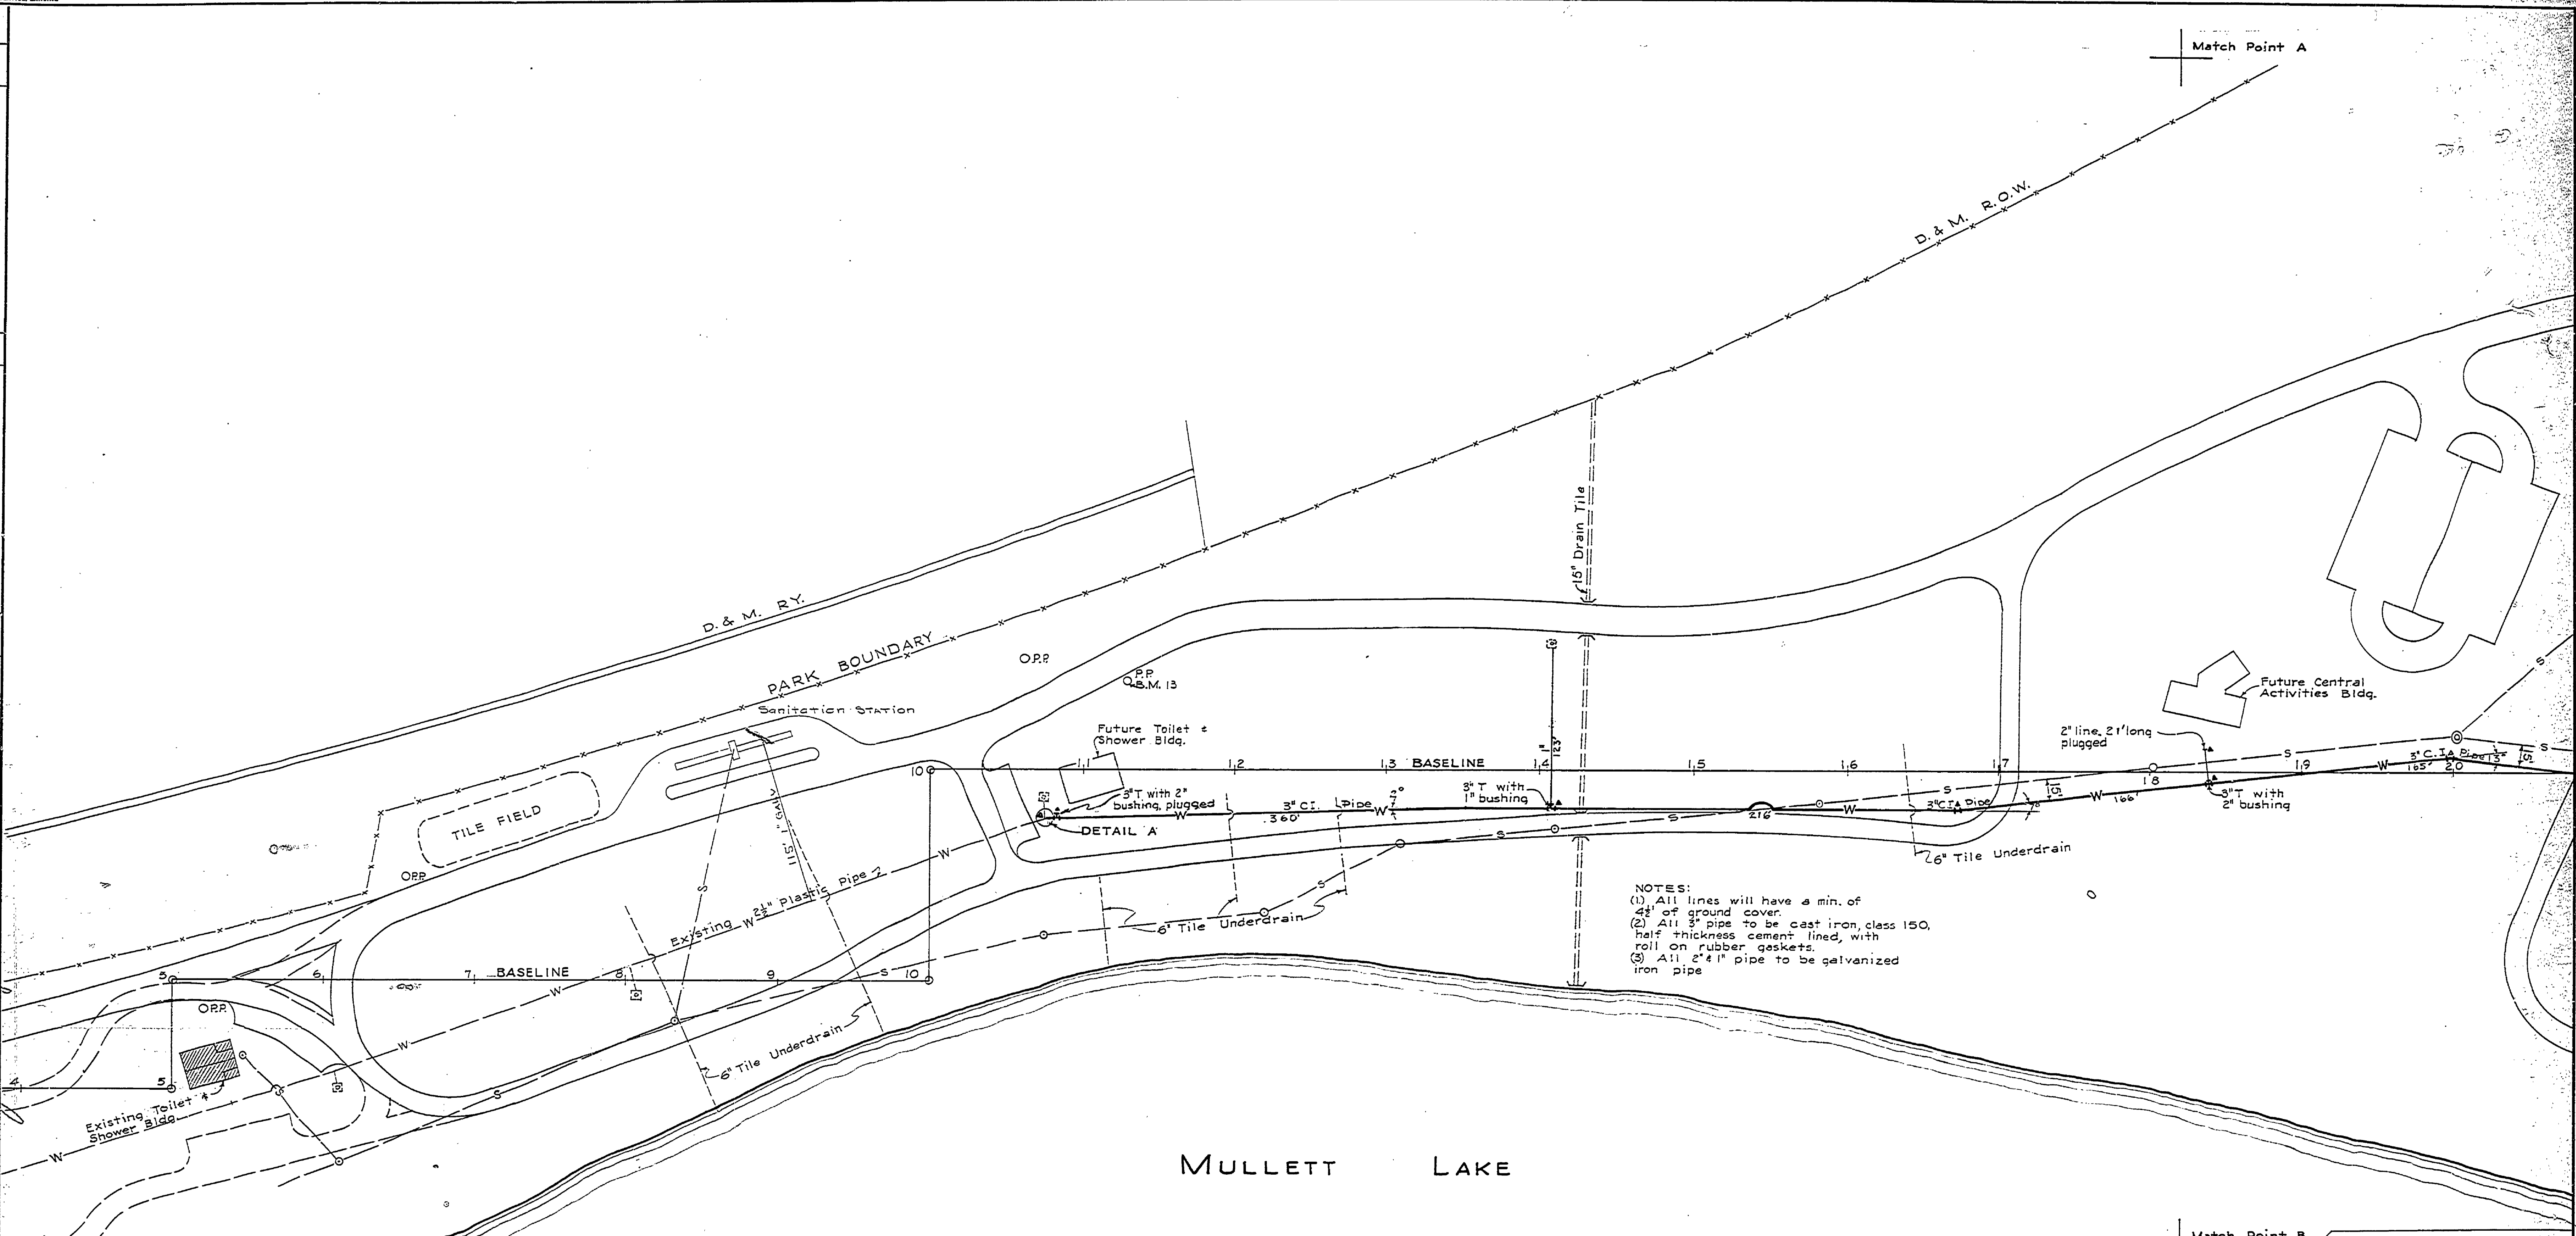


NOTES:  
 (1) All lines will have a min. of 4" of ground cover.  
 (2) All 3" pipe to be cast iron, class 150, half thickness cement lined, with roll on rubber gaskets.  
 (3) All 2" pipe to be galvanized iron pipe

- LEGEND**
- S- EXISTING SEWER LINE
  - O- EXISTING MANHOLE
  - W- EXISTING WATER LINE
  - W- PROPOSED WATER LINE
  - EXISTING DRINKING FOUNTAIN
  - PROPOSED DRINKING FOUNTAIN
  - △- CONCRETE POST MARKER

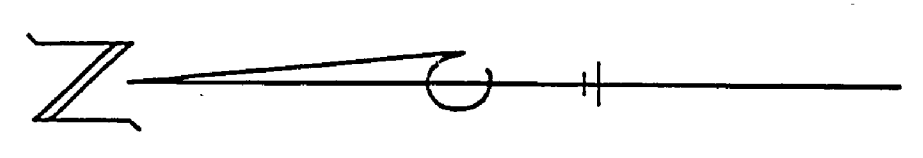

SCALE 1" = 50'

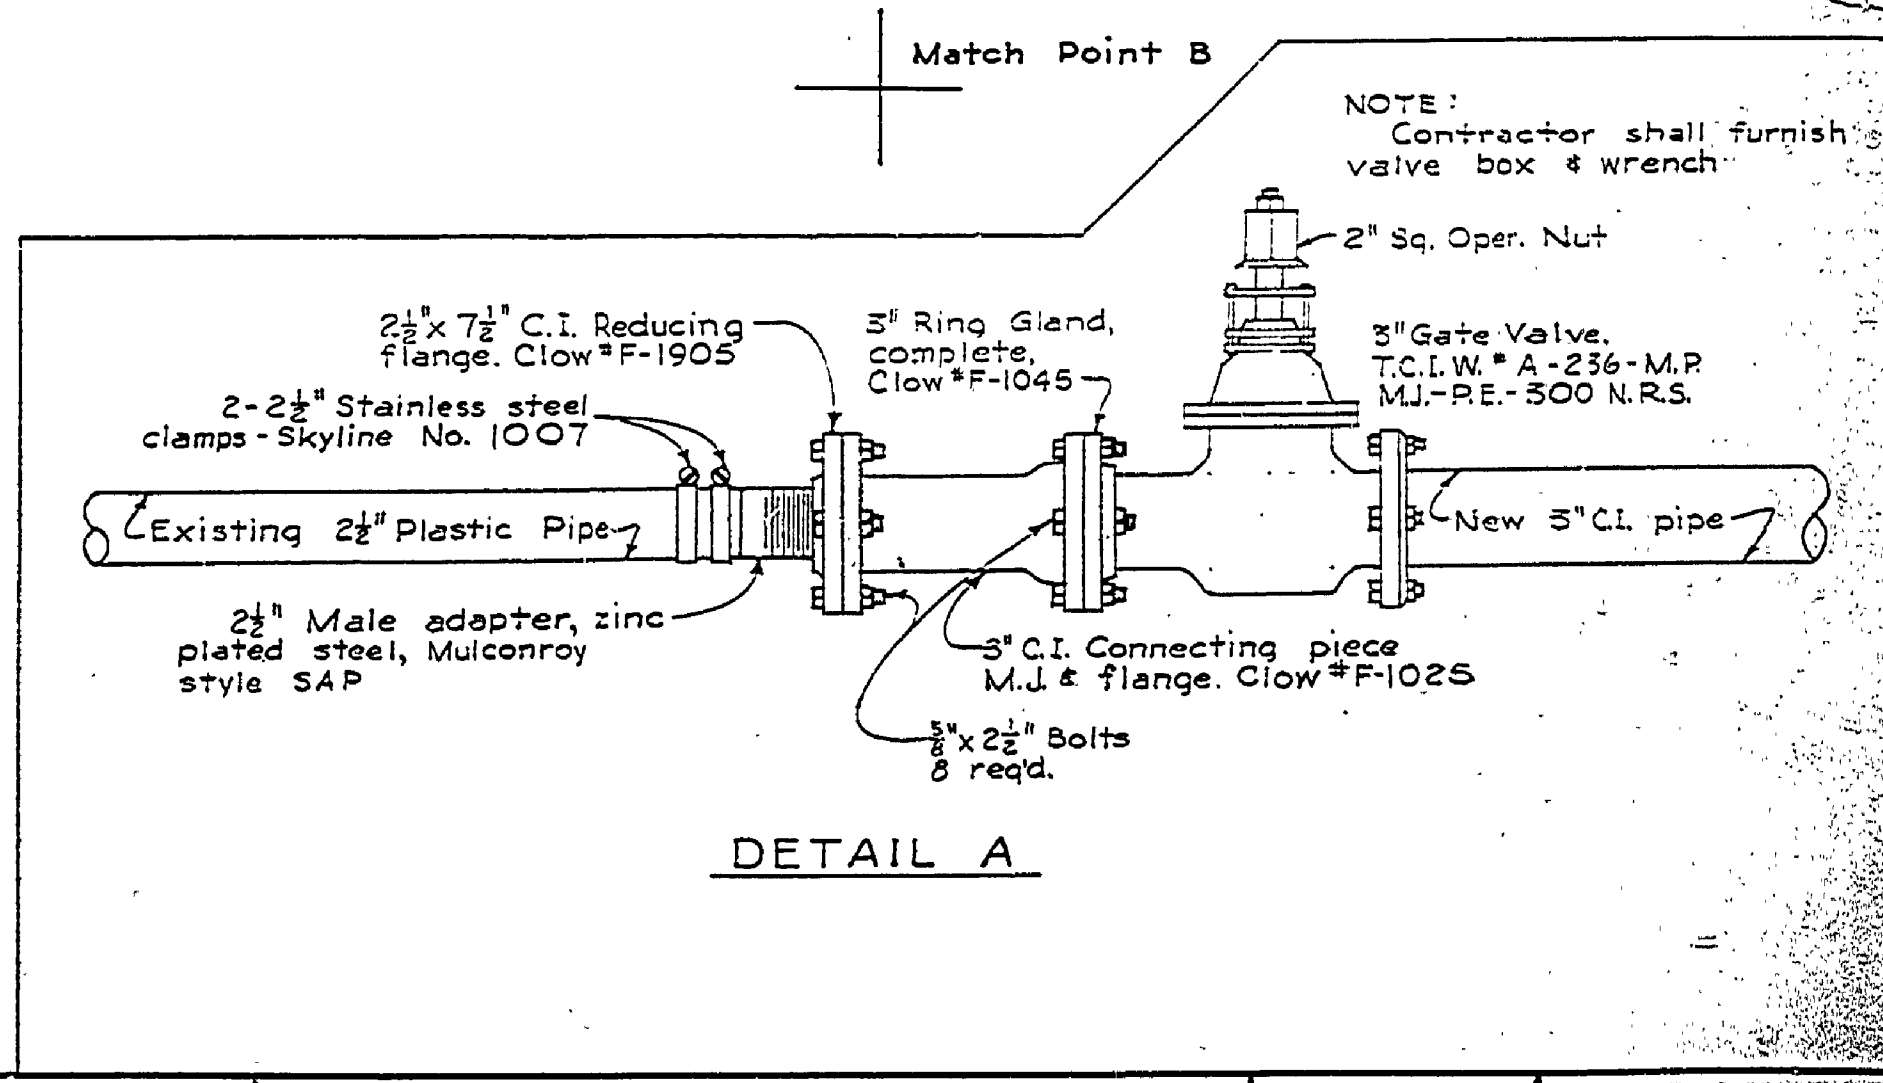

NOTE: Contractor shall furnish valve box & wrench