



DESIGNED BY	DATE	REVIEWED	DATE	APPROVED	DATE	NO.	DATE	BY	REVISIONS
B.H.G.	8.1.62	ARCHITECTURAL	10.1.62		1	1	7.14.63	B.H.G.	Revised As Shld. Ex. Construction
DRAWN BY	D.M.C.	ENGINEERING	8.1.62		2	2			
CHECKED BY	B.H.G.	LANDSCAPE	8.1.62		3	3	7.24.63		
					4	4			
					5	5			
					6	6			

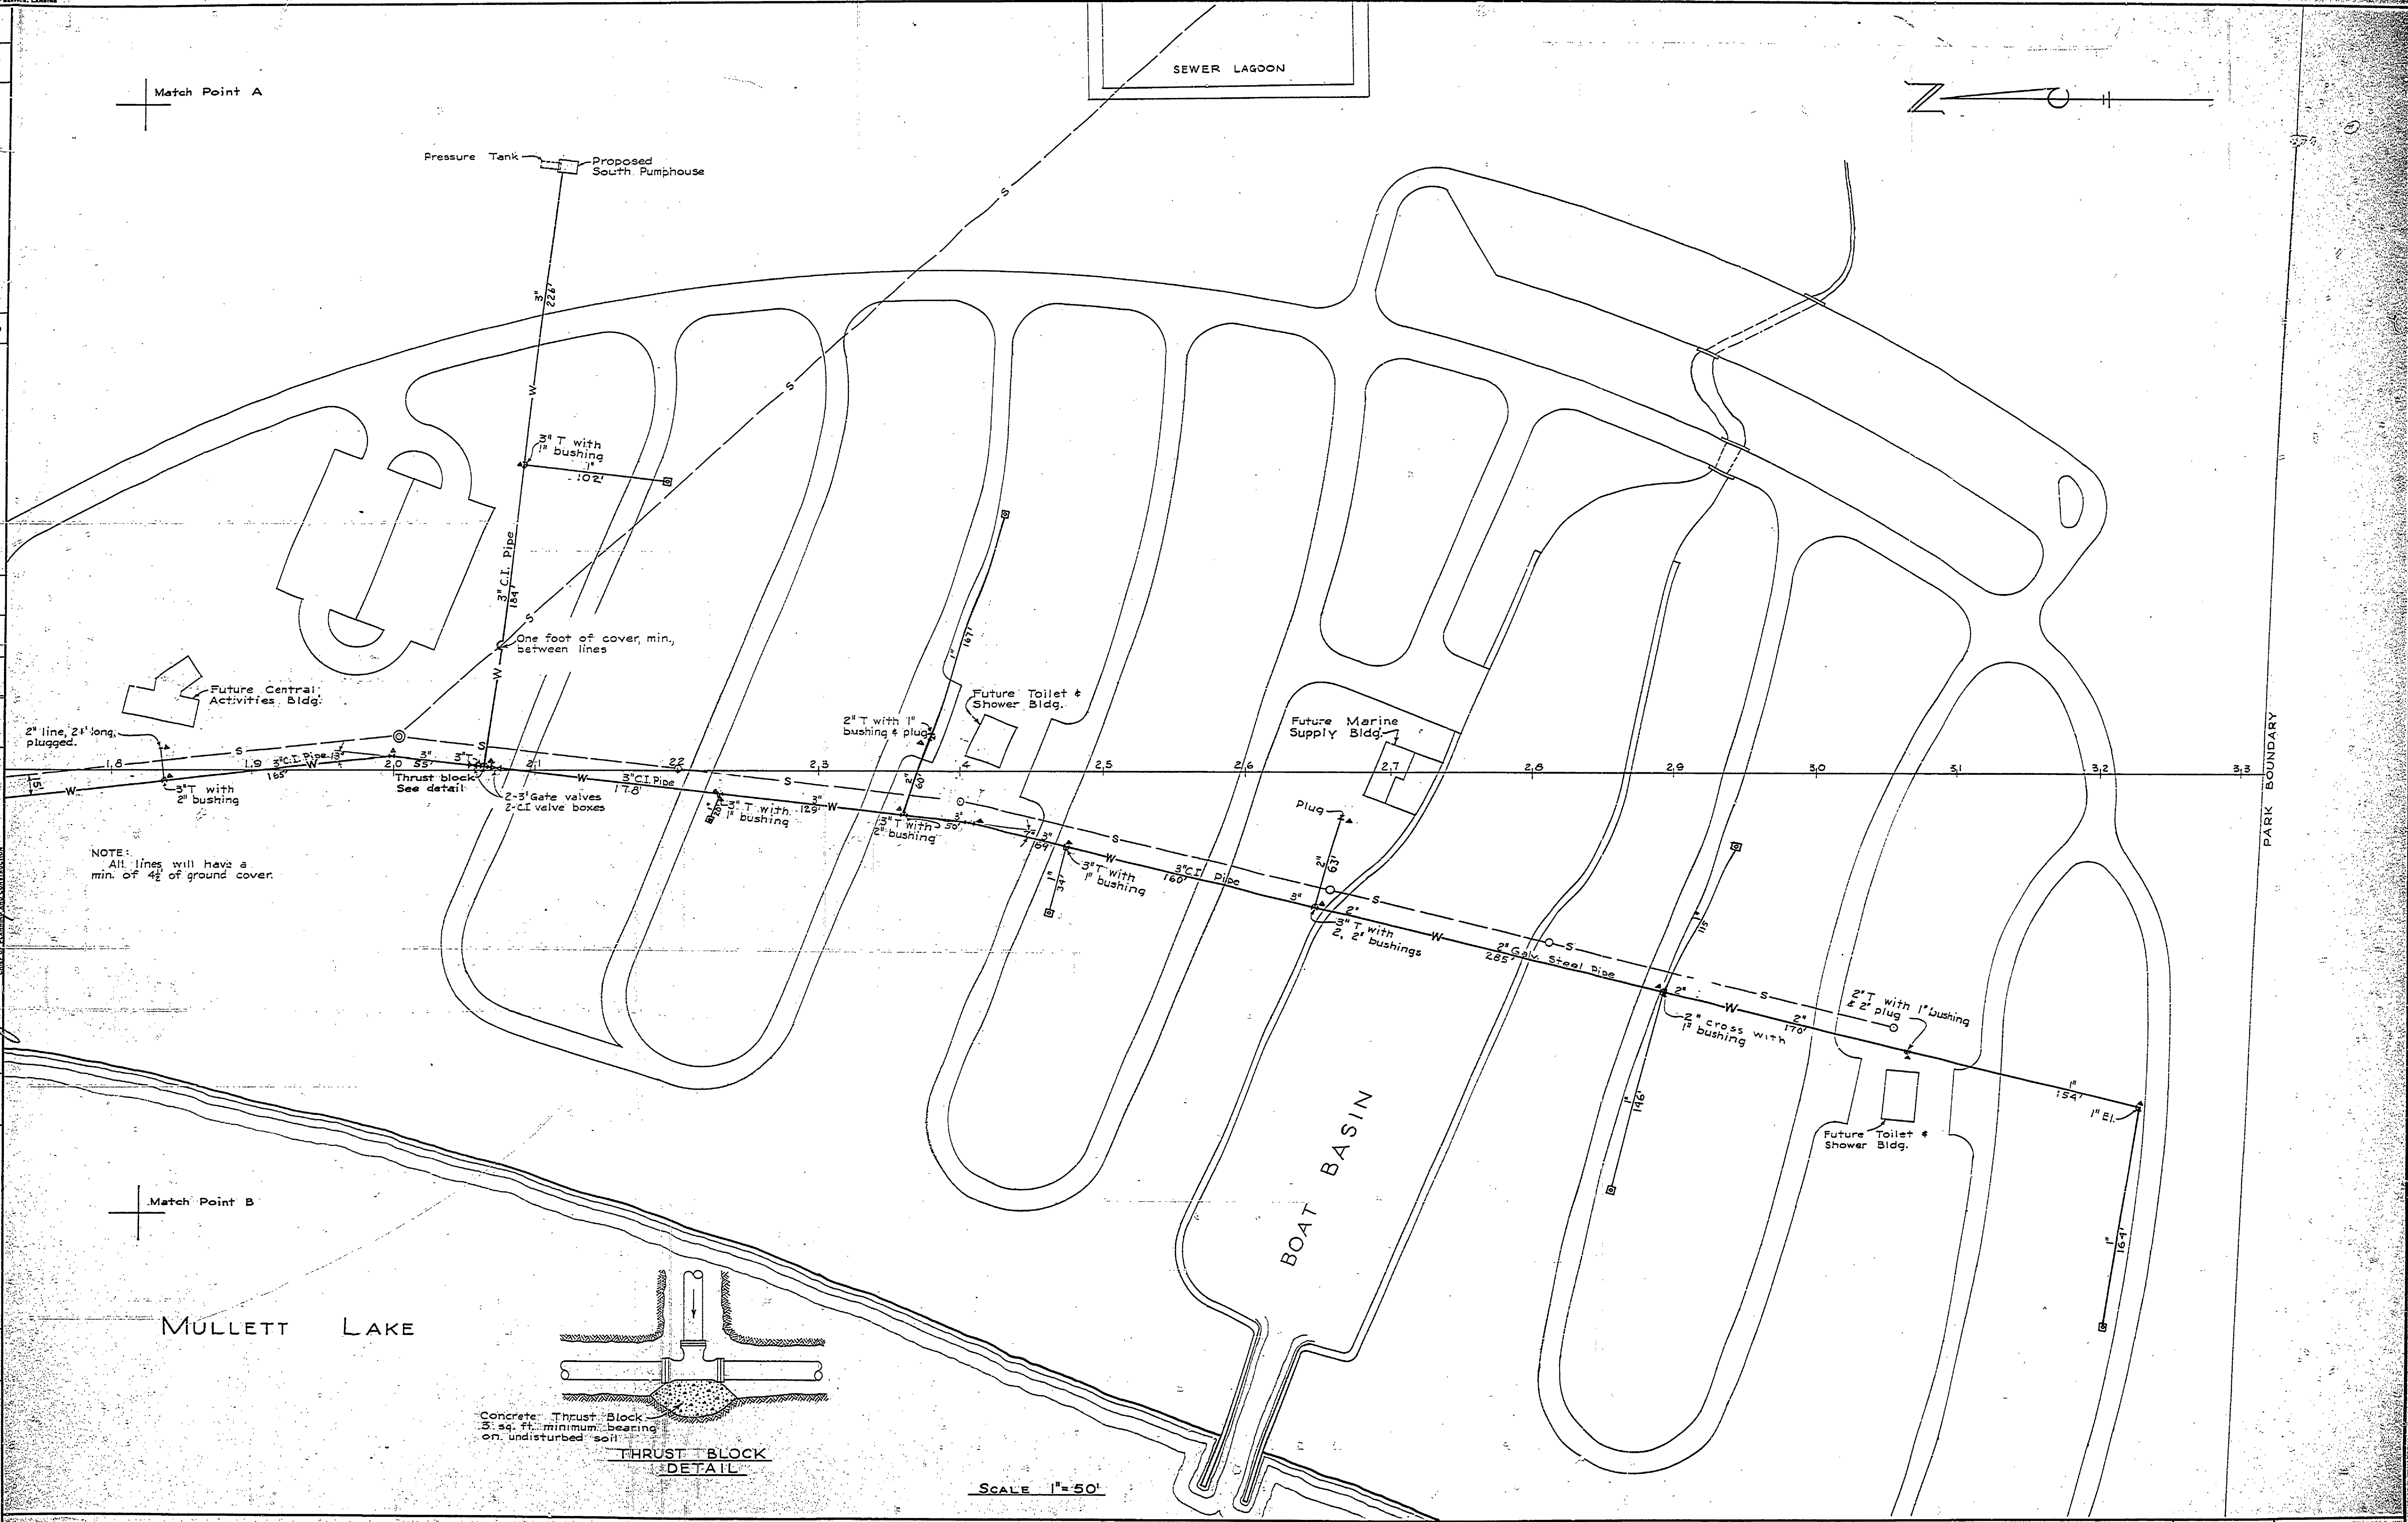

NOTE:  
All lines will have a min. of 4" of ground cover.

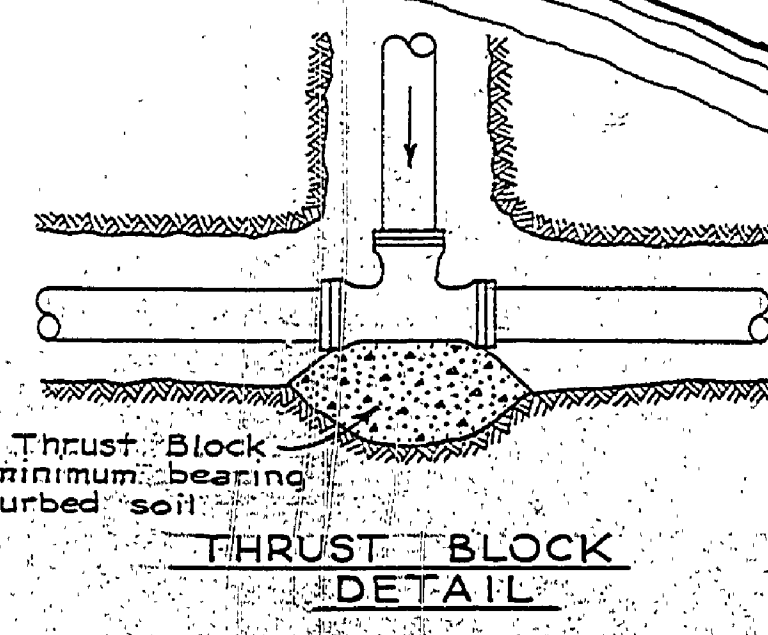

SCALE 1"=50'

MICHIGAN  
DEPARTMENT OF CONSERVATION  
PARKS AND RECREATION DIVISION

ALOHA STATE PARK  
WATER SYSTEM

SHEET  
NO. 2  
OF 2

PLAN NO.  
E102