
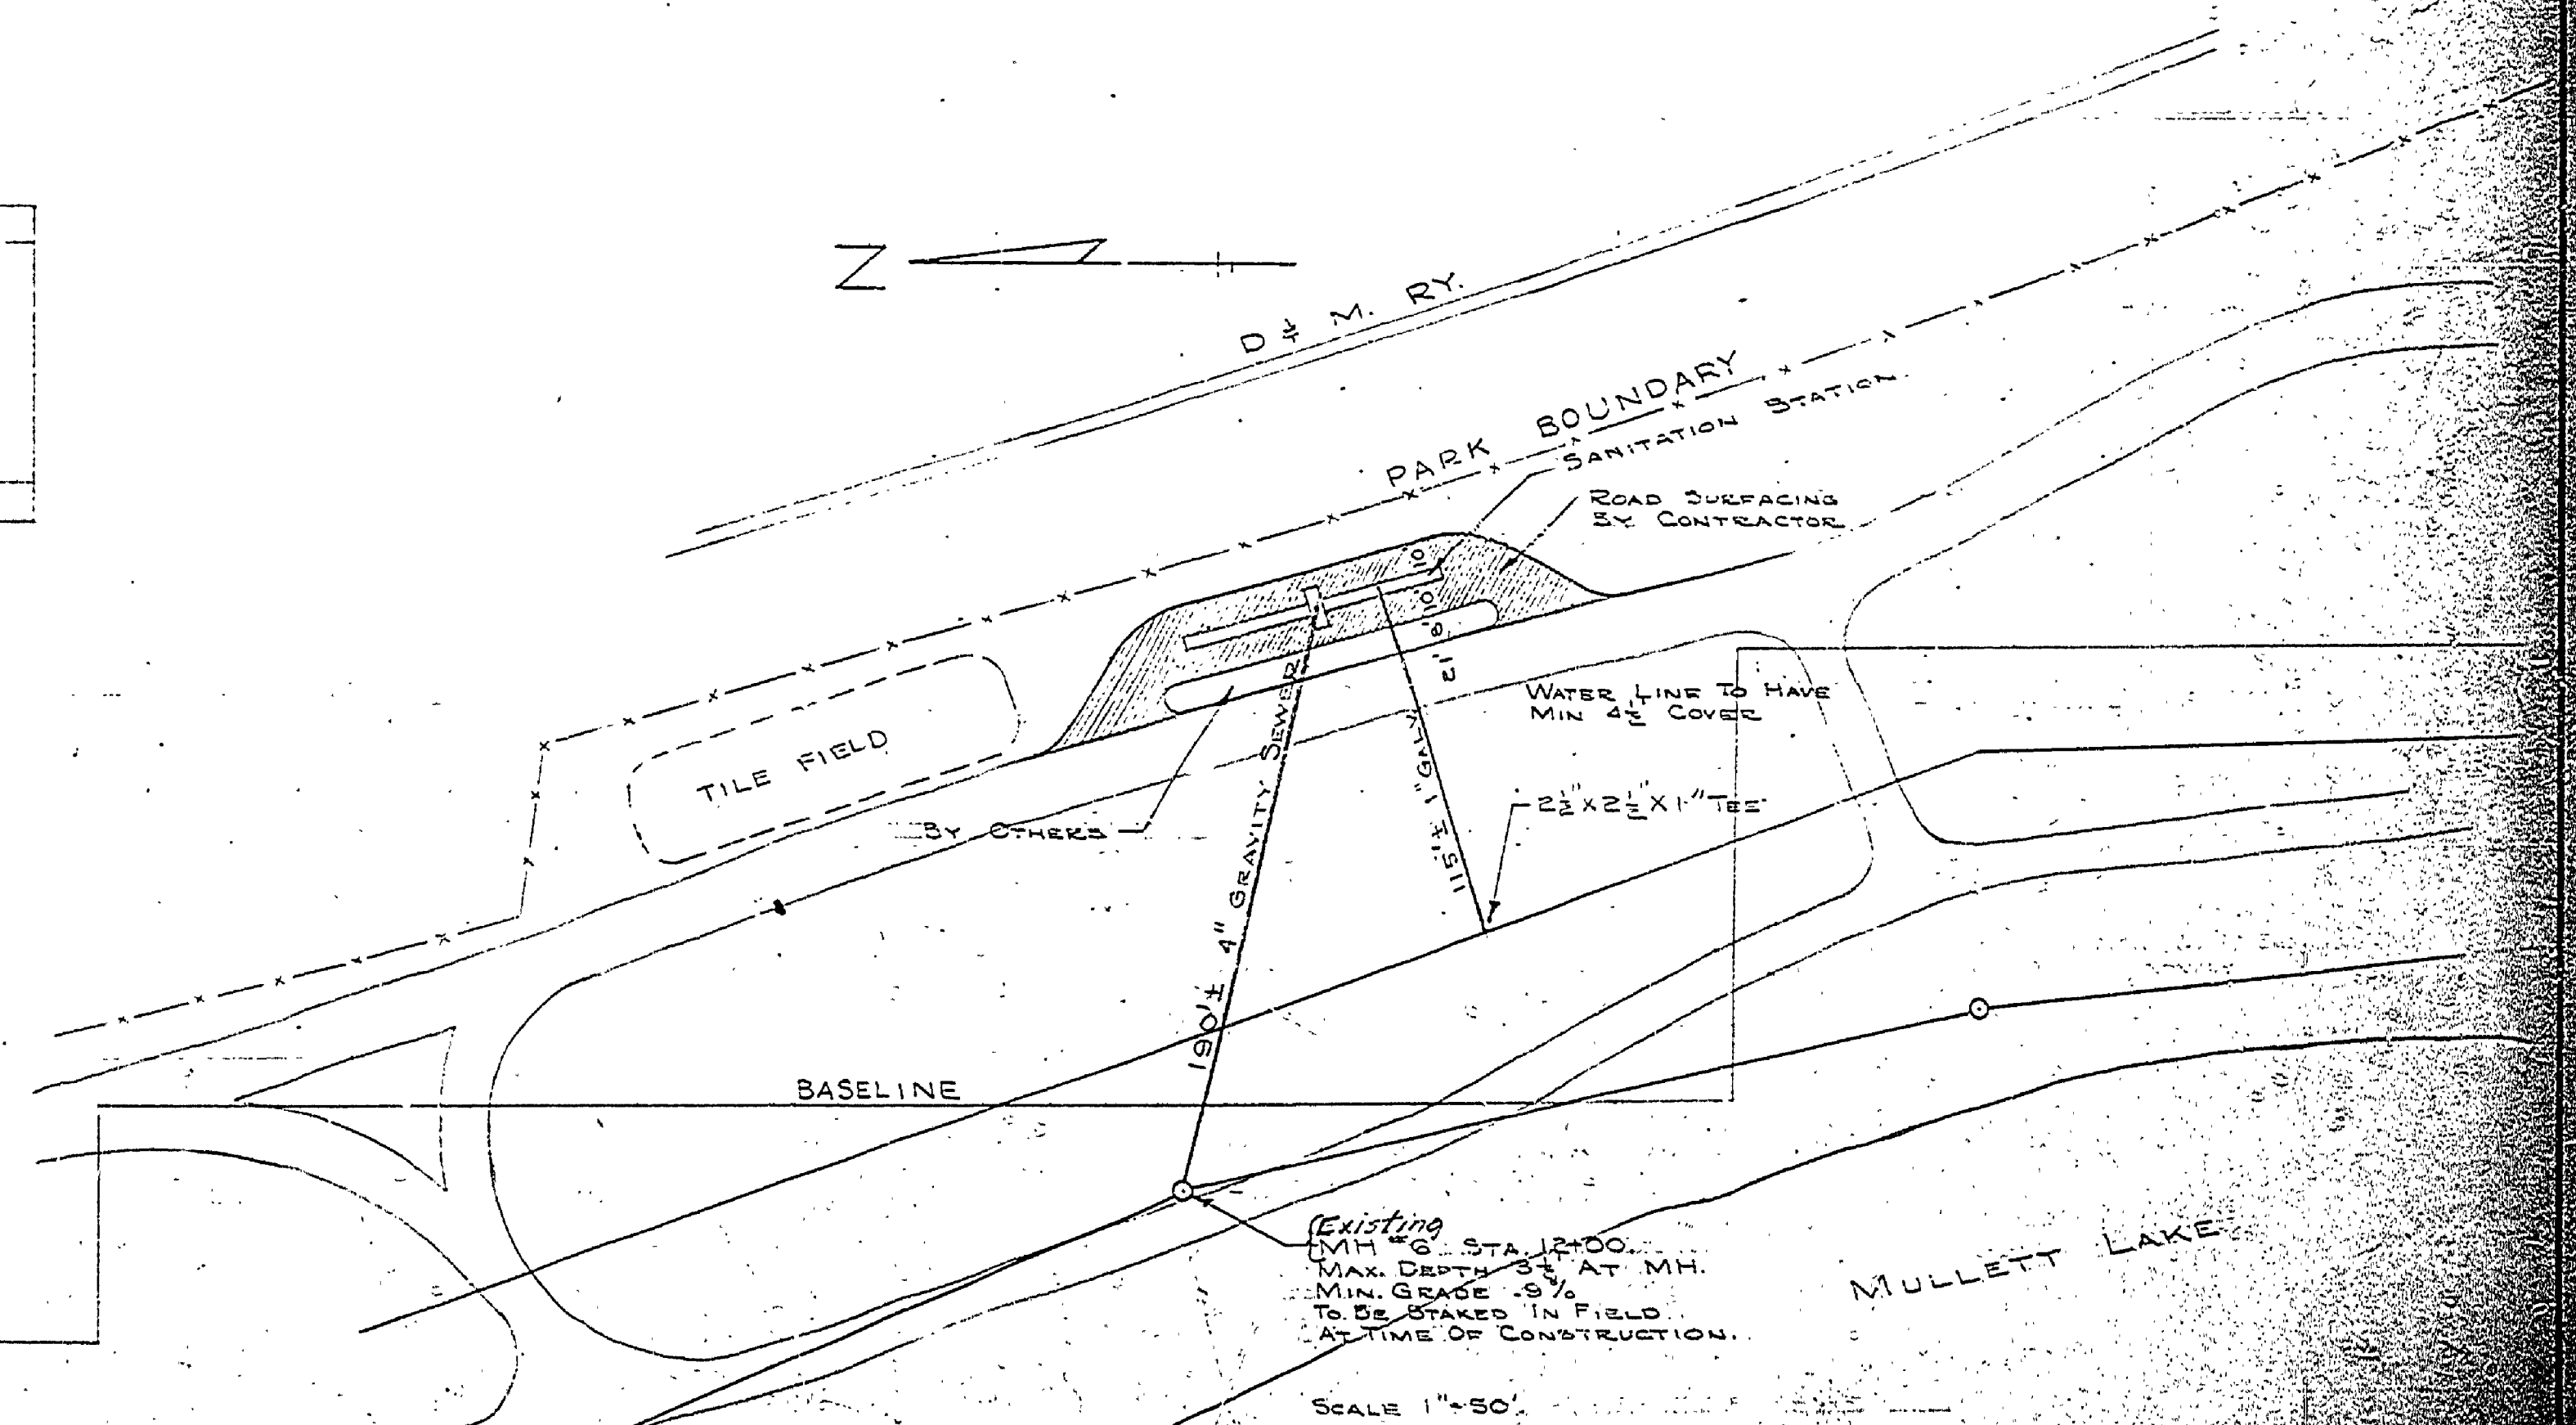
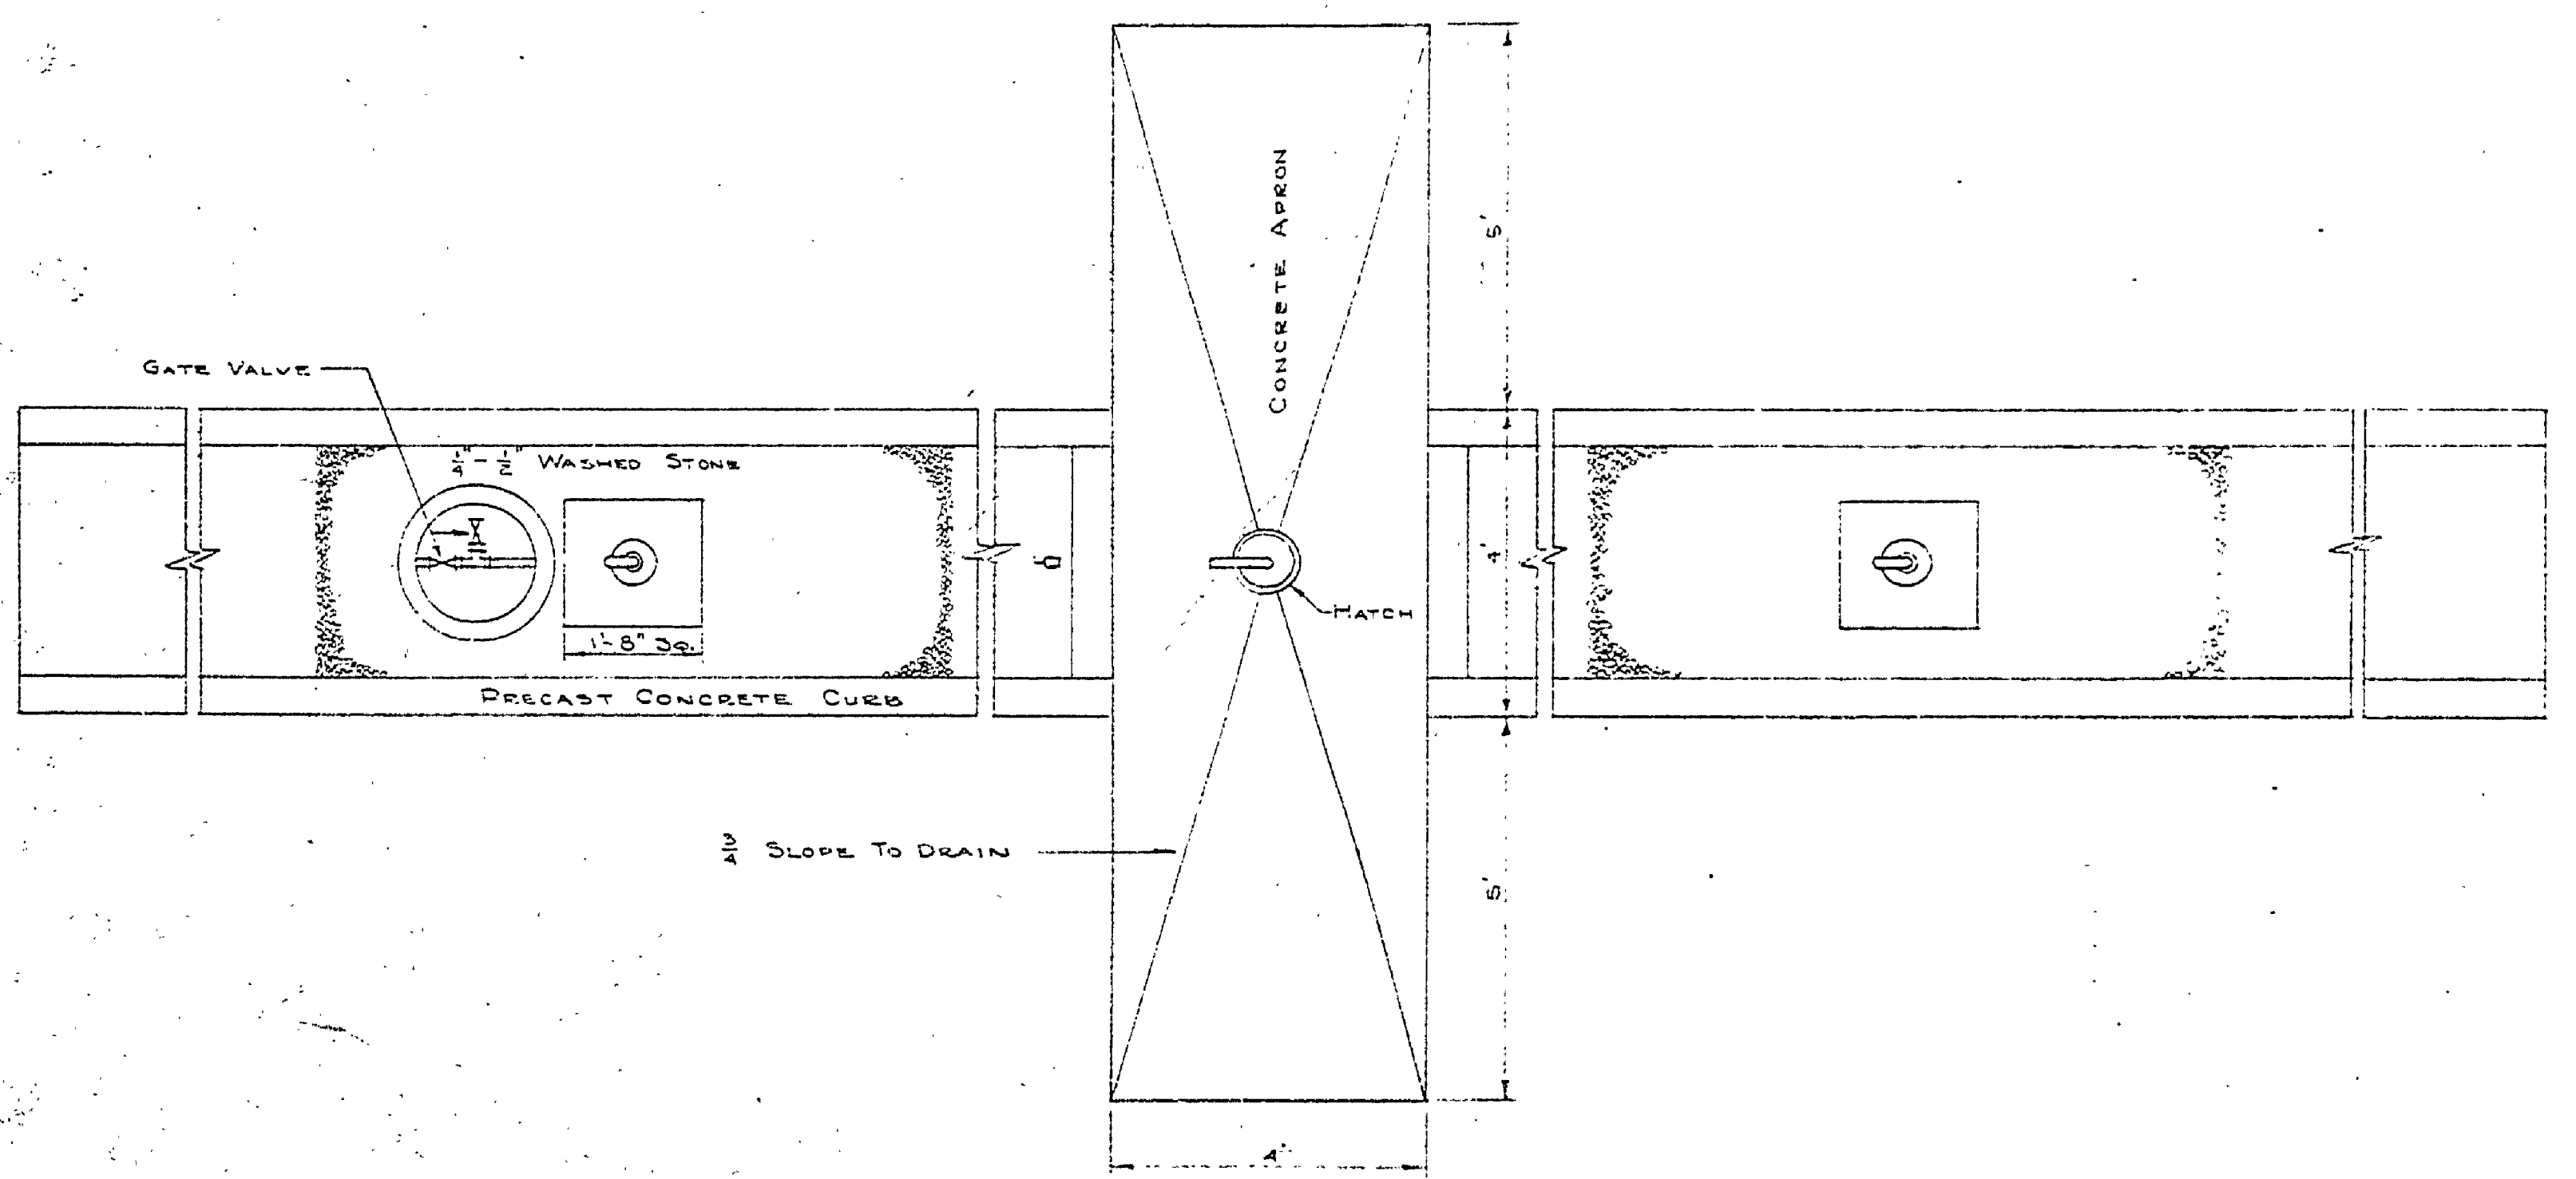
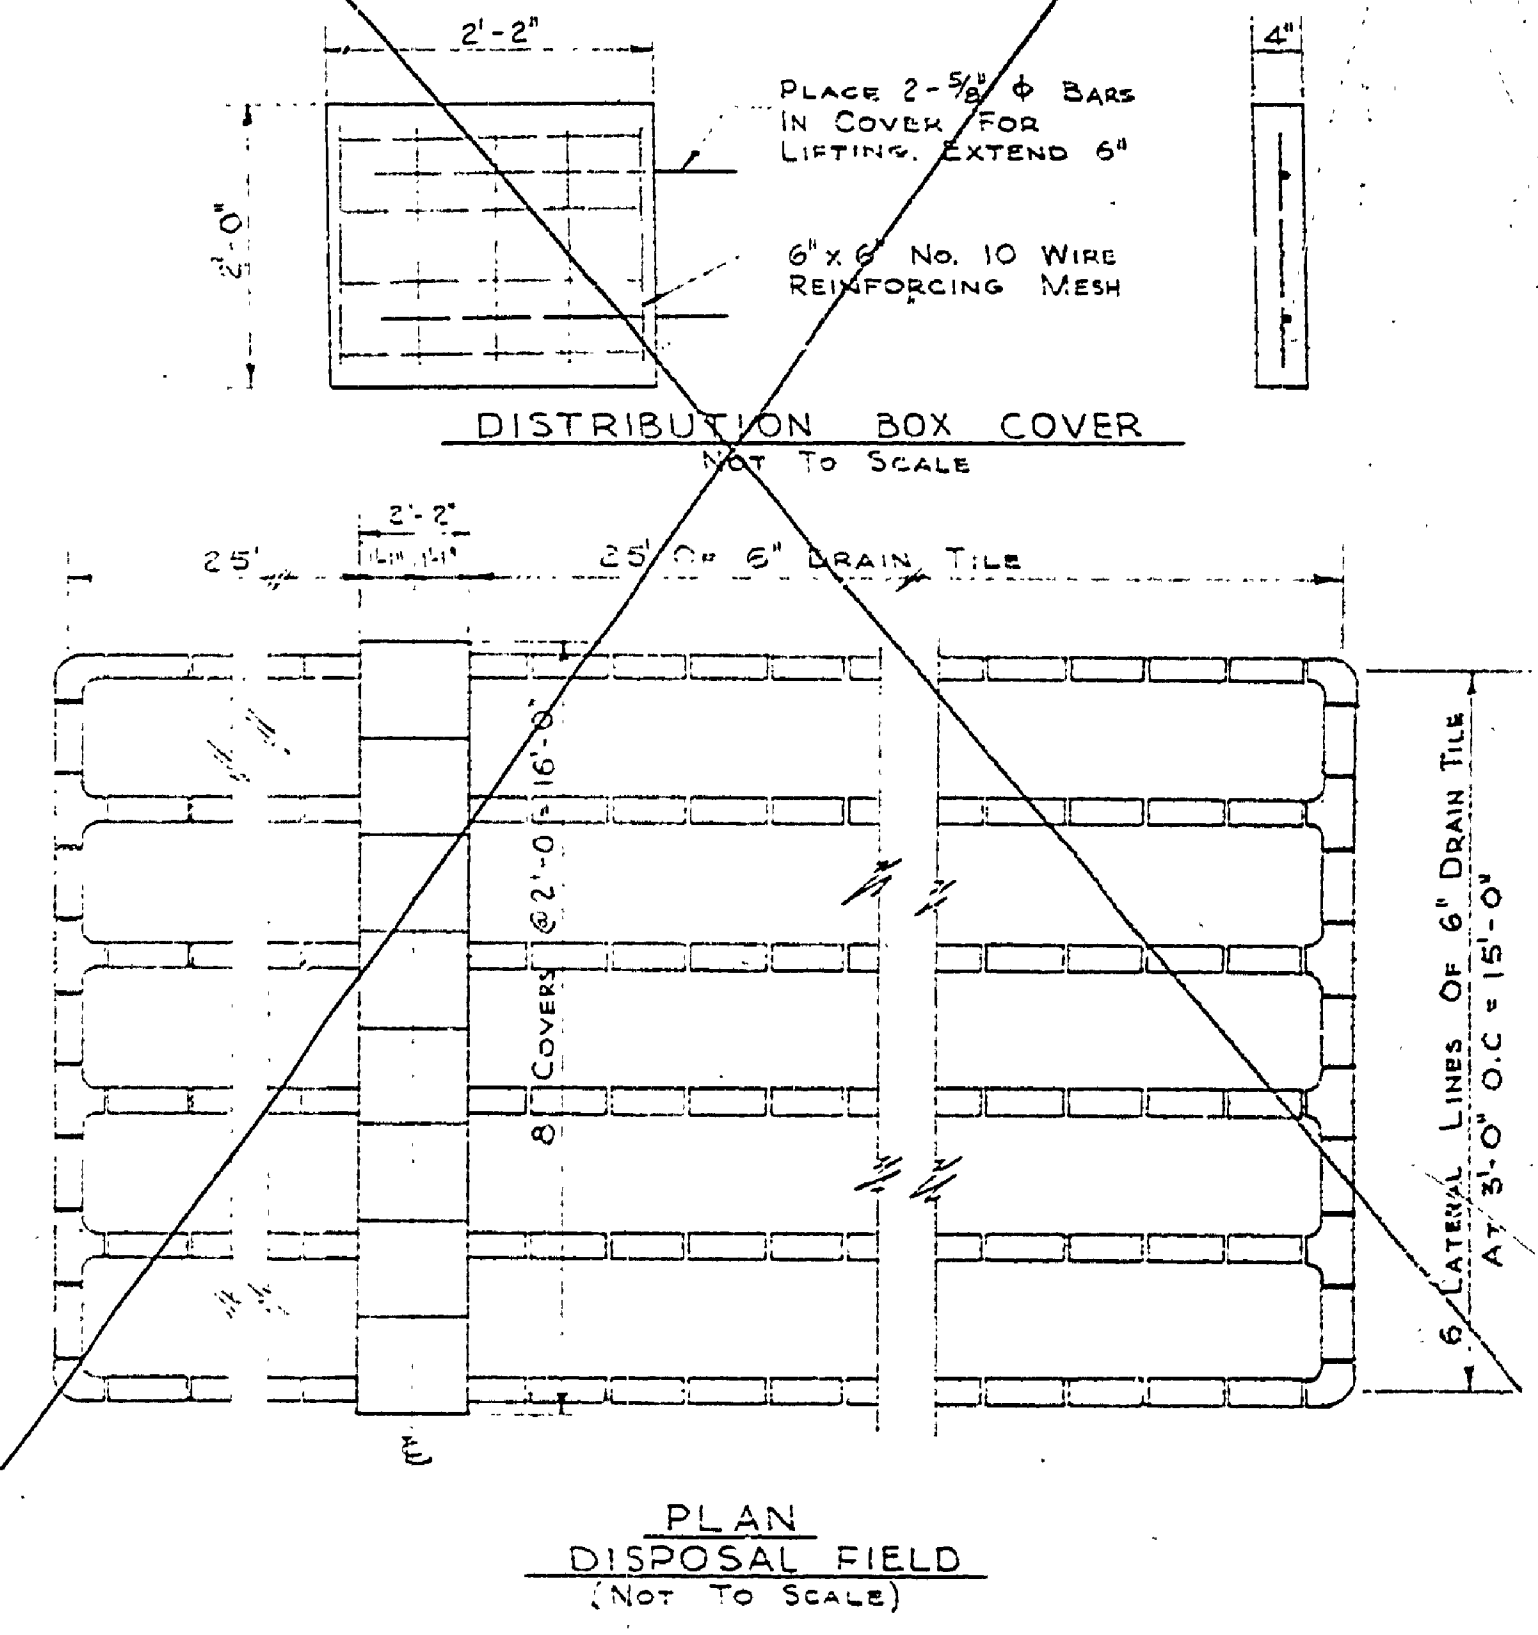
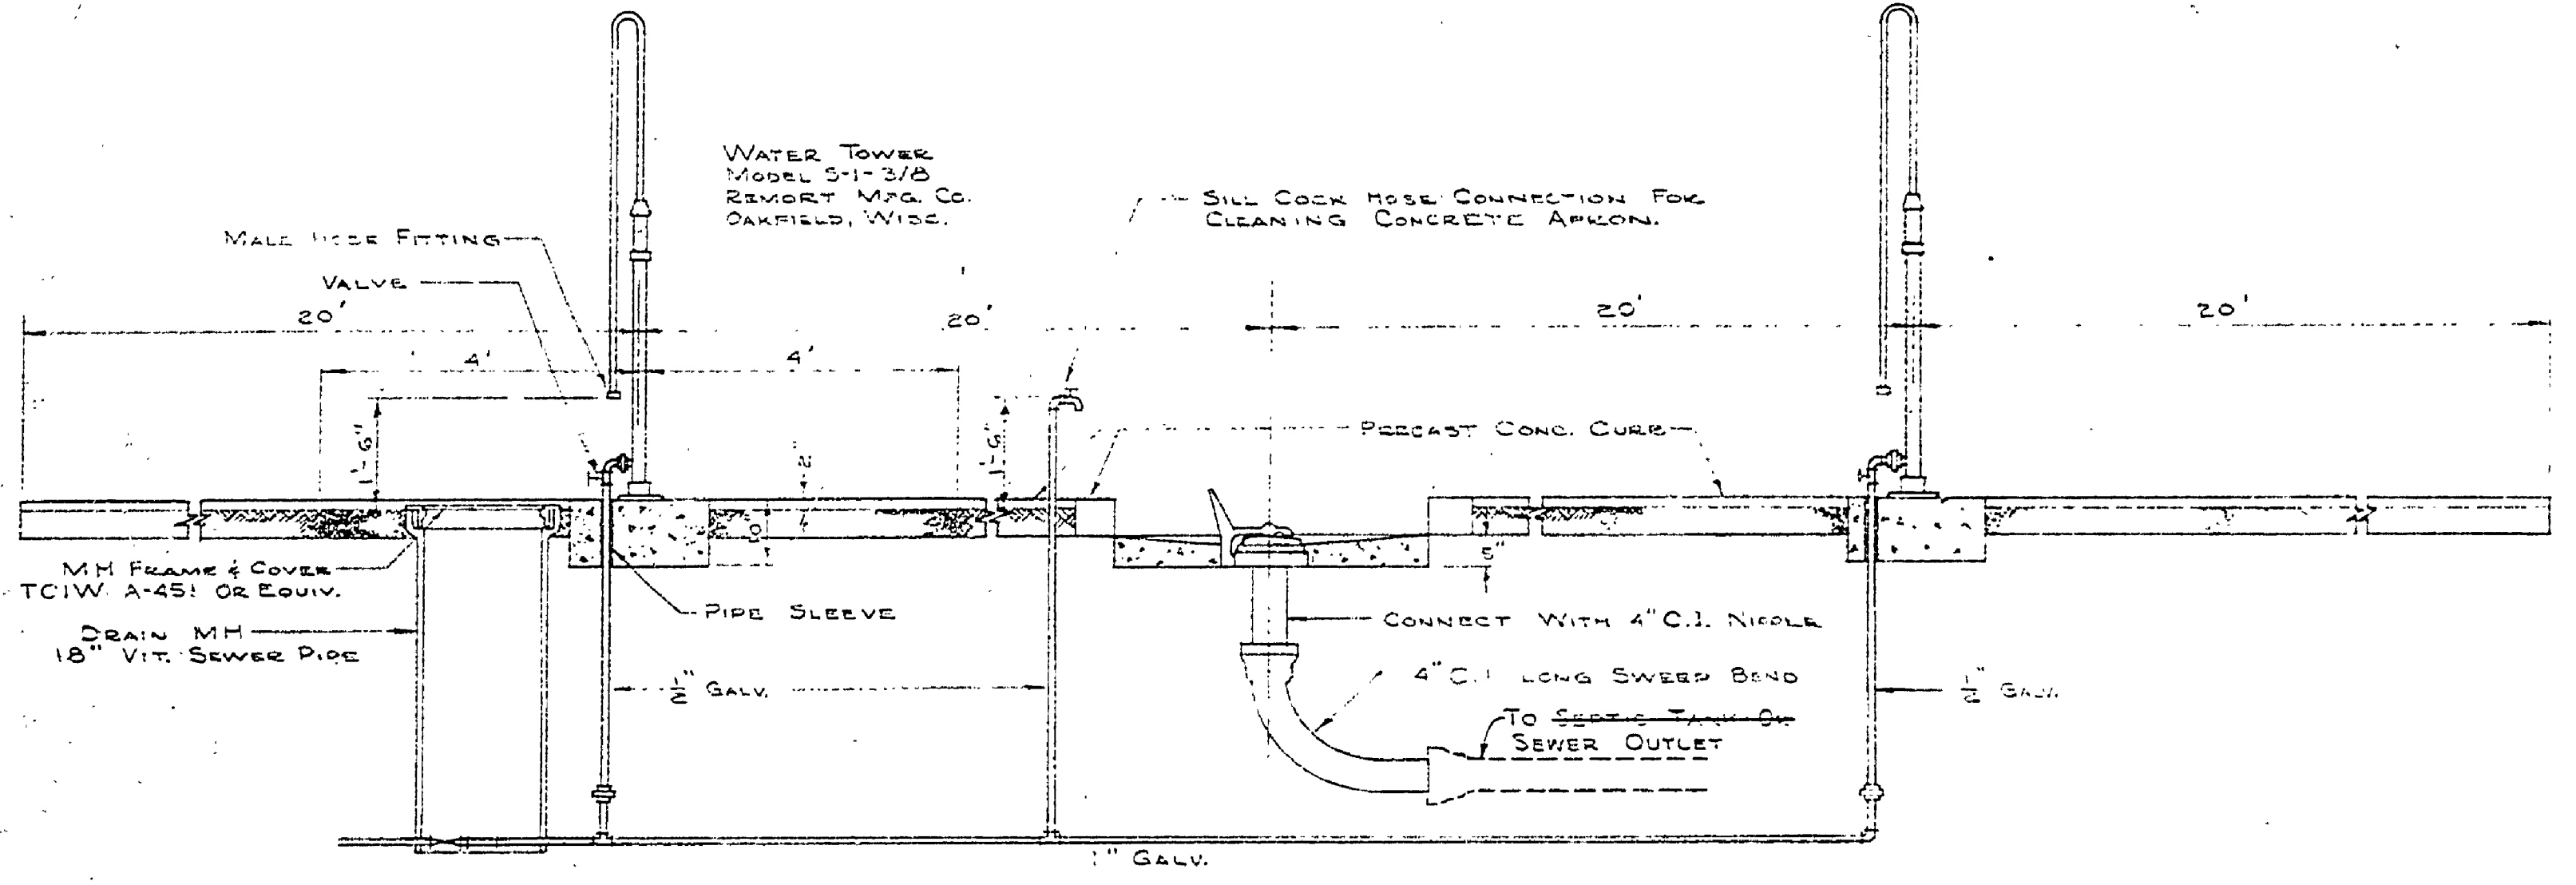
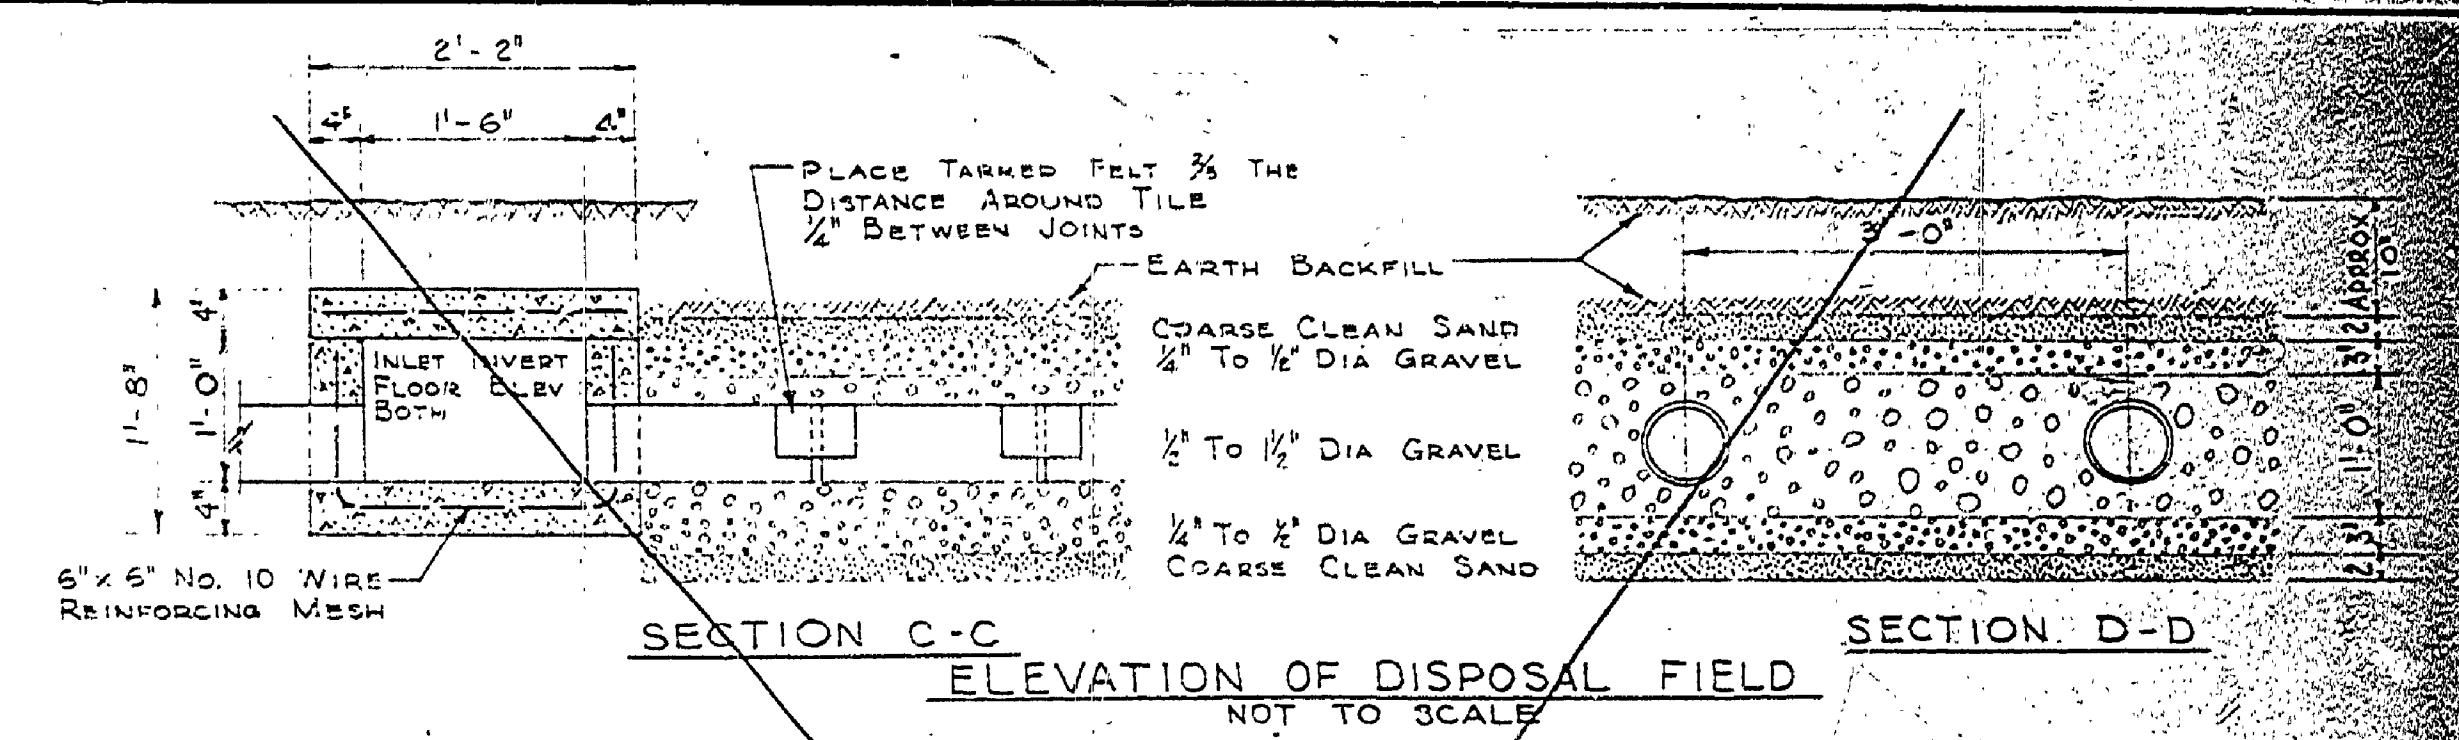
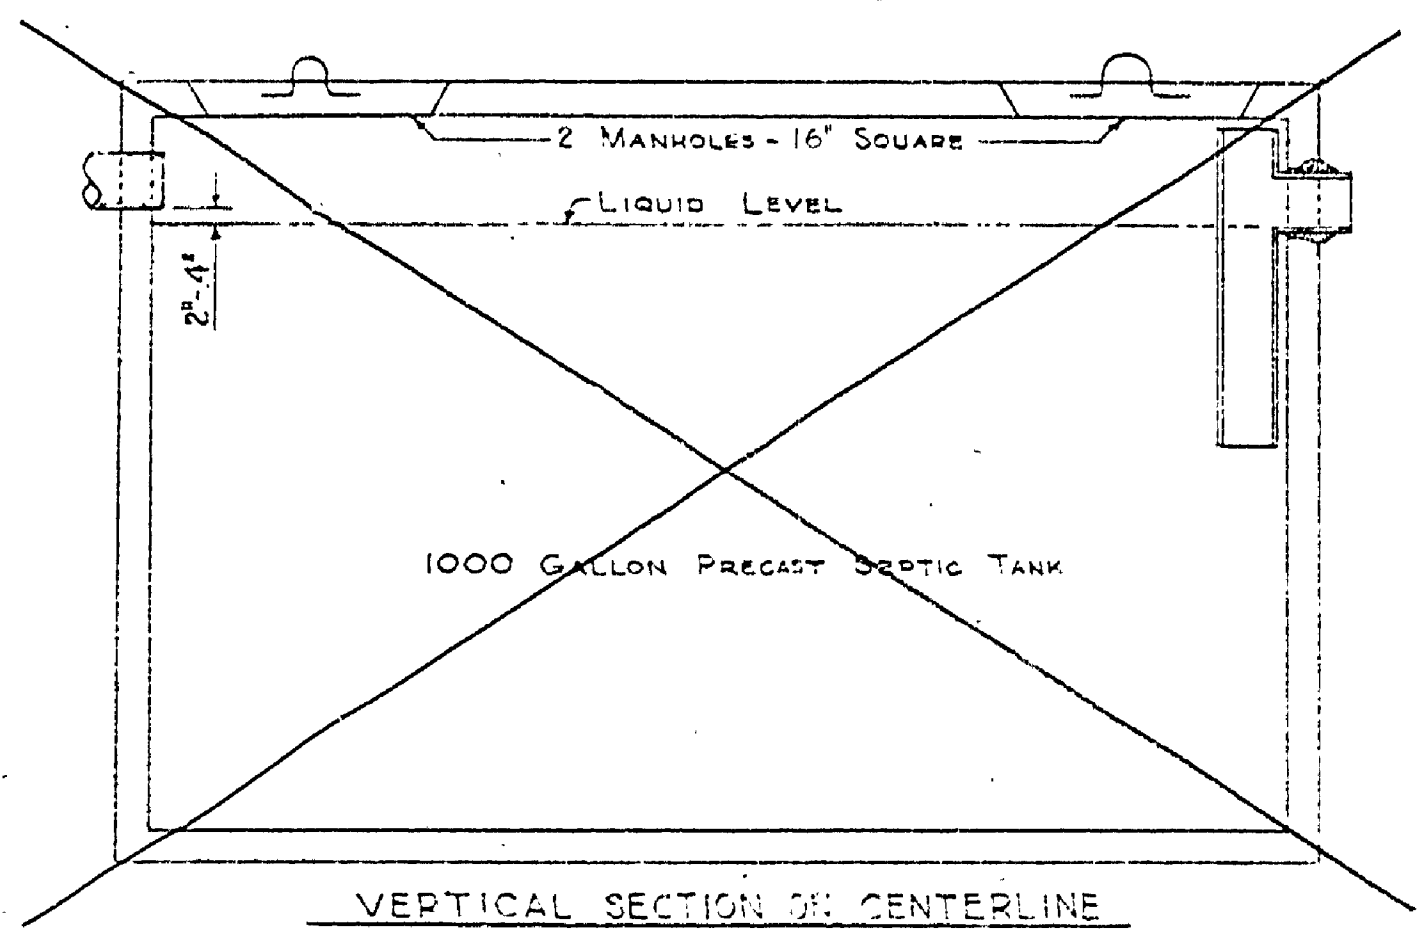


DESIGNED BY	DRAWN BY	CHECKED BY	DATE	REVIEWED	DATE	APPROVED	DATE	NO.	DATE	BY	REVISIONS
W. J. DUNCAN	W. J. DUNCAN	W. J. DUNCAN	1/3/64	W. J. DUNCAN	1/3/64	[Signature]	1/3/64	1	1-3-64	J. C.	4
								2			5
								3			6

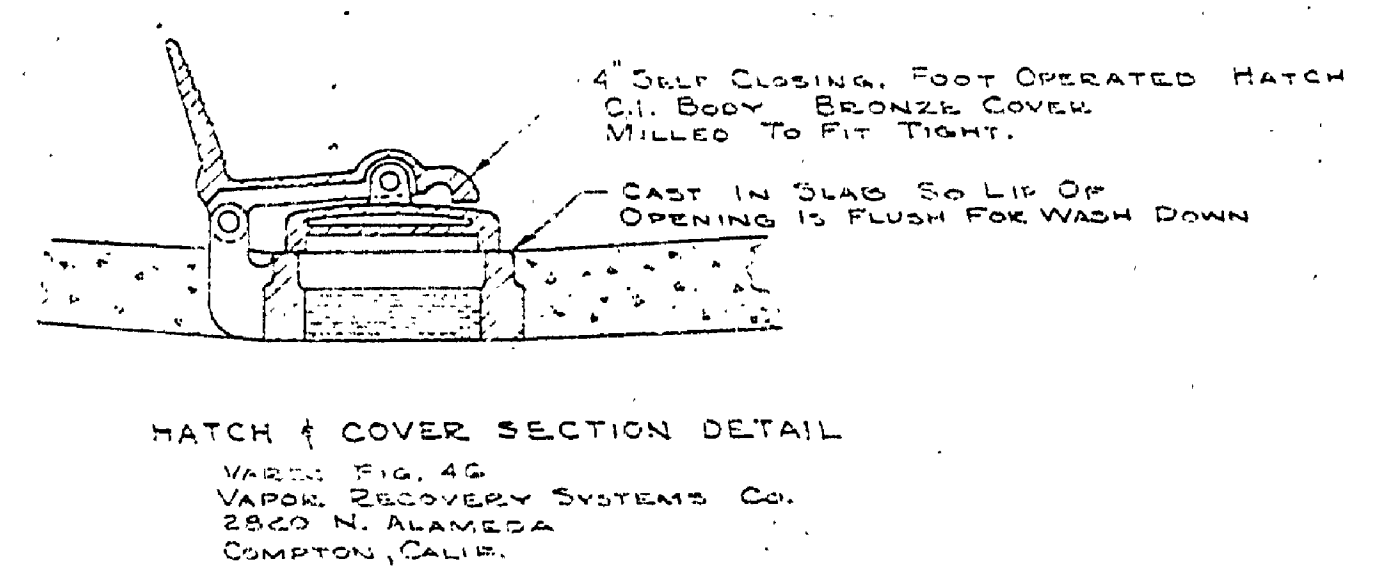

MICHIGAN DEPARTMENT OF CONSERVATION PARKS AND RECREATION DIVISION
 ALOHA STATE PARK SANITATION STATION
 SHEET NO. 8 OF 8
 PLAN NO. E-104

258-002-26-C4 SHEET NO. 8 OF 8