


DESIGNED BY	DATE	REVIEWED	DATE	APPROVED	DATE	NO.	DATE	BY	REVISIONS
DRAWN BY		ARCHITECTURAL				1			4
CHECKED BY		ENGINEERING				2			5
		LANDSCAPE				3			6

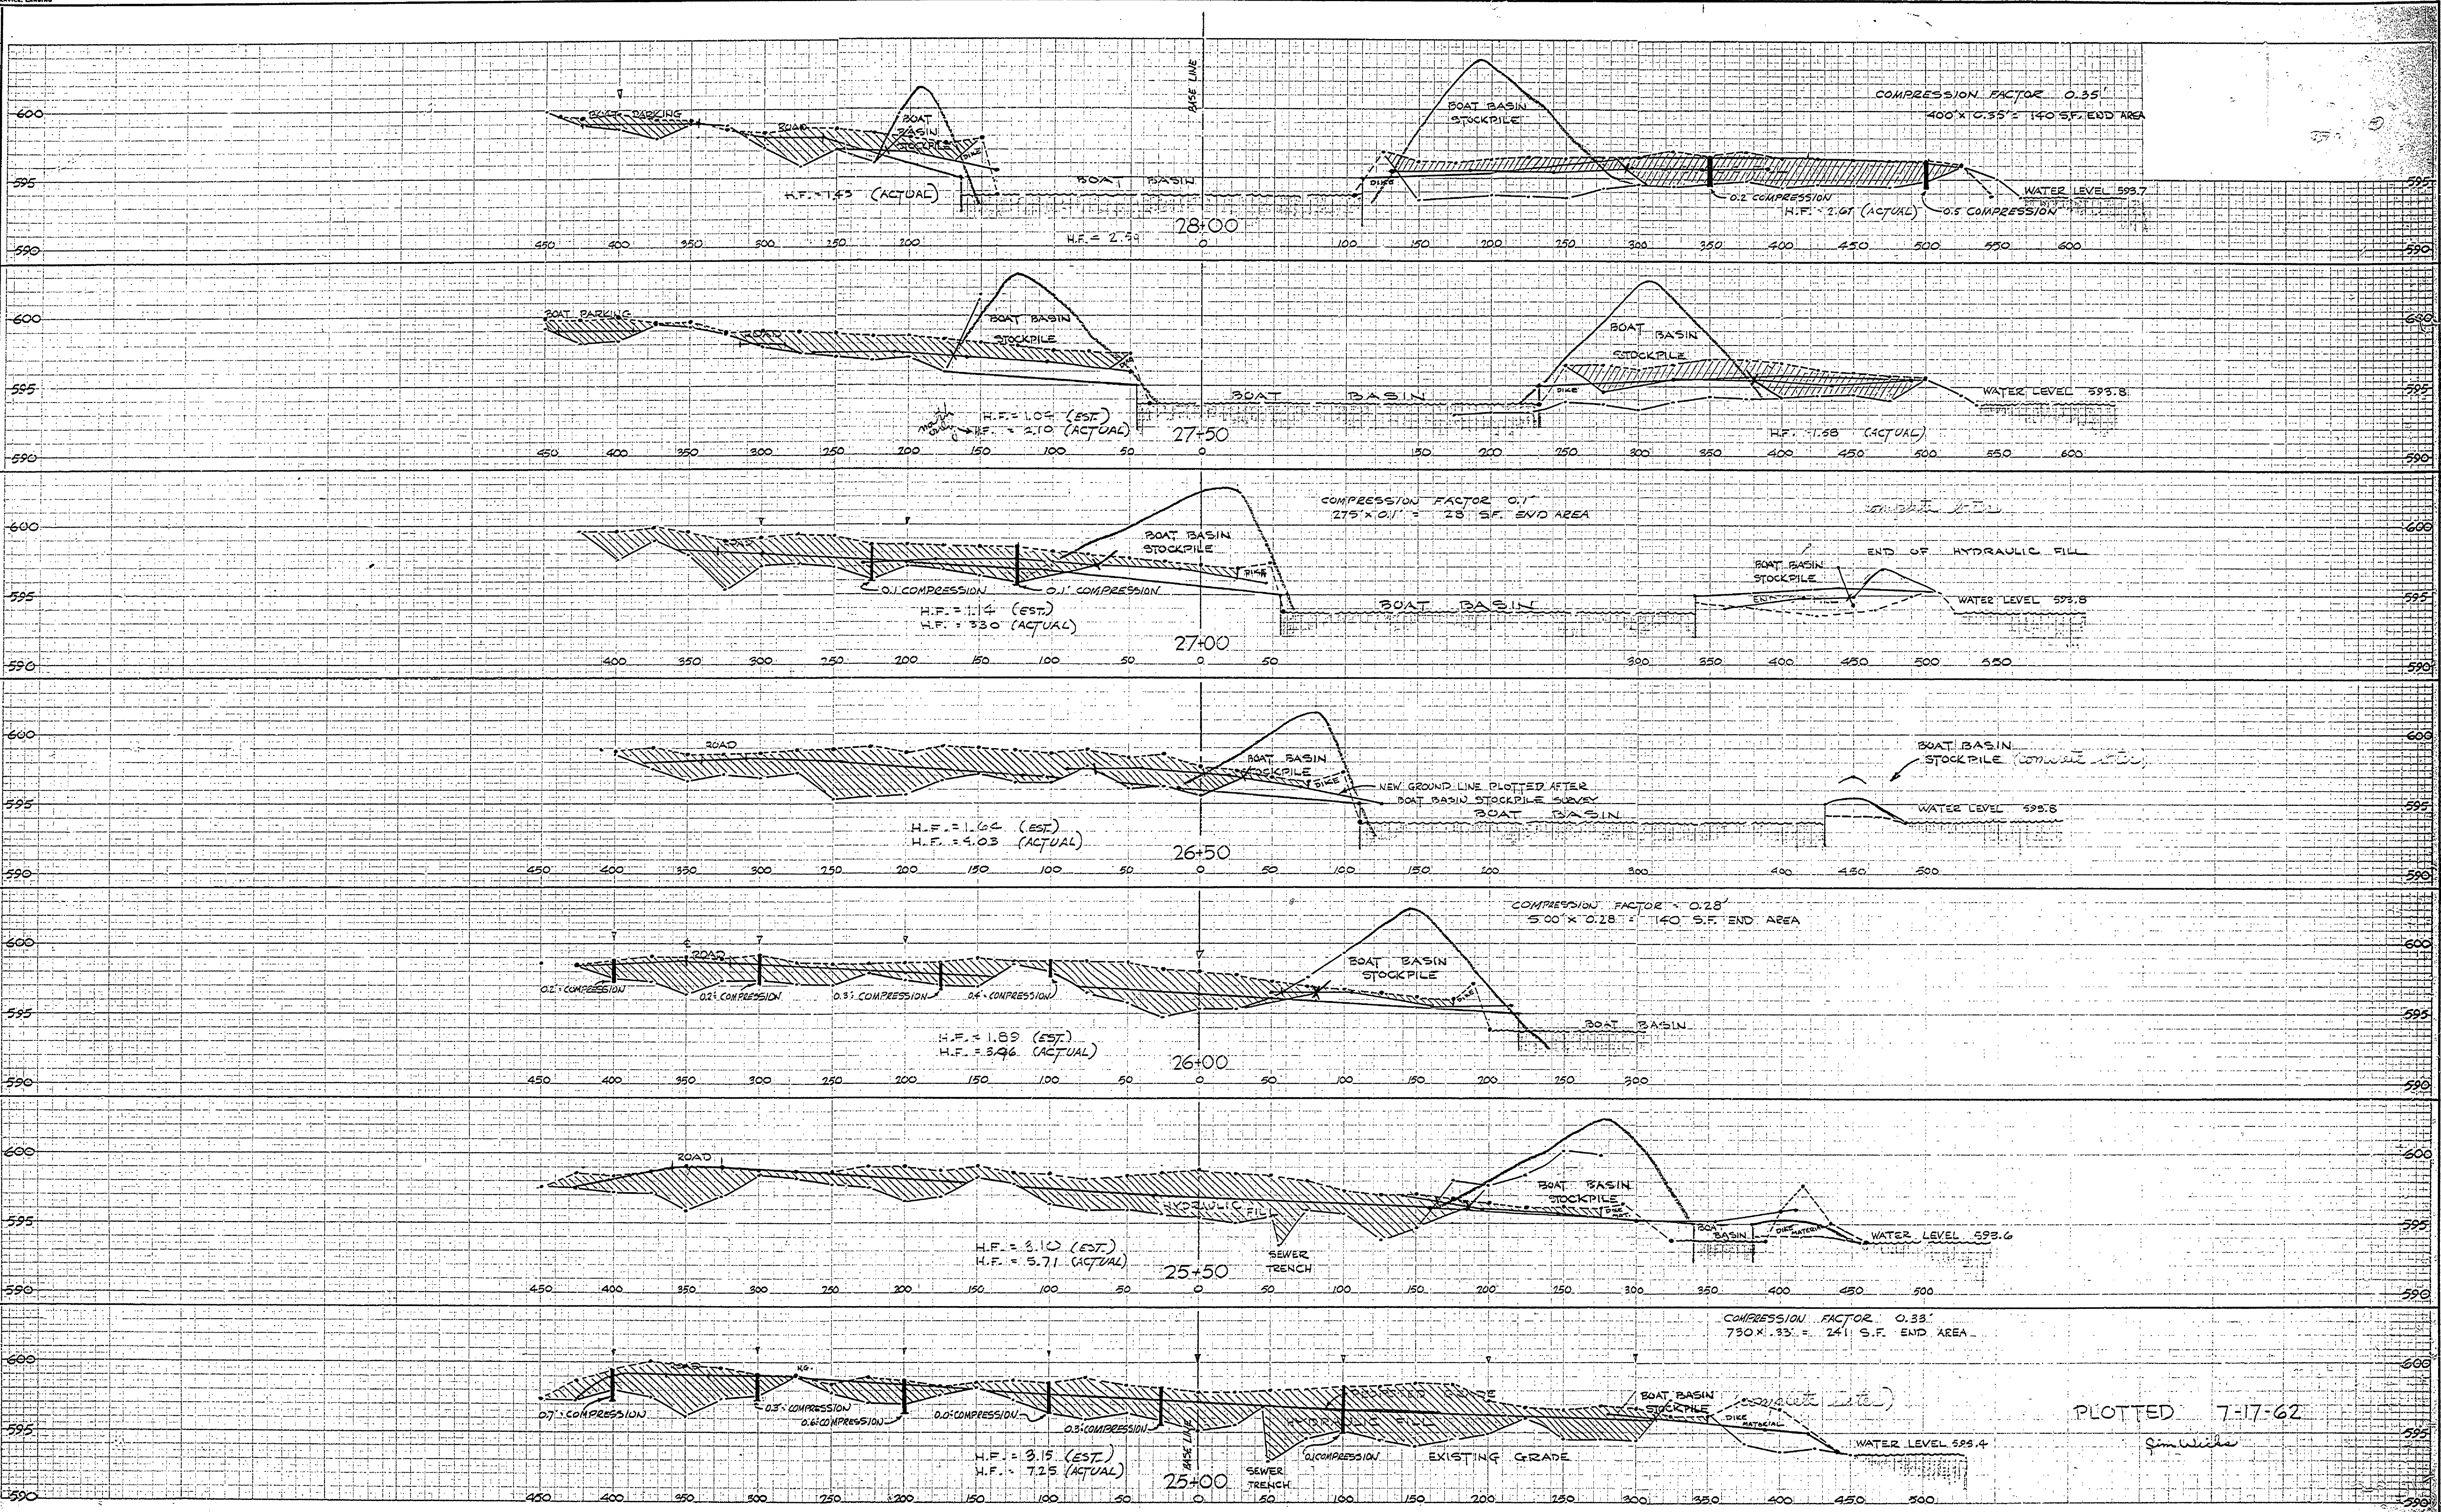

SCALE  
 VERT. 1" = 5'  
 HORIZ. 1" = 30'

MICHIGAN  
 DEPARTMENT OF CONSERVATION  
 PARKS AND RECREATION DIVISION

ALOHA STATE PARK  
 HYDRAULIC EXCAVATION MEASUREMENT  
 CAMPGROUND CROSS SECTIONS

SHEET  
 NO. 3  
 OF 5

PLAN NO.  
 WORK SHEET

PLOTTED 7-17-62  
 Jim Wicks