


DESIGNED BY	DATE	REVIEWED	DATE	APPROVED	DATE	NO.	DATE	BY	REVISIONS	DATE	BY
DRAWN BY E. J. W.		ARCHITECTURAL ENGINEERING				1			4		
CHECKED BY		LANDSCAPE				2			5		
						3			6		

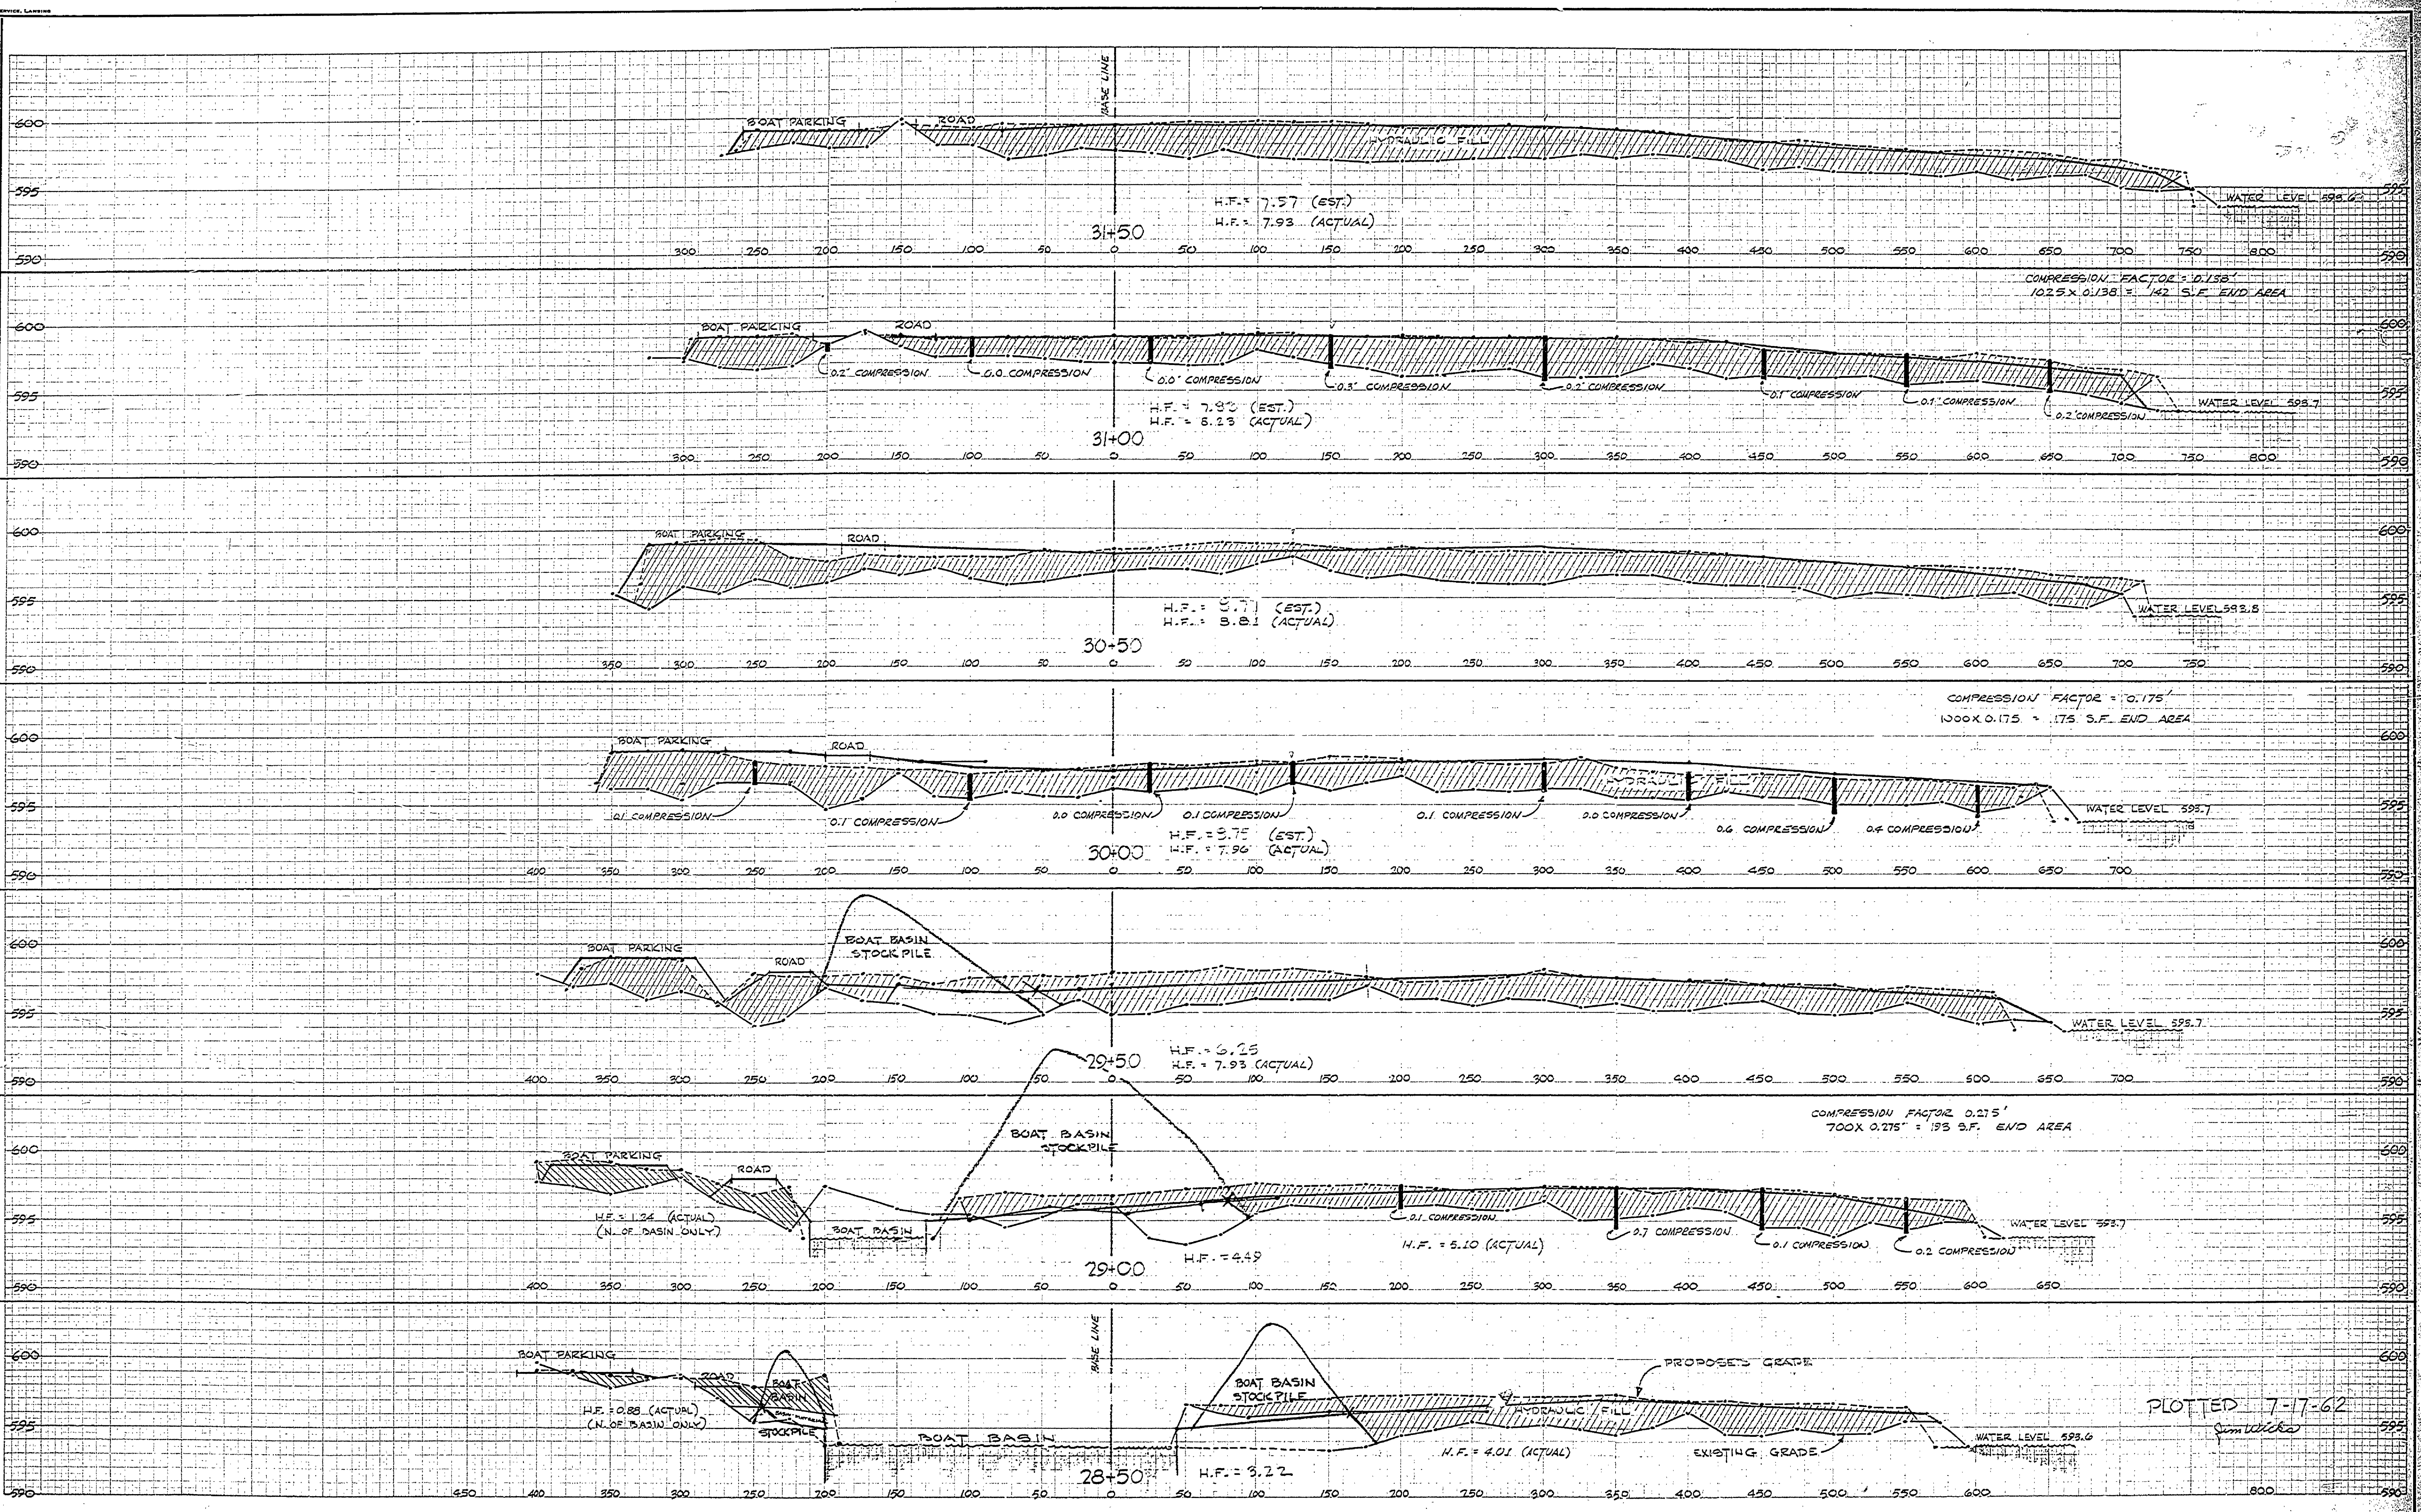

PLOTTED 7-17-62
J. M. WILKINSON

SCALE
VERT. 1" = 5'
HORZ. 1" = 50'

MICHIGAN
DEPARTMENT OF CONSERVATION
PARKS AND RECREATION DIVISION

ALOHA STATE PARK
HYDRAULIC EXCAVATION MEASUREMENT
CAMPGROUND CROSS SECTIONS

SHEET NO. 4
OF 5
PLAN NO. WORK SHEET