



ENTRANCE RACK
WITH METER SOCKET & CIRCUIT BREAKER PANEL BOARD


NOTE: GROUND ELECTRICAL SYSTEM AT DISTRIBUTION PANELBOARD TO NEAREST BURIED WATER PIPE.

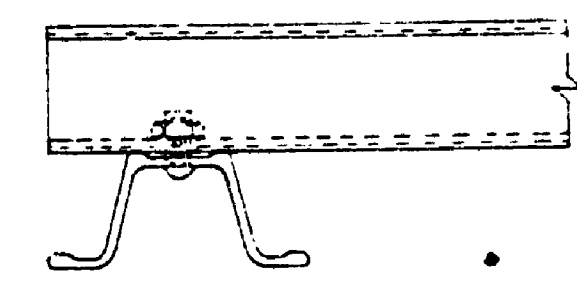


SECTION A-A
NO SCALE

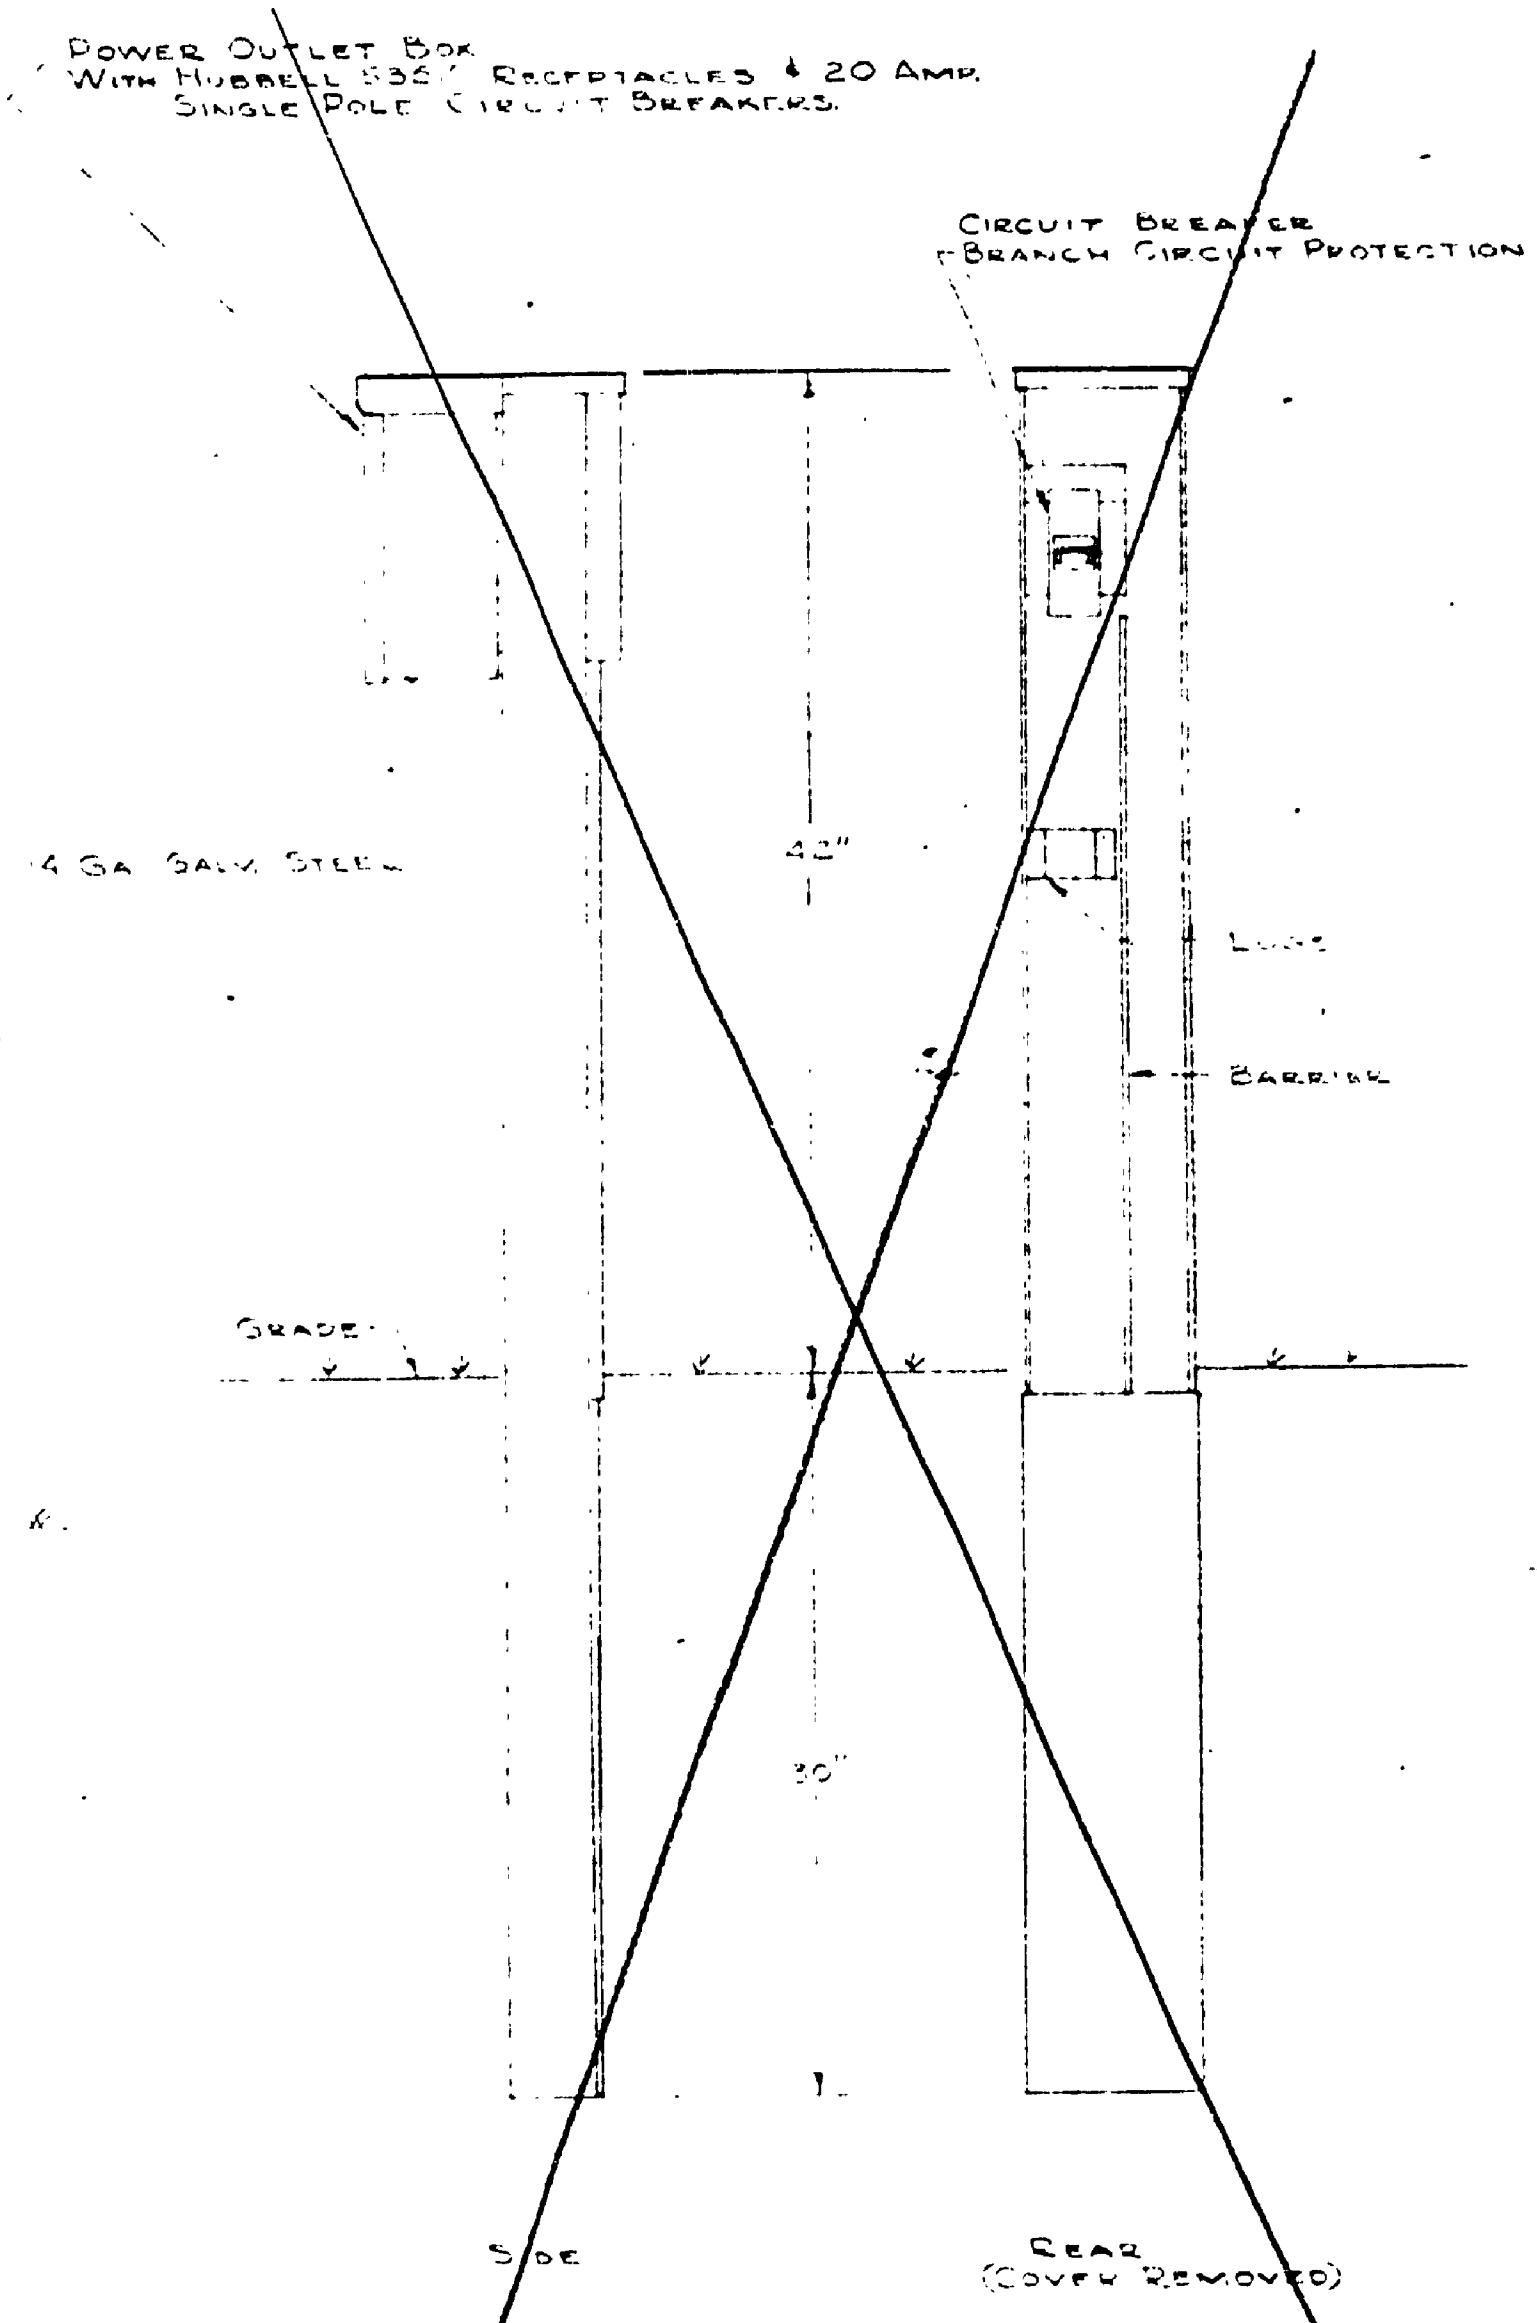

JUNCTION BOX
WITH HUBBELL 532 RECEPTACLES & 20 AMP SINGLE POLE CIRCUIT BREAKERS

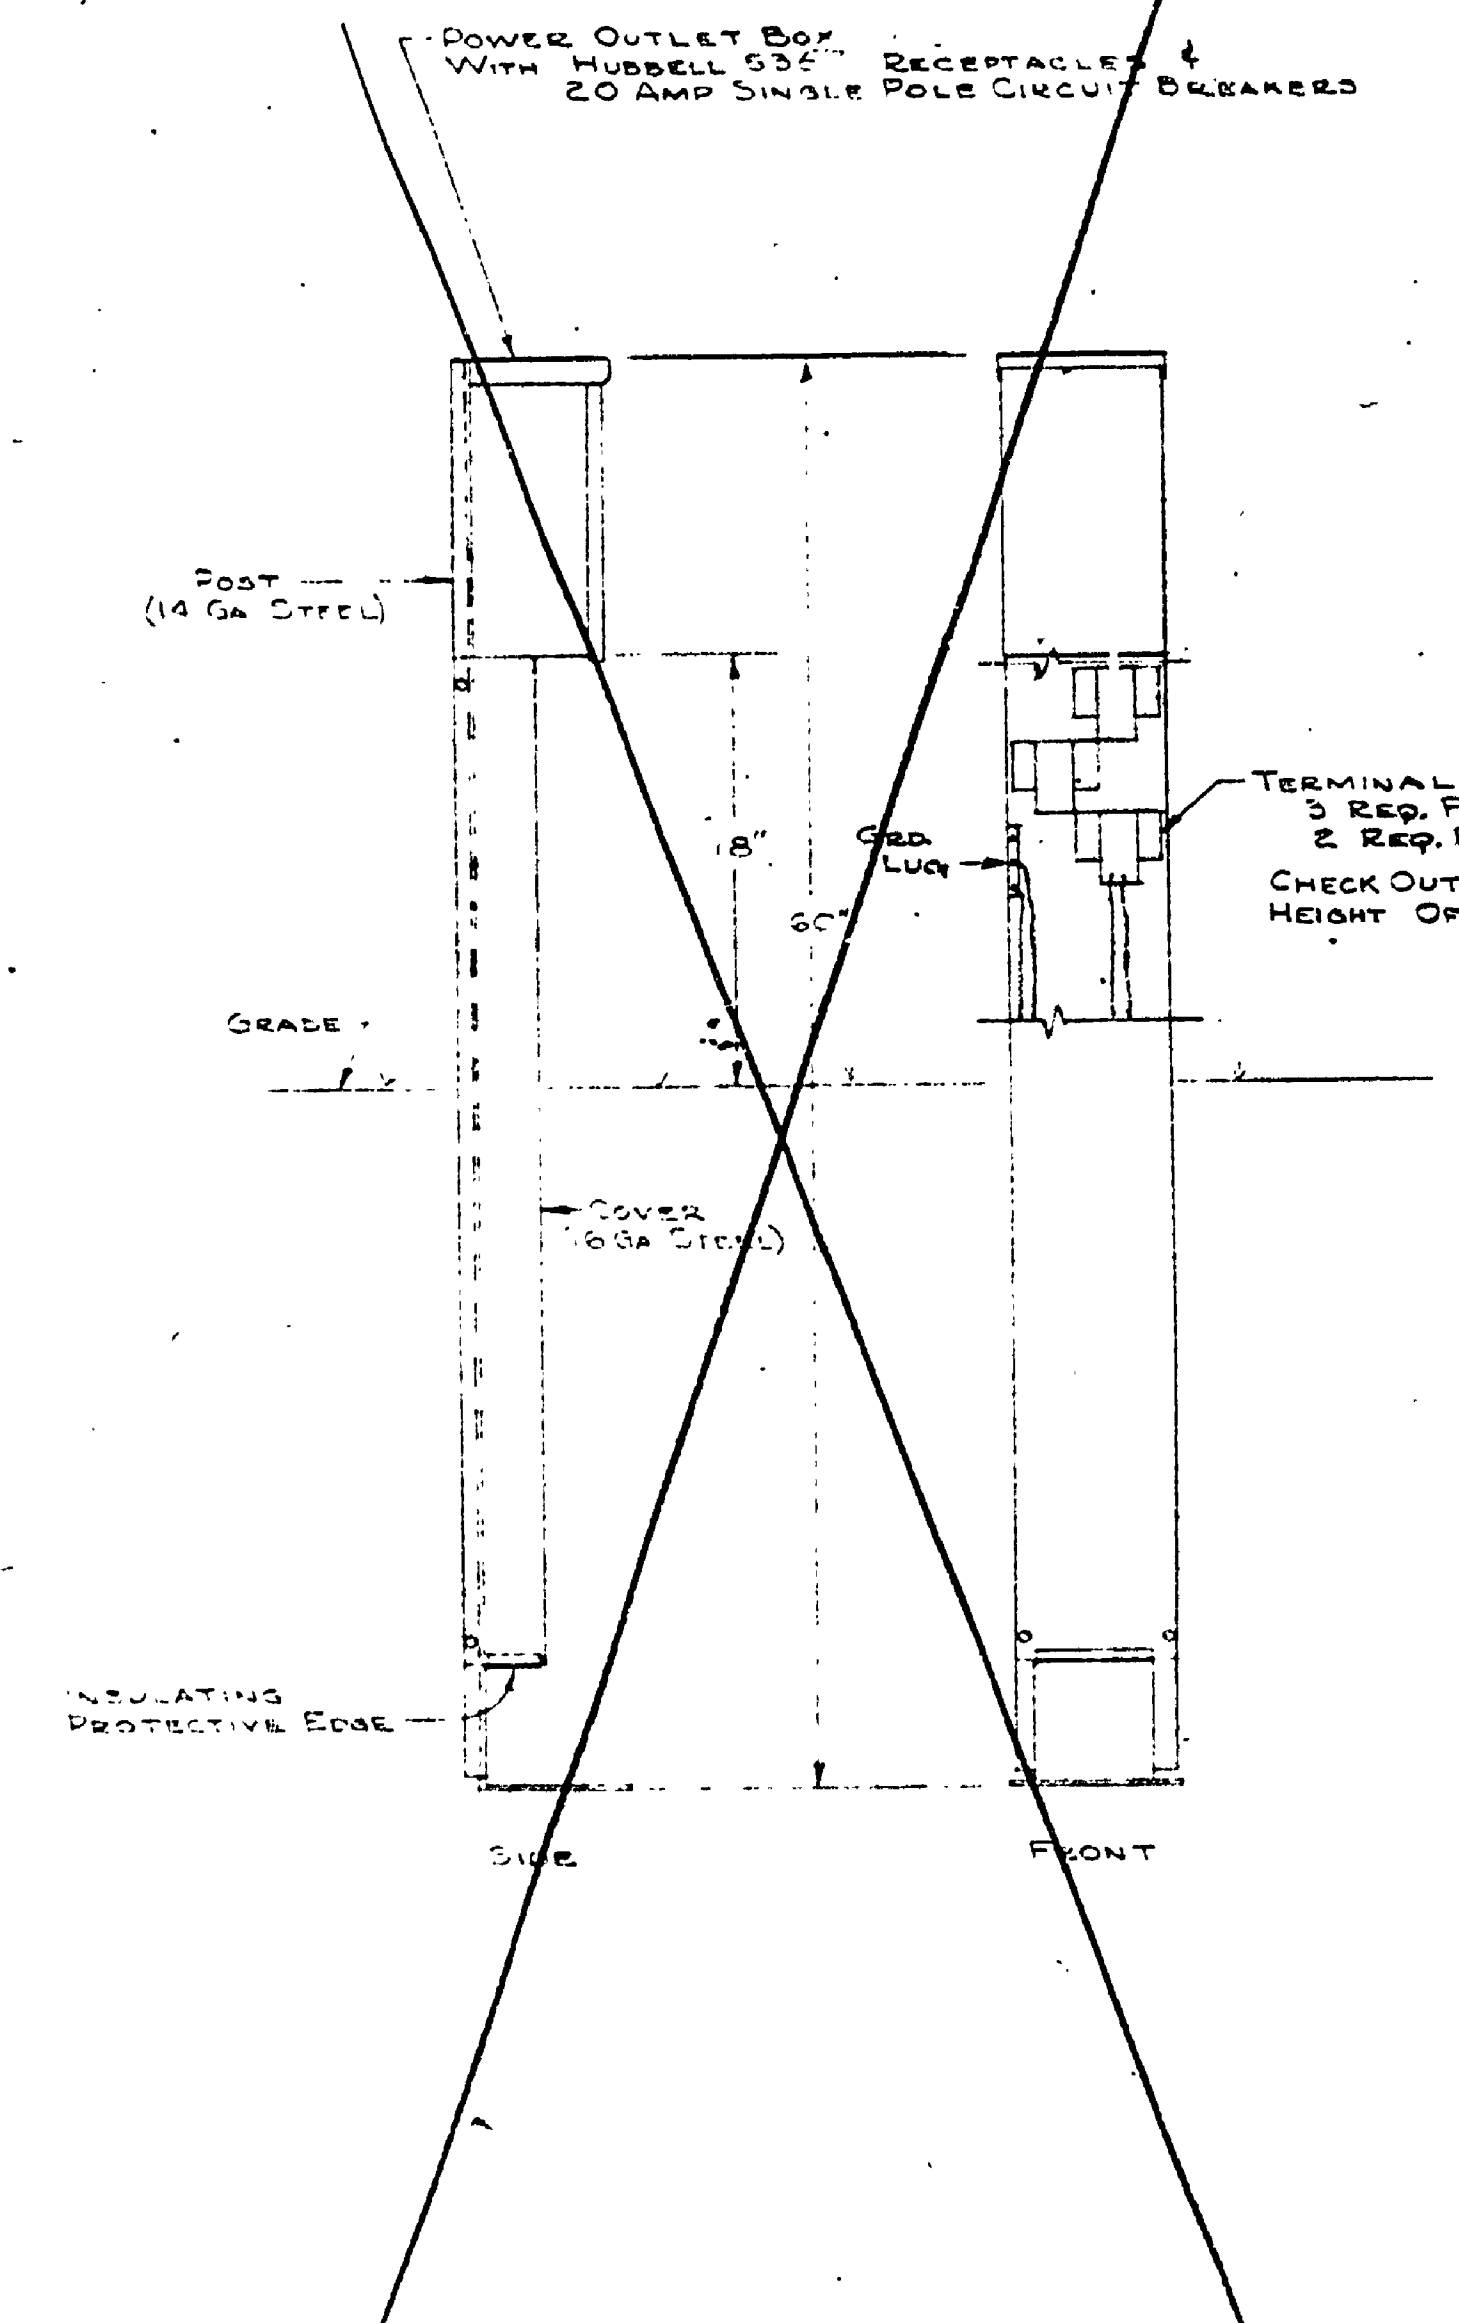

MOUNTING POST
WITH OUTLET BOX

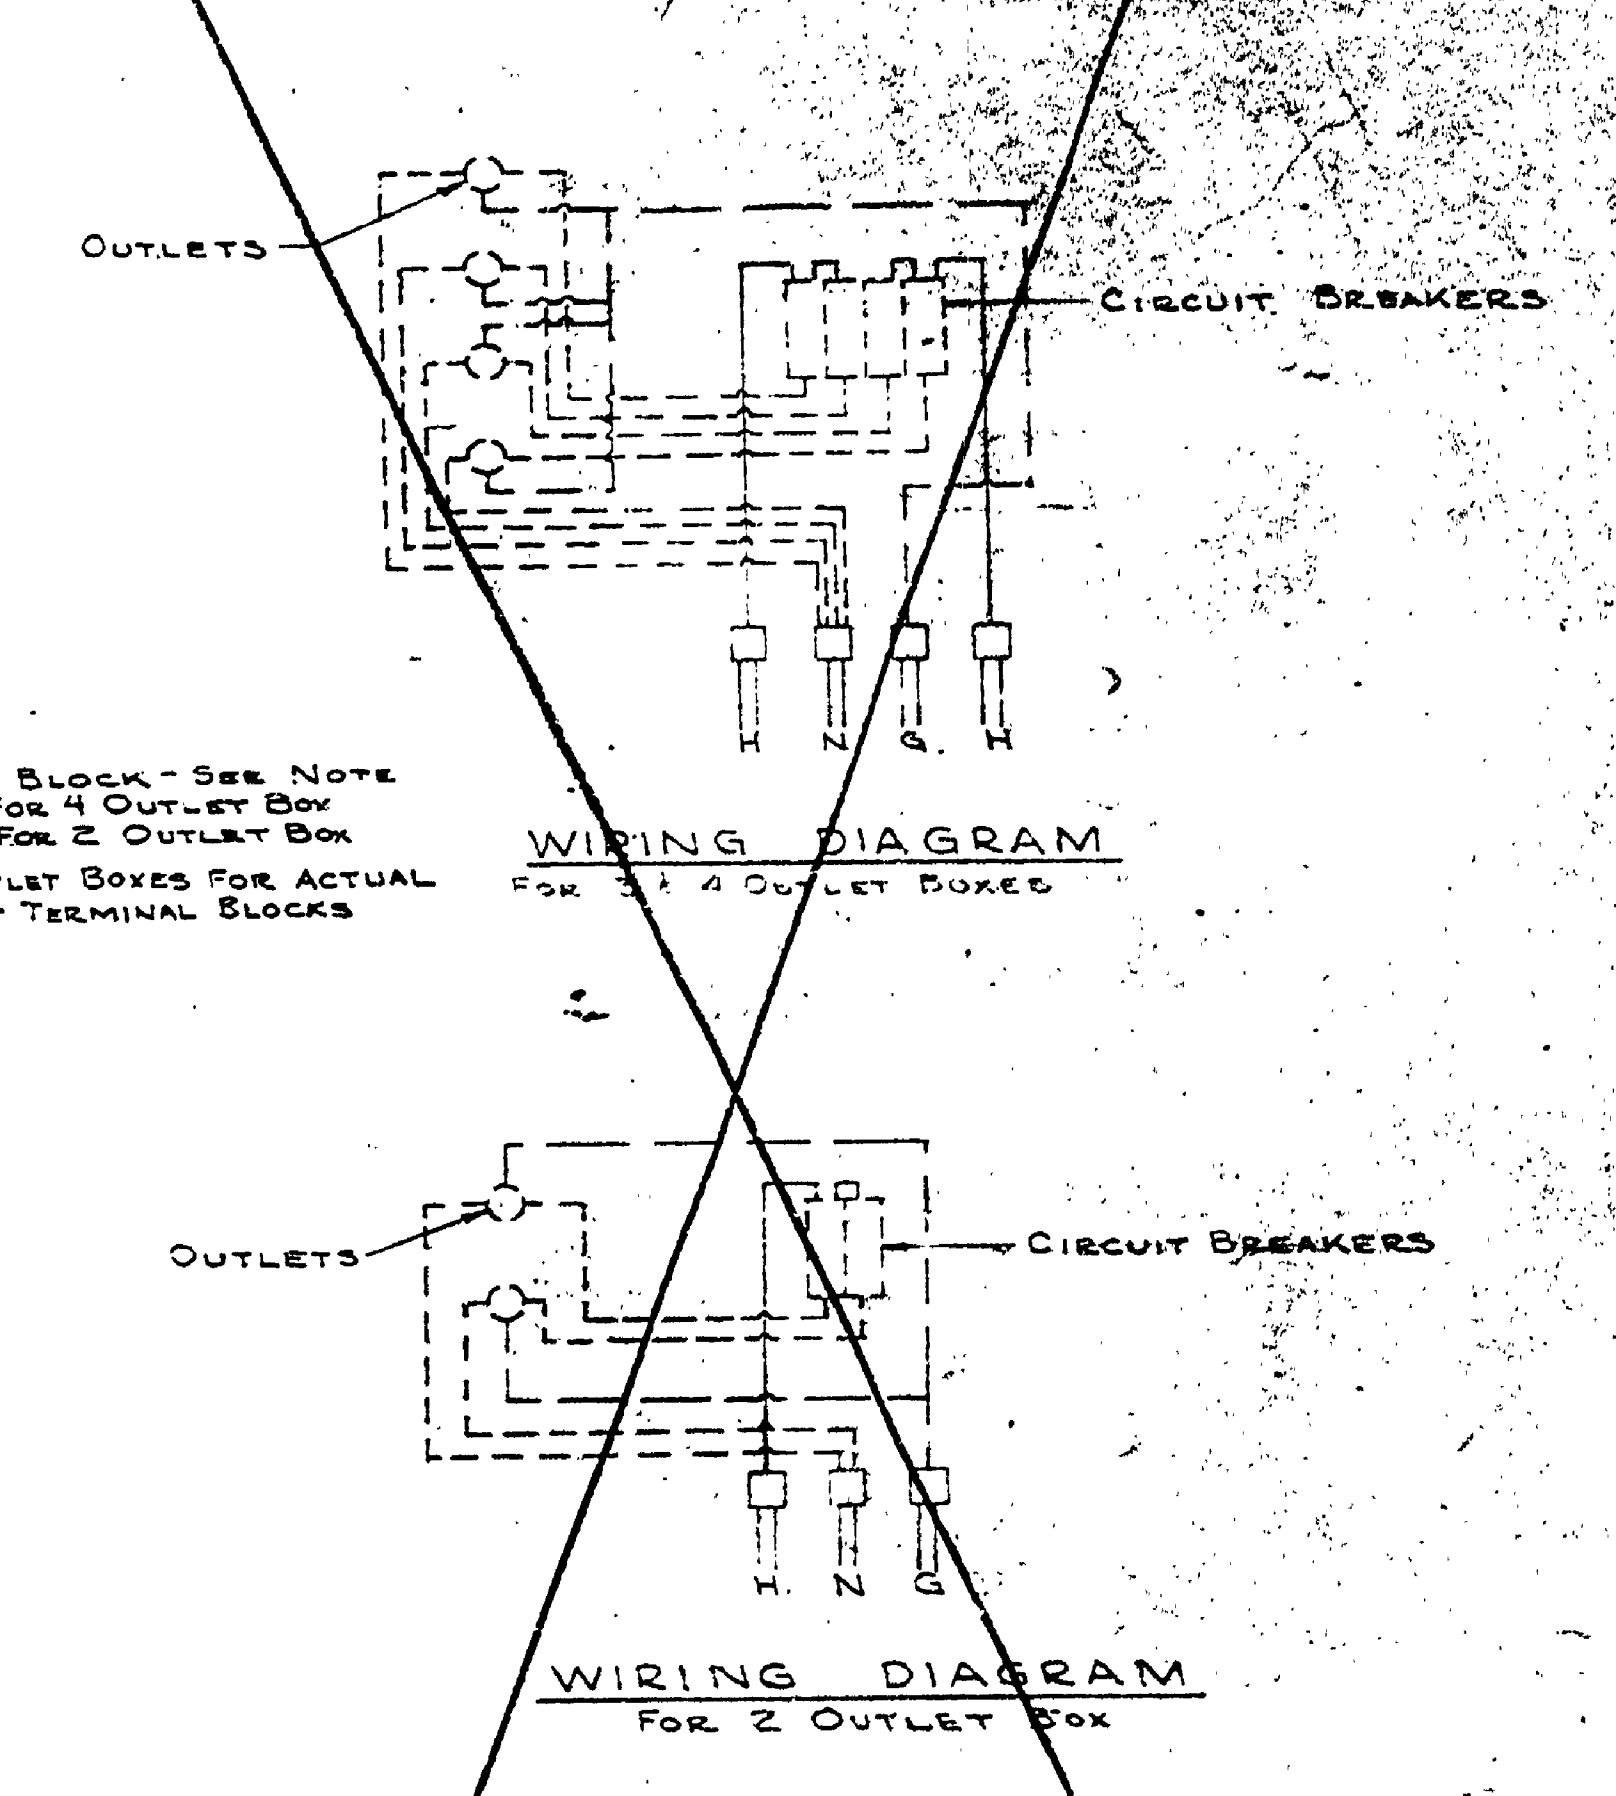

NOTE: THE POSTS ARE DESIGNED TO PERMIT LOOPING OF CABLE FROM ONE UNIT TO THE NEXT. SPlicing TO BE DONE IN POST. LUGS ARE PROVIDED TO RECEIVE UP TO #10 WIRE. WOUND TO BASE TO EQUIPMENT GROUND PROVIDED ON POST.

SURVEYED BY		DRAWN BY		NO. DATE BY		REVISIONS		NO. DATE BY		REVISIONS		MICHIGAN DEPARTMENT OF CONSERVATION	STANDARD PLAN UNDERGROUND SECONDARY FOR CAMPGROUND	SHEET NO. 2 OF 3 FOR PROJECT NO. 24-1537	ALOHA STATE PARK SHEET 2 OF 3 PLAN NO. E-1/6
DESIGNED BY		CHECKED BY		NO. DATE BY		REVISIONS		NO. DATE BY		REVISIONS					

SE-106