




Reviewed by: James Hame 3-20-73
IN CHARGE, PARK DESIGN DATE

Approved by: [Signature] 3-20-73
CHIEF, PARKS DIVISION DATE

Mullett Lake

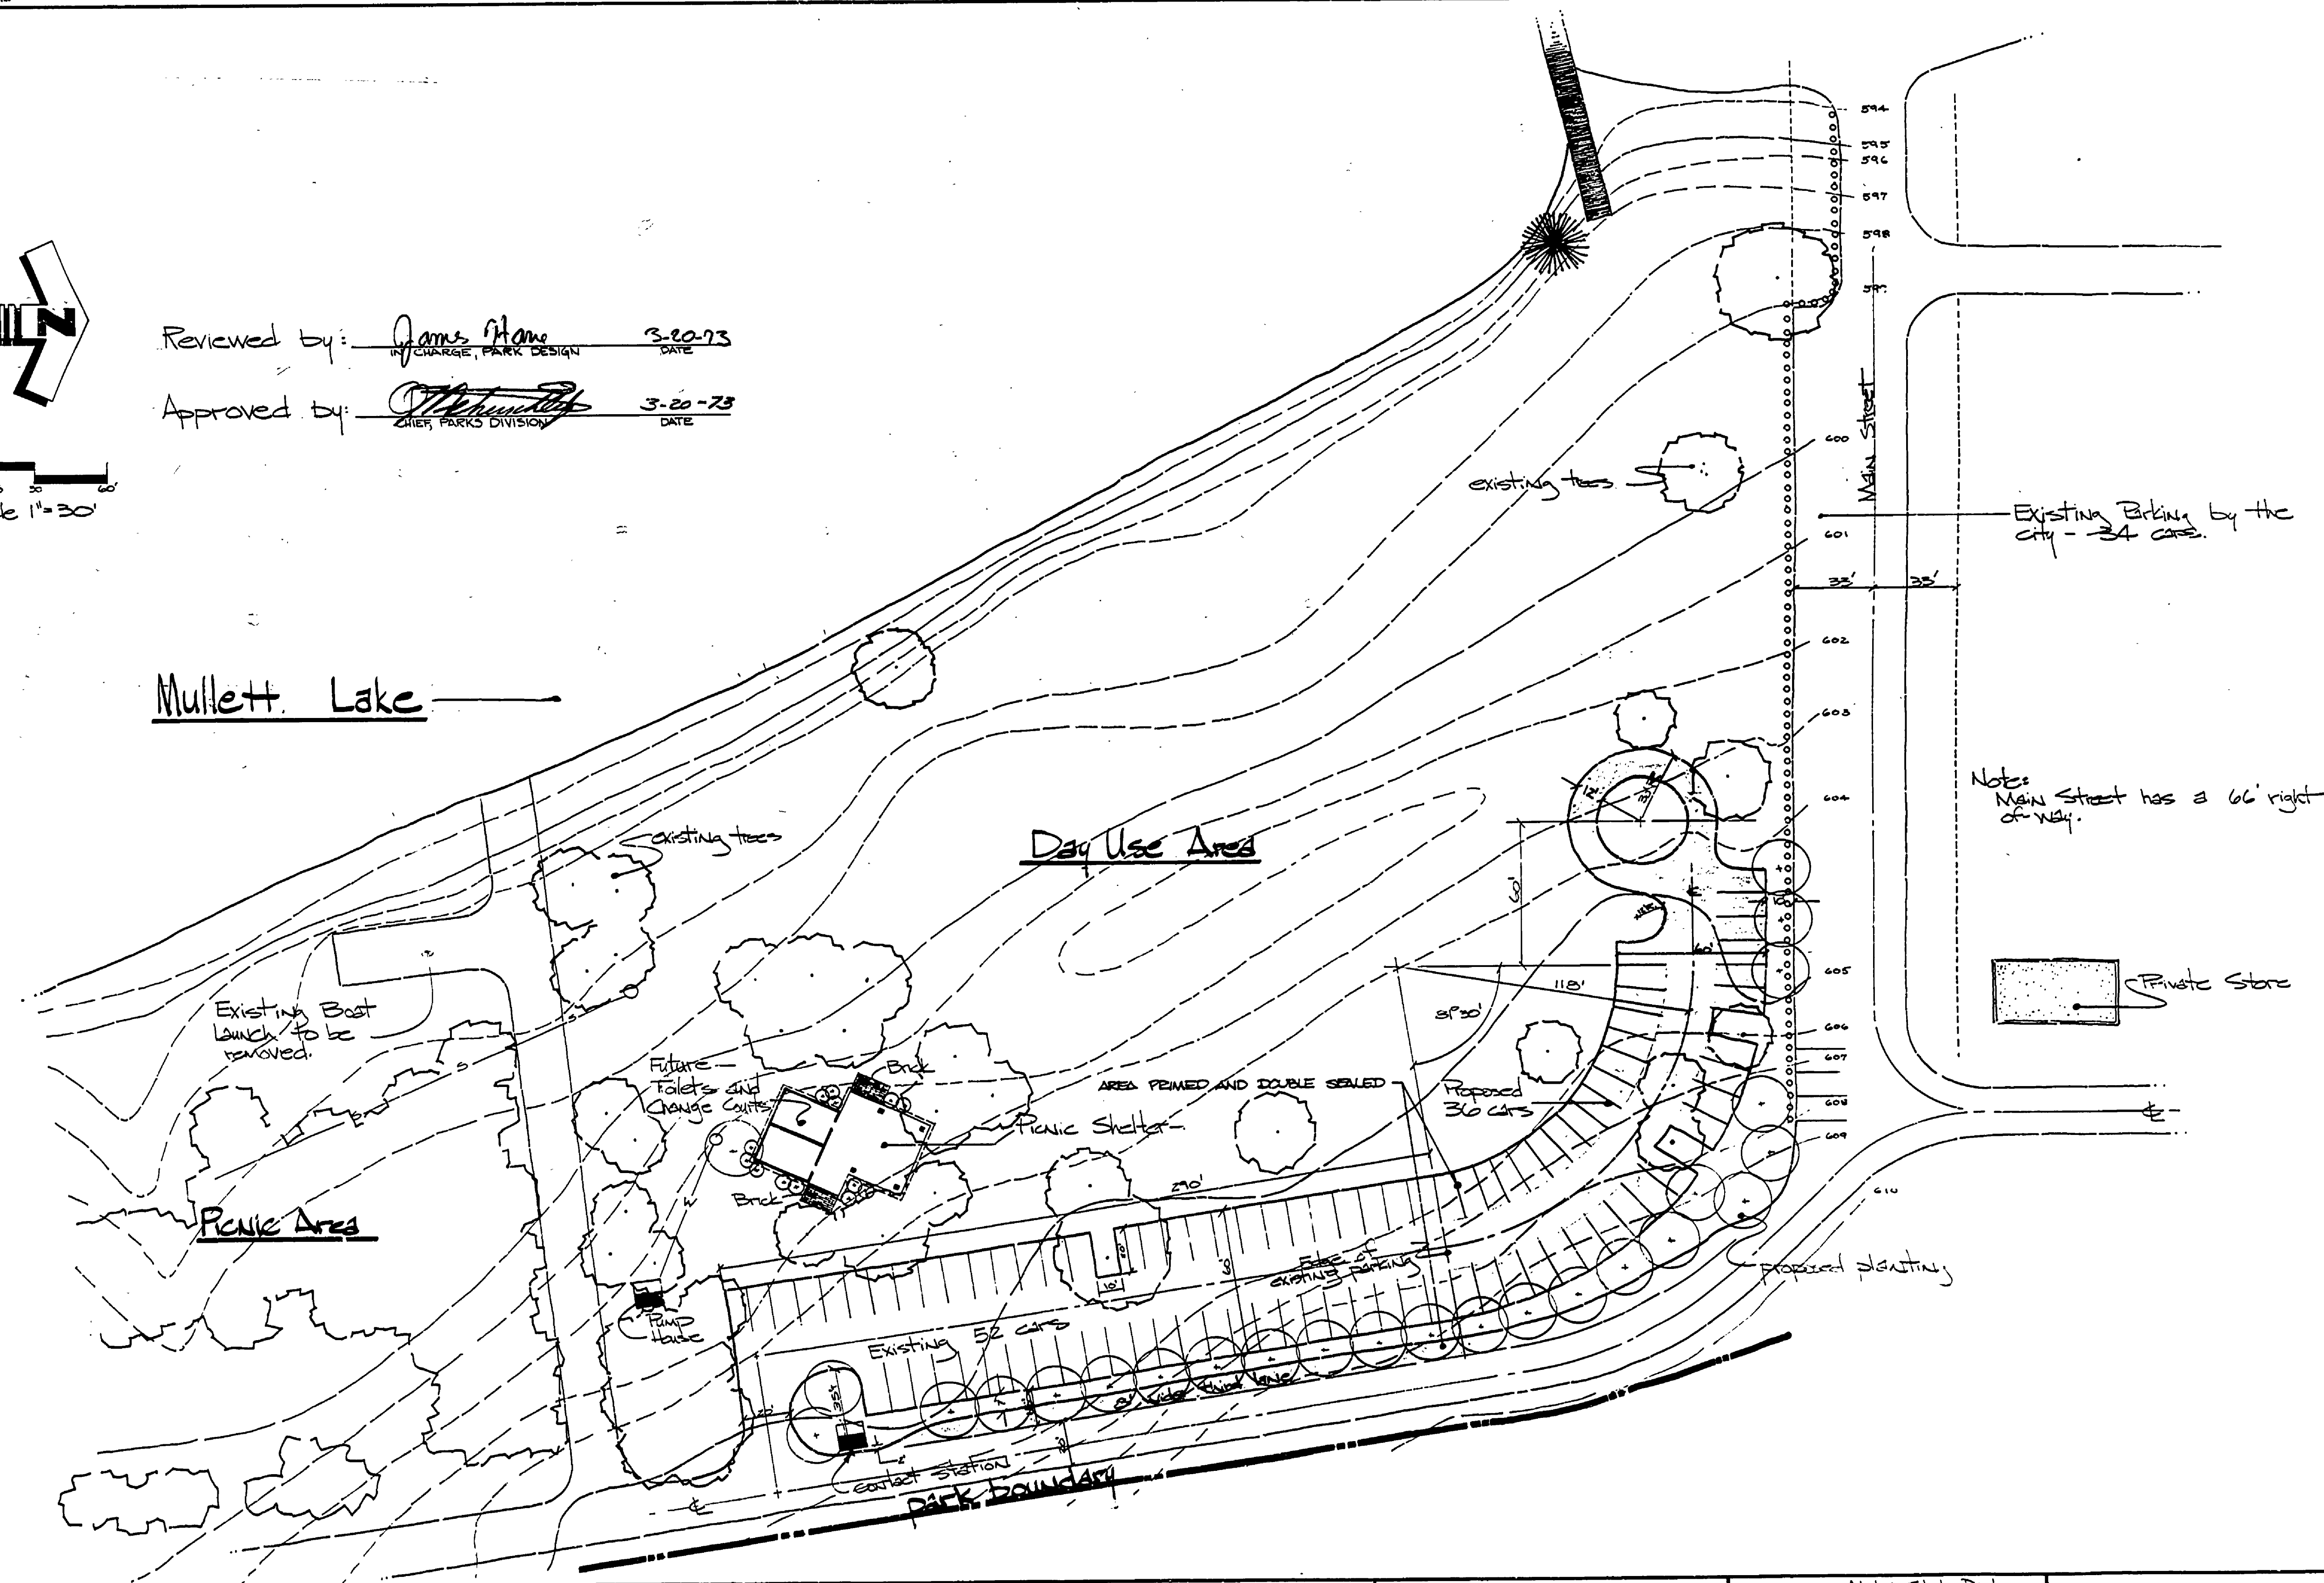

| | | | | | | | | | | | | | | | | | | | | | | | | | |
|-------------------------------|--|----------------------------|--|---------|--|----------|--|----|--|--|--|----------|--|----|--|-----------|--|--|--|-----------------------|--|--------------|--|--------------|--|
| DESIGNED BY <u>H. CHUNITH</u> | | DRAWN BY <u>R. WHITNER</u> | | 3/1/73 | | NO. DATE | | BY | | REVISIONS | | NO. DATE | | BY | | REVISIONS | | MICHIGAN DEPARTMENT OF NATURAL RESOURCES | | ALoha STATE PARK | | AREA OR PARK | | PROJECT NO. | |
| DATE | | CHECKED BY <u>R. G. V.</u> | | 3/19/73 | | 1. 10-74 | | | | PRIME & DOUBLE SEAL PAVING LOT EXPANSION | | 3. | | | | | | ALoha STATE PARK | | parking lot expansion | | PROJECT NO. | | SHEET 1 OF 1 | |
| | | DATE | | DATE | | DATE | | | | 4. | | | | | | | | SHEET TITLE | | PLAN NO. L-109 | | | | | |