


REVISIONS	NO.	DATE	BY
	1	7-23-67	GMH
	2	4/70	PSS
	3		
	4		
	5		
	6		

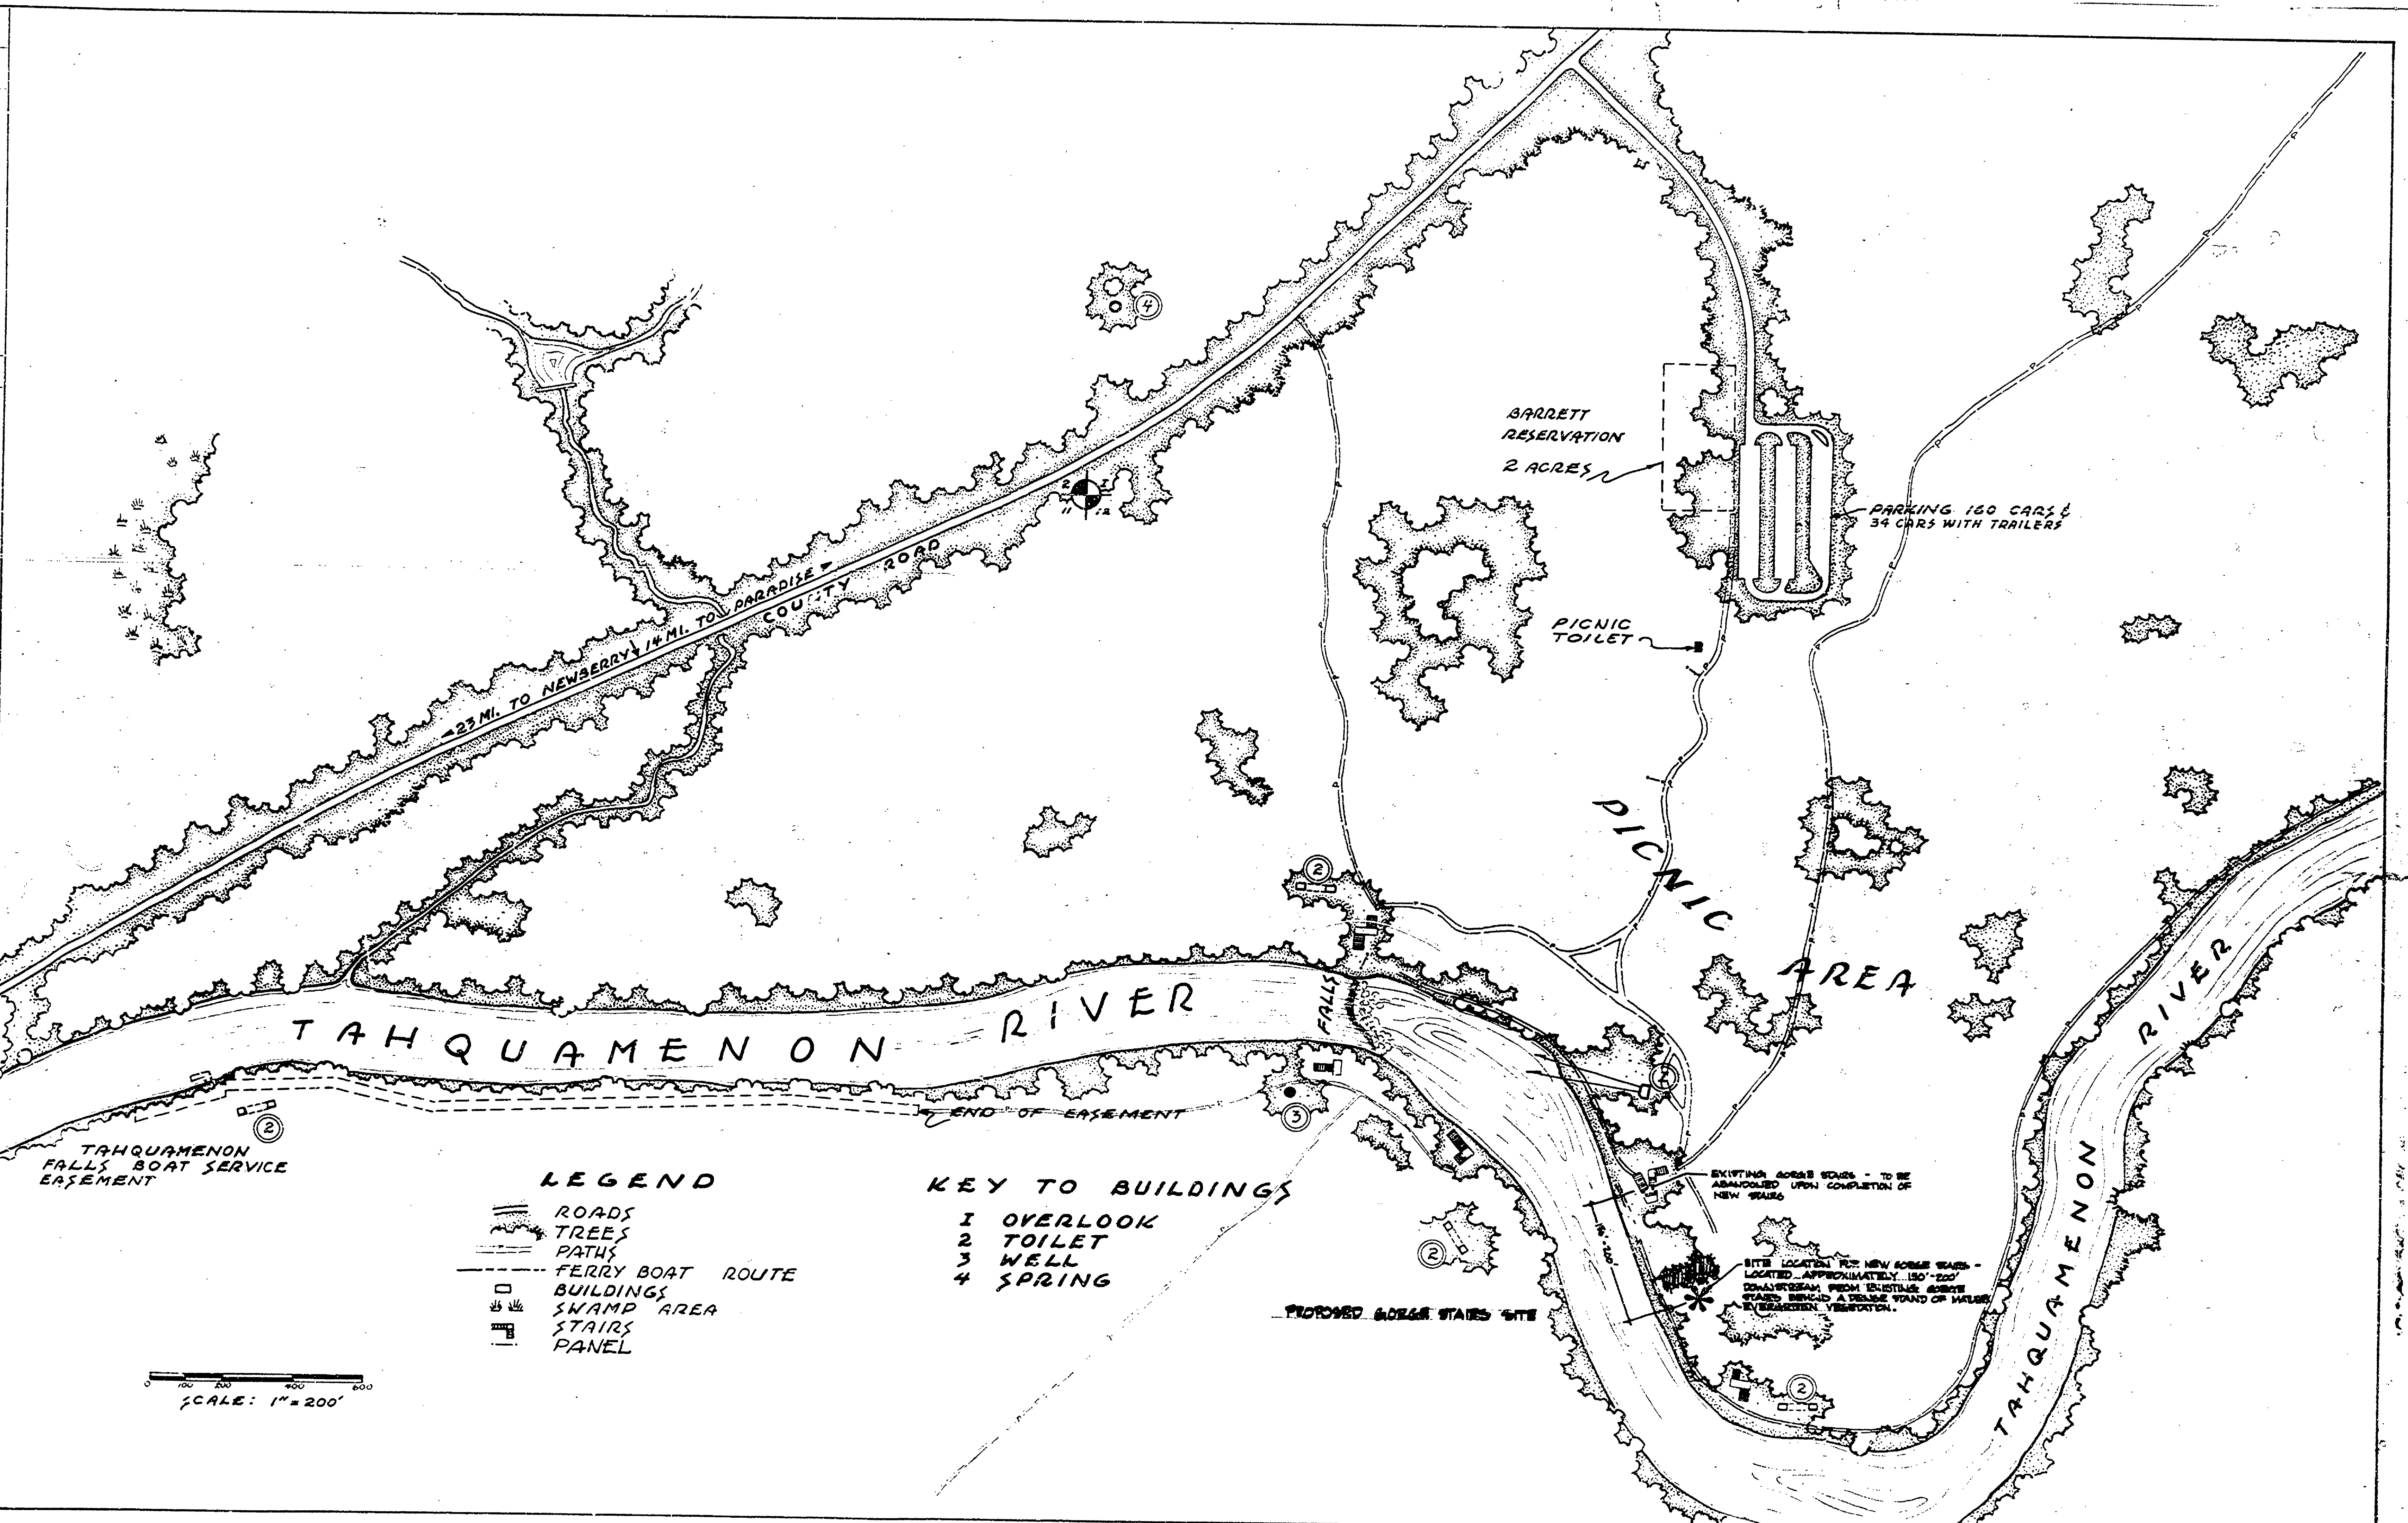

SCALE: 1" = 200'

- LEGEND**
- ROADS
 - TREES
 - PATHS
 - FERRY BOAT ROUTE
 - BUILDINGS
 - SWAMP AREA
 - STAIRS
 - PANEL

- KEY TO BUILDINGS**
- 1 OVERLOOK
 - 2 TOILET
 - 3 WELL
 - 4 SPRING

MICHIGAN
DEPARTMENT OF CONSERVATION
PARKS AND RECREATION DIVISION

TAHQUAMENON FALLS STATE PARK
UPPER FALLS
GORGE STAIRS

SHEET
NO. 1
OF 1

PLAN NO.
L-119