
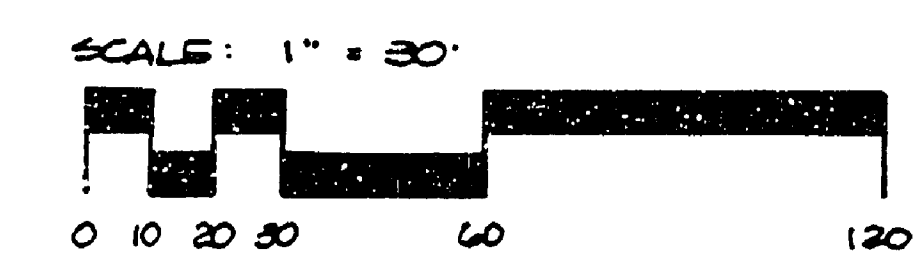
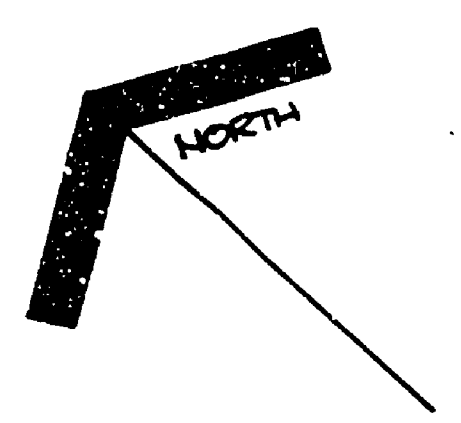


LEGEND

- P — POWER LINE
- T — TELEPHONE LINE
- UTILITY POLE
- MAN HOLE
- ⊙ GAS PUMP
- x TELEPHONE PEDESTAL

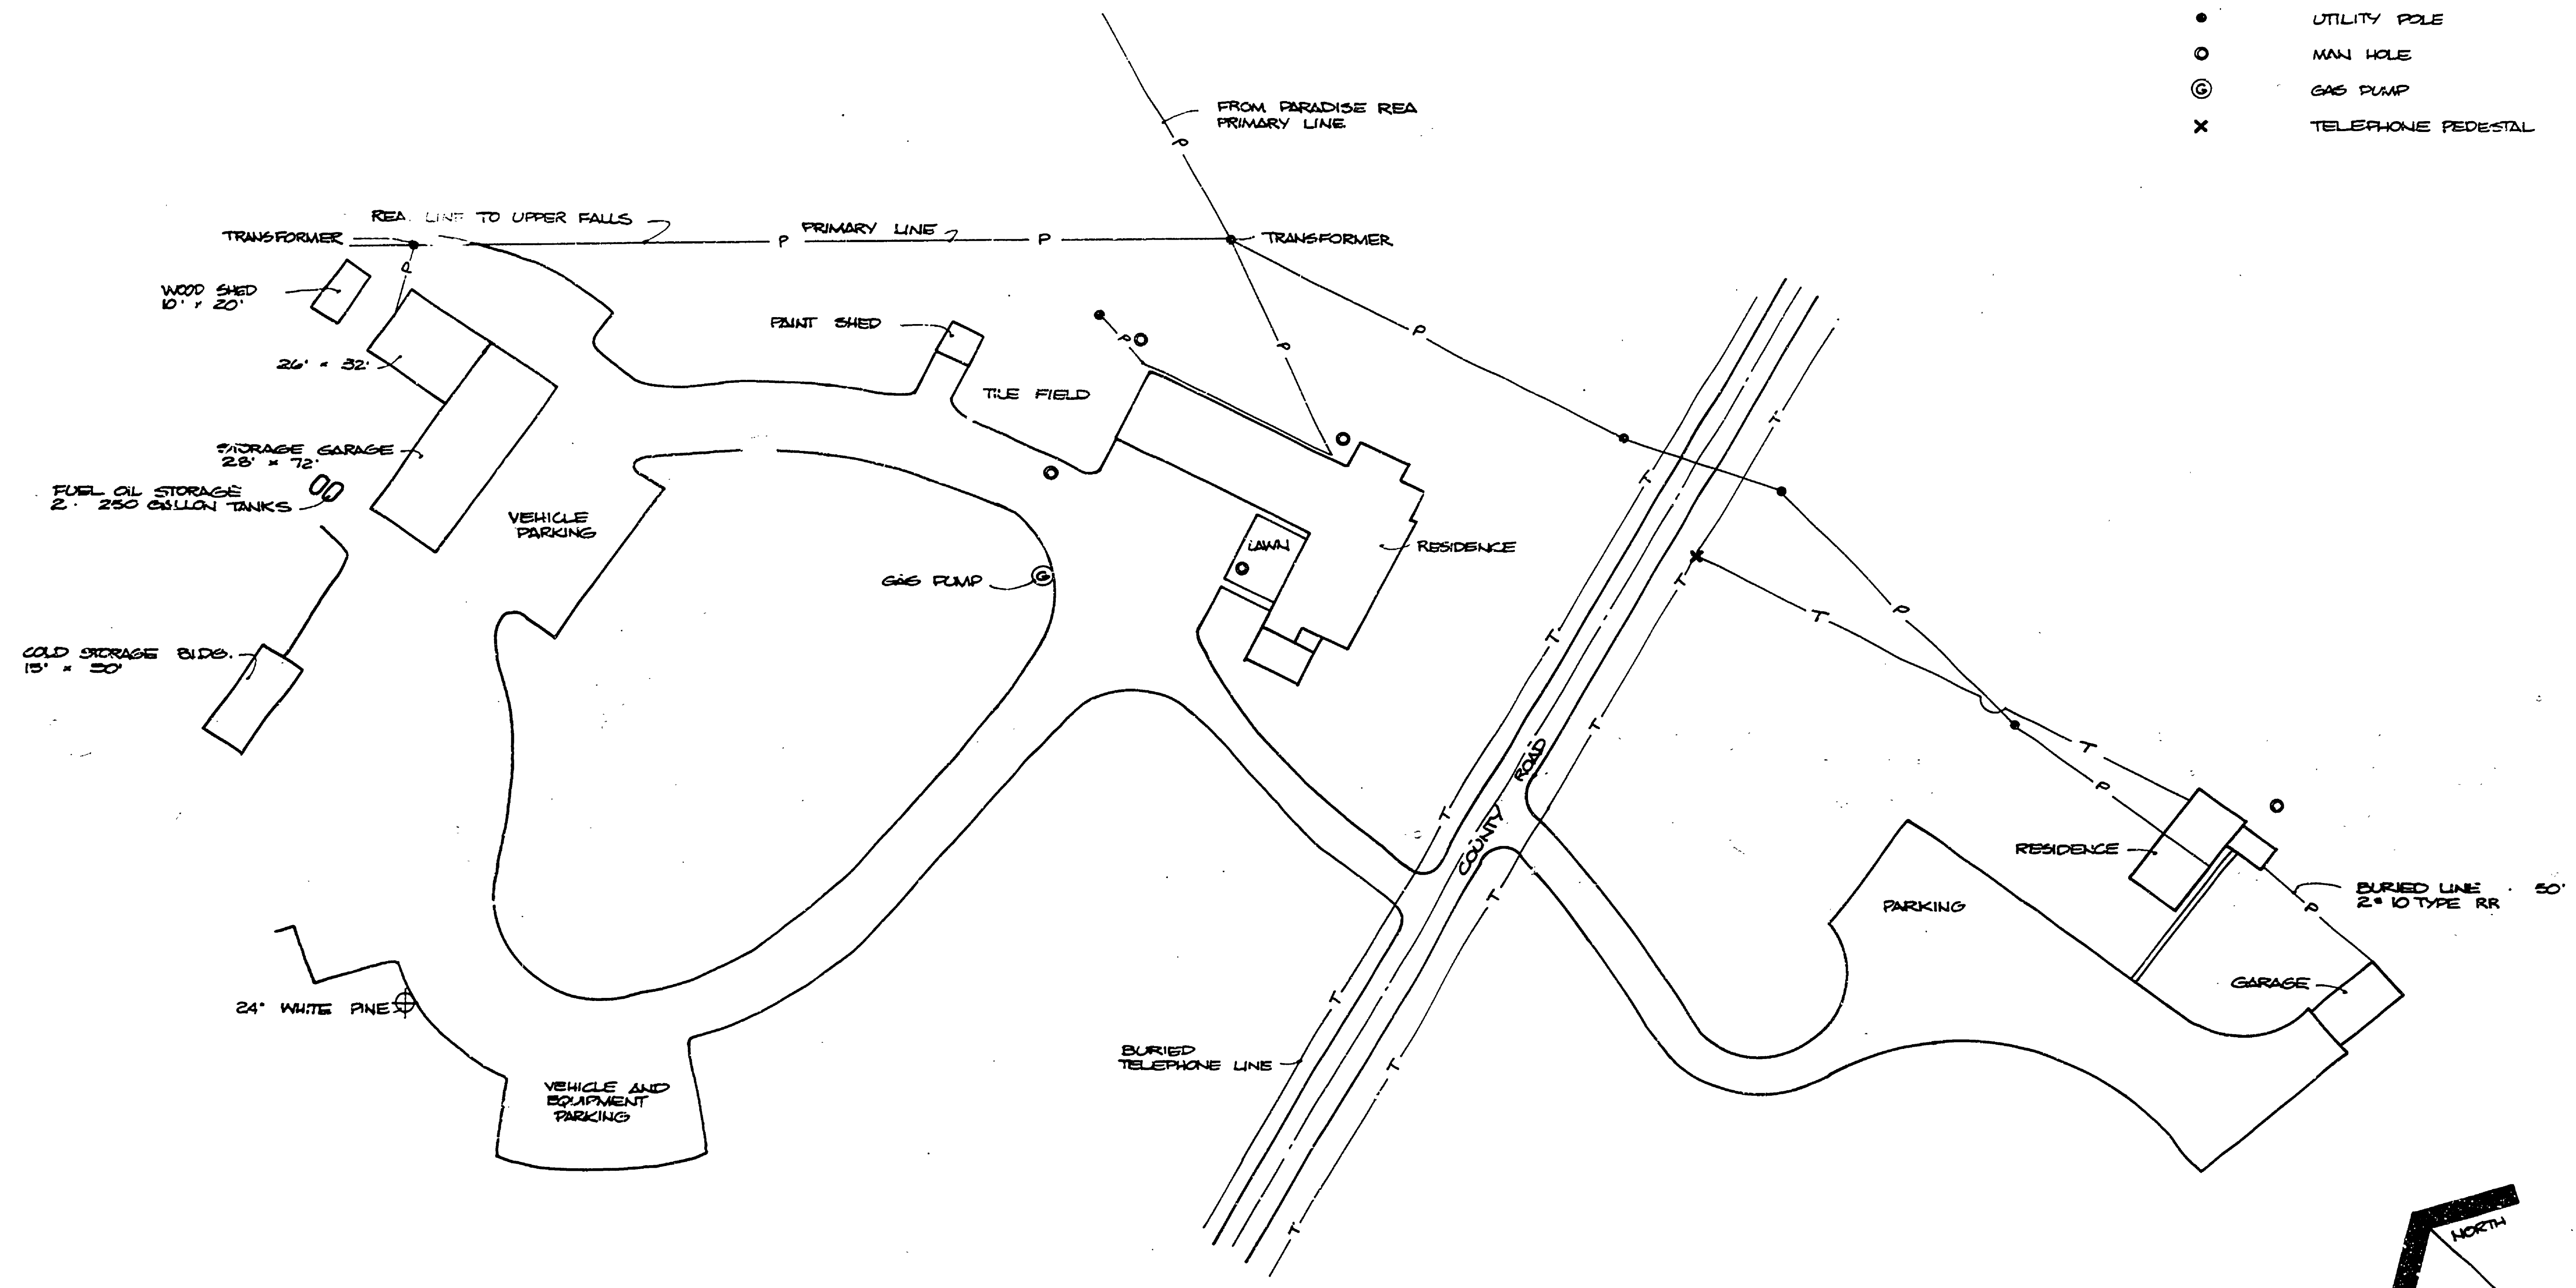

SURVEYED BY	DRAWN BY J. DOBRIN	8/78	NO.	DATE	BY	REVISIONS	NO.	DATE	BY	REVISIONS	MICHIGAN DEPARTMENT OF NATURAL RESOURCES	TAHOQUAMENON FALLS S.P. AREA OR PARK	PROJECT NO.
DESIGNED BY	CHECKED BY	DATE	1.	7/16/66	CRM	BROUGHT UP TO DATE	3.				HEADQUARTERS AREA AS BUILT SHEET TITLE	HEADQUARTERS AREA PROJECT ELECTRICAL UTILITIES & TELEPHONE	SHEET 1 OF 1
			2.	8/78	JD	REVISED PER FIELD INFORMATION	4.						PLAN NO. L-125