


PARTIAL RESURVEY  
IN  
T. 48 N. R. 6 W.

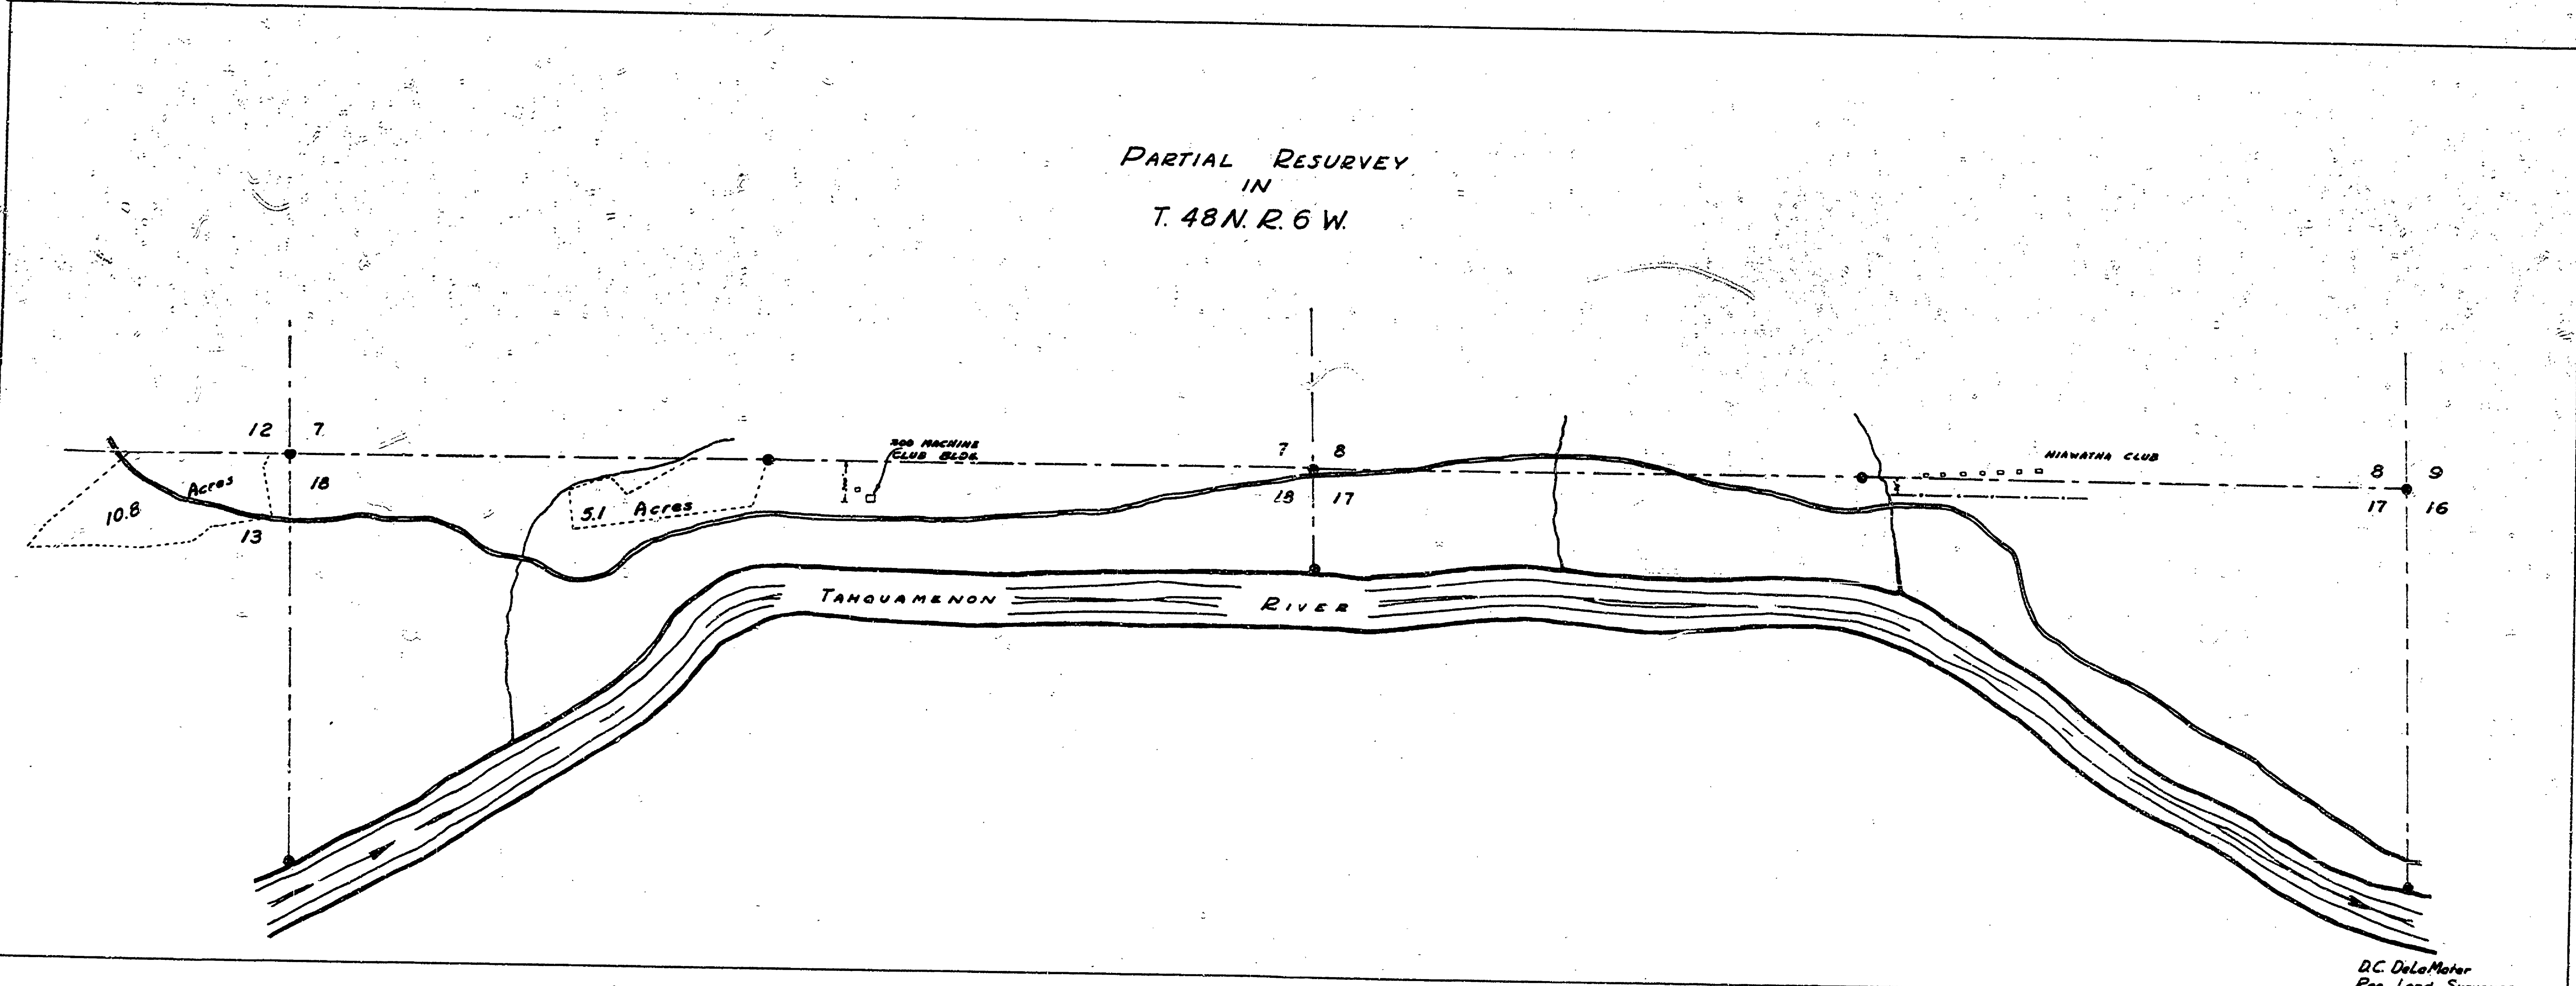

D.C. DeLoMater  
Reg. Land Surveyor

Tanguamenon Falls S.P. R-7