



DESIGNED BY	DATE	REVIEWED	DATE	APPROVED	DATE	NO.	DATE	BY	REVISIONS	DATE	BY
ARCHITECTURAL	5/1/64					1			1		
ENGINEERING	5/1/64					2			2		
LANDSCAPE						3			3		
									4		

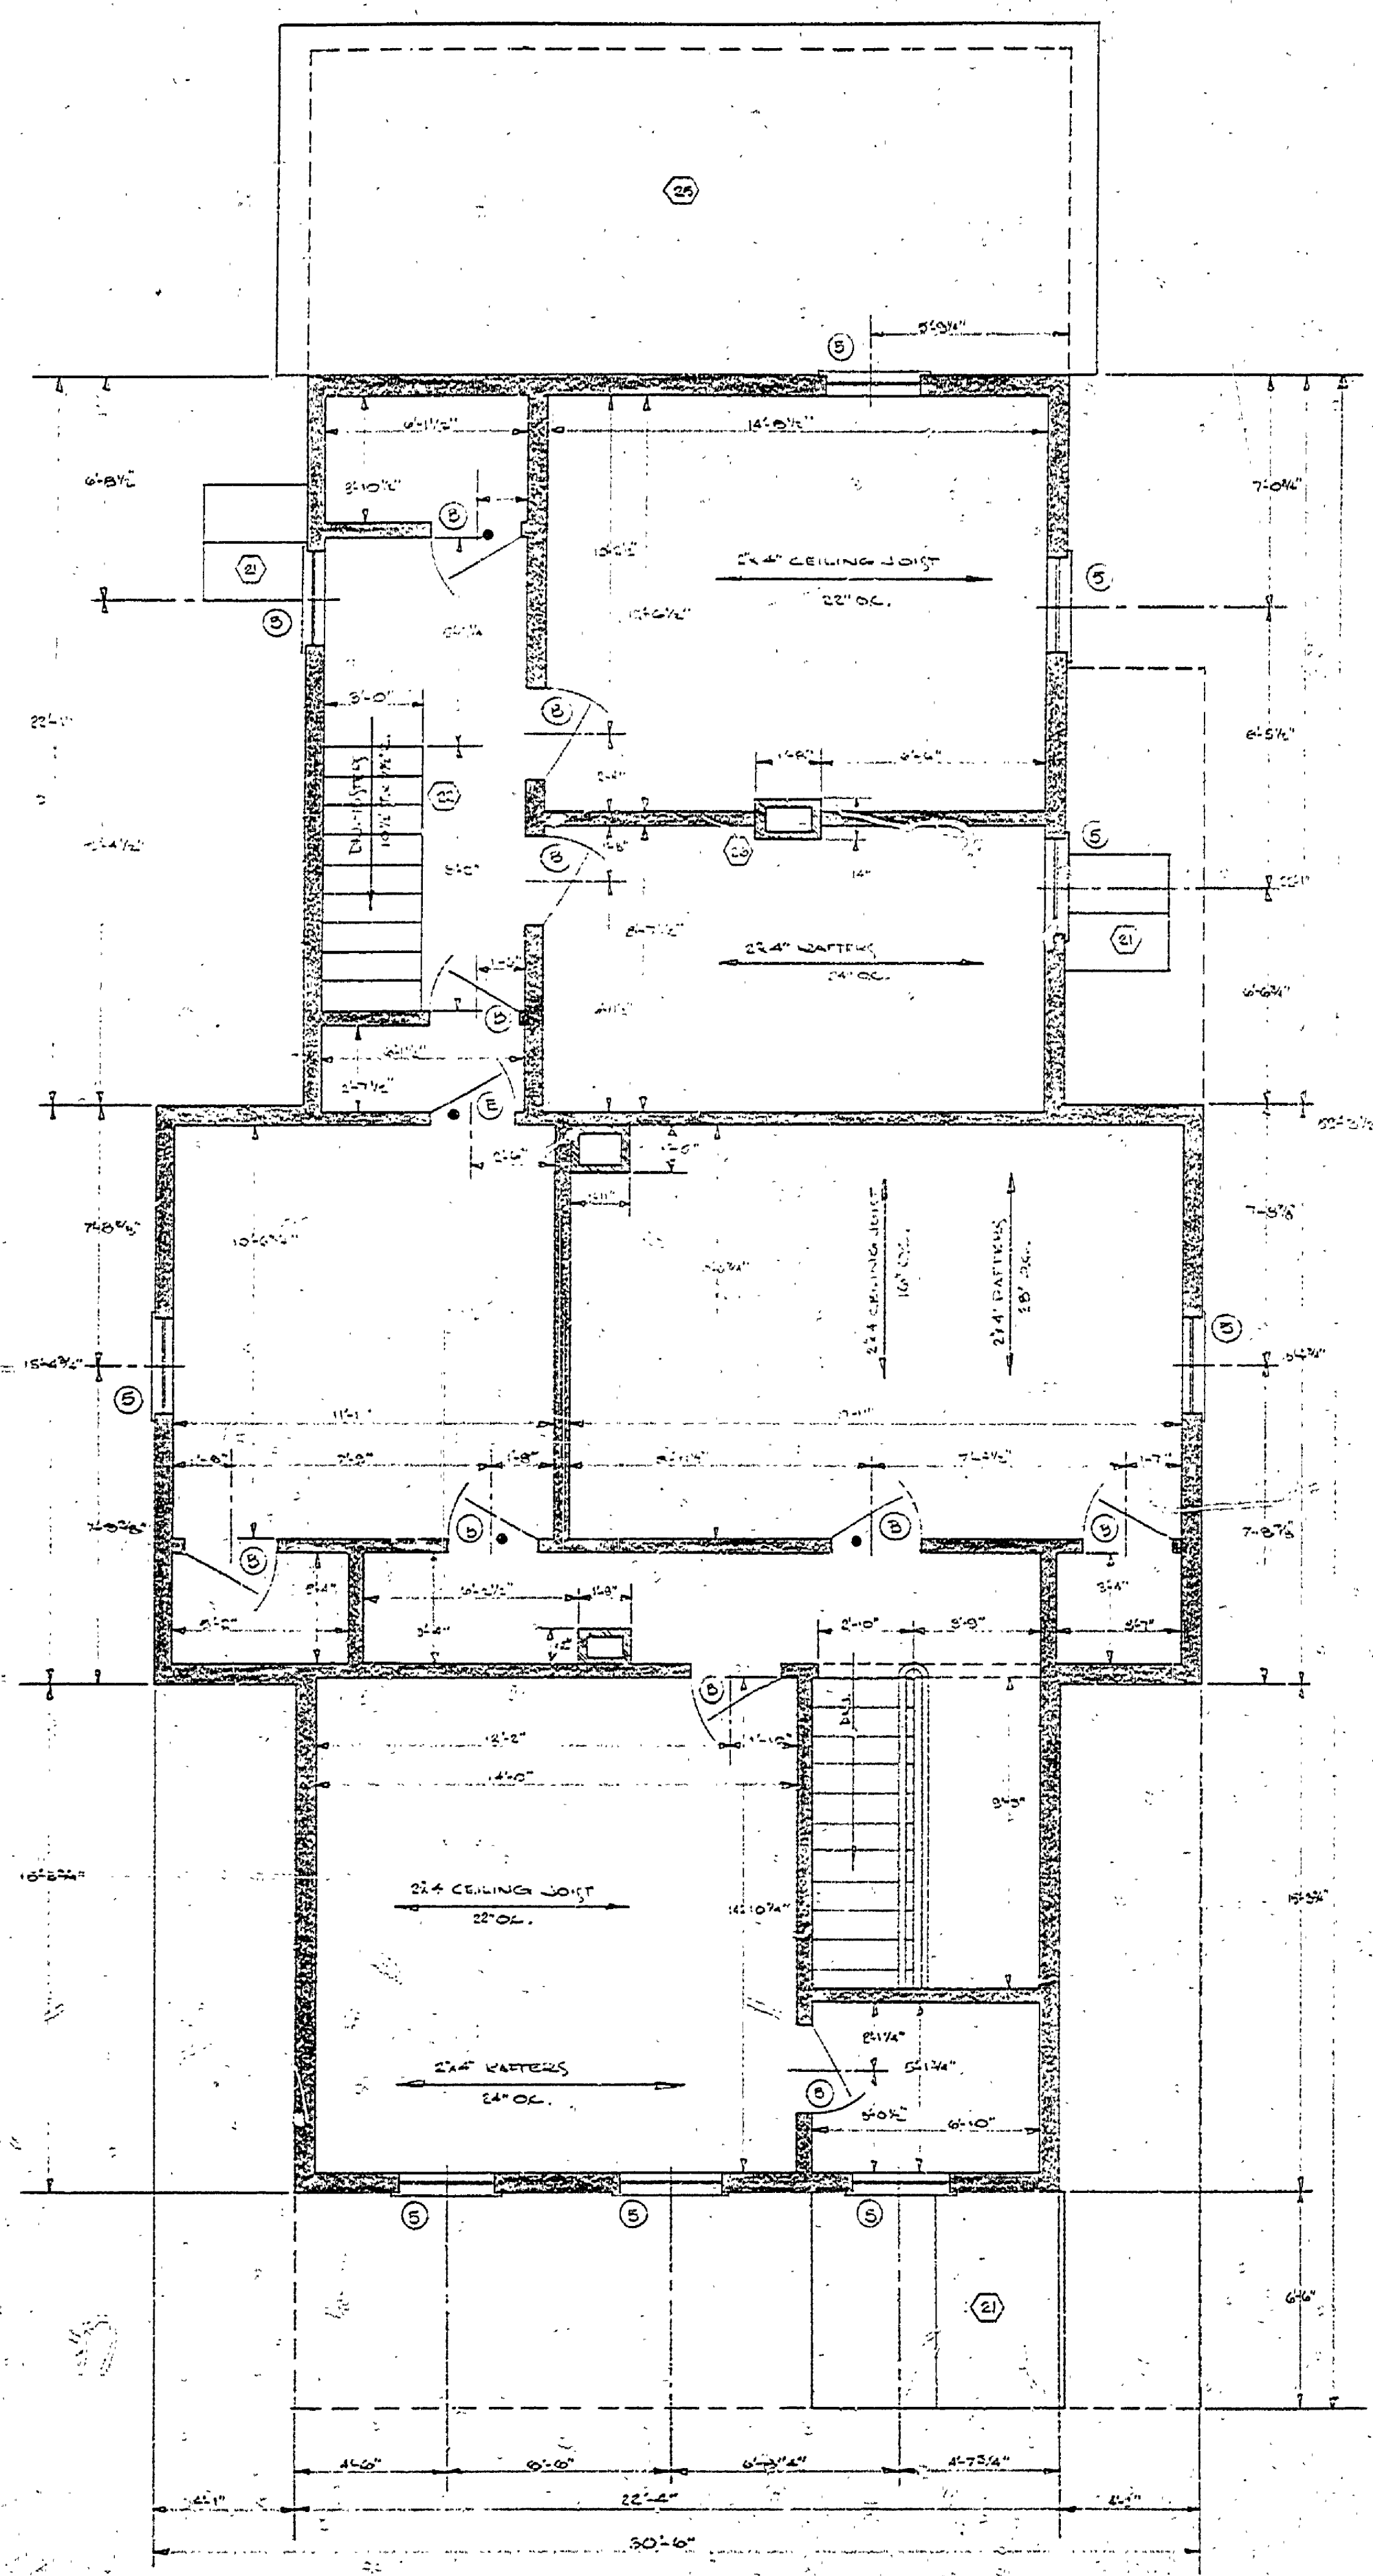

SECOND FLOOR PLAN  
SCALE 1/8"=1'-0"

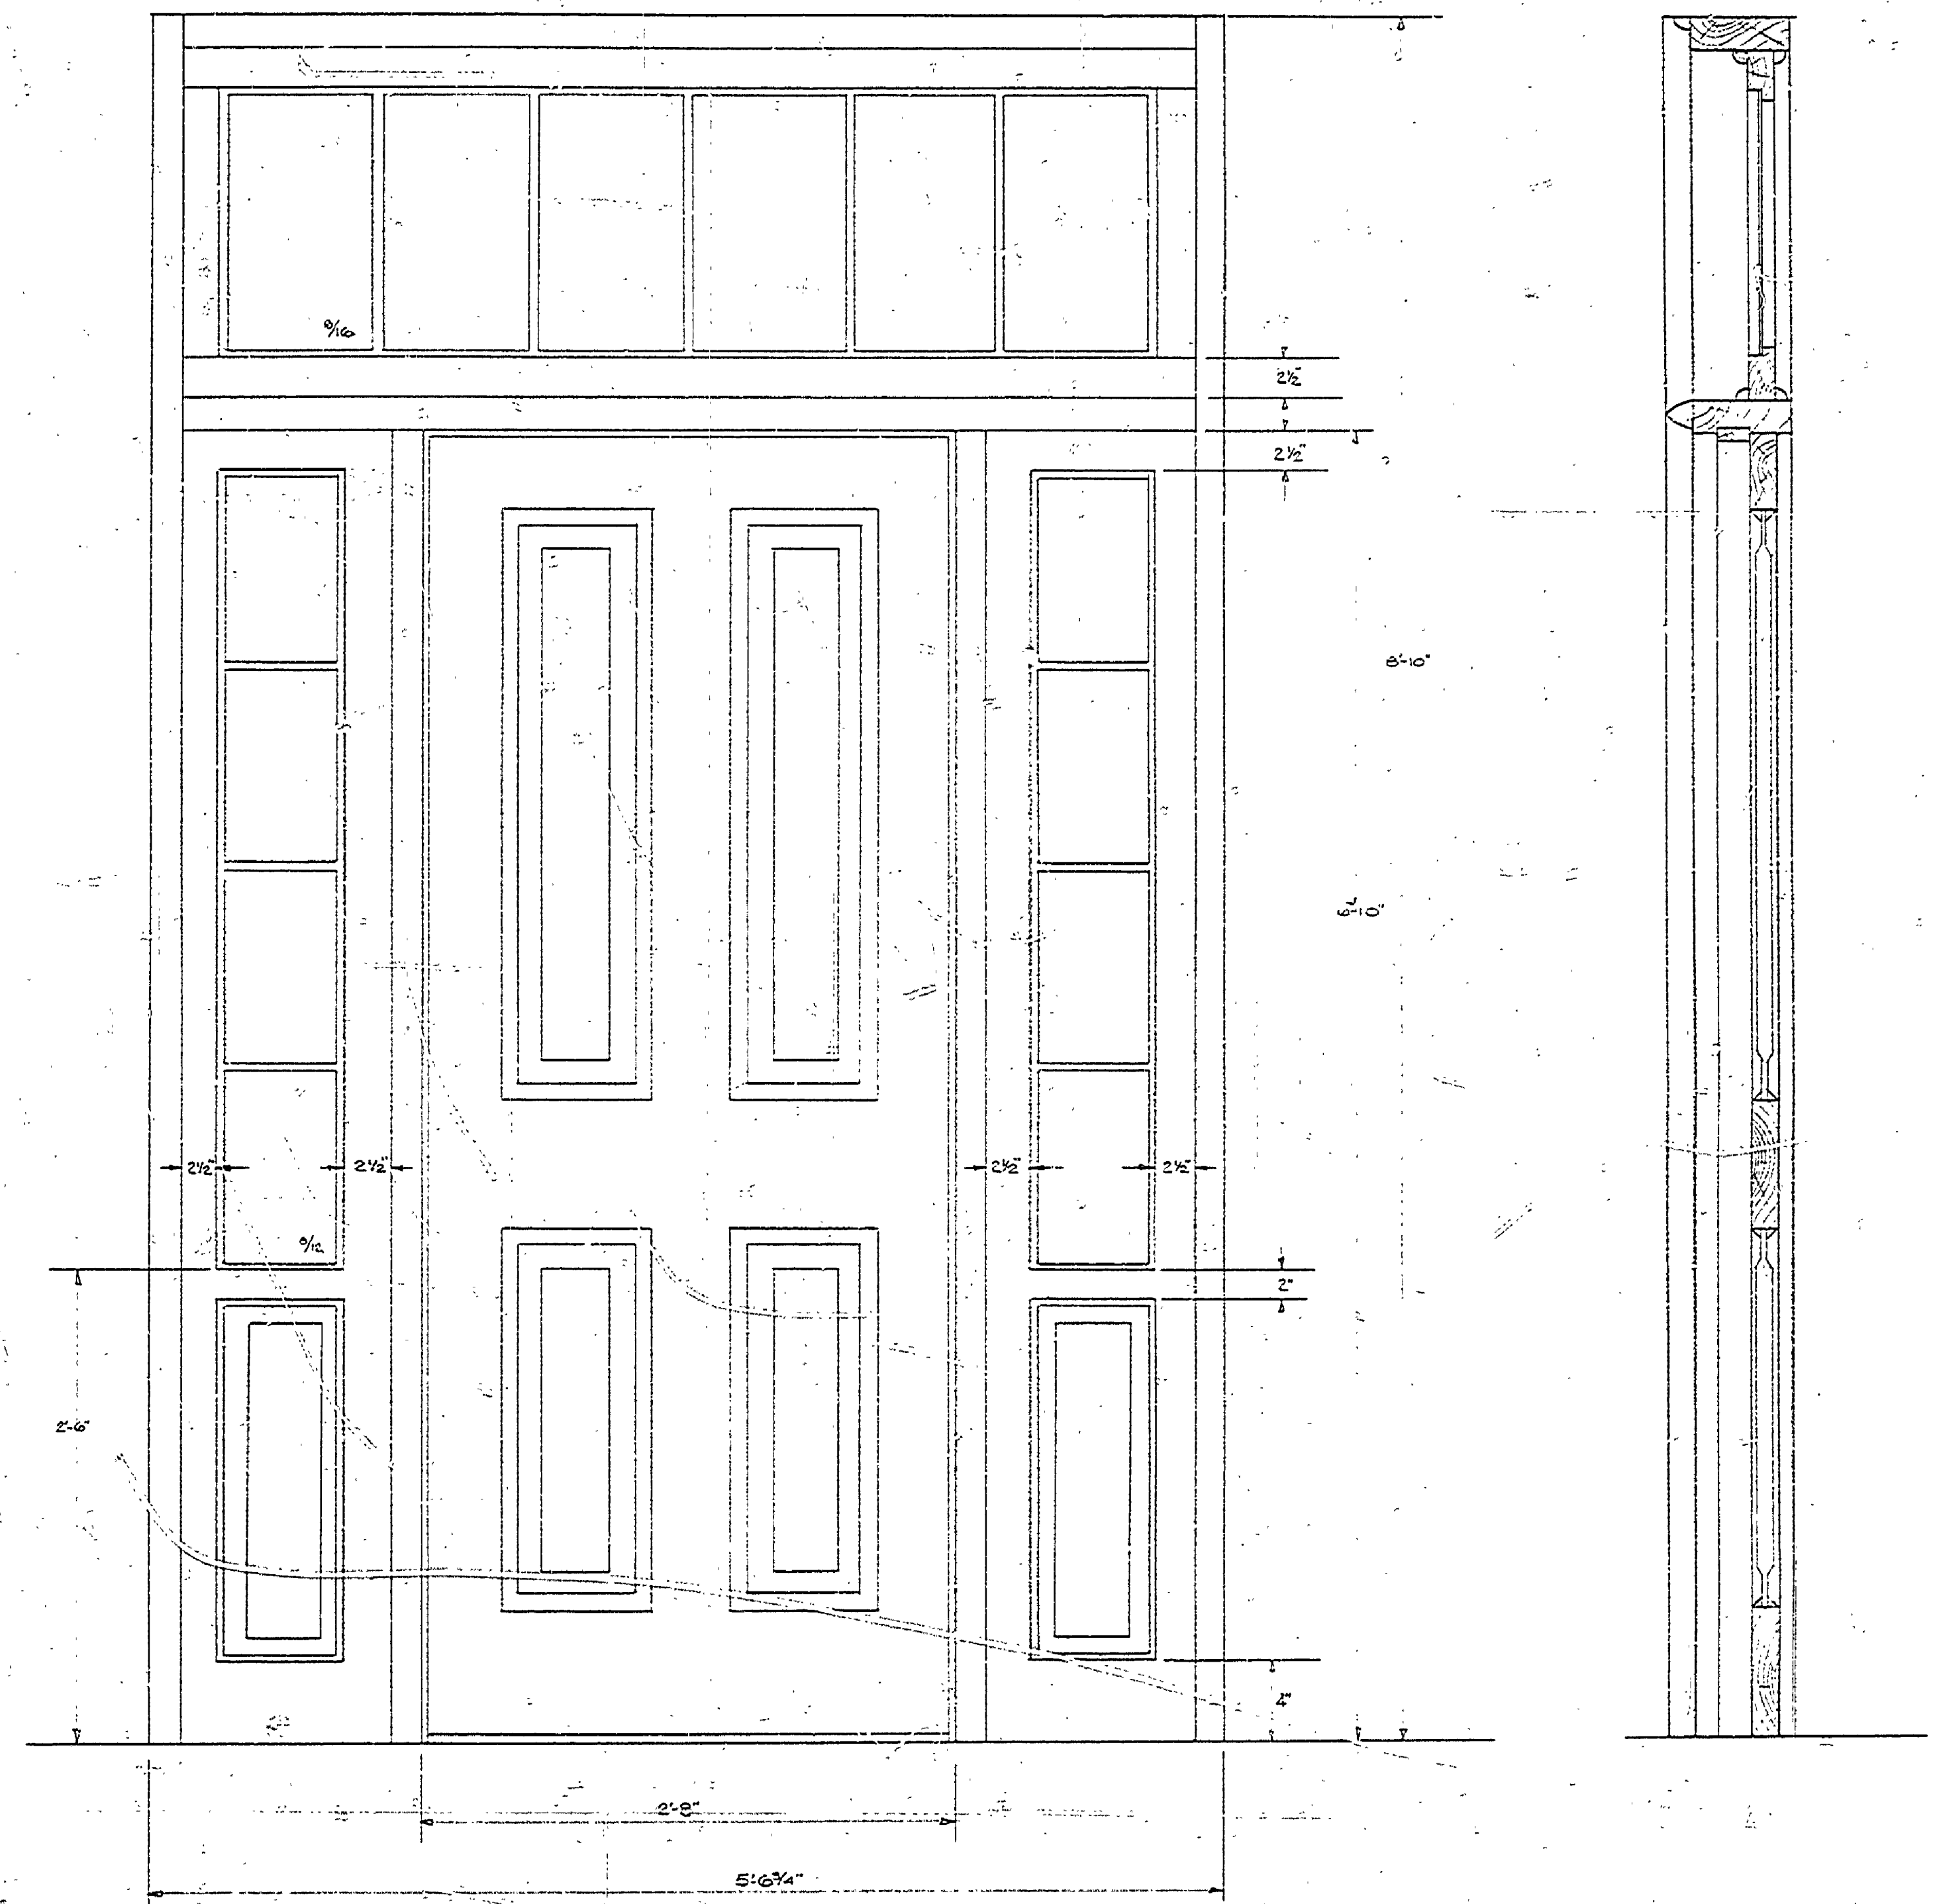

MAIN ENTRANCE DETAIL  
SCALE 1/8"=1'-0"

NOTE:  
NEARLY ALL EXTERIOR TRIM IS MISSING.  
MUST BE REPLACED.

BUILDING #1

MICHIGAN  
DEPARTMENT OF CONSERVATION  
PARKS AND RECREATION DIVISION

MEASURED DRAWING  
FAYETTE HISTORICAL TOWNSITE  
FAYETTE STATE PARK

SHEET  
NO. 2  
OF 5

PLAN NO.  
A-1