




DESIGNED BY	7/10/62	ARCHITECTURAL	DATE	APPROVED	DATE	NO.	DATE	BY	REVISIONS	DATE	BY
DRAWN BY	7/10/62	ENGINEERING				1			4		
CHECKED BY		LANDSCAPE				2			5		
						3			6		

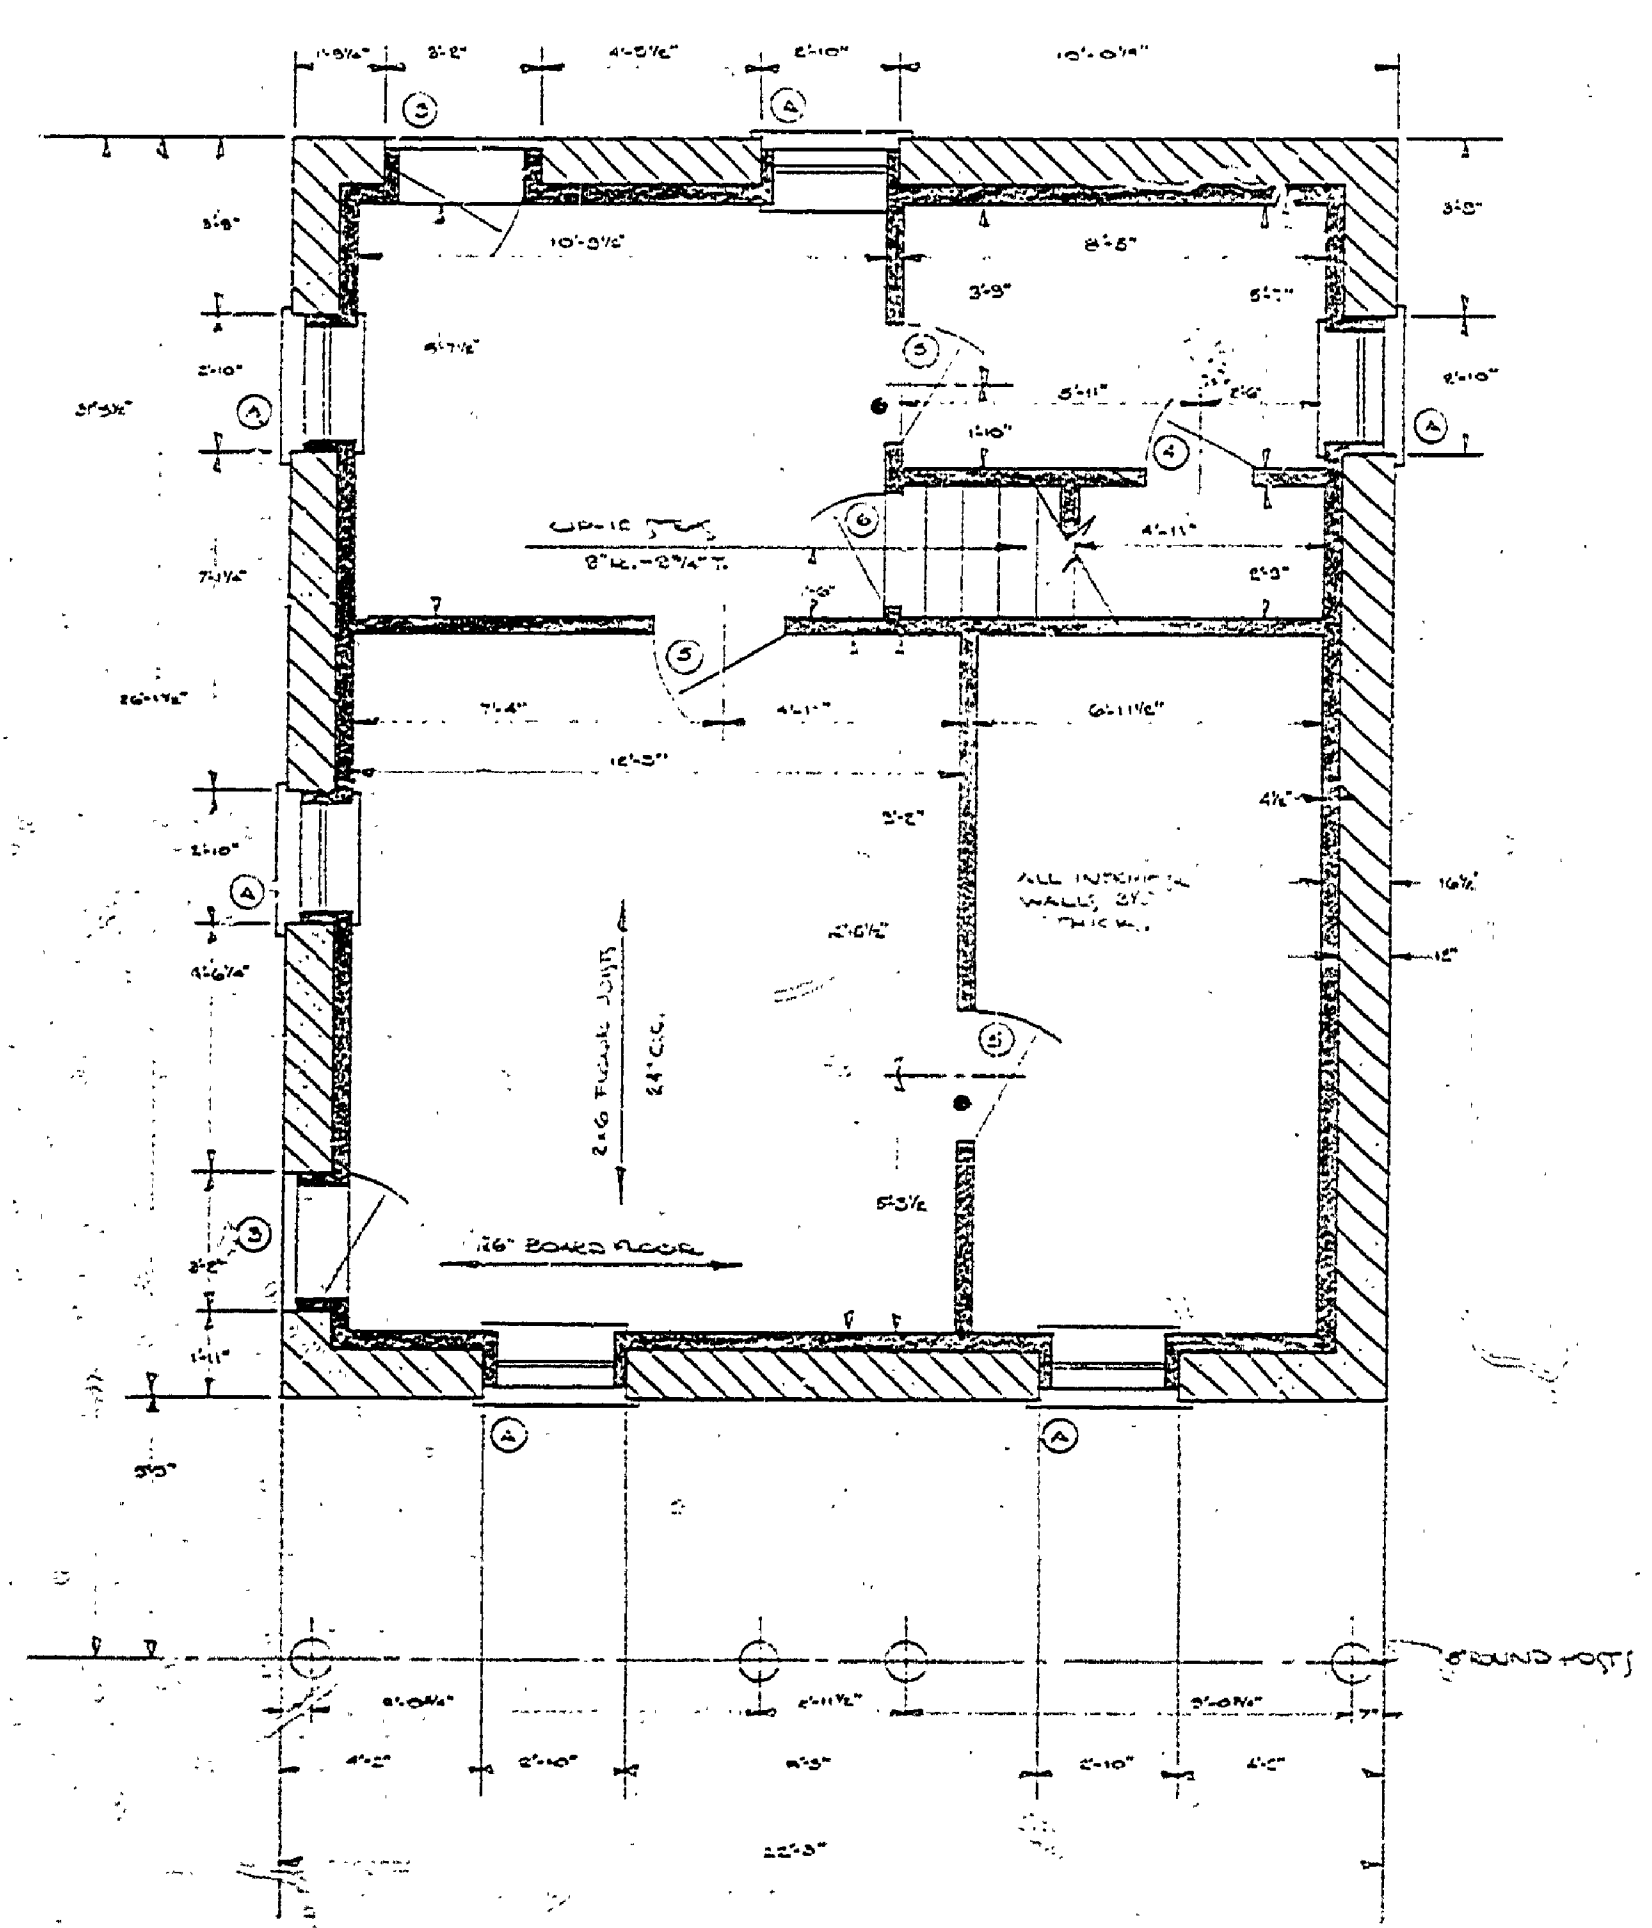

FIRST FLOOR PLAN

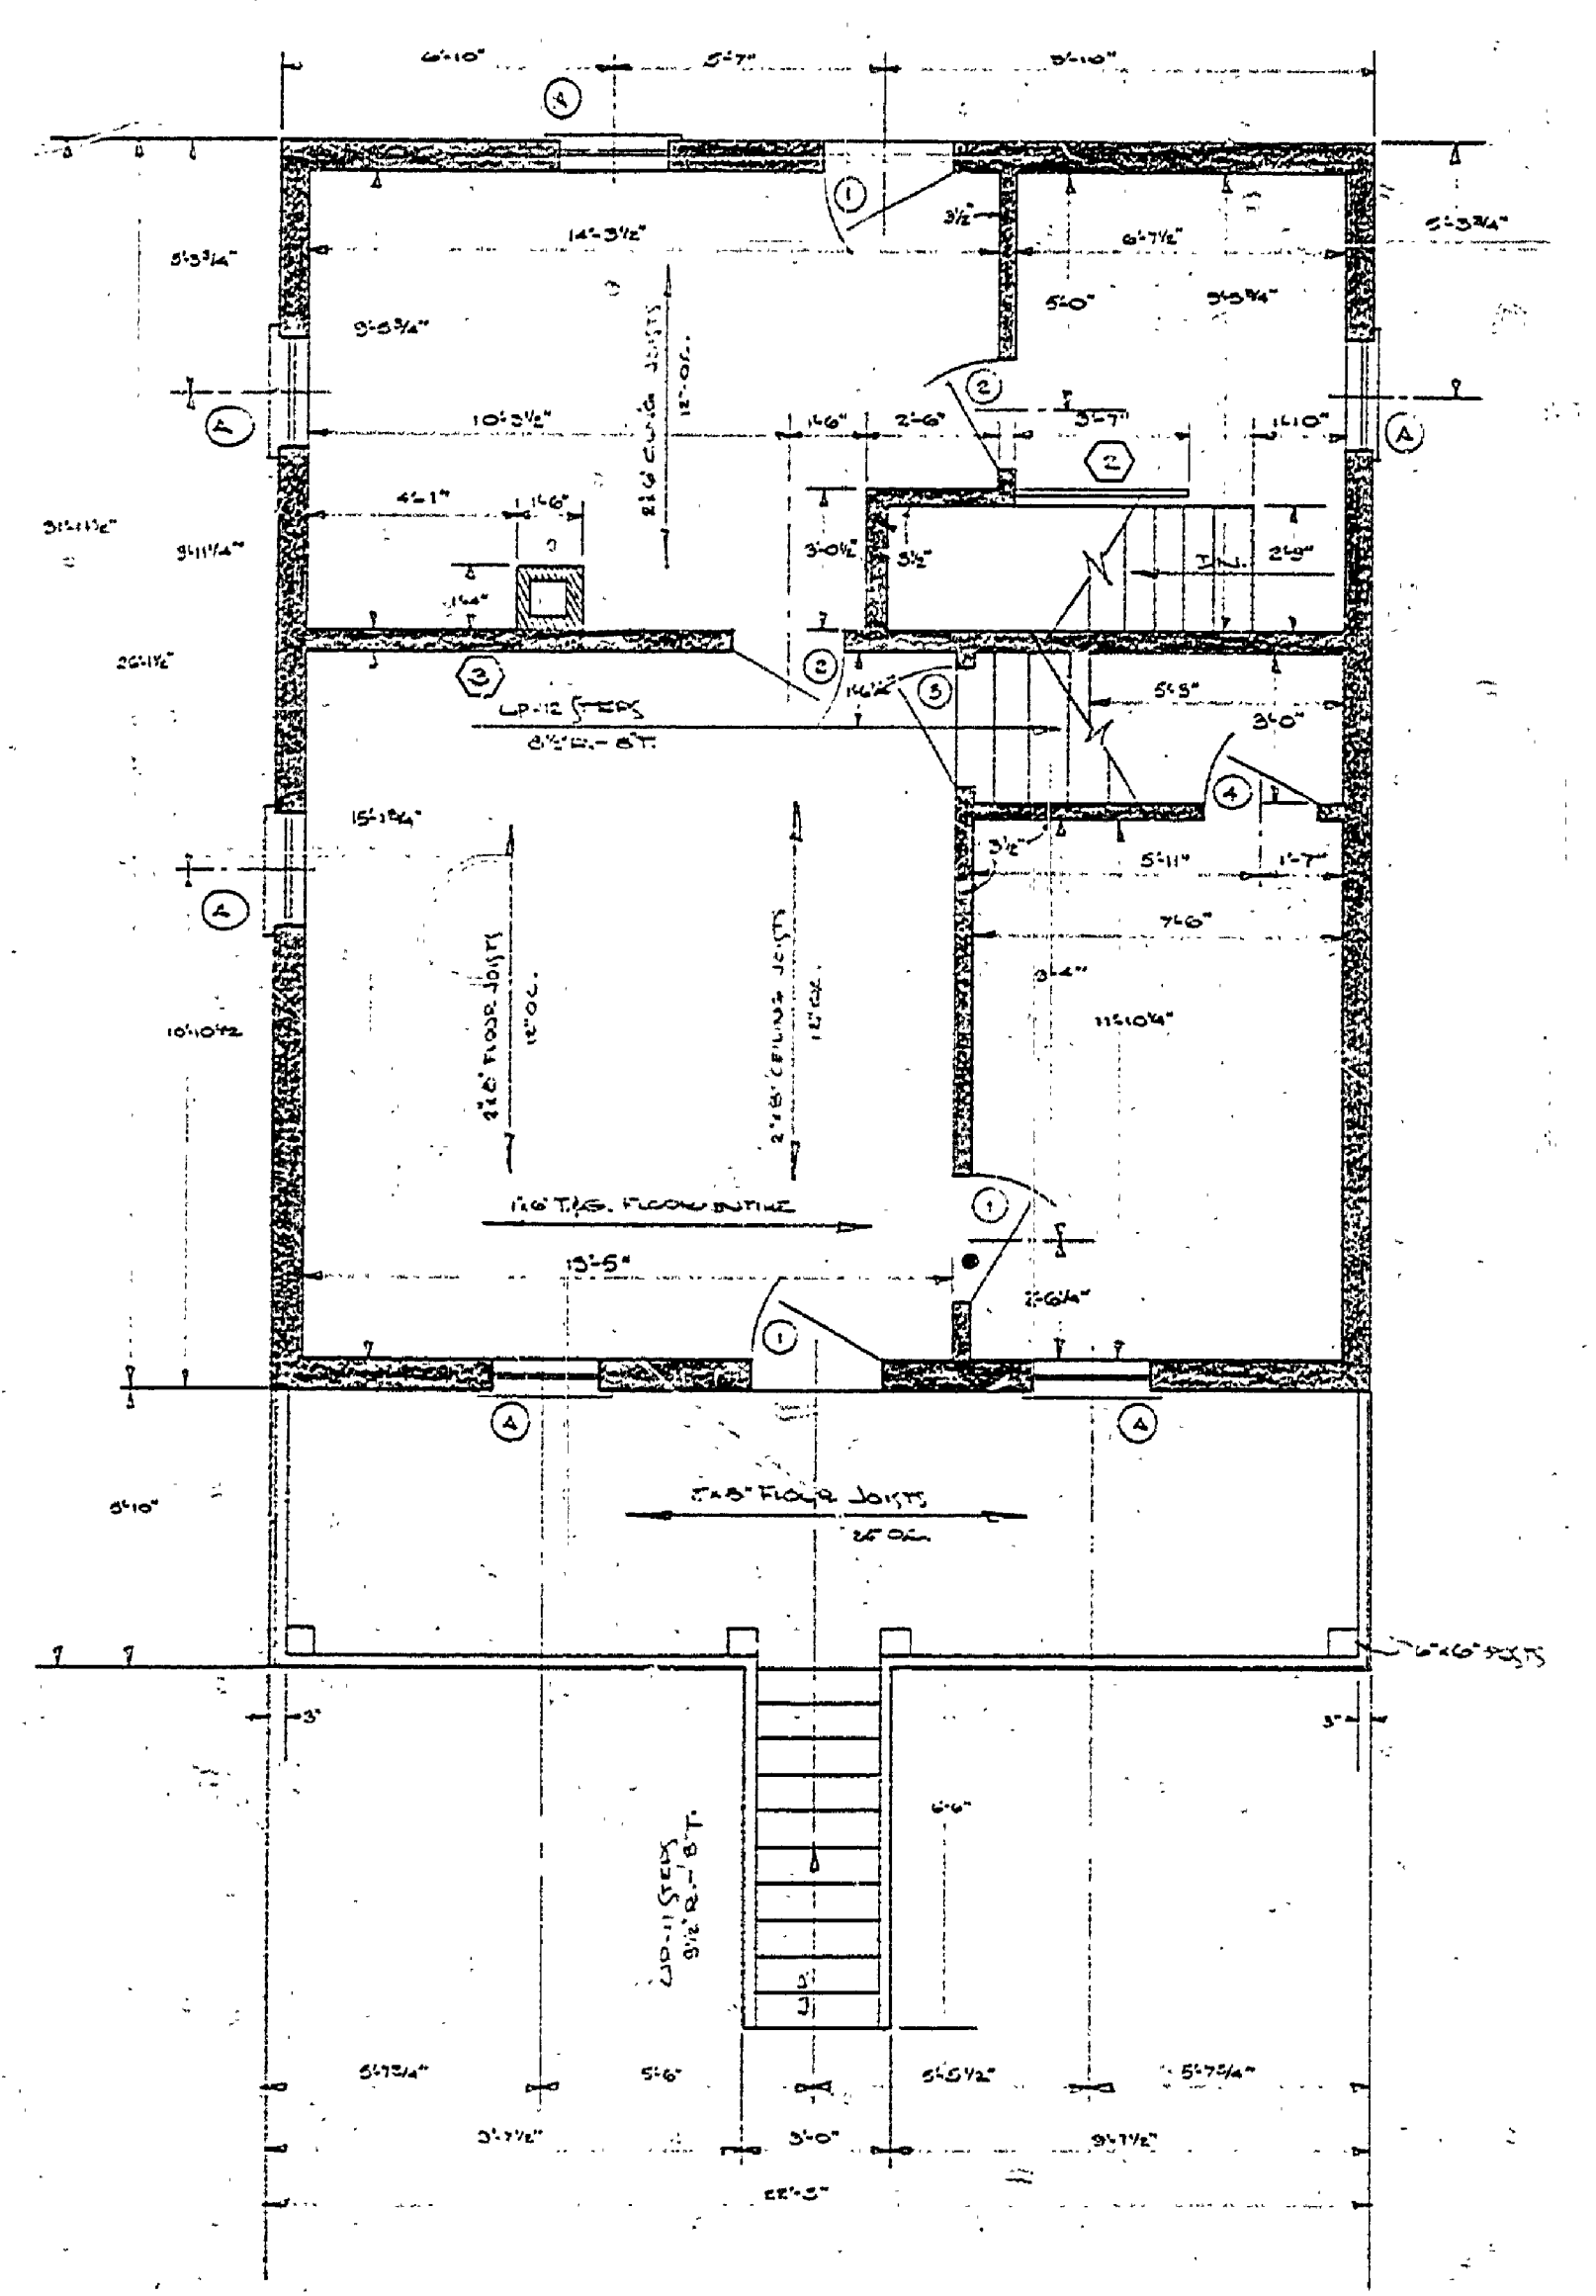


SECOND FLOOR PLAN

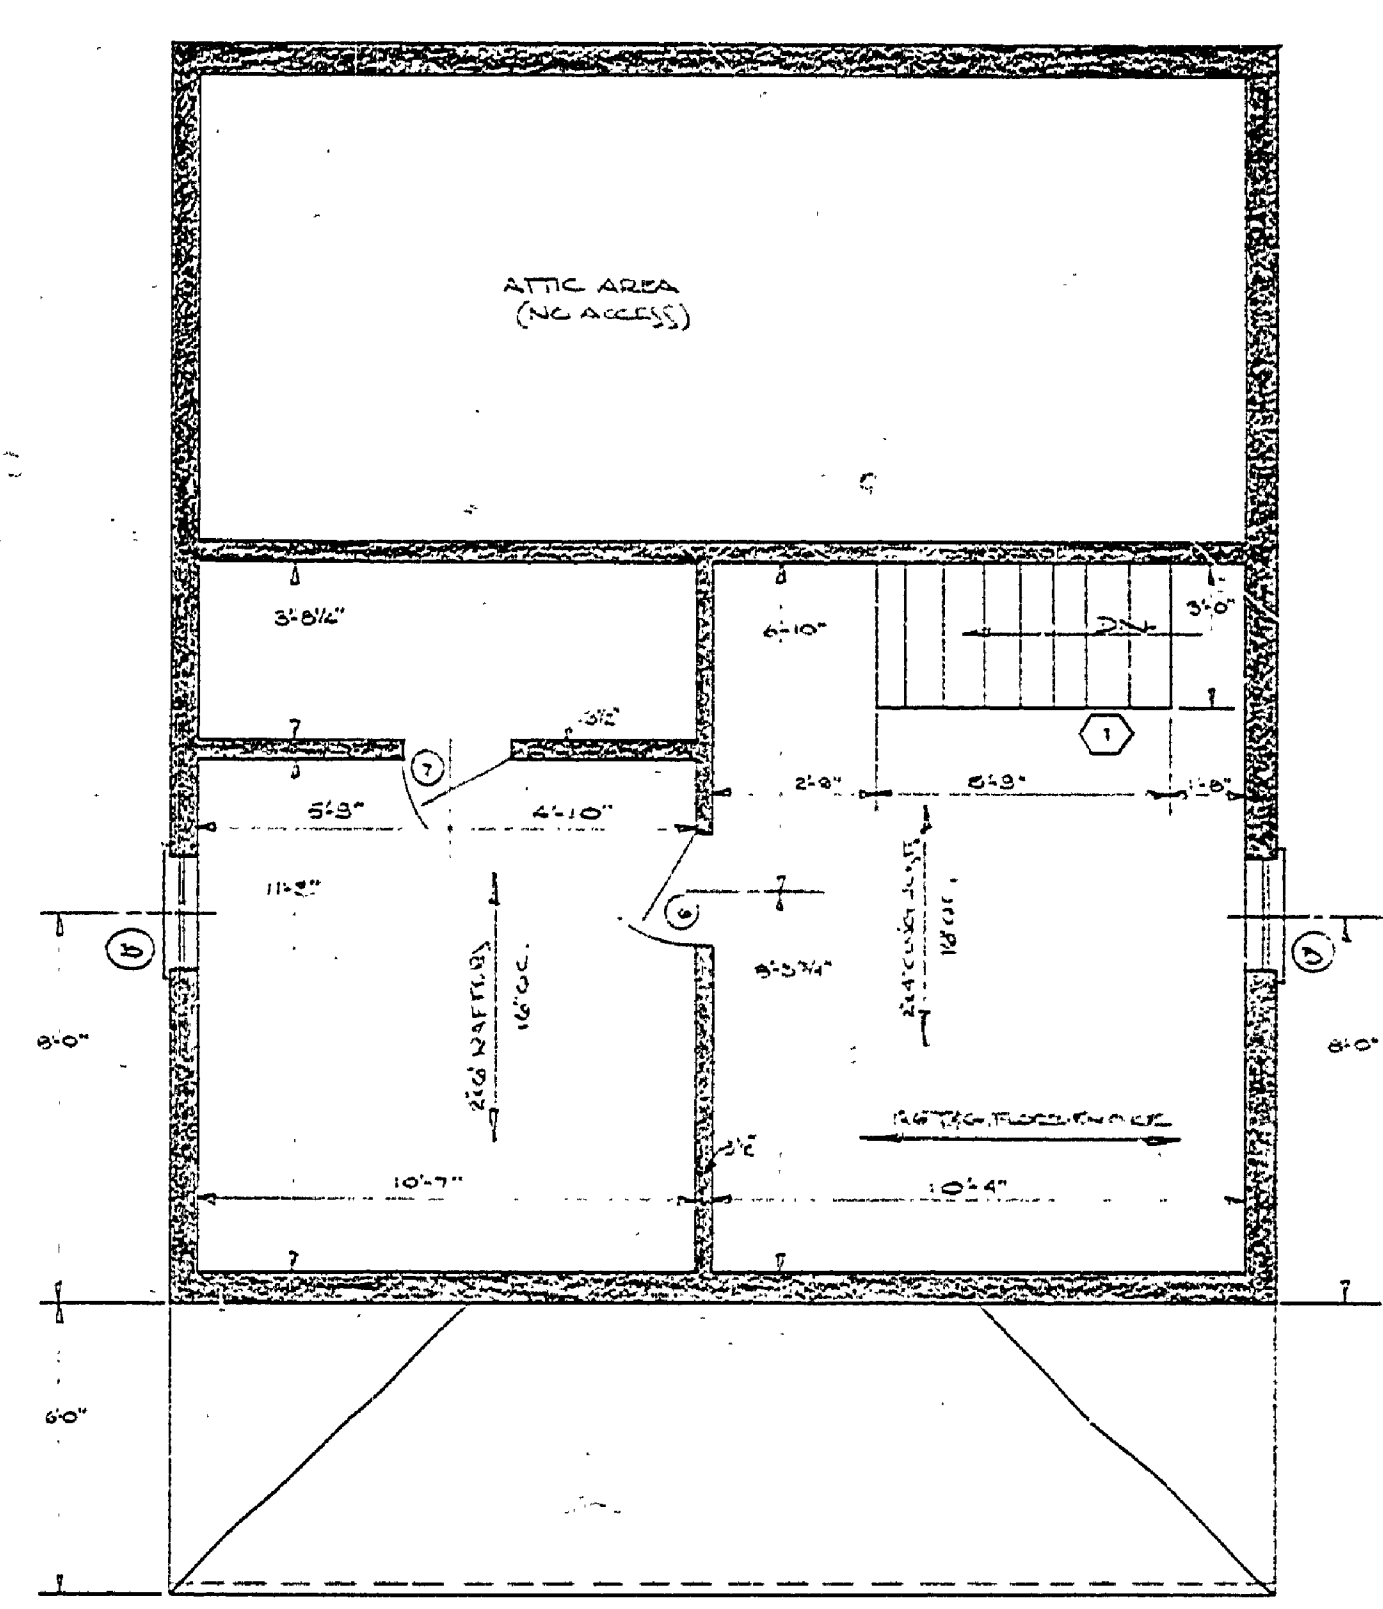

THIRD FLOOR PLAN

NOTE:  
 ALL FLOORS INDICATED WITH SMALL "DOT" ARE MISSING.  
 FLOORING THROUGHOUT HOUSE IS IN POOR CONDITION.  
 FRONT STEPS TO PORCH ARE IN EXTREMELY DANGEROUS CONDITION.  
 FRONT PORCH AS SHOWN WAS NOT AN ORIGINAL HOME.  
 REAR PORCH IS MISSING.  
 SAFETY RAIL AROUND TOWER WELL IS MISSING.  
 SASHES IS NOT ORIGINAL.  
 PLASTER IN THIS AREA IS MISSING AND HAS BEEN REPLACED WITH FIBERBOARD. IT IS NOW IN POOR CONDITION.

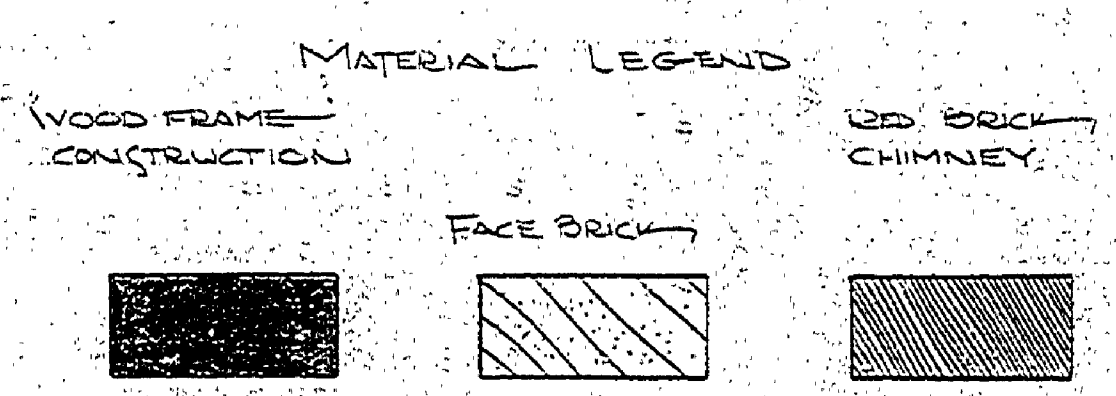

DOOR SCHEDULE

NO.	REQ'D	SIZE	GLASS	TRANS.	HARDWARE	REMARKS
1	3	2'8" x 6'8"	NONE	NONE	STANDARD	4 PANEL
2	2	2'4" x 6'5"	"	"	"	"
3	3	2'6" x 6'5"	"	"	"	"
4	2	2'2" x 6'4"	"	"	"	"
5	3	2'0" x 6'6"	"	"	"	"
6	2	2'4" x 6'6"	"	"	"	"
7	1	2'2" x 8'0"	"	"	"	"

WINDOW SCHEDULE

NO.	REQ'D	TYPE	SIZE	SASH	GLASS	REMARKS
A	12	DL	2'4" x 4'8"	2'4" x 2'4" 5/8"	6'5" x 12"	SPRING BOLT
B	2	"	2'4" x 8'8"	2'4" x 1'10" 5/8"	6'5" x 10"	"