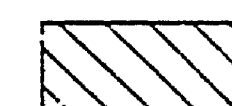
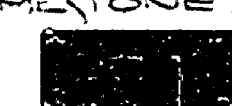


DESIGNED BY	DRAWN BY	CHECKED BY	DATE	REVIEWED	DATE	APPROVED	DATE	NO.	DATE	REVISIONS
								1		4
								2		5
								3		6

ORIGINAL WORKSHEET AND MOUNTED
 FROM MICHIGAN DEPARTMENT OF CONSERVATION
 EXISTING AT GRADE LEVEL.
 VERIFY ONE PART ONLY MOUNTING


MATERIAL LEGEND
 LIMESTONE RUBBLE
 WOOD FRAME

WINDOW SCHEDULE


WIN. NO.	TYPE	SIZE	GLASS	GLASS	REMARKS
A	DLG	24" x 36"	24" x 36"	6" x 10"	SPRING BOLT
B	"	24" x 40"	24" x 40"	12" x 14"	"

DOOR SCHEDULE


WIN. NO.	TRANS.	SIZE	GLASS	HARDWARE	REMARKS
1	"	24" x 60"	NONE	SPB	PANEL
2	"	24" x 60"	"	"	"

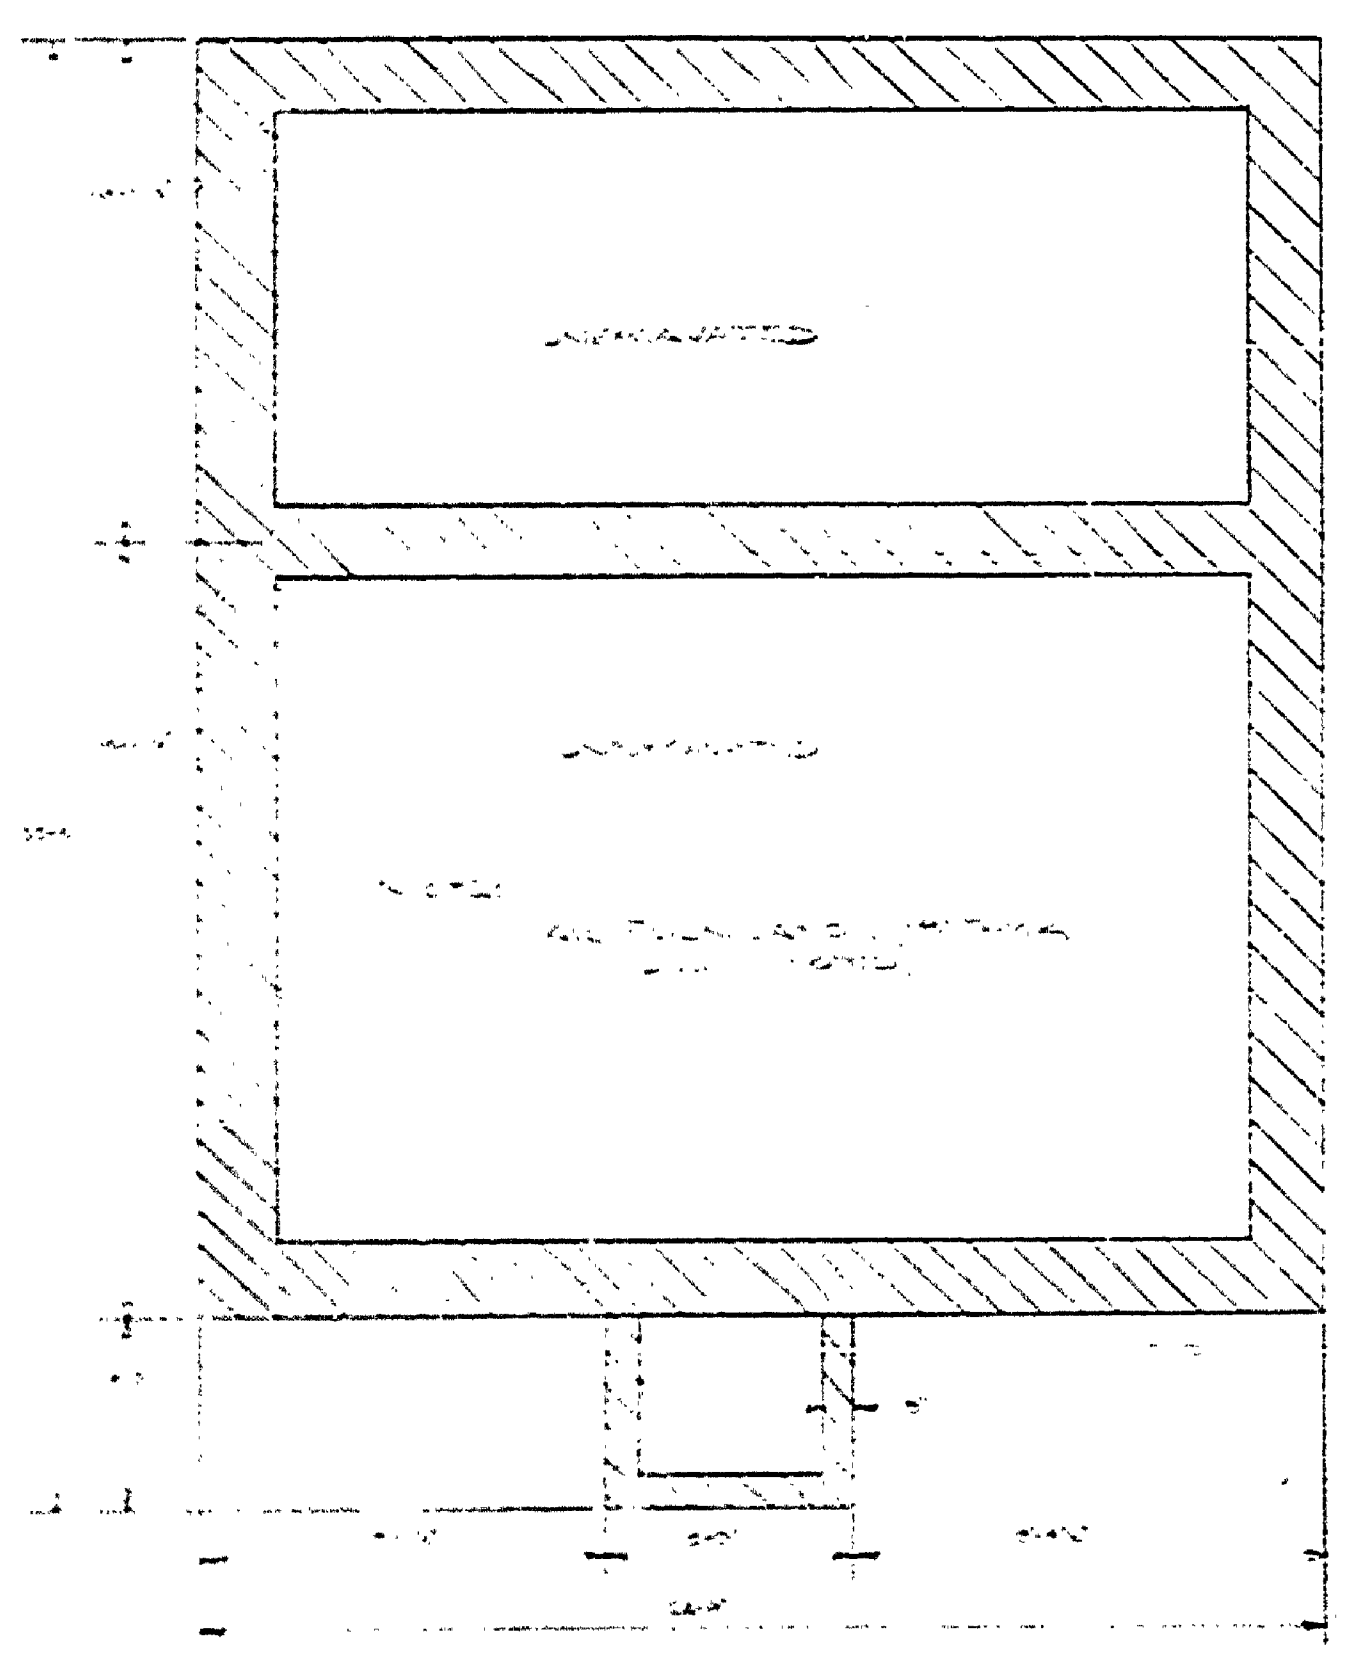

FOUNDATION PLAN

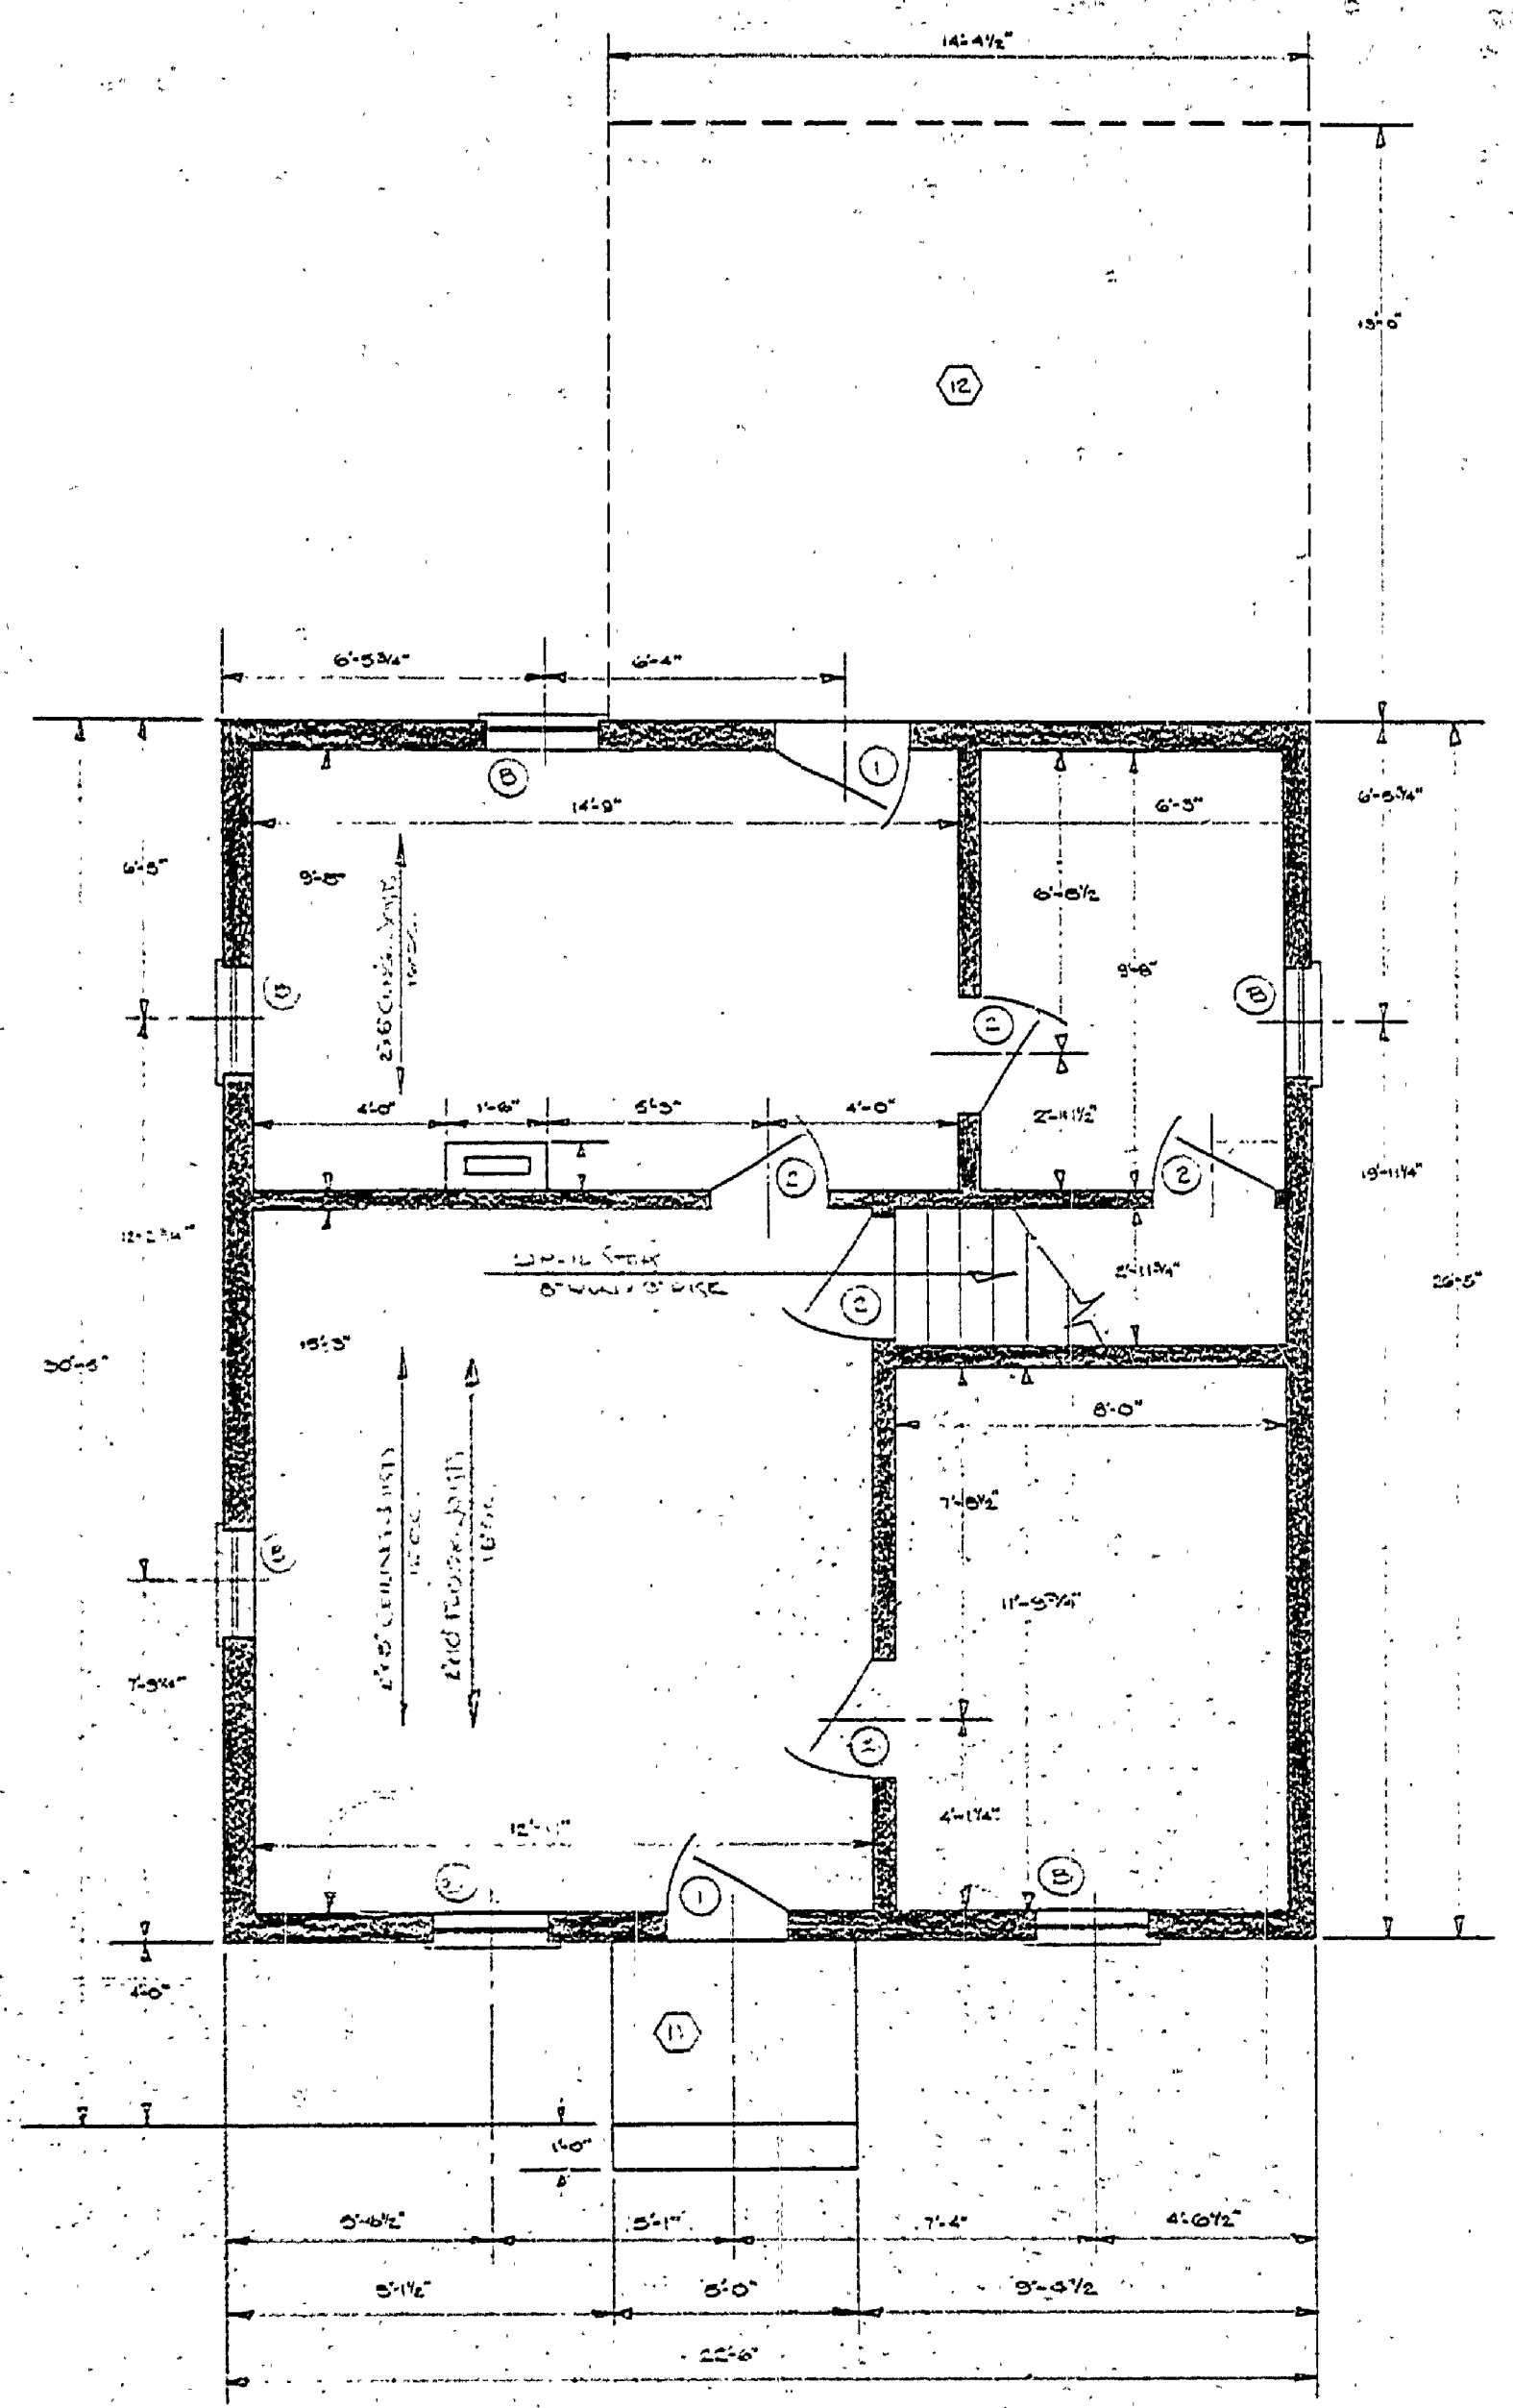


FIRST FLOOR PLAN

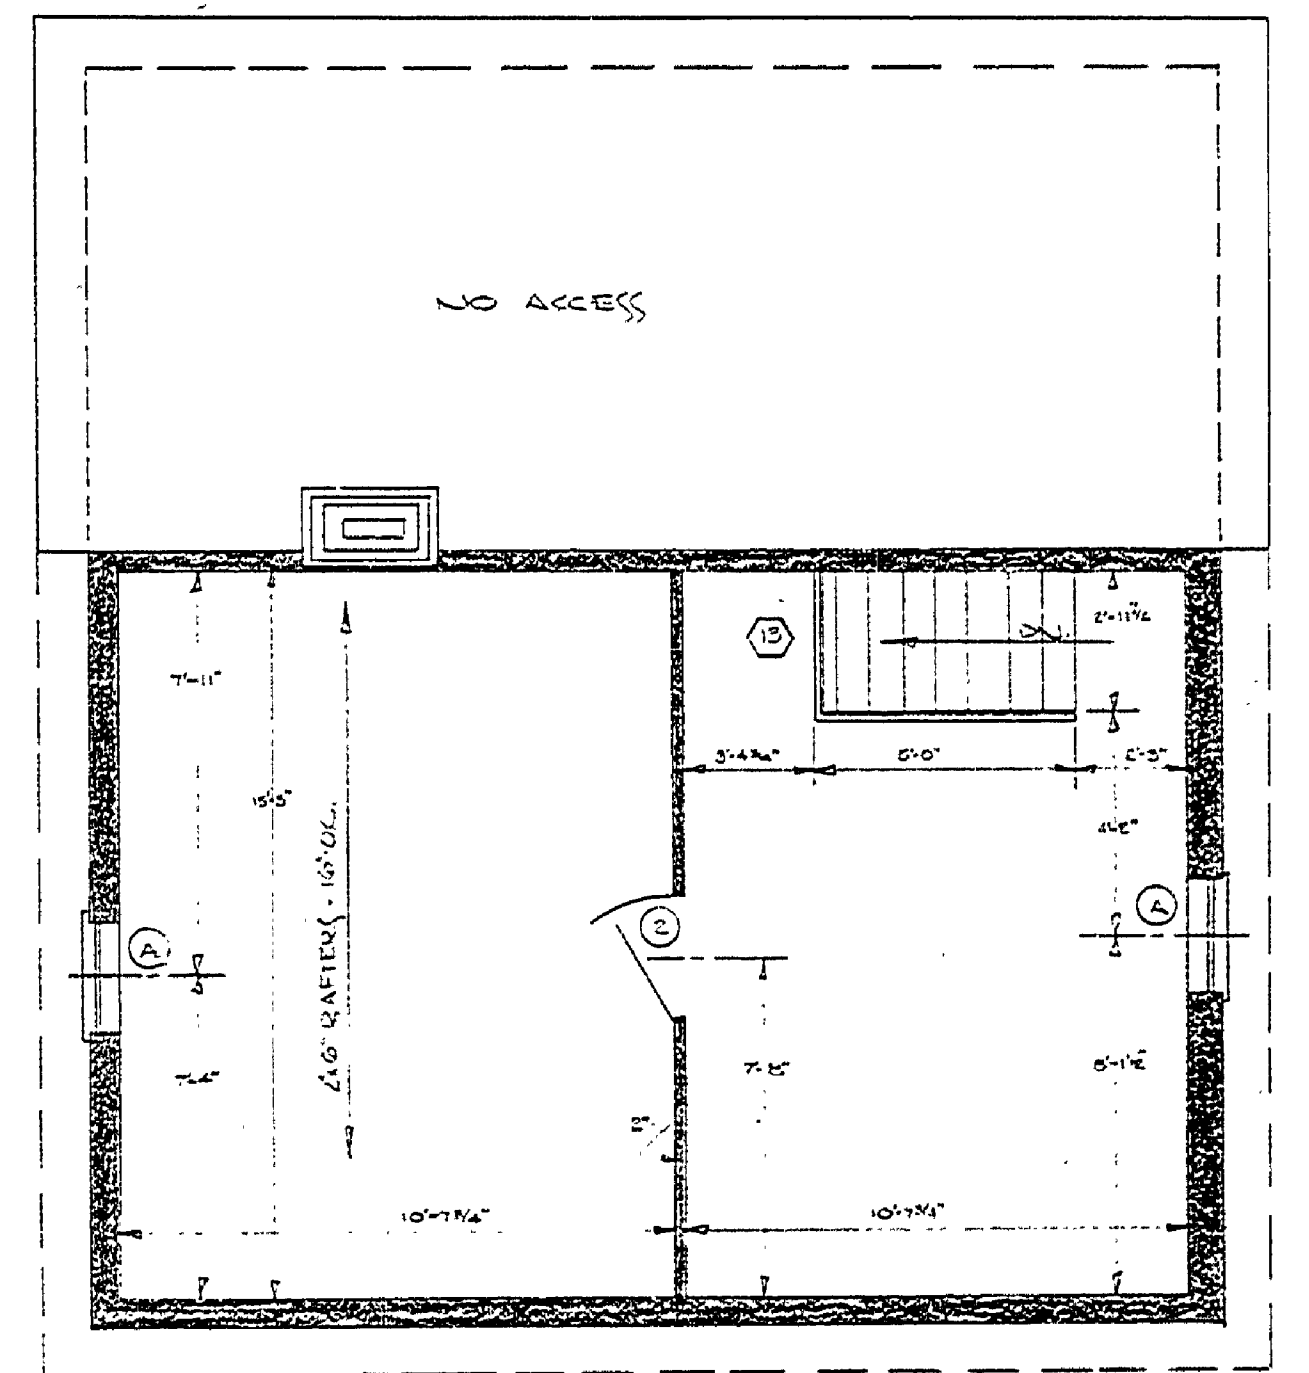


SECOND FLOOR PLAN


SCALE 1/4" = 1'-0"

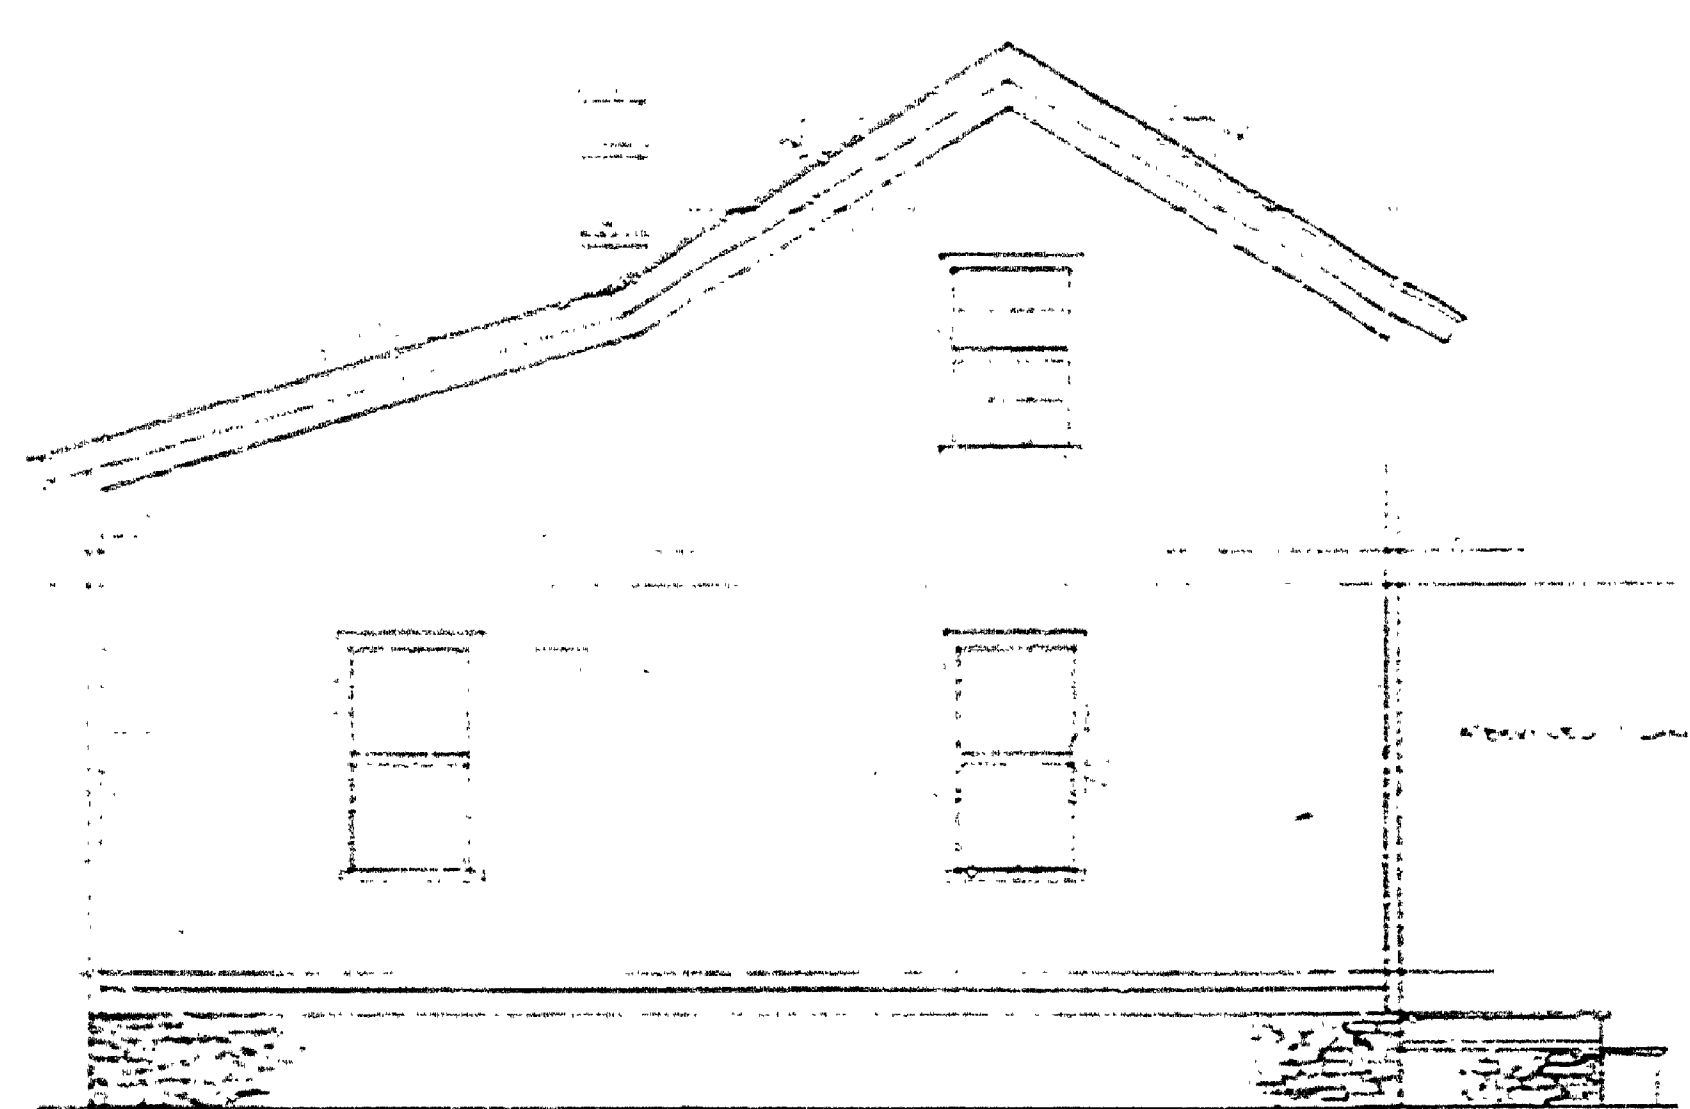


EAST ELEVATION

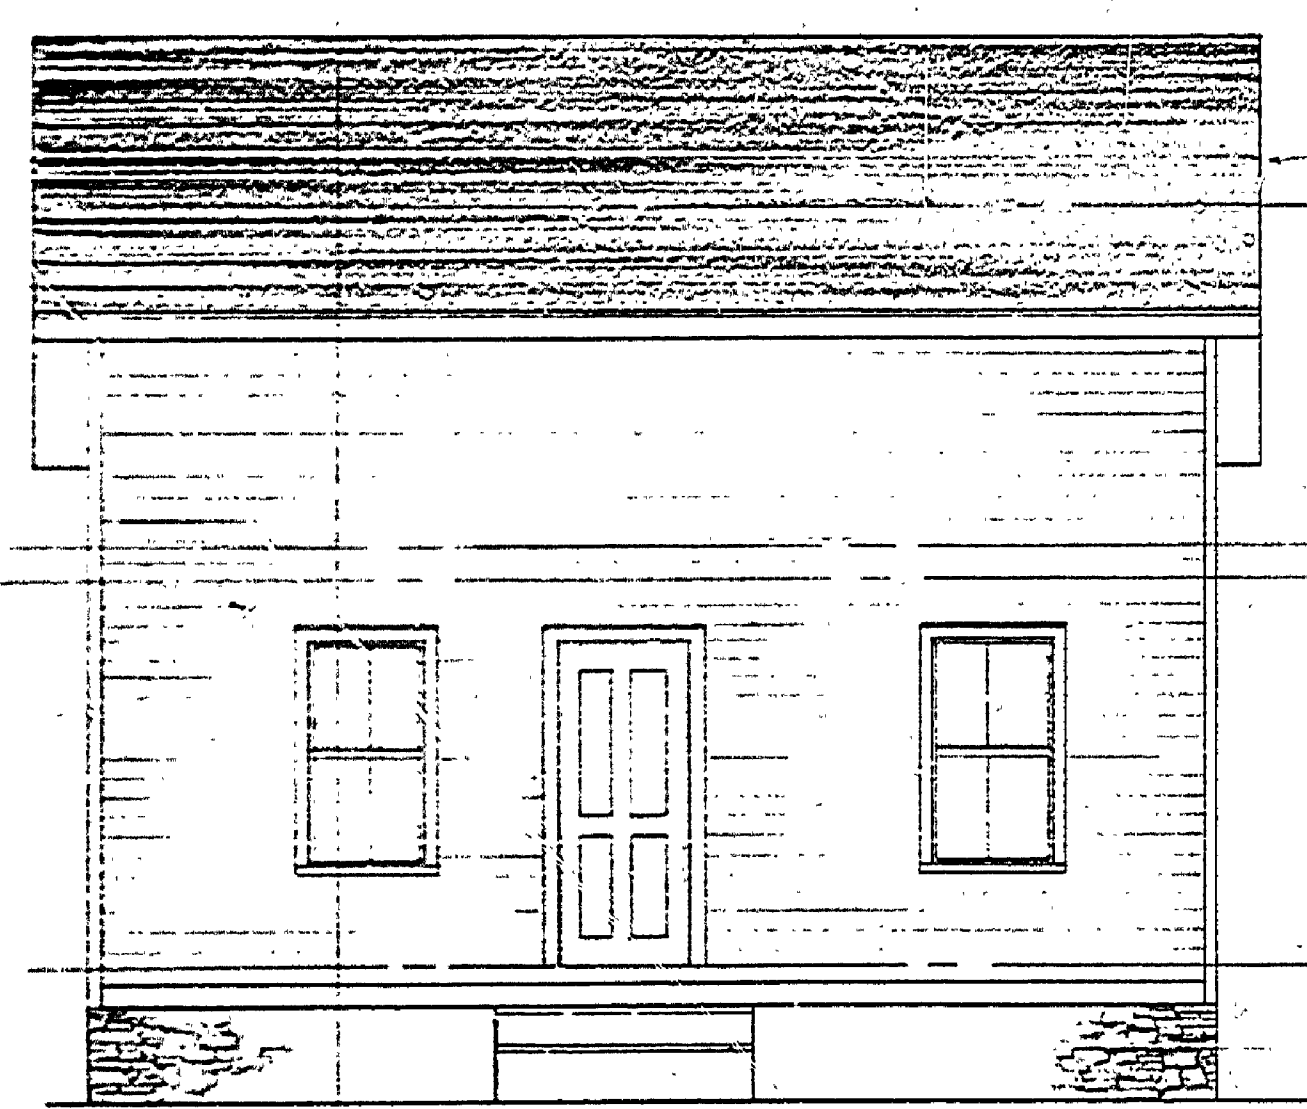

NORTH ELEVATION

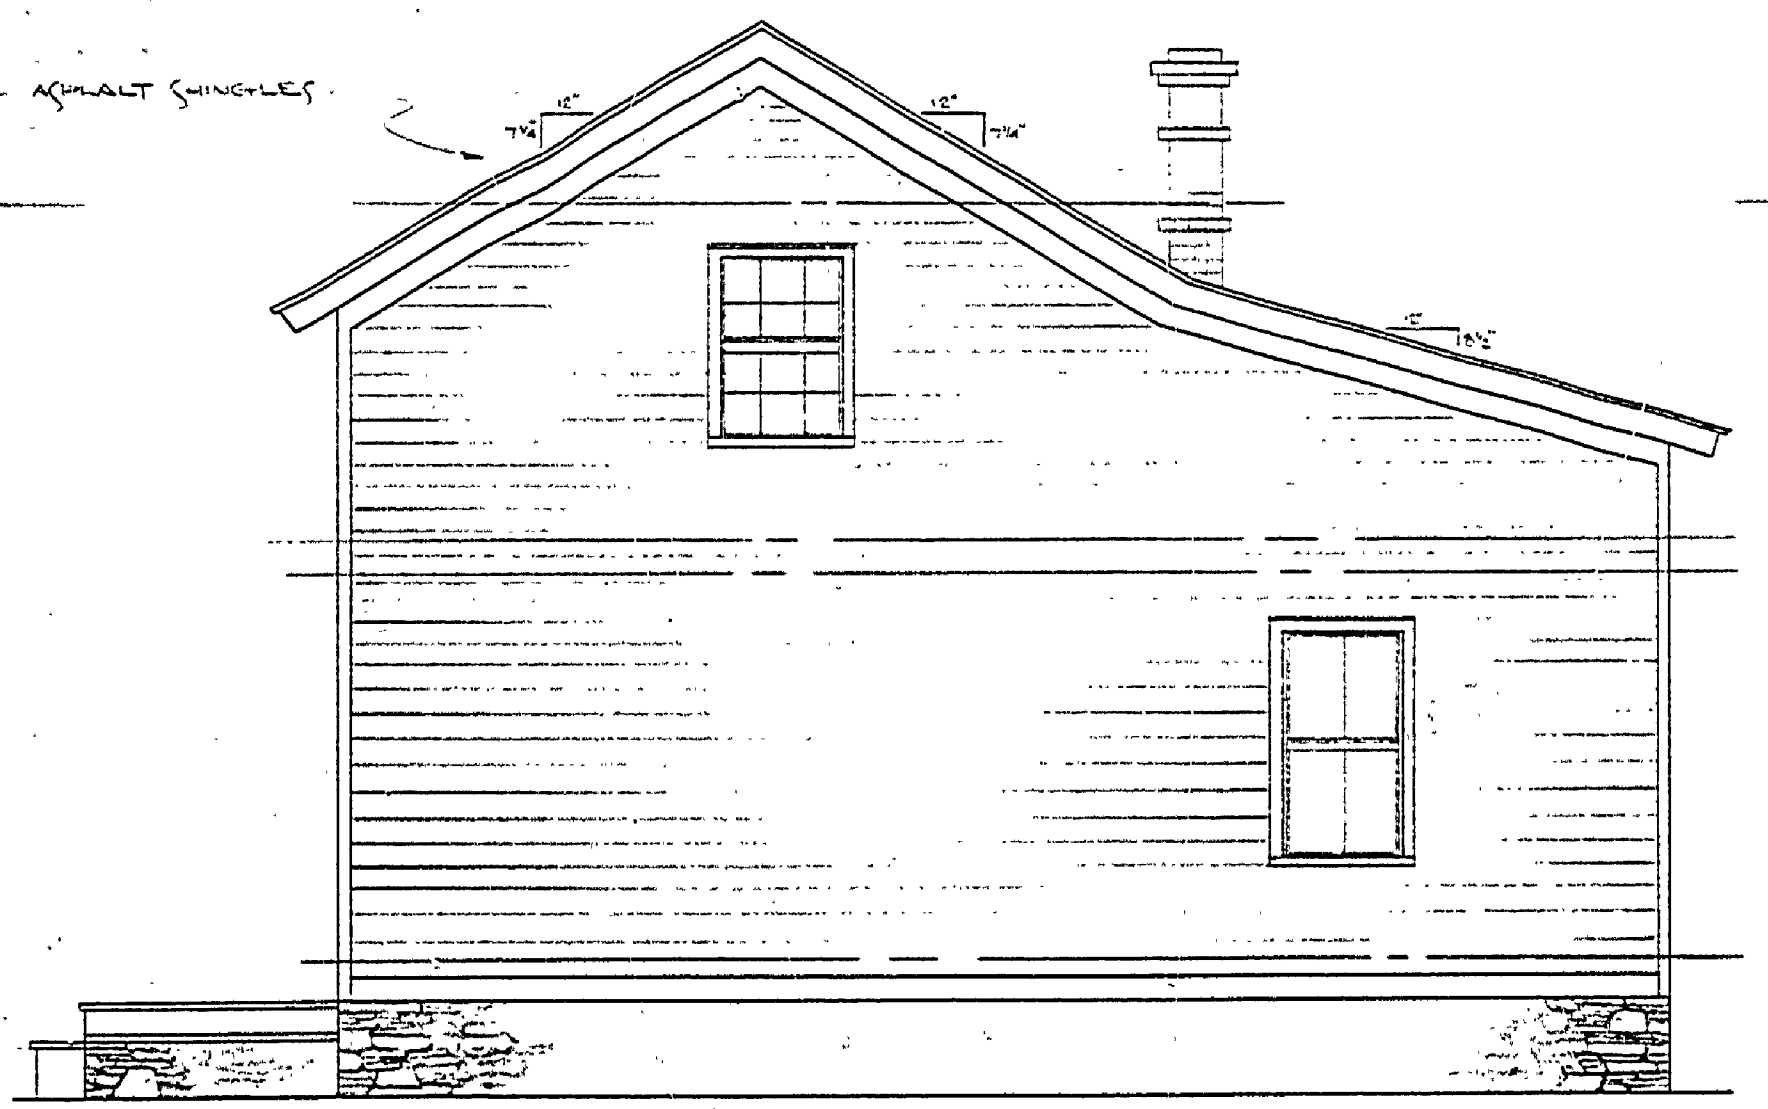

WEST ELEVATION

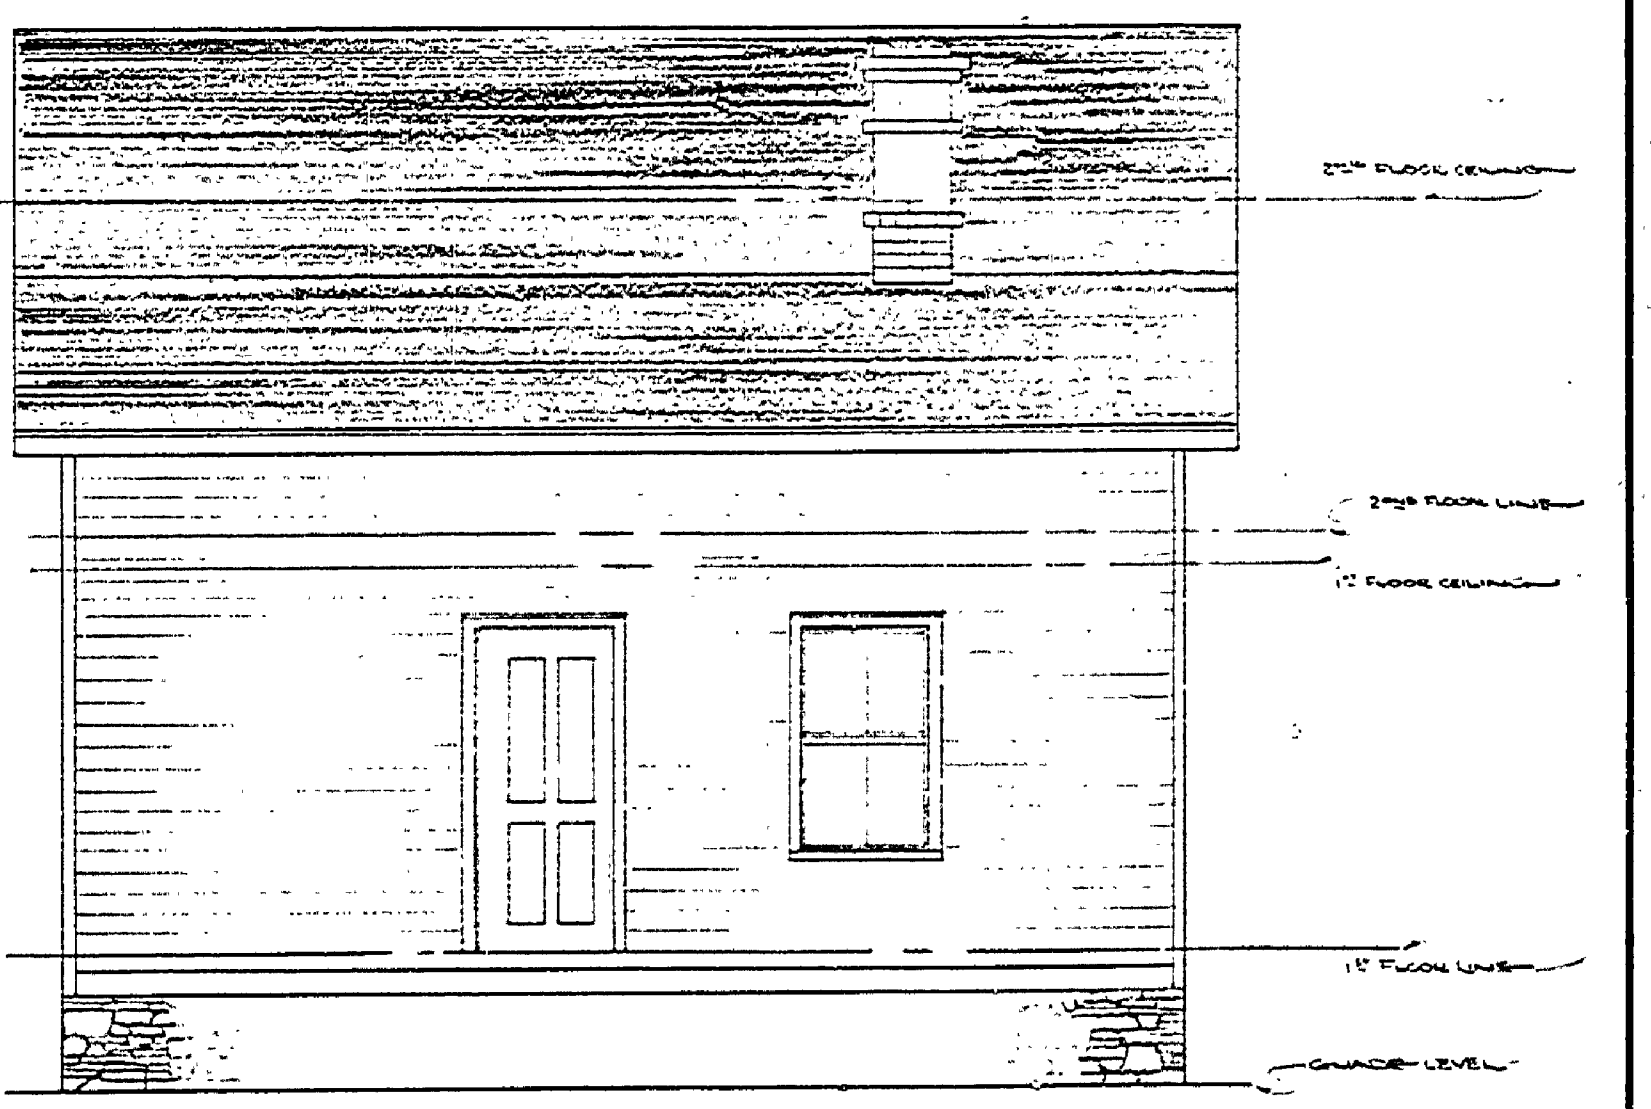

SOUTH ELEVATION

BUILDING #7

MICHIGAN
 DEPARTMENT OF CONSERVATION
 PARKS AND RECREATION DIVISION

MEASURED DRAWING
 FAYETTE HISTORICAL TOWNSHIP
 FAYETTE GATE PARK

SHEET
 NO. 1
 OF 2

PLAN NO.
 A-7