


DATE	REVIEWED	DATE	APPROVED	DATE	NO.	DATE	BY	REVISIONS	DATE	BY
					1			4		
					2			5		
					3			6		


MA.	REQD	SIZE	TYPE	GLASS	TRANS.	HARDWRE	REMARKS
A	2	2'-0" x 6'-0"	PANEL	NONE	NONE	STD	
B	1	2'-0" x 6'-0"	"	"	"	"	MISSING
C	1	2'-2" x 6'-0"	"	"	"	"	
D	1	2'-0" x 6'-0"	"	"	"	"	

MA.	REQD	SIZE	SASH	GLASS	TYPE	REMARKS
1	1	2'-0" x 10'-0"		6/8" x 10"	FIXED	
2	3	2'-7 1/2" x 4'-10"	2'-7 1/2" x 2'-5 1/2"	6/8" x 12"	DM.	
3	1	1'-8" x 2'-0"		6/8" x 12"	G.O.	
4	2	2'-4 1/2" x 5'-0 1/2"	2'-4" x 1'-10 1/2"	6/8" x 10"	G.L.	


ALL DOORS NOTED WITH "DOT" ARE MISSING

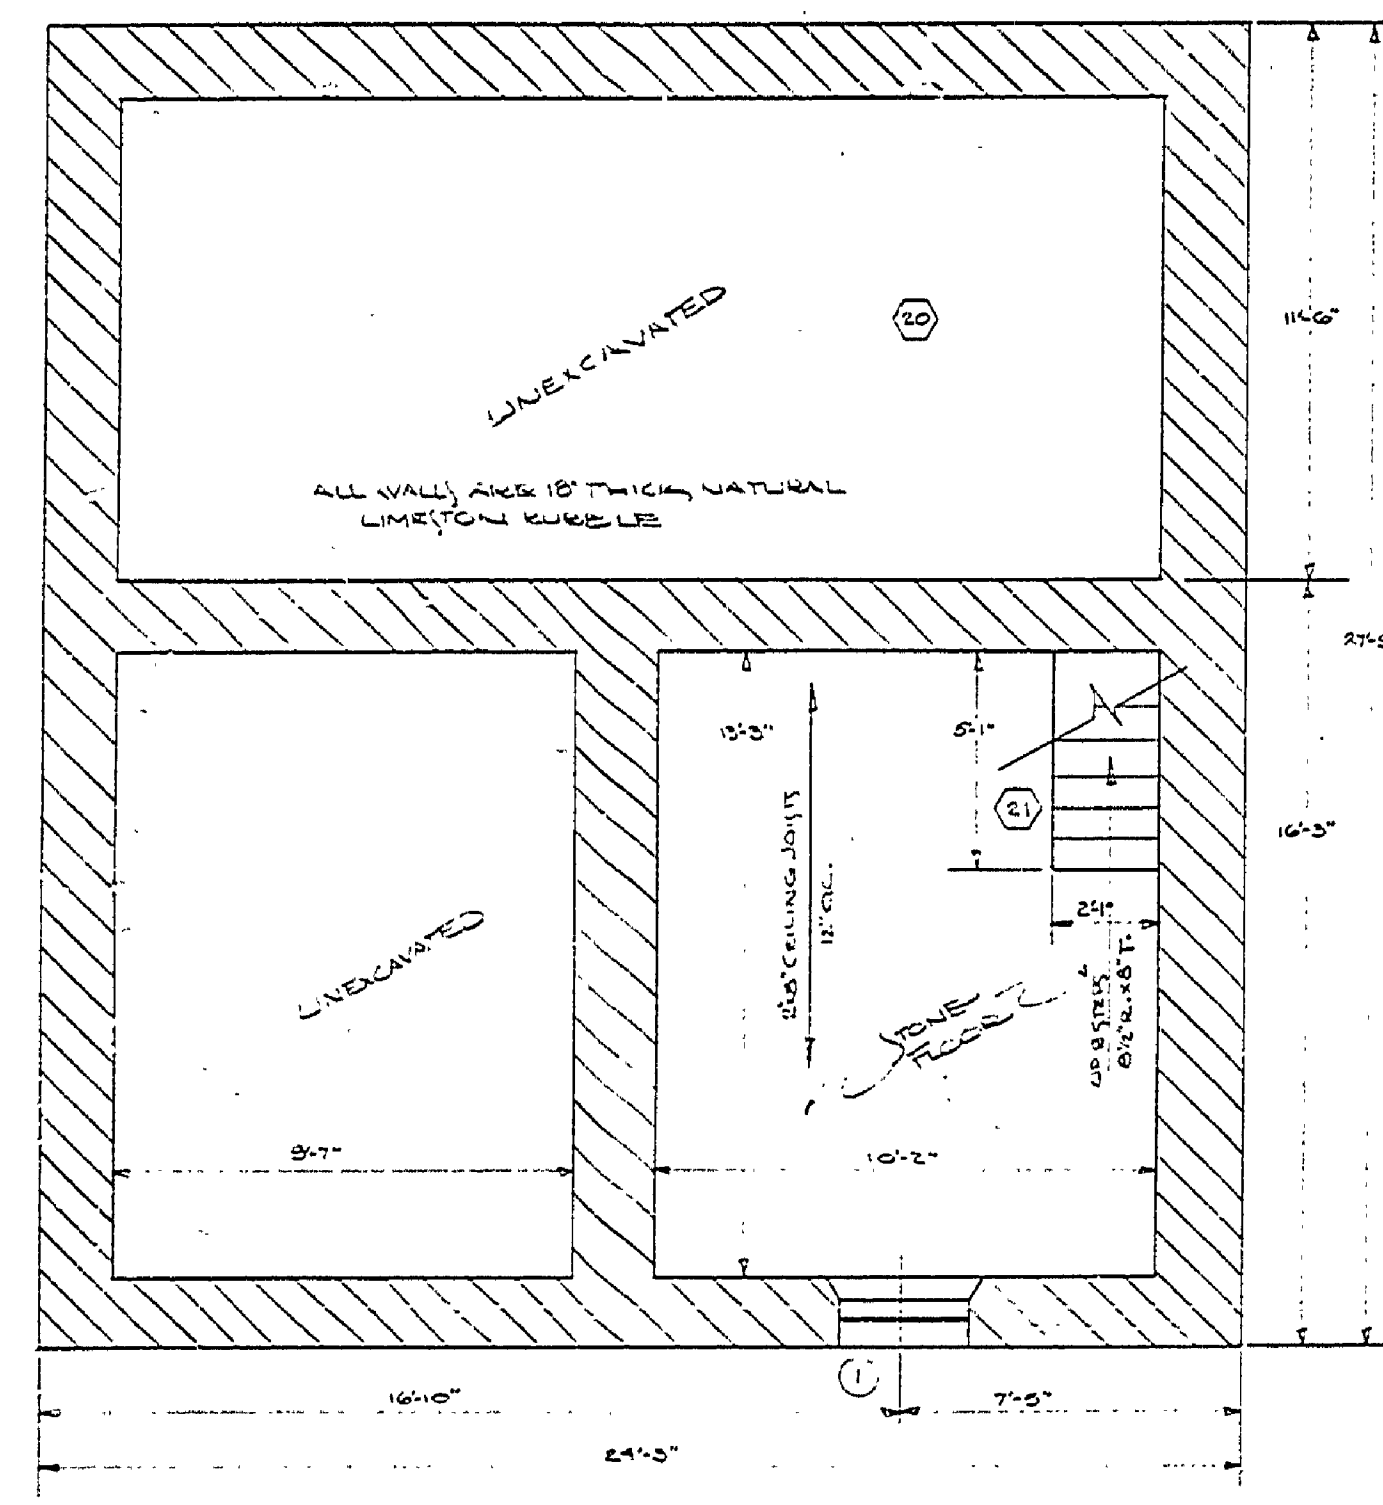

FOUNDATION & BASEMENT PLAN

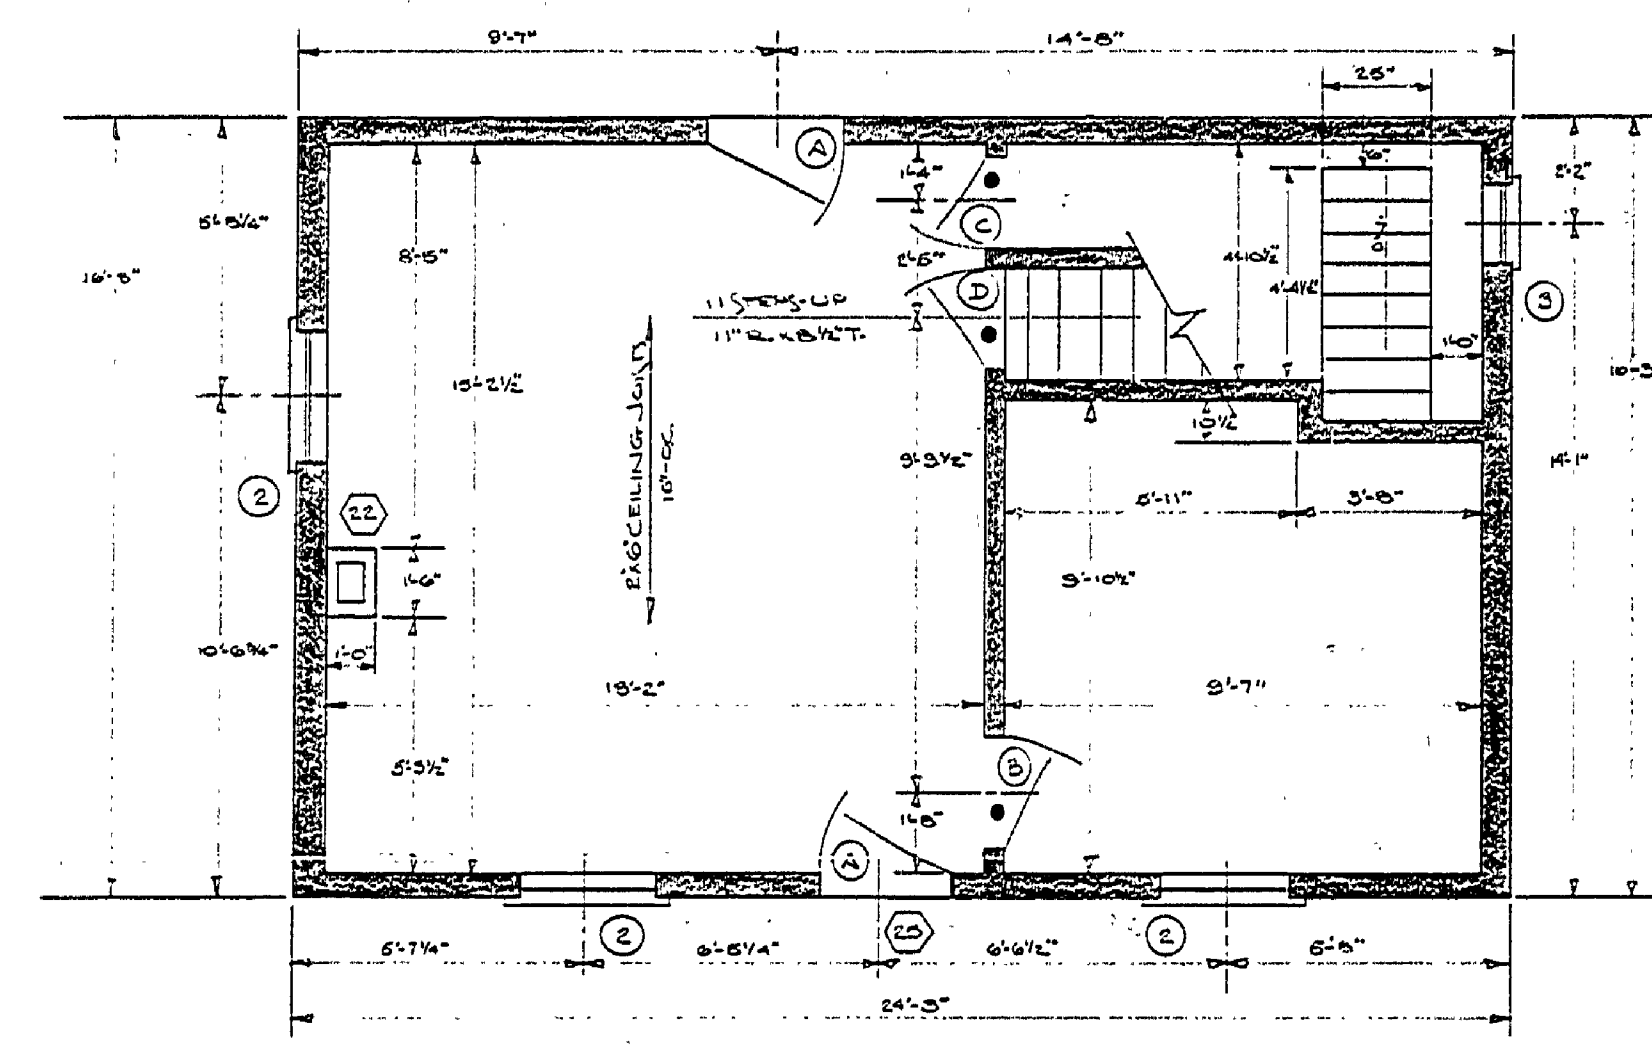



FIRST FLOOR PLAN

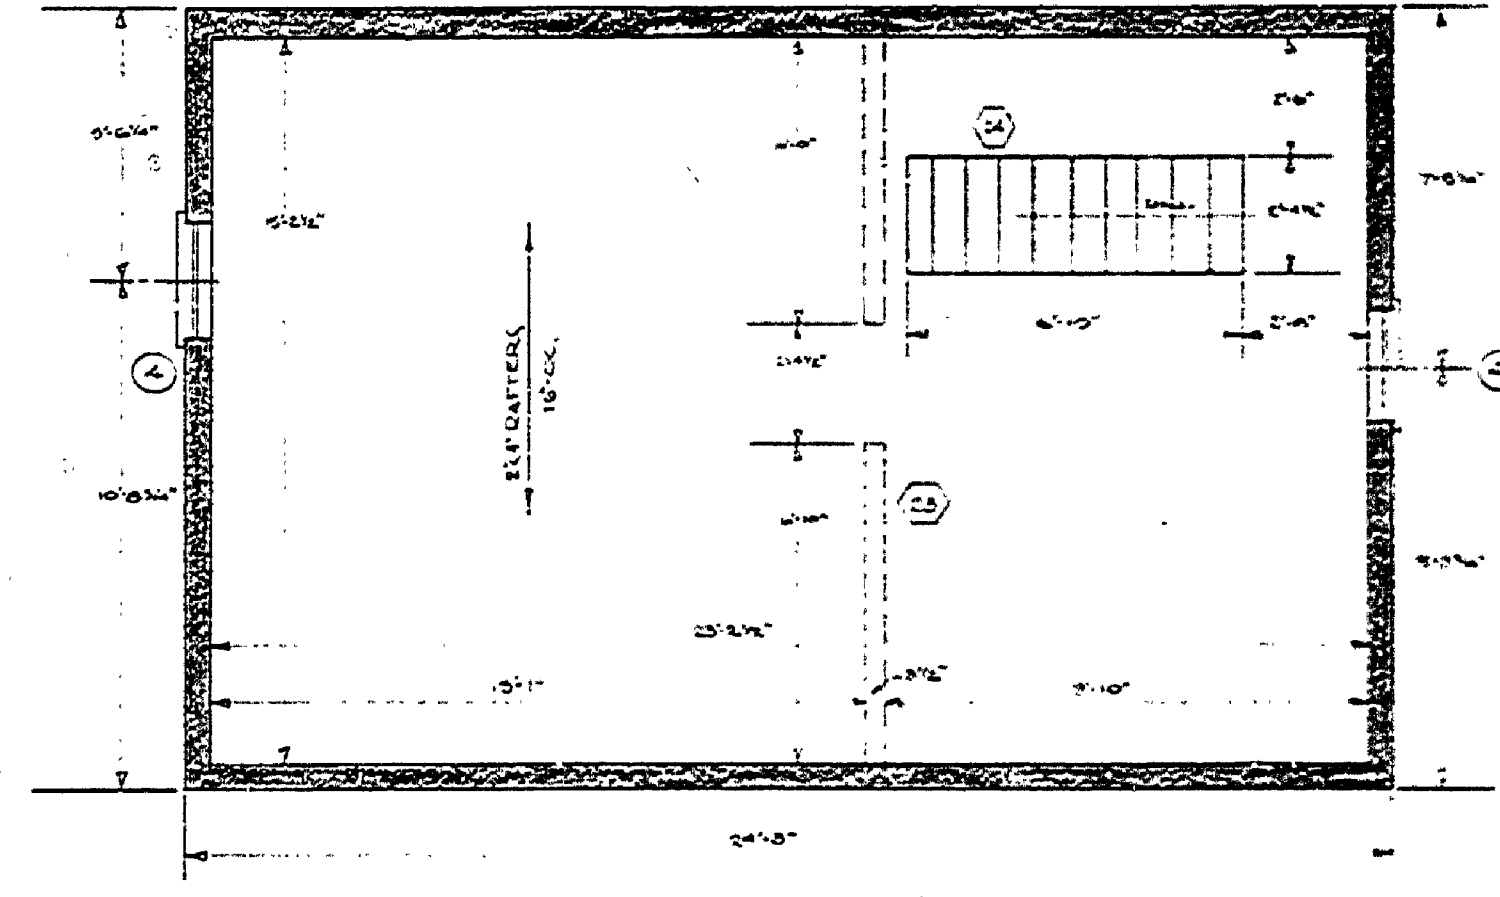


SECOND FLOOR PLAN

- NOTES:
- (1) PARTIAL FOUNDATION IS FILLING POSITION FOR EITHER AN ENCLOSED ROOM OR ROOM ON SEAL OF HOUSE.
  - (2) SPEC. NOT ORIGINAL
  - (3) FLOOR MISSING FROM BUTTRESS FIRST FLOOR RELIANT
  - (4) WALL MISSING
  - (5) JACKET WALL MISSING
  - (6) FRONT PORCH REM. 11/10
  - (7) 11\"/>
  - (8) 11\"/>
  - (9) 11\"/>


SCALE 1/4"=1'-0"

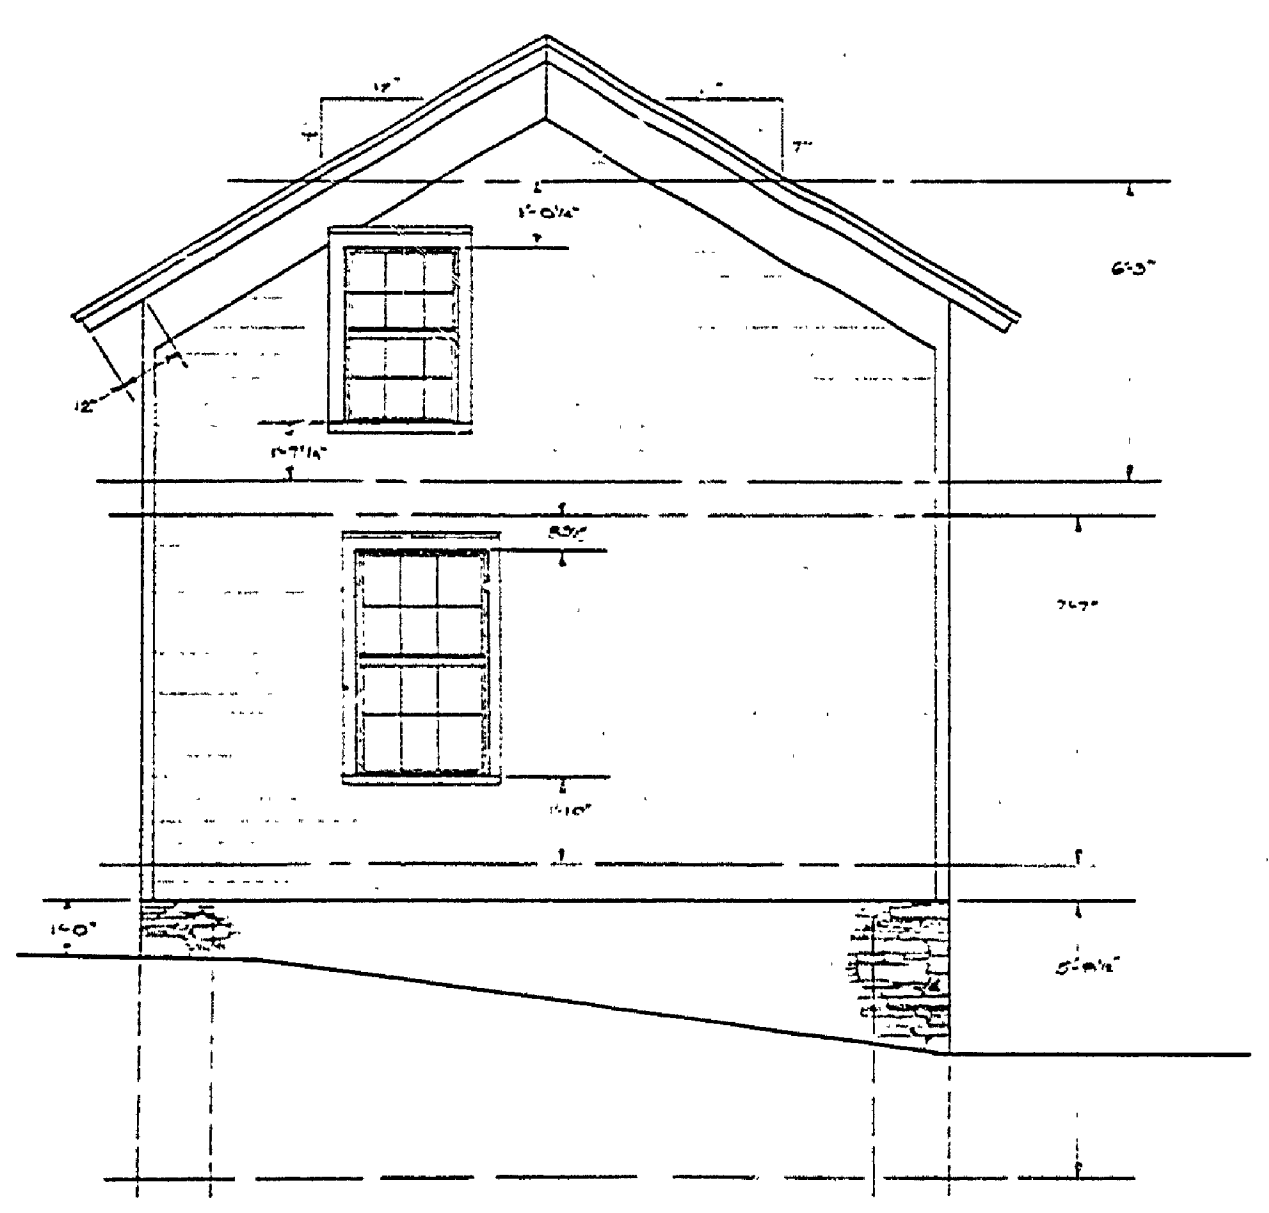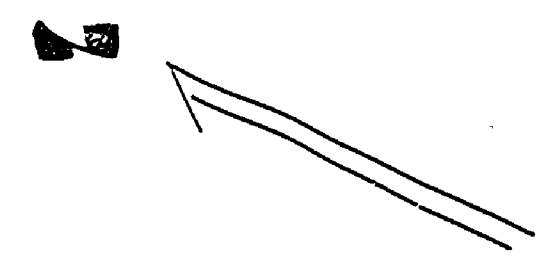


NORTH ELEVATION

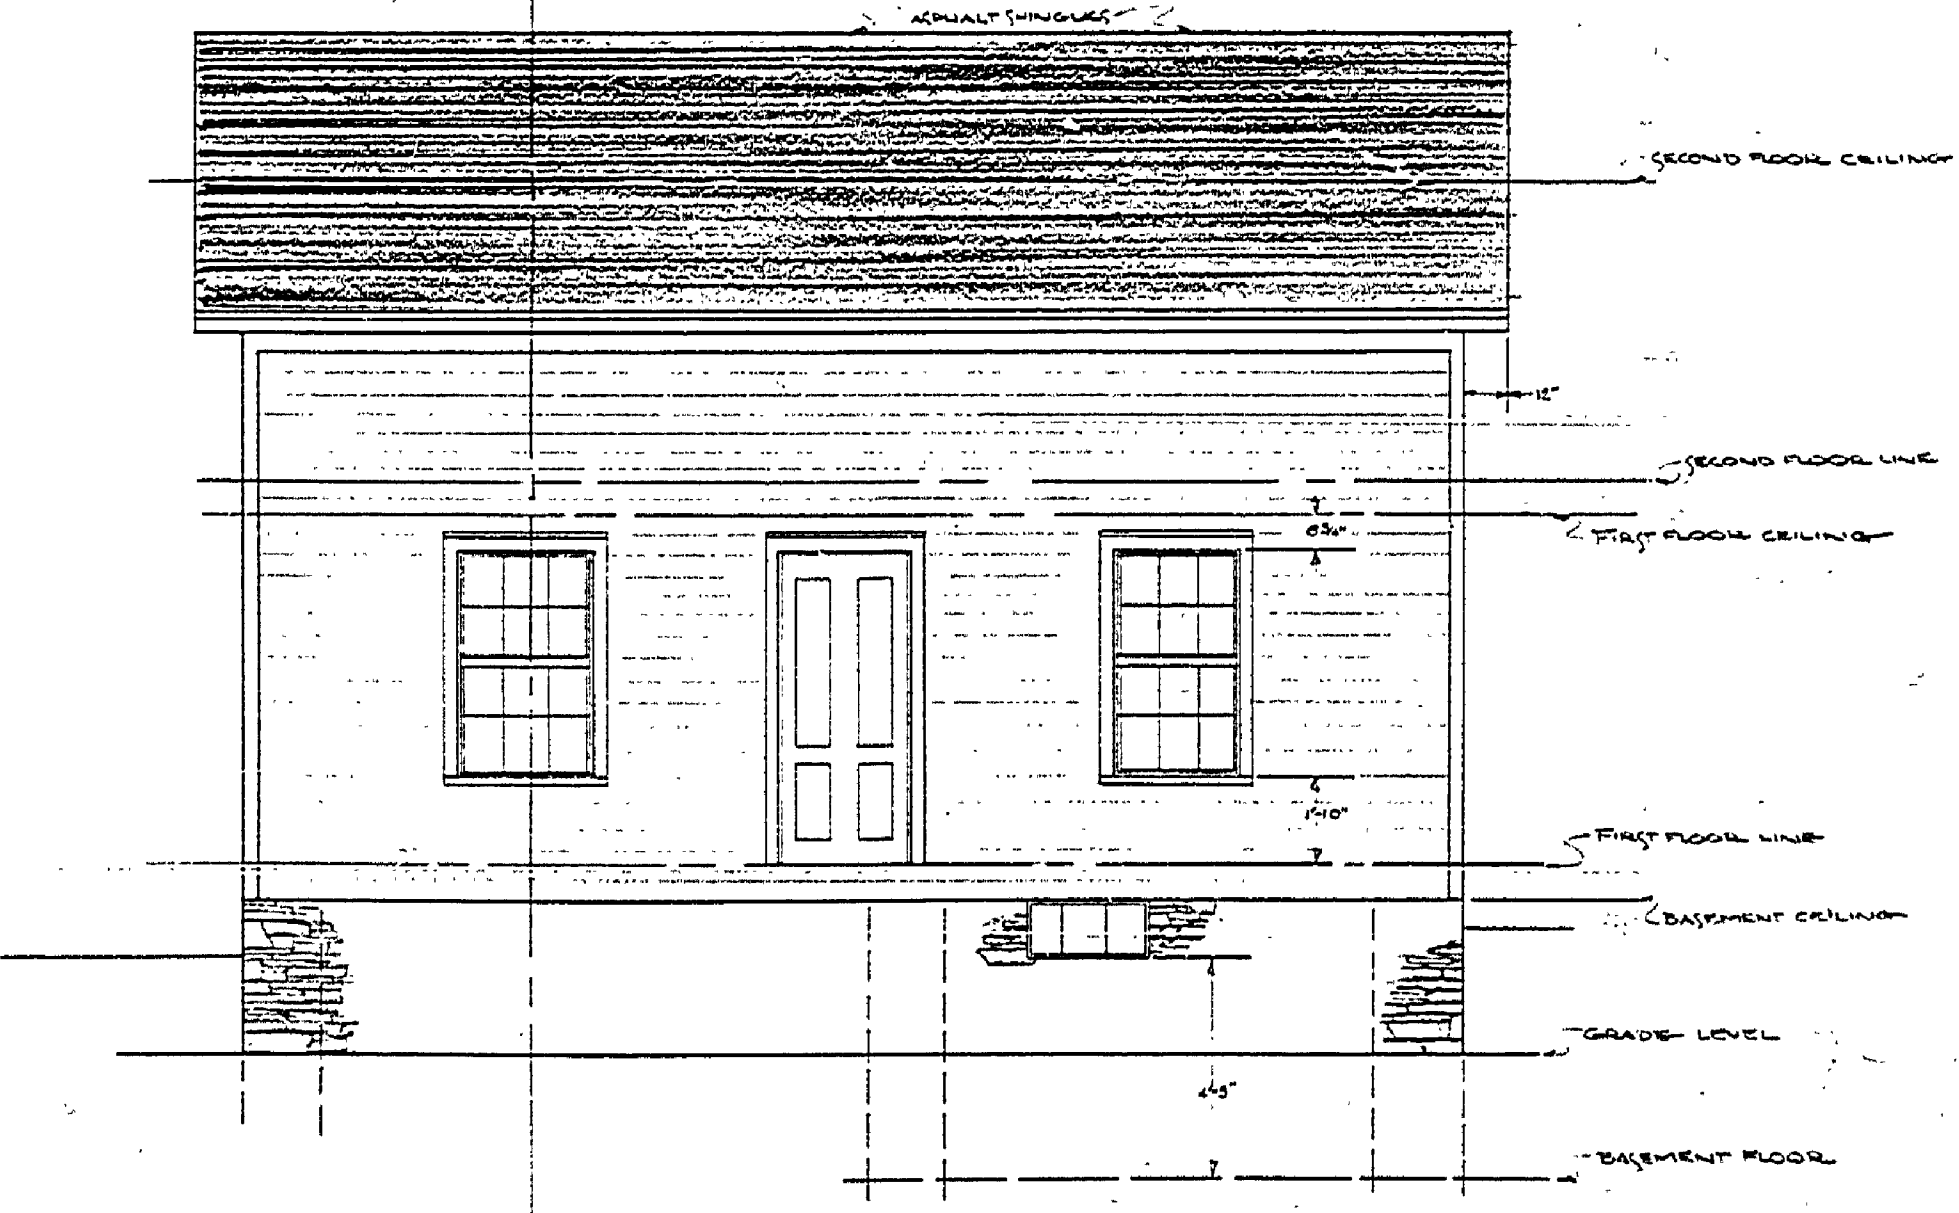

WEST ELEVATION

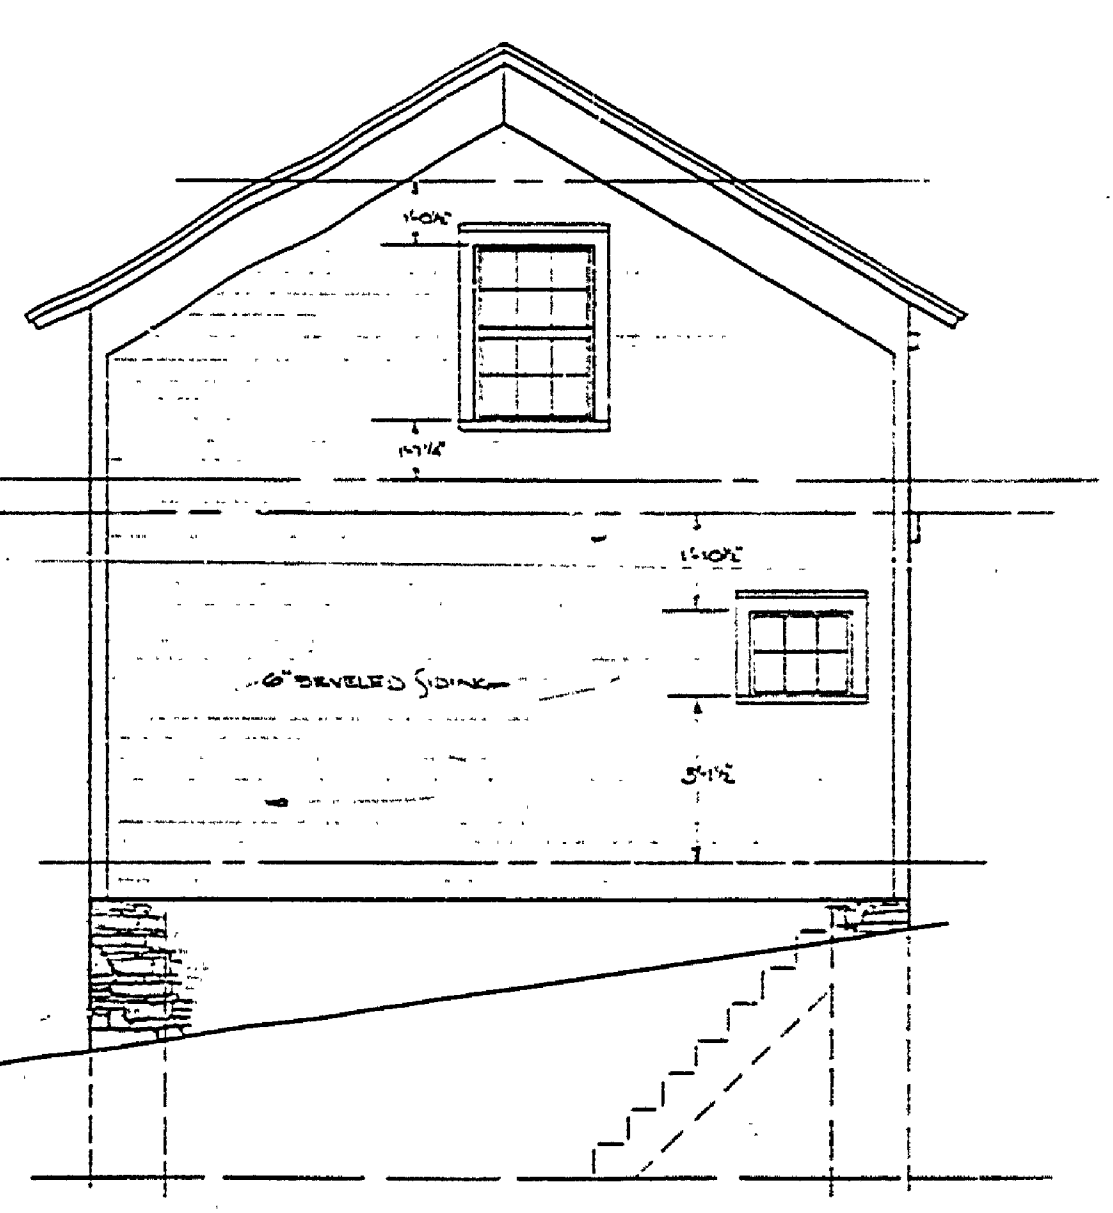

SOUTH ELEVATION

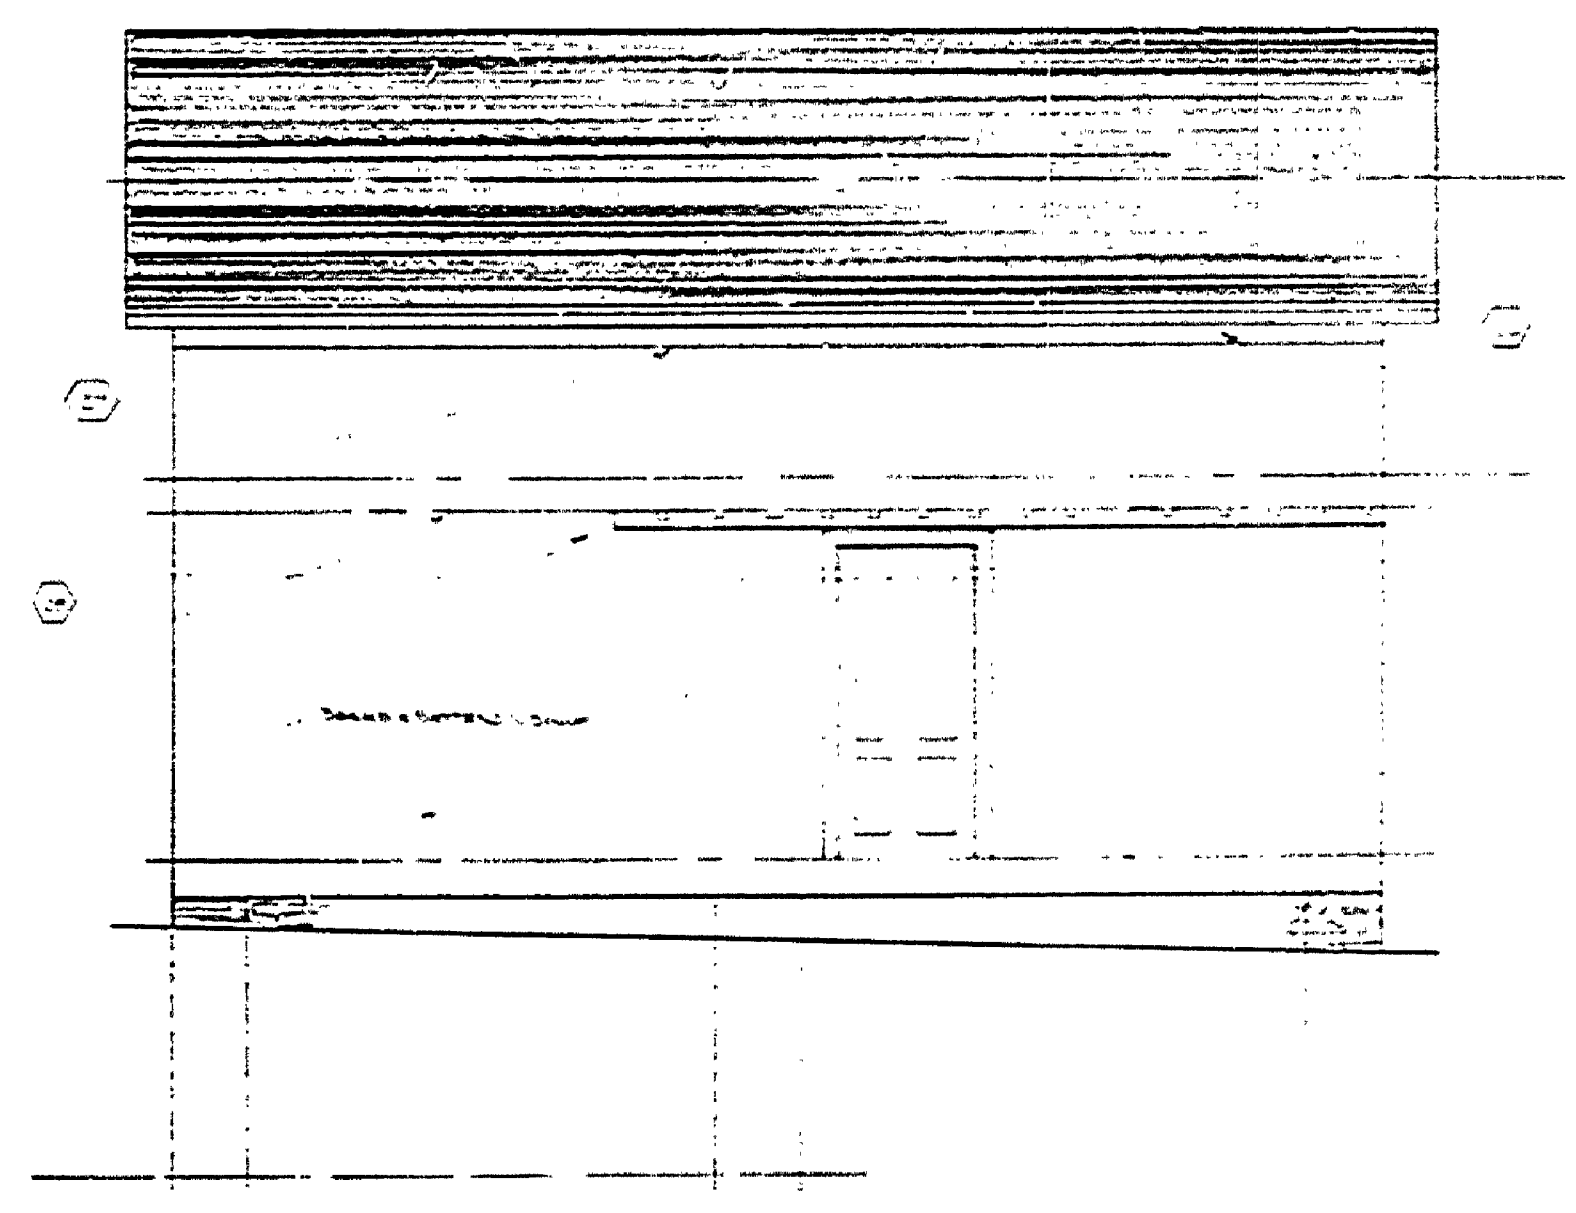

EAST ELEVATION

BUILDING #18

MICHIGAN DEPARTMENT OF CONSERVATION PARKS AND RECREATION DIVISION

MEASURED DRAWING - HISTORICAL TOWN SITE FAYETTE - GATE 212

SHEET NO. OF

PLAN NO. A-18