


| DESIGNED BY   | DATE    | REVIEWED      | DATE | APPROVED | DATE | NO. | DATE | BY | REVISIONS |
|---|---------|---------------|------|----------|------|-----|------|----|-----------|
| DESIGNED BY [Signature]<br>DRAWN BY [Signature]<br>CHECKED BY [Signature] | 6/10/64 | ARCHITECTURAL |      |          |      | 1   |      |    | 4         |
|   | 6/10/64 | ENGINEERING   |      |          |      | 2   |      |    | 5         |
|   |         | LANDSCAPE     |      |          |      | 3   |      |    | 6         |
|   |         |               |      |          |      |     |      |    |           |
|   |         |               |      |          |      |     |      |    |           |
|   |         |               |      |          |      |     |      |    |           |



SECTION D-D  
SCALE 1"=4'

NOTE: ORIGINAL GROUND WAS  
DRAINAGE DITCH

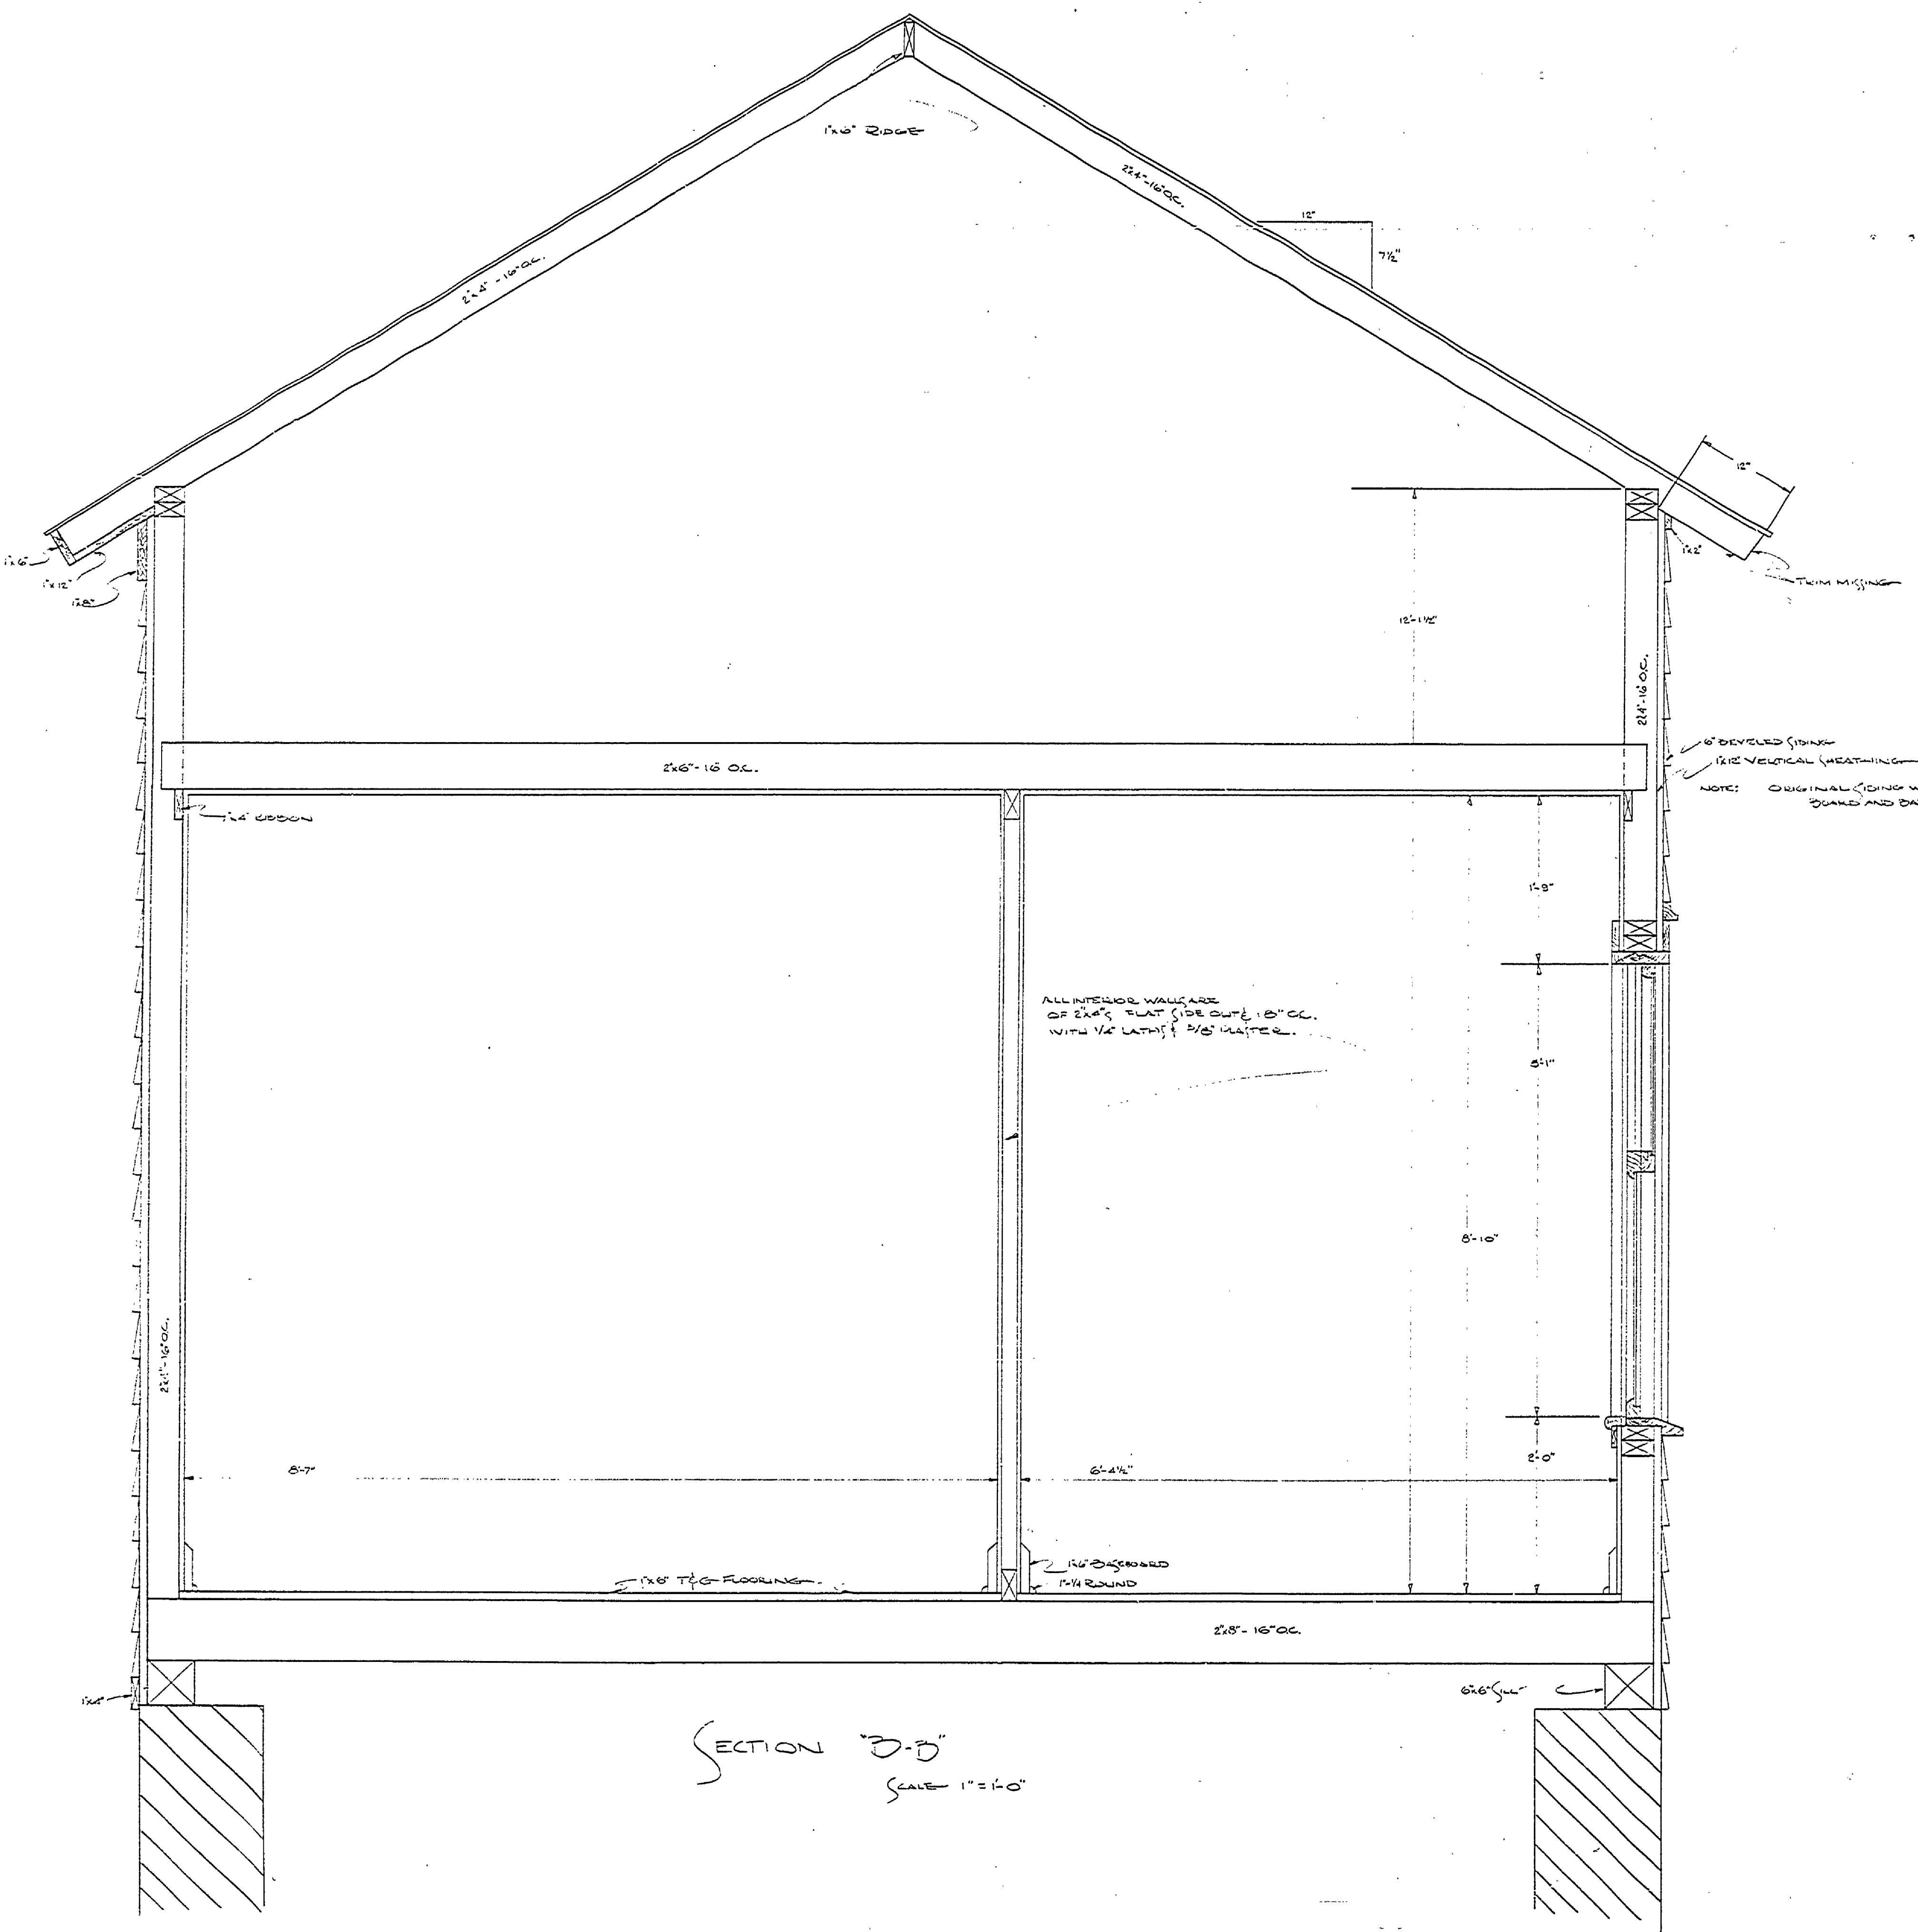