



DESIGNED BY B.C.L.	DATE 7/13/82	REVIEWED ARCHITECTURAL	DATE	APPROVED	DATE	NO.	DATE	BY	REVISIONS
DRAWN BY B.C.L.	7/15/82	ENGINEERING				1			4
CHECKED BY		LANDSCAPE				2			5
						3			6

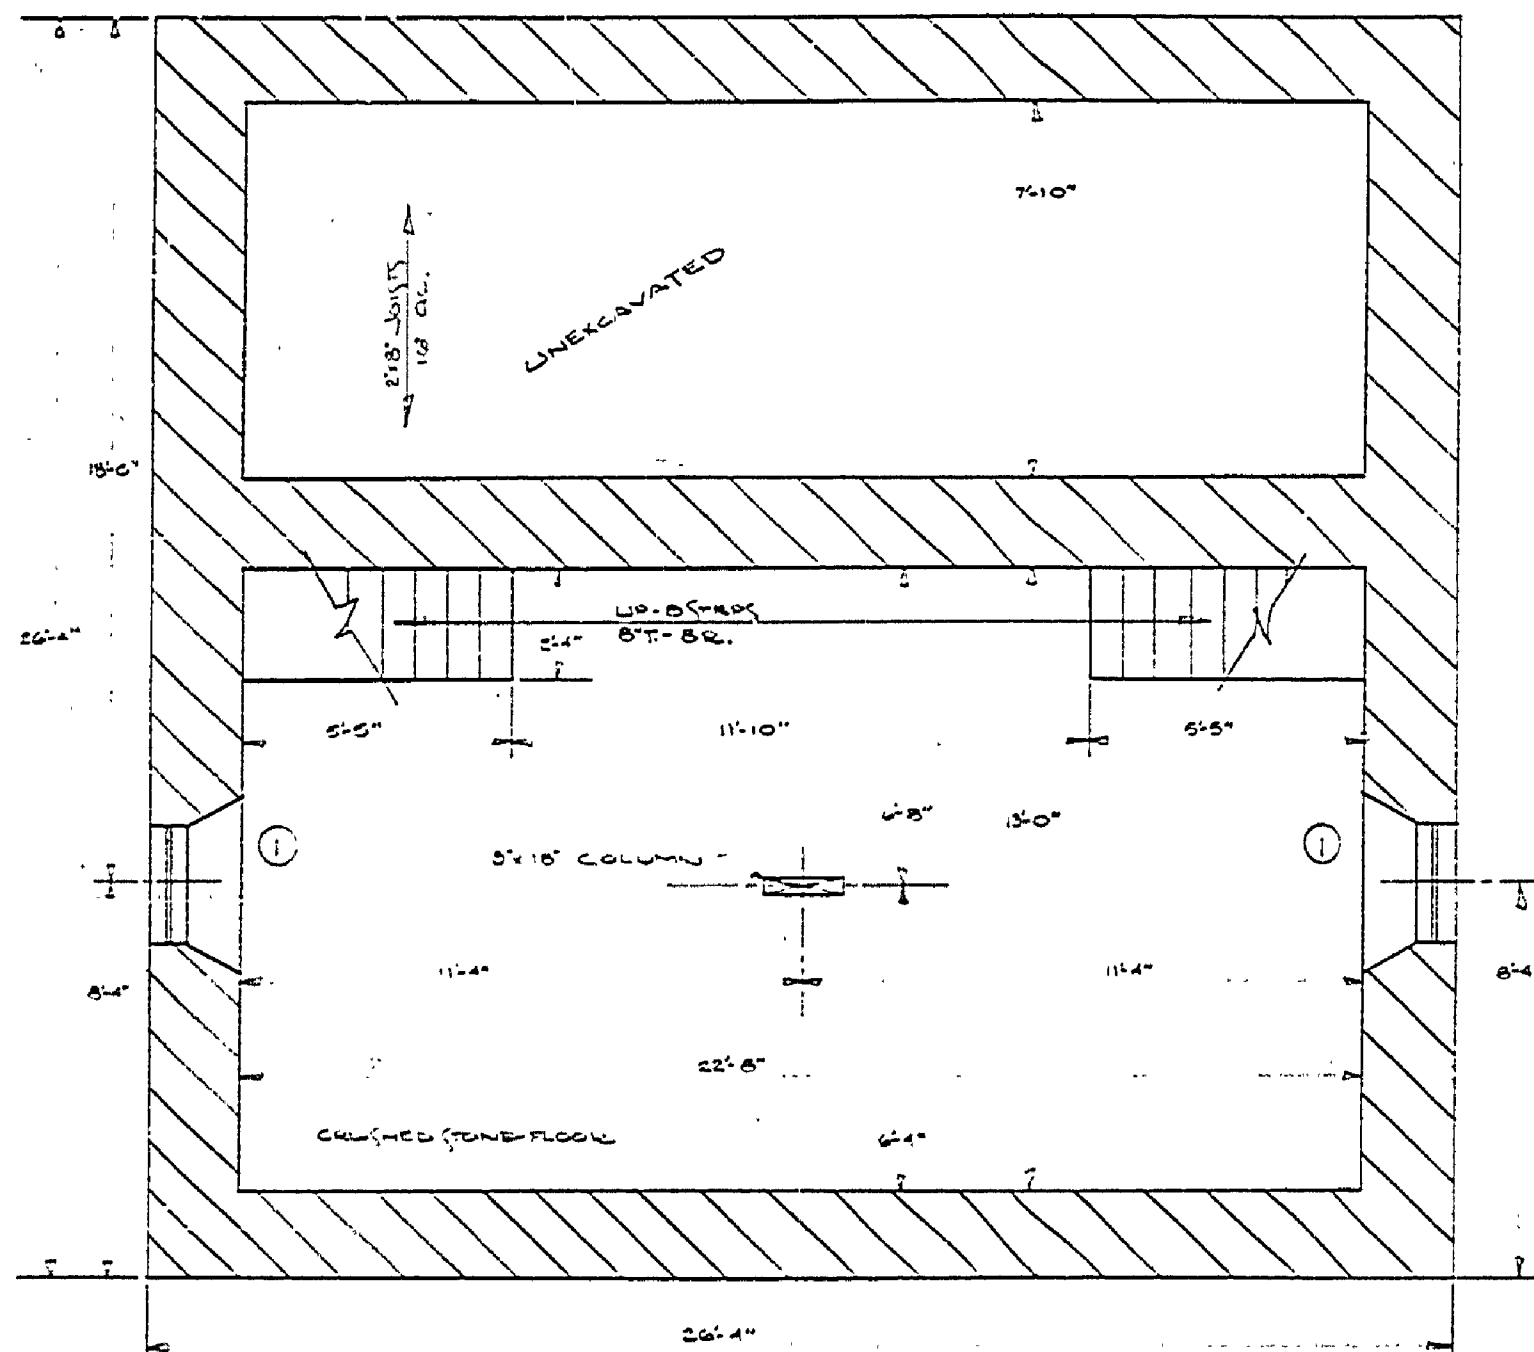


BASEMENT & FOUNDATION PLAN

NOTE:
ALL WALLS 22\"/>

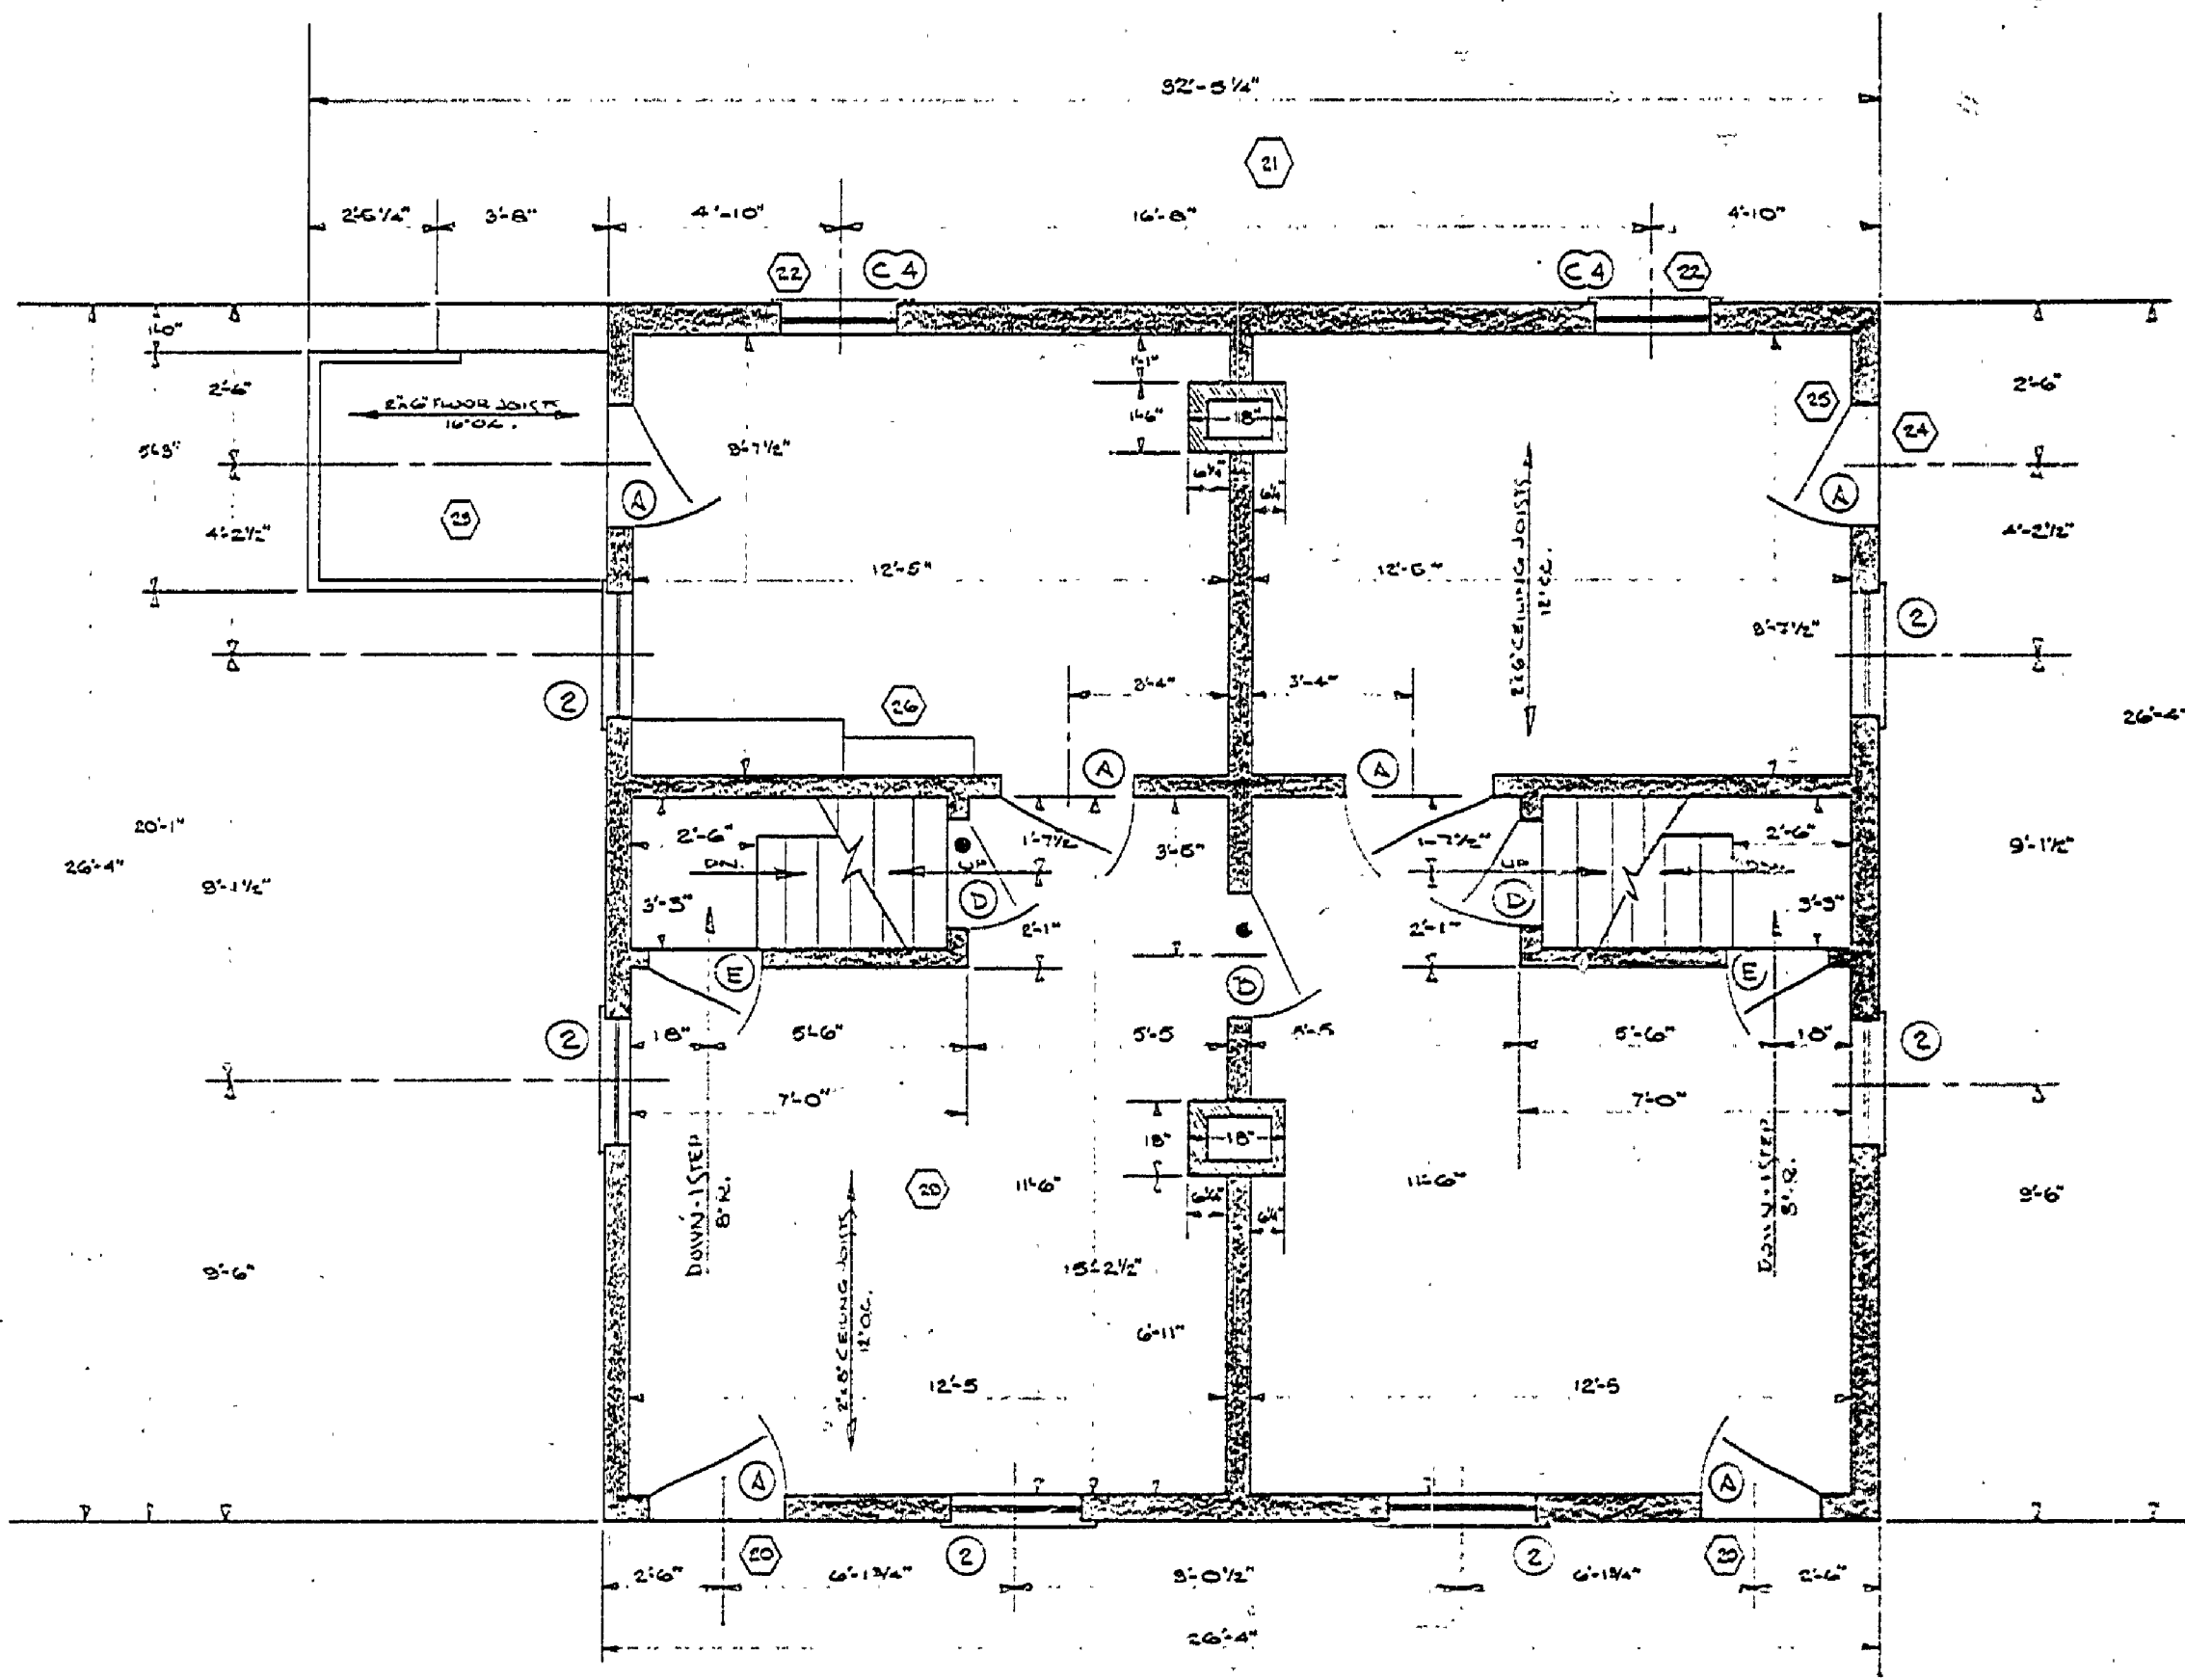

FIRST FLOOR PLAN

SCALE 1/4\"/>

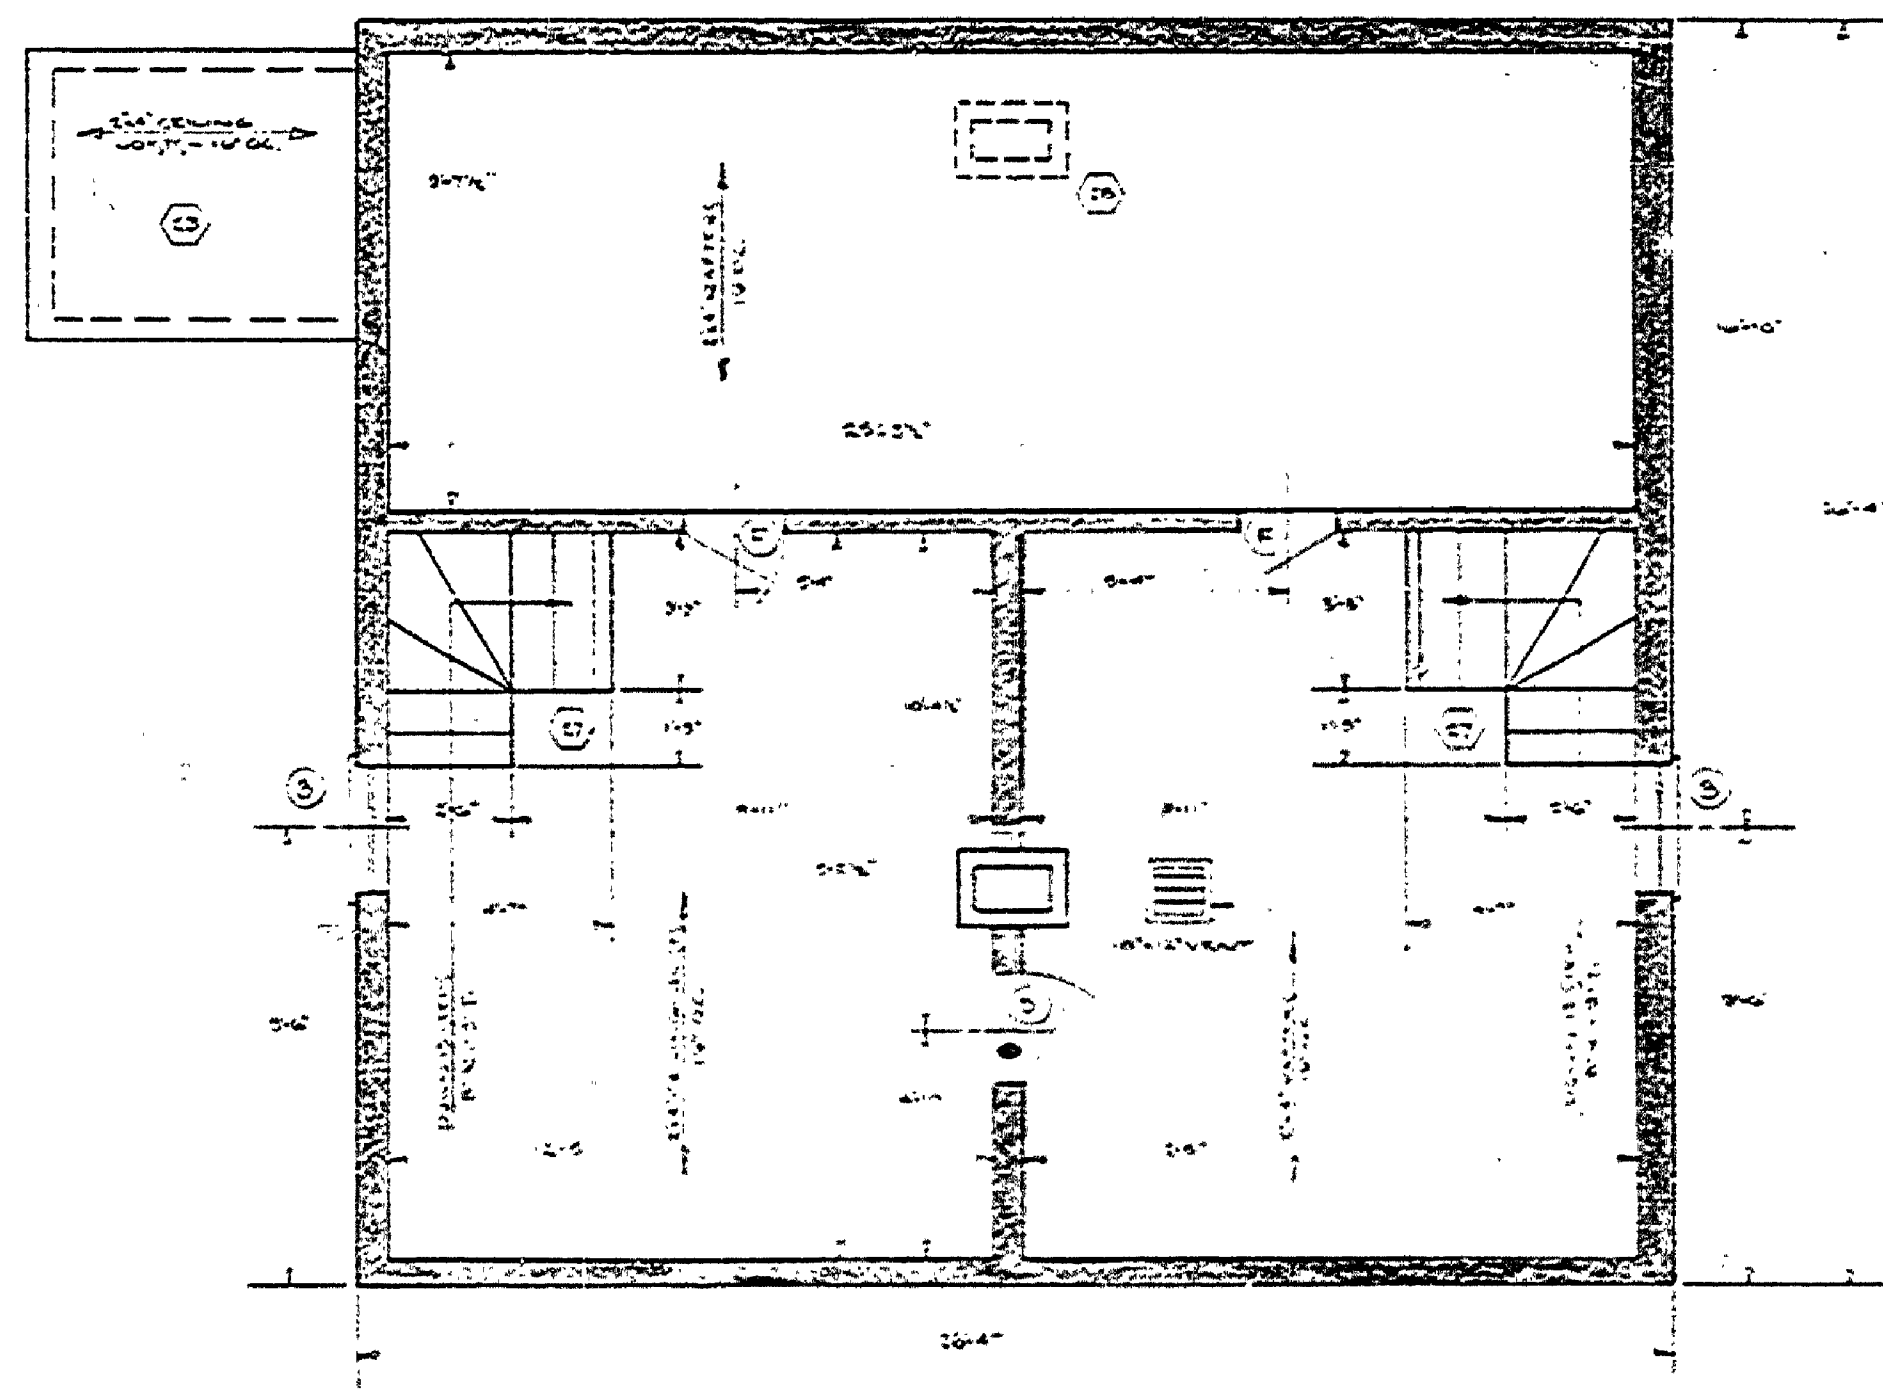


SECOND FLOOR PLAN

- NOTE:
- (1) - SMALL FRONT PORCH AND TERRACE DECK REPAIRED IN 1978.
 - (2) - THIS LEVEL'S ROOF IS TERRACE DECK, PREVIOUSLY ON LEVEL OF FLOOR.
 - (3) - LOWER PART OF THIS DECK WAS 1\"/>
 - (4) - WORK IN VERY POOR CONDITION.
 - (5) - PORCH (WALLS TO 2\"/>
 - (6) - DOOR SALES IN TERRACE.
 - (7) - KITCHEN (WALLS) - SEE DETAIL.
 - (8) - STAIRS (WALLS) - SEE DETAIL.
 - (9) - TOP OF CHIMNEY REMOVED BELOW 2\"/>
 - (10) - WATER IN 1\"/>

NO.	REQD.	SIZE	TYPE	GLASS	TRANS.	HARDWARE	REMARKS
A	0	0'-0" x 0'-0"	PANEL	NONE	NONE	STD.	NONE
B	1	2'-0" x 6'-6"	"	"	"	"	"
C	1	2'-0" x 6'-6"	"	"	"	"	"
D	0	2'-4" x 6'-6"	"	"	"	"	"
E	2	2'-2" x 5'-4"	"	"	"	"	"
F	0	1'-0" x 4'-0"	FRAME	"	"	"	ATTIC ACCESS

NO.	REQD.	SIZE	GLASS	TYPE	REMARKS
1	2	2'-0" x 1'-0"	3/ 8"x10"	FIXED	NONE
2	0	2'-7 1/4" x 5'-1 1/2"	6/ 8" x 12"	DM.	COUNTER BAL.
3	2	2'-7 1/4" x 4'-4"	6/ 8" x 12"	DM.	COUNTER BAL.
4	2	2'-0" x 2'-0"	6/ 8" x 12"	FIXED	NONE

NOTE:
ALL DOORS NOTED WITH SMALL DOT - • ARE MISSING

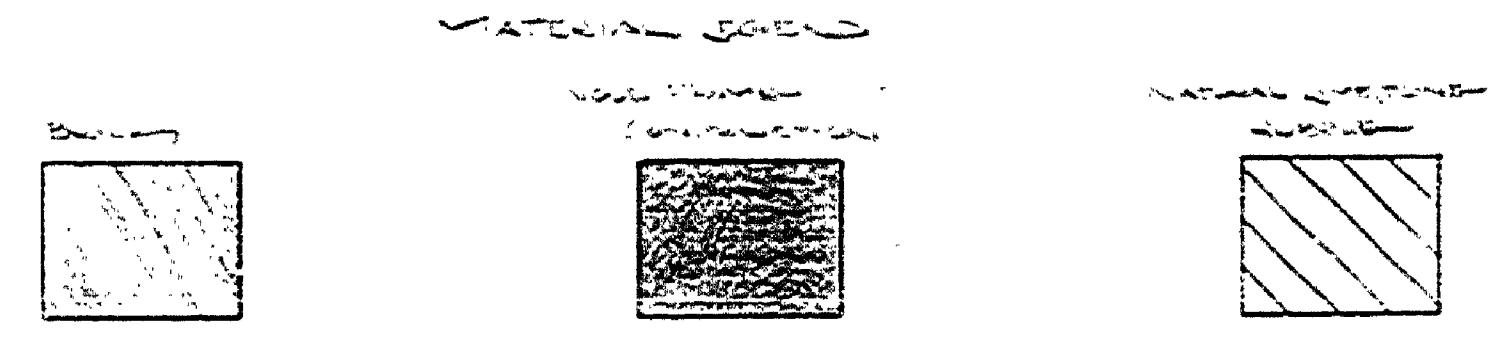

BUILDING # 30231

MICHIGAN
DEPARTMENT OF CONSERVATION
PARKS AND RECREATION DIVISION

MEASURED DRAWING
FAYETTE HISTORICAL TOWNSITE
FAYETTE STATE PARK

SHEET
NO. 1
OF 1
PLAN NO.
A-30