


DESIGNED BY	DATE	REVIEWED	DATE	APPROVED	DATE	NO.	DATE	BY	REVISIONS
DRAWN BY <i>James Lawrence</i>	9-22-60	ARCHITECTURAL ENGINEERING LANDSCAPE				1			4
						2			5
						3			6

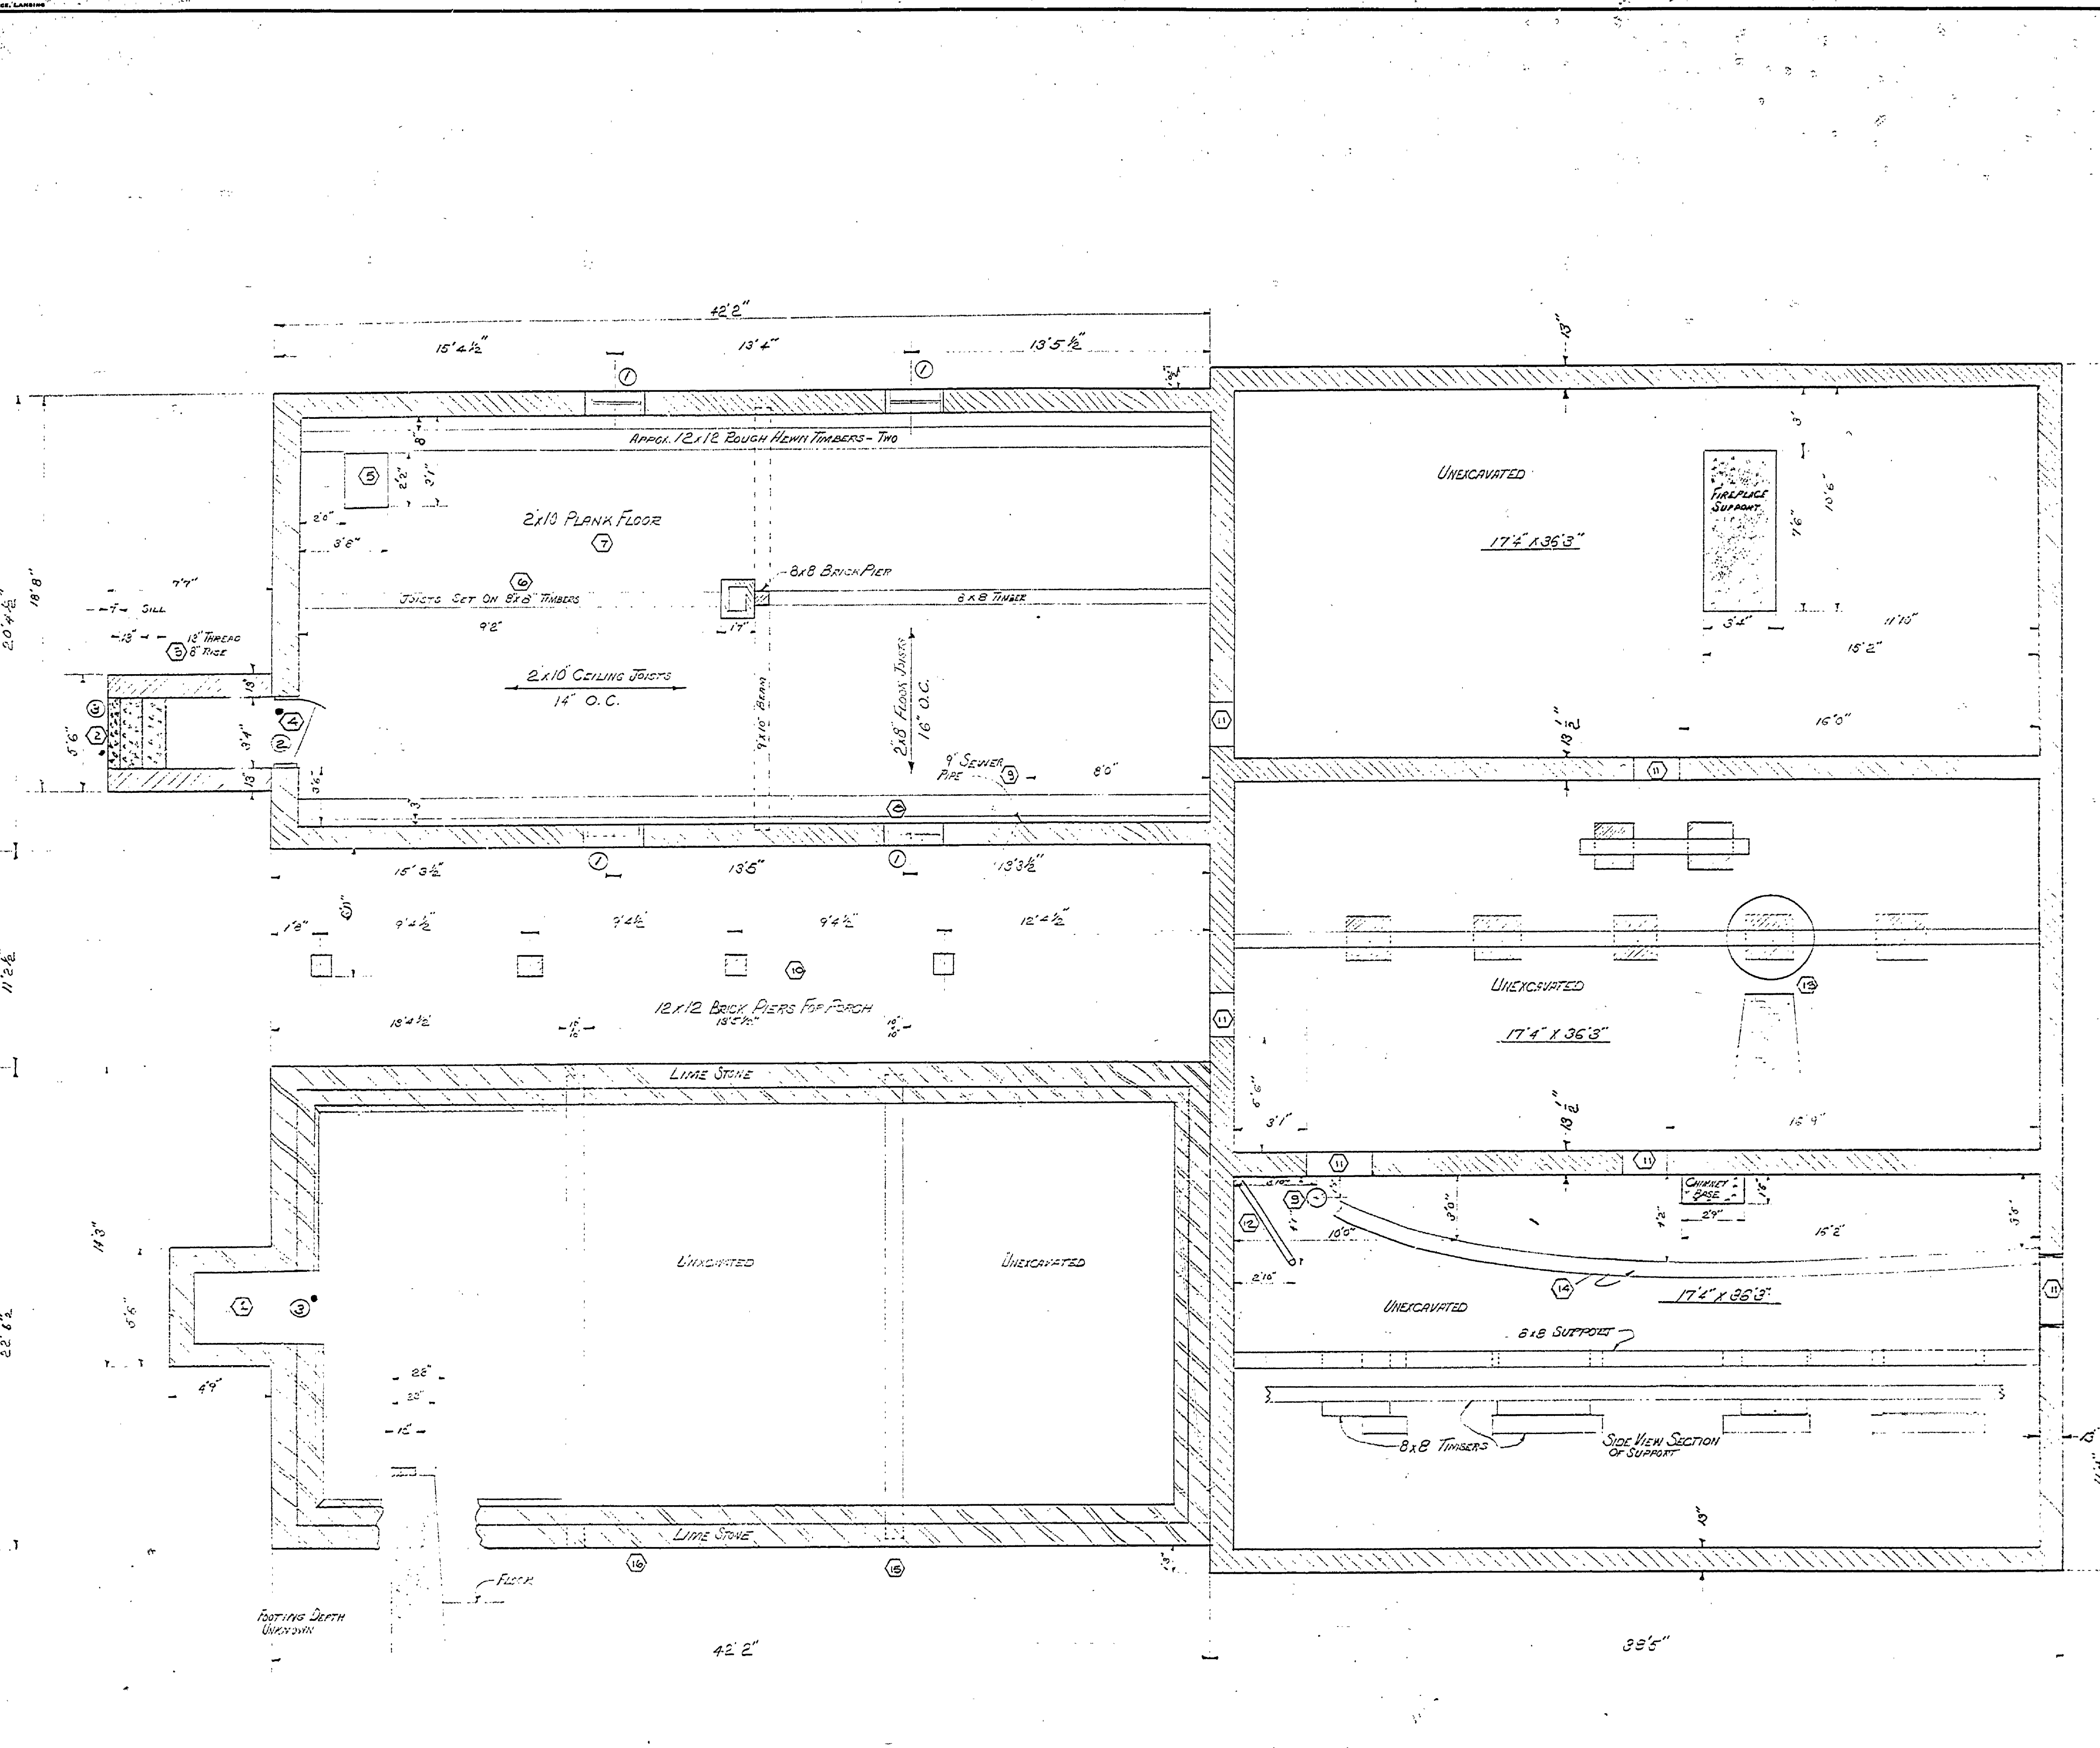

FOUNDATION & BASEMENT PLAN SCALE 1/4" = 1'-0"

SPECIAL NOTE


THESE DRAWINGS ARE THE MEASURED DRAWINGS OF WHAT IS ACTUALLY THERE AT THIS TIME. NOTES FOR THESE DRAWINGS CONCERNING REPAIRS NEEDED, PREVIOUS ALTERATIONS AND ADDITIONS (OR DELETIONS) AND GENERAL COMMENTS, ETC., WILL BE INCLUDED UNDER SEPARATE COVER. DETAILS FOR RESTORATION AND RECONSTRUCTION WILL BE INCLUDED IN ANOTHER SET OF DRAWINGS.

WINDOW SCHEDULE					
NO.	REQ.	TYPE	SIZE	GLASS	REMARKS
1	4	FIXED	10'0" X 3'0"	MISSING	7# STEEL BARS @ 2' O.C.

DOOR SCHEDULE					
NO.	REQ.	TYPE	SIZE	GLASS	REMARKS
2	1		35 1/2" X 75"	SOLID WOOD	IN BAD CONDITION
3	1				SILL JAMB & DOOR MISSING
4	1				SILL JAMB & DOOR MISSING

DOORS NOTED WITH SMALL DOT (•) ARE MISSING, OR DAMAGED

MATERIAL SCHEDULE

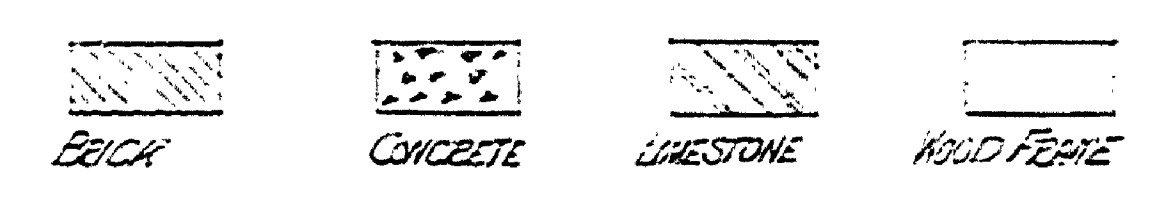

FOOTING DEPTH ON ALL BASEMENT WALLS & SUPPORTS UPWARD

MICHIGAN DEPARTMENT OF CONSERVATION PARKS AND RECREATION DIVISION

MEASURED DRAWINGS
FAYATTE HORTICULTURAL TRANSMITTEL
FAYETTE STATE PARKS

SHEET NO. 1 OF 1 PLAN NO. A-100