


DESIGNED BY	DATE	REVIEWED	DATE	APPROVED	DATE	NO.	DATE	REVISIONS	DATE	BY
DRAWN BY <i>[Signature]</i>	10 22 64	ARCHITECTURAL				1		4		
CHECKED BY		ENGINEERING				2		5		
		LANDSCAPE				3		6		

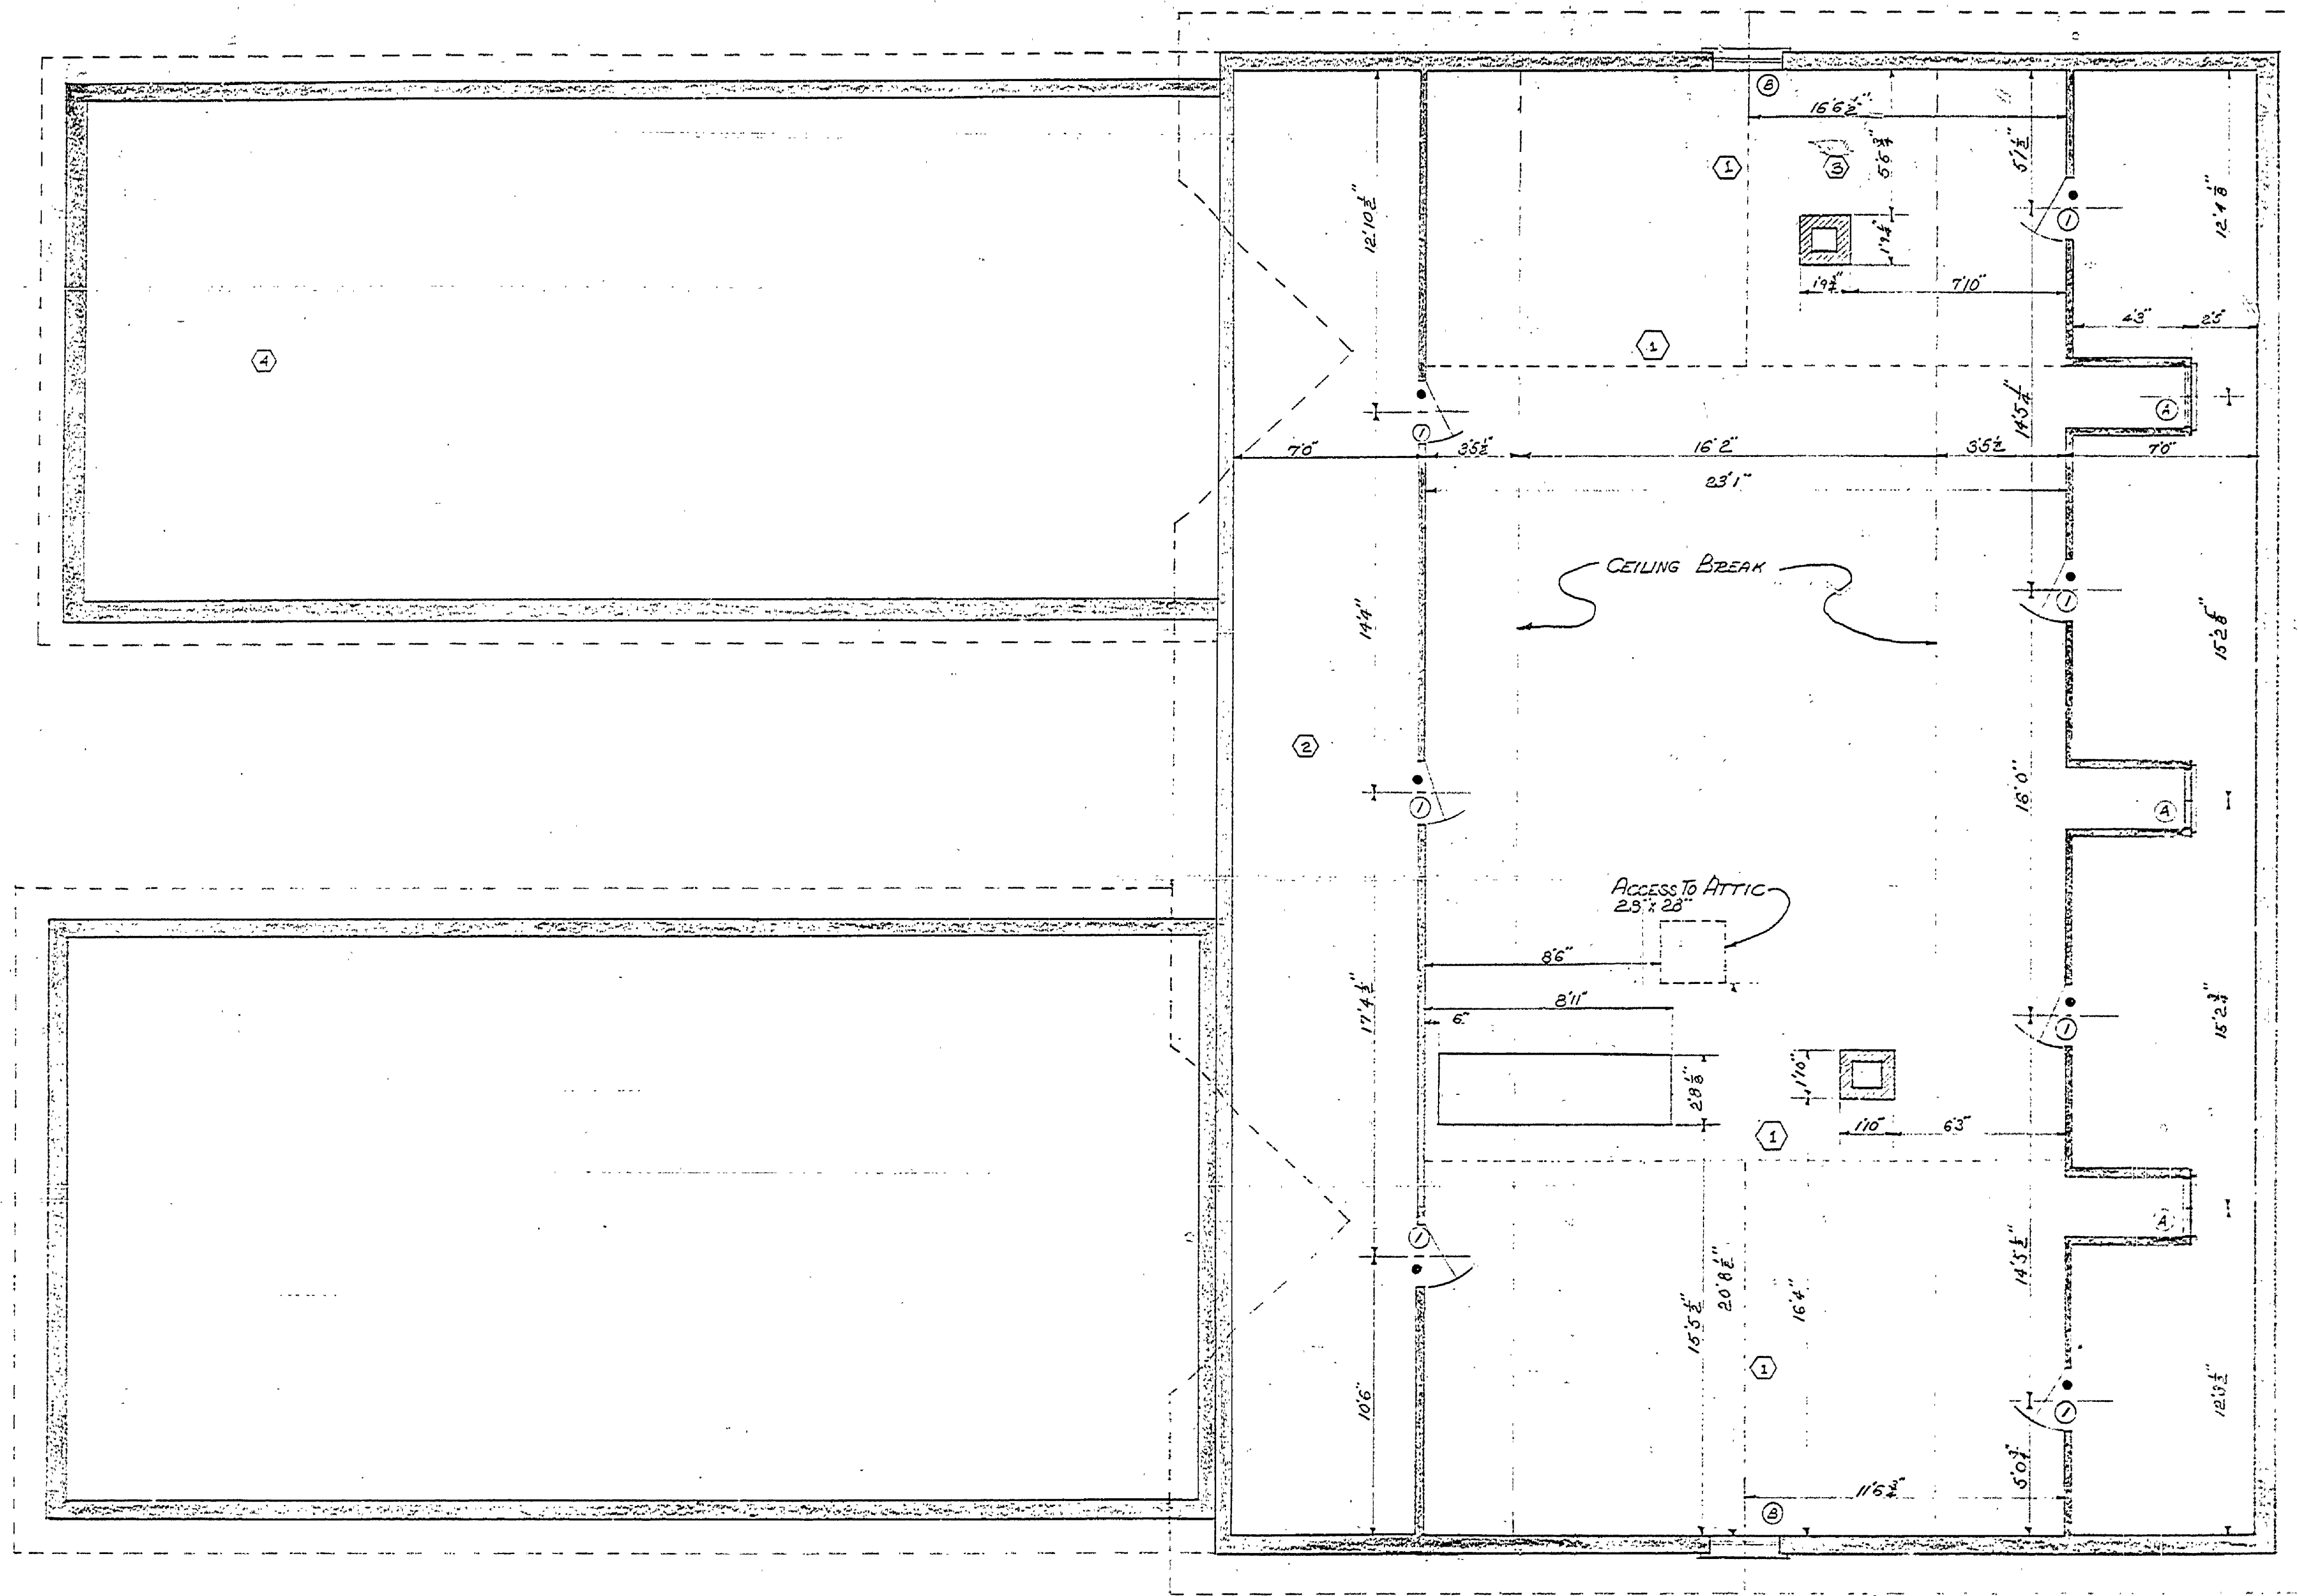

THIRD FLOOR PLAN
SCALE 1/4" = 1'-0"

WINDOW SCHEDULE						
NO.	REQ'D	SIZE	SASH	GLASS	TYPE	REMARKS
A	3		23'12 1/2"	3'110	D.H.	
B	2	85' x 128 1/2"	52' x 28 1/2"	3'150	D.H.	

DOOR SCHEDULE						
NO.	REQ'D	SIZE	GLASS	TRANS.	TYPE	REMARKS
1	7	63' x 28"	NONE	NONE	1100 F	

NOTES
 116 T&S FLOORING IS IN SOME CORNERS IN PLASTER FIVE. N.Y. TRIM.
 ALL DOORS MARKED WITH A DOT (•) ARE MISSING.
 STABLE SPACE WALLS HAVE A 2 1/4" FORT WITH 5/8" PLASER ON EDGE WITH
 WALL FOR GRIDS. PLASTER WITH ONE SIDE ONLY.

MICHIGAN
DEPARTMENT OF CONSERVATION
PARKS AND RECREATION DIVISION

MEASURED DRAWINGS
FAYETTE HISTORICAL TOWNSITE
FAYETTE STATE PARKS

SHEET
NO. 4
OF 11
PLAN NO.
A-100