


DESIGNED BY	DATE	REVIEWED	DATE	APPROVED	DATE	NO.	DATE	REVISIONS	DATE	BY
DRAWN BY CHECKED BY	9/18/62	ARCHITECTURAL ENGINEERING LANDSCAPE	DATE	APPROVED	DATE	1		4		
						2		5		
						3		6		

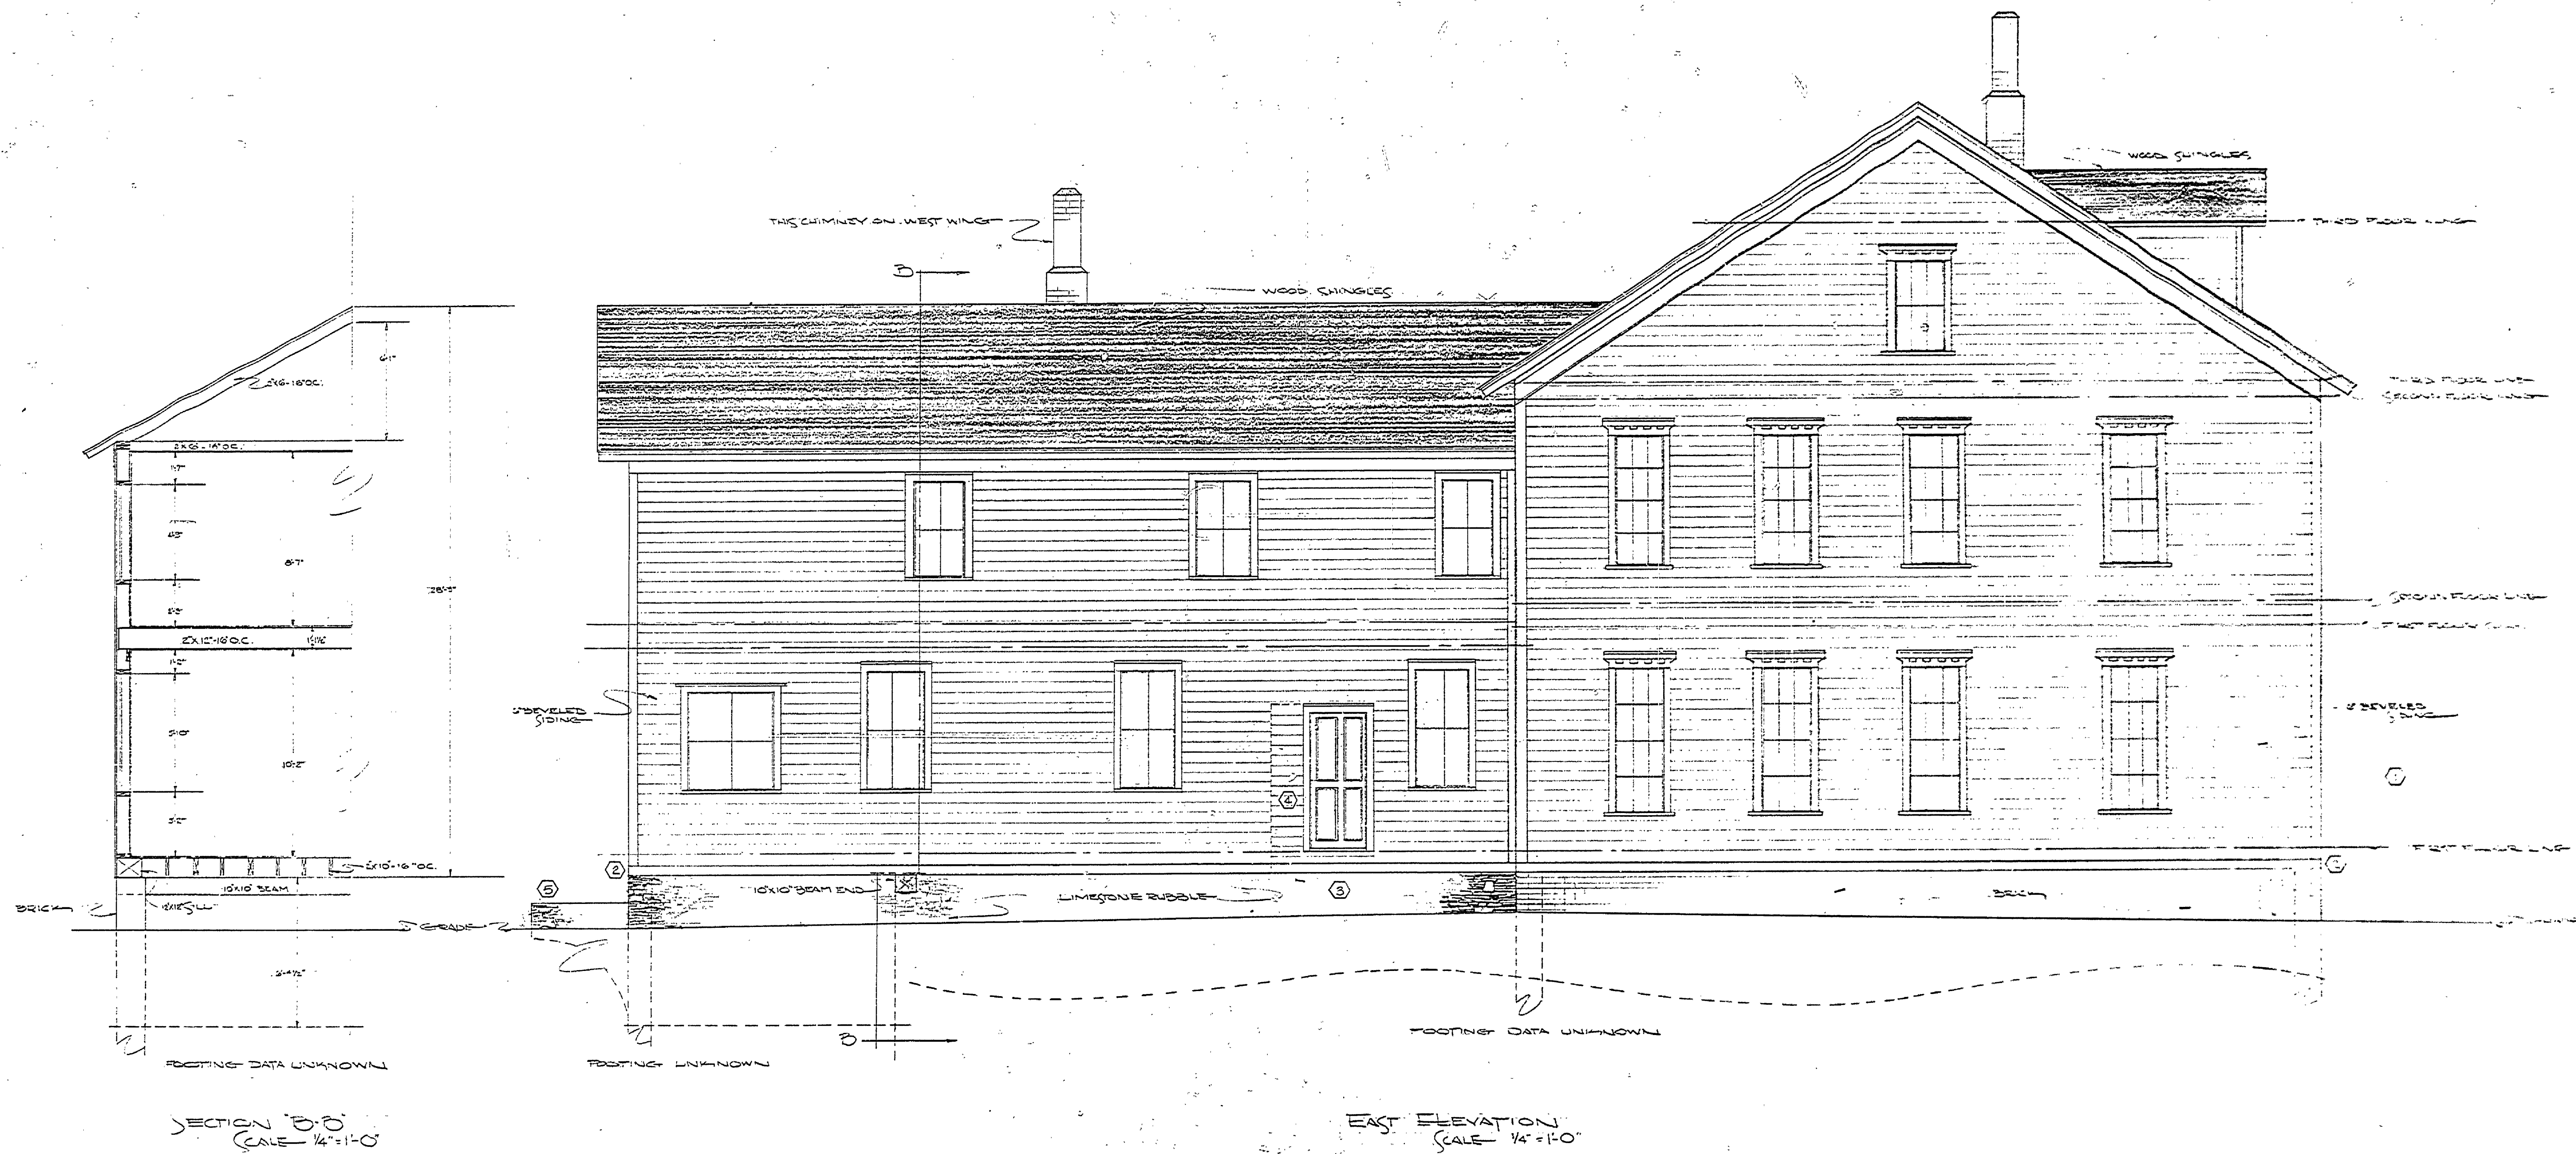

MICHIGAN  
DEPARTMENT OF CONSERVATION  
PARKS AND RECREATION DIVISION

MEASURED DRAWING  
FAYETTE HISTORICAL TOWN SITE  
FAYETTE GATEWAY PARK

SHEET  
NO. 2  
OF 2

PLAN NO.  
A-100