


DESIGNED BY	DATE	REVIEWED	DATE	APPROVED	DATE	NO.	DATE	BY	REVISIONS	DATE	BY
DRAWN BY CHECKED BY	10/1/62	ARCHITECTURAL ENGINEERING LANDSCAPE				1			4		
						2			5		
						3			6		

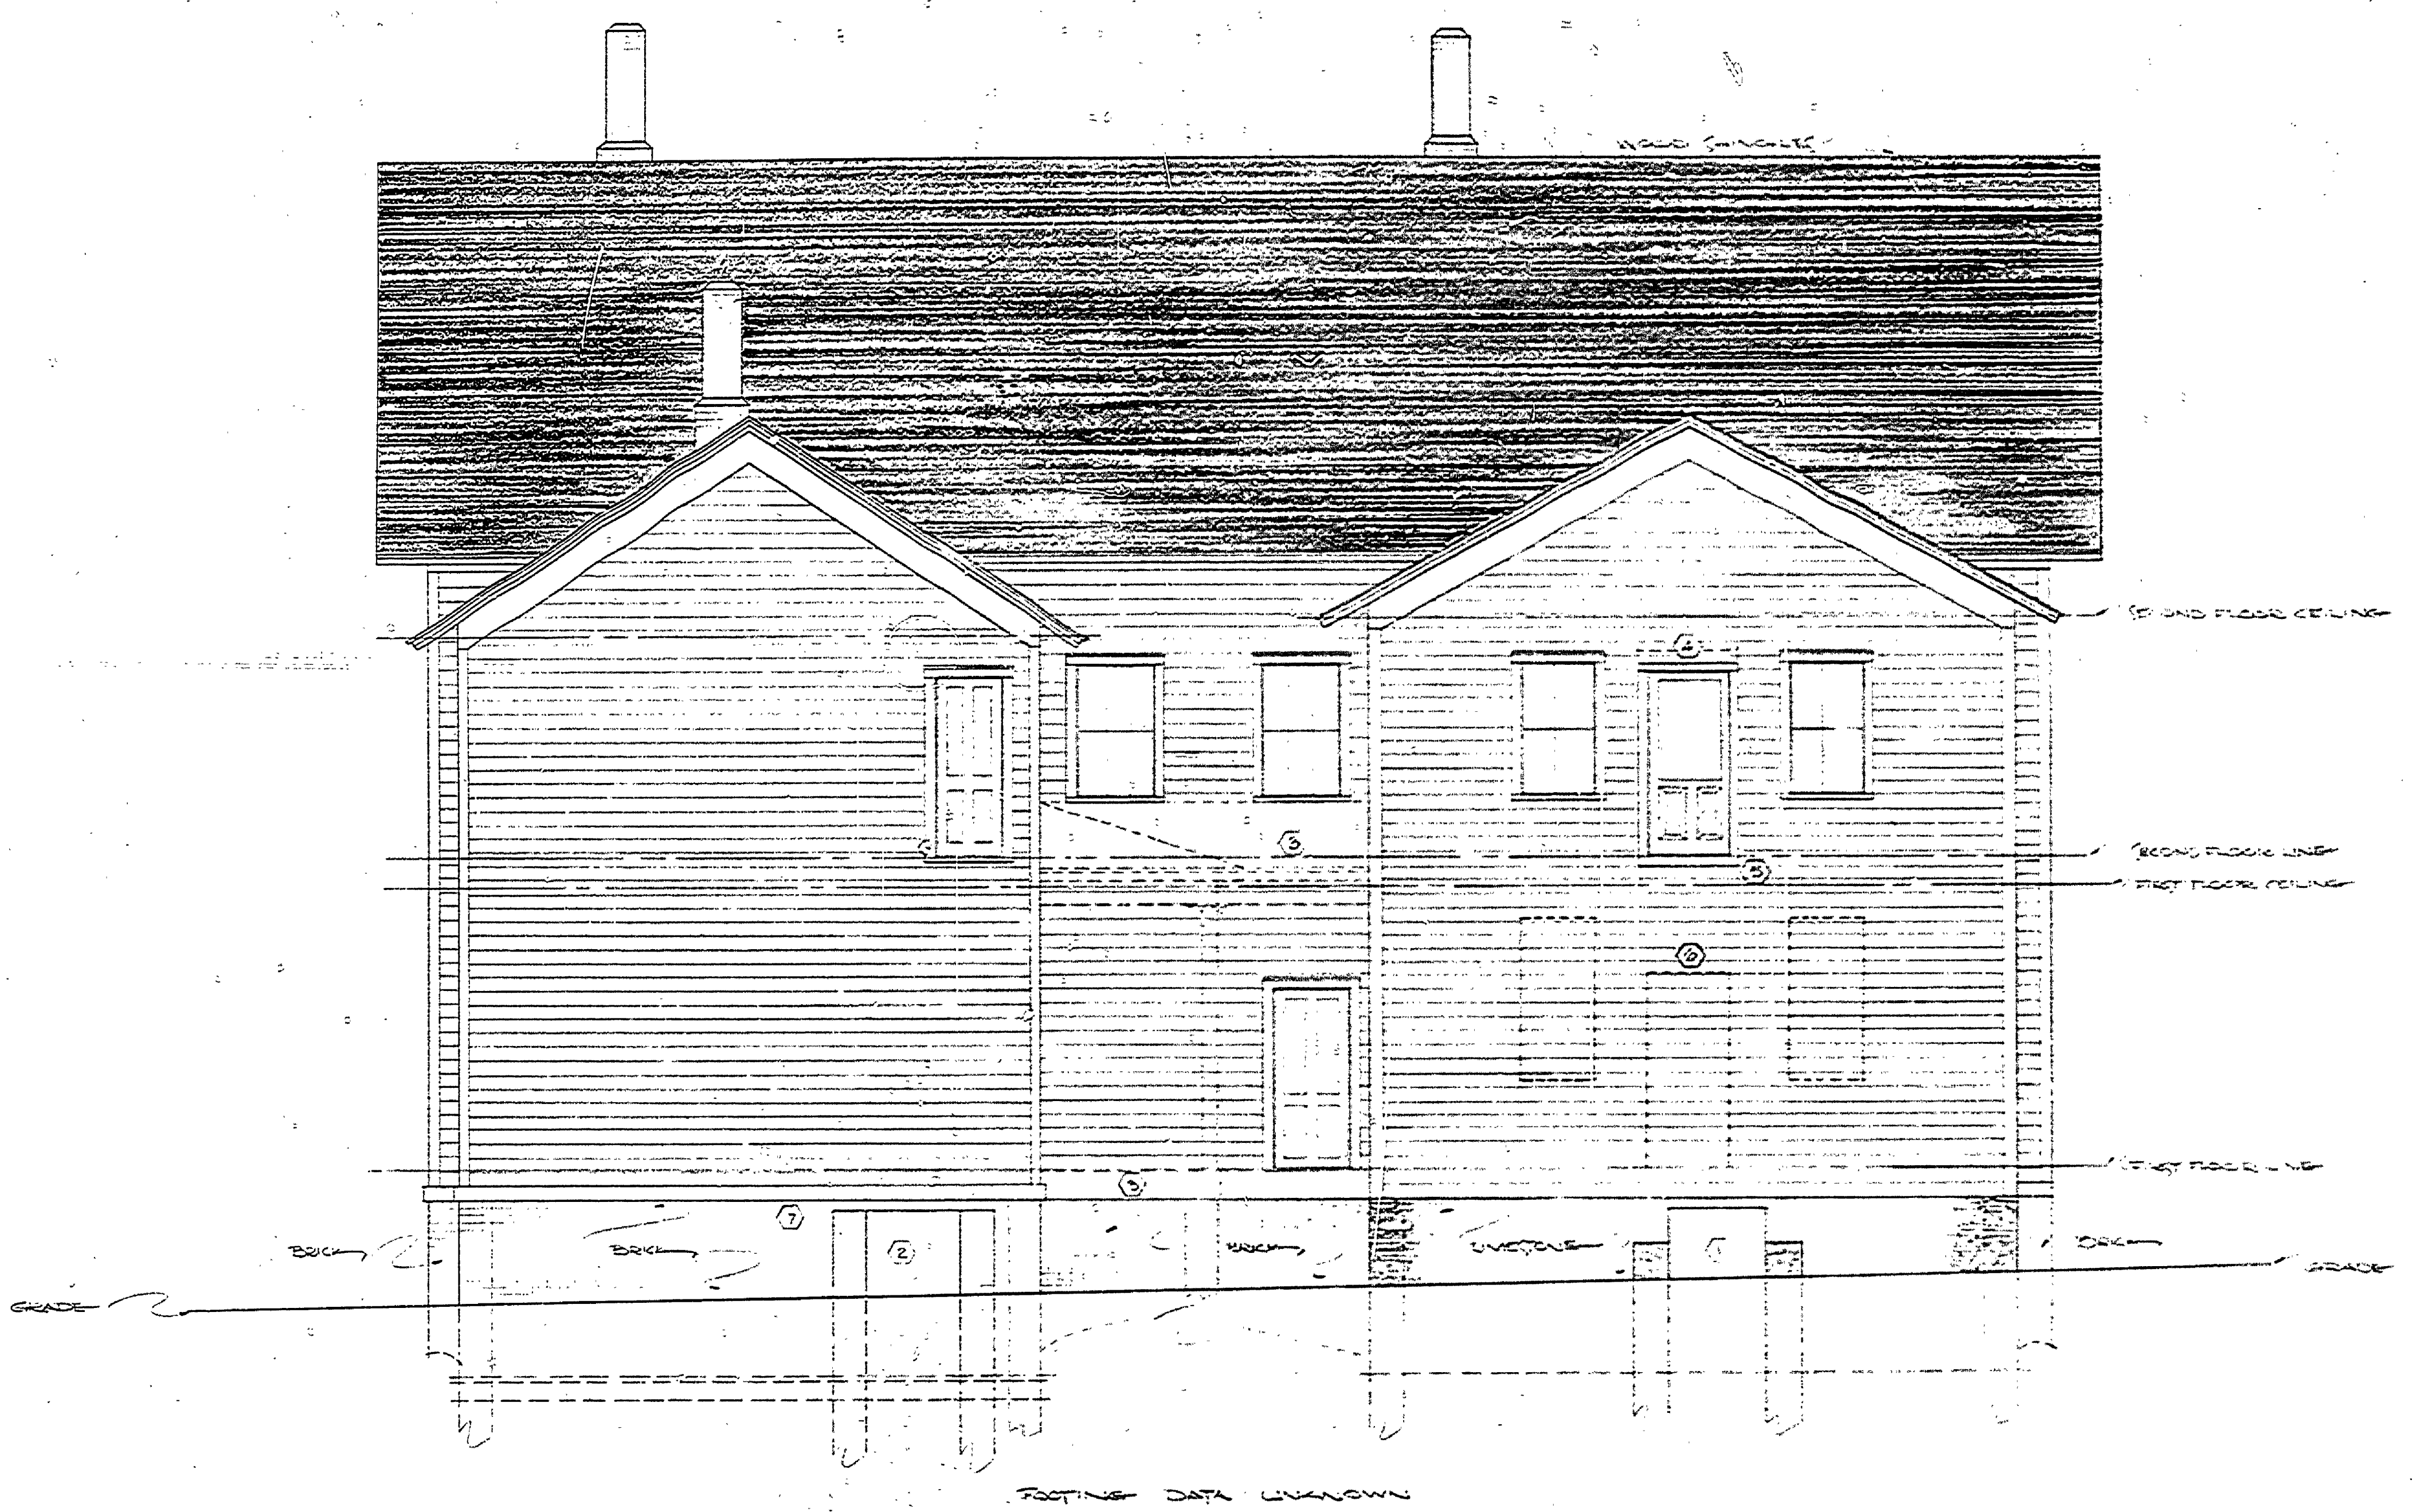

SOUTH ELEVATION  
SCALE 1/8" = 1'-0"

HOTEL SALOON - BUILDING #100

MICHIGAN  
DEPARTMENT OF CONSERVATION  
PARKS AND RECREATION DIVISION

MEASURED DRAWING  
FAYETTE HISTORICAL TOWNSHIP  
FAYETTE GATE

SHEET  
NO. 8  
OF 11

PLAN NO.  
A-100