



| DATE | REVIEWED      | DATE | APPROVED | DATE | NO. | DATE | BY | REVISIONS |
|------|---------------|------|----------|------|-----|------|----|-----------|
|      | ARCHITECTURAL |      |          |      | 1   |      |    | 4         |
|      | ENGINEERING   |      |          |      | 2   |      |    | 5         |
|      | LANDSCAPE     |      |          |      | 3   |      |    | 6         |



ORIGINAL LOCATION OF THIS UNIT NOT KNOWN, PRESENTLY FASTENED ON TOP OF BATHTUB.

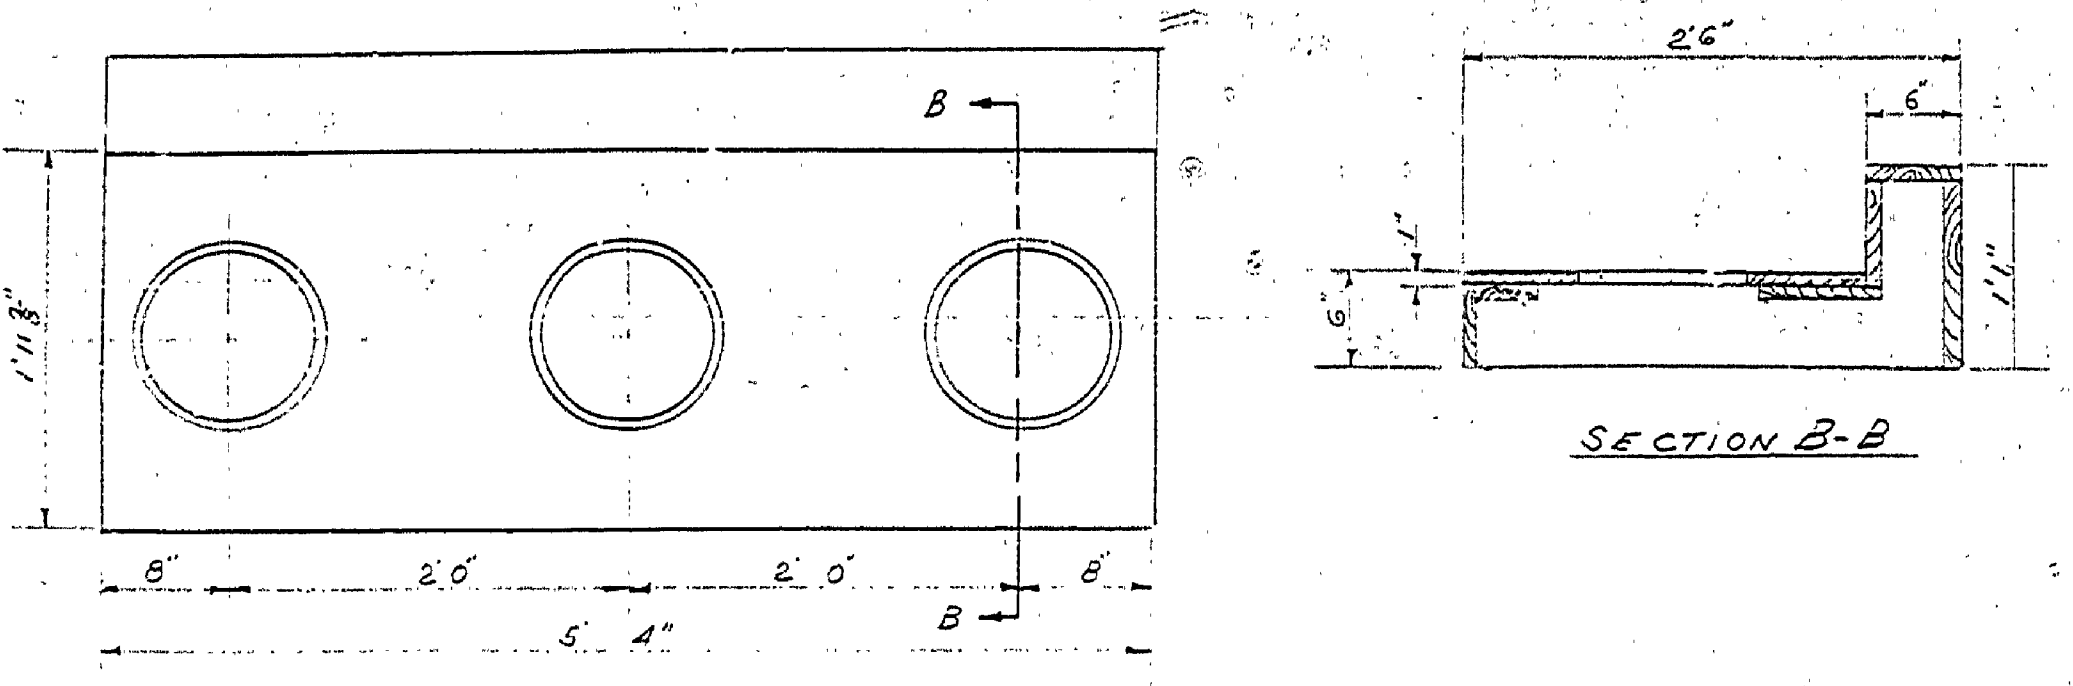


WASH STAND IN ROOM 210

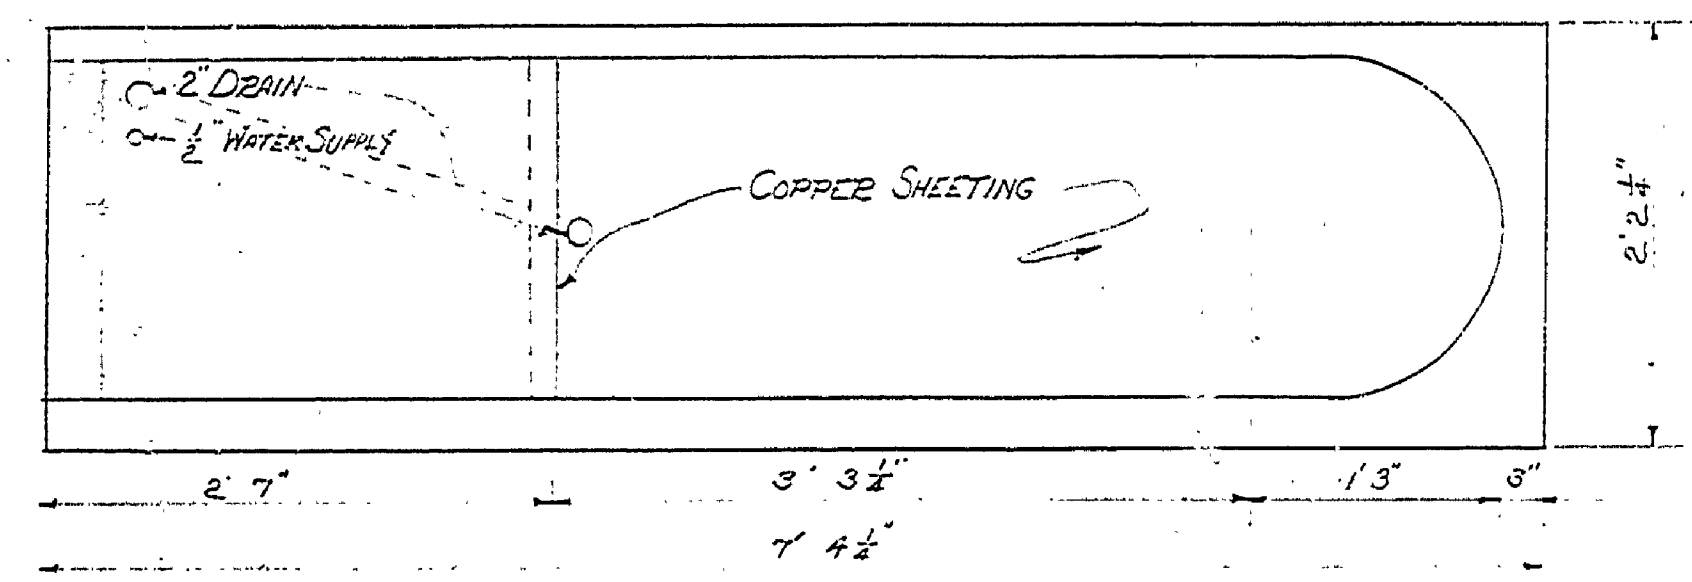


BATHTUB IN ROOM 210  
SCALE 1\"/>

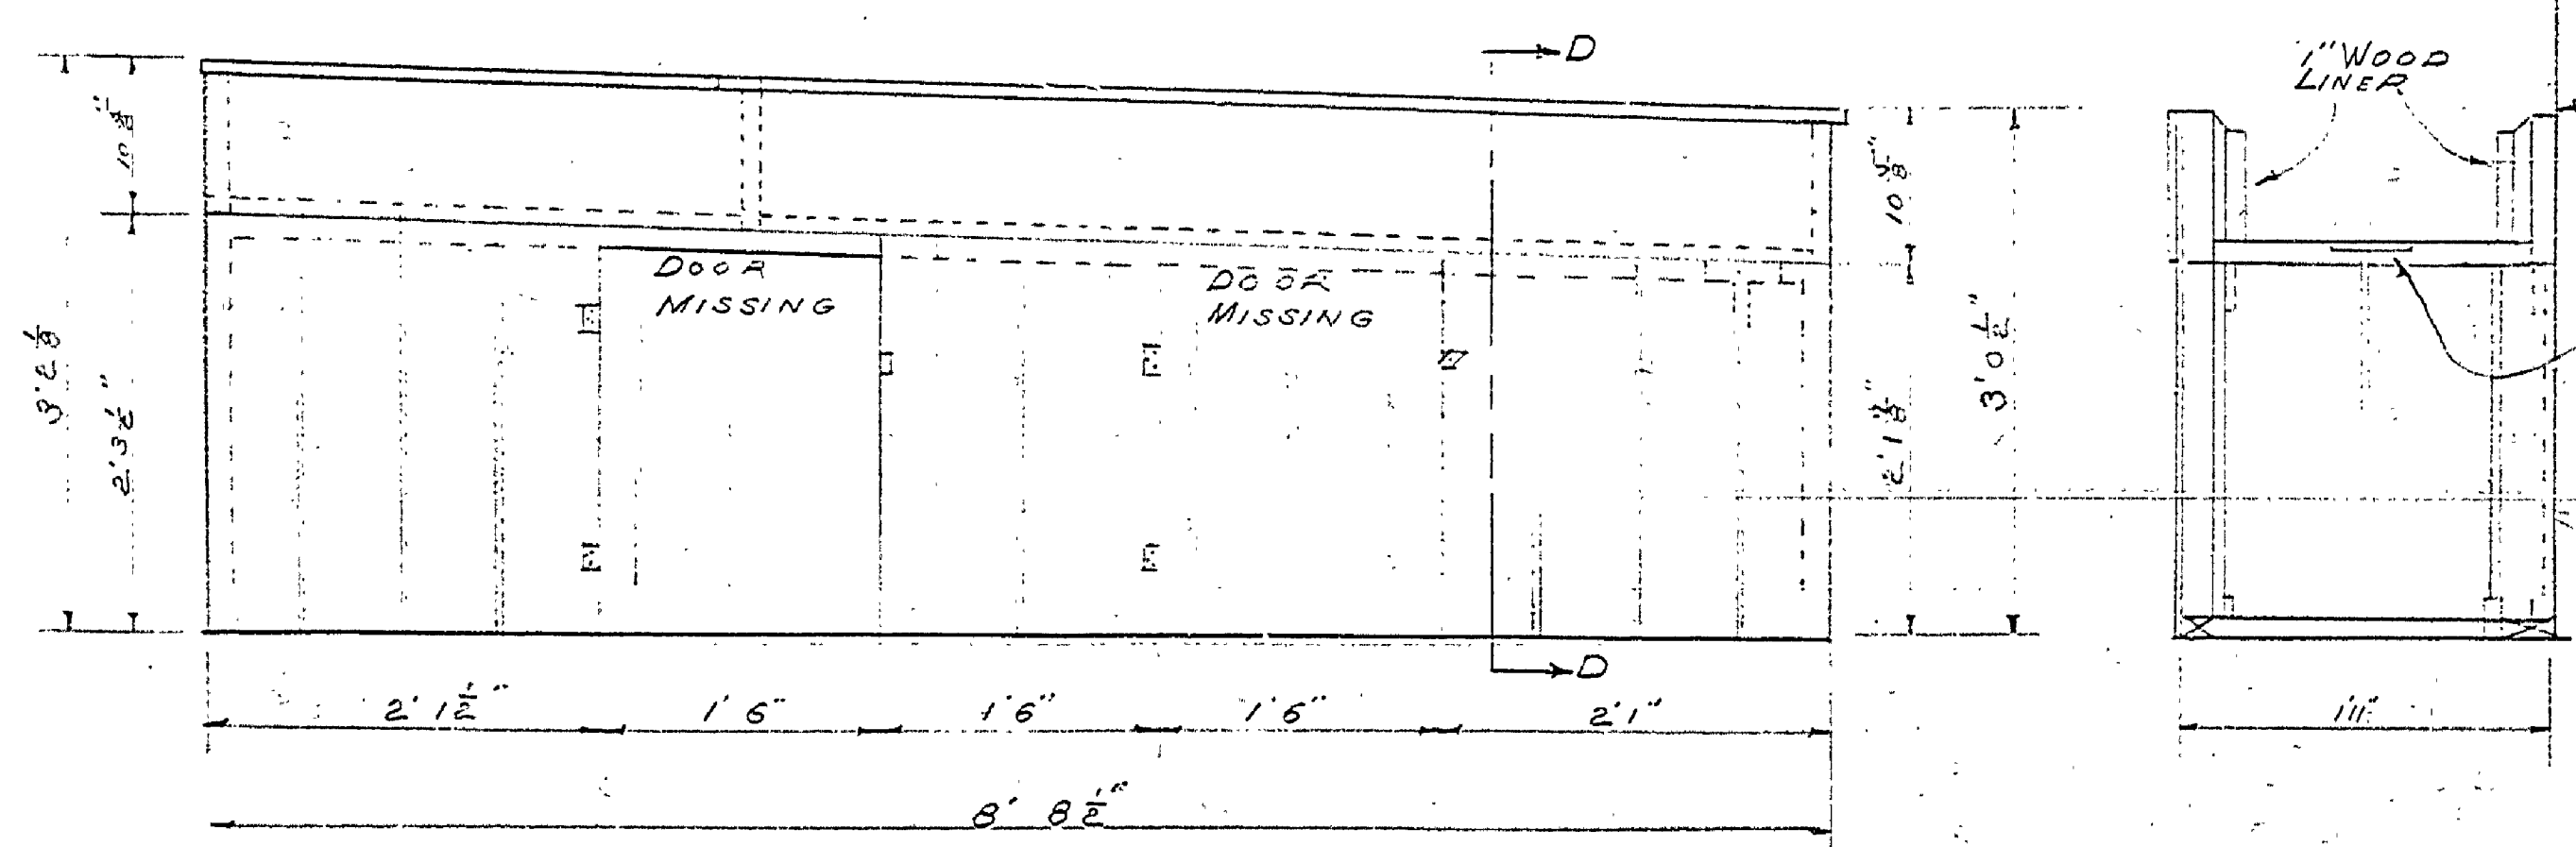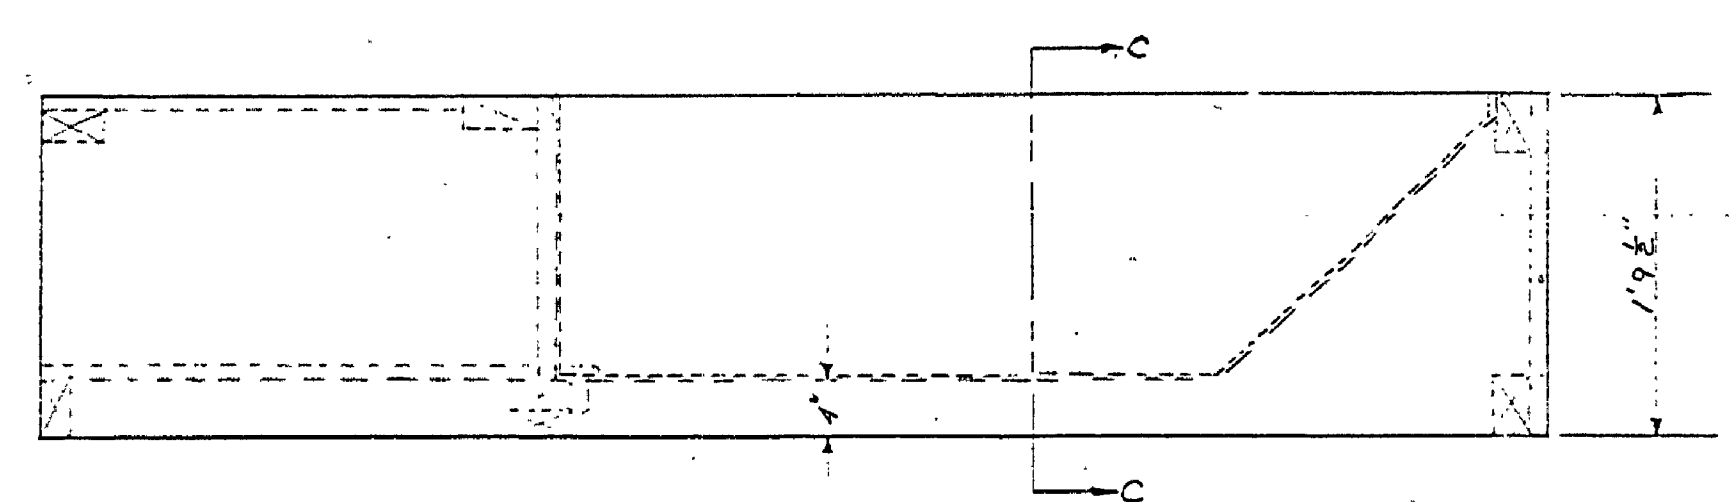



WOOD SINK IN ROOM 107  
SCALE 1\"/>

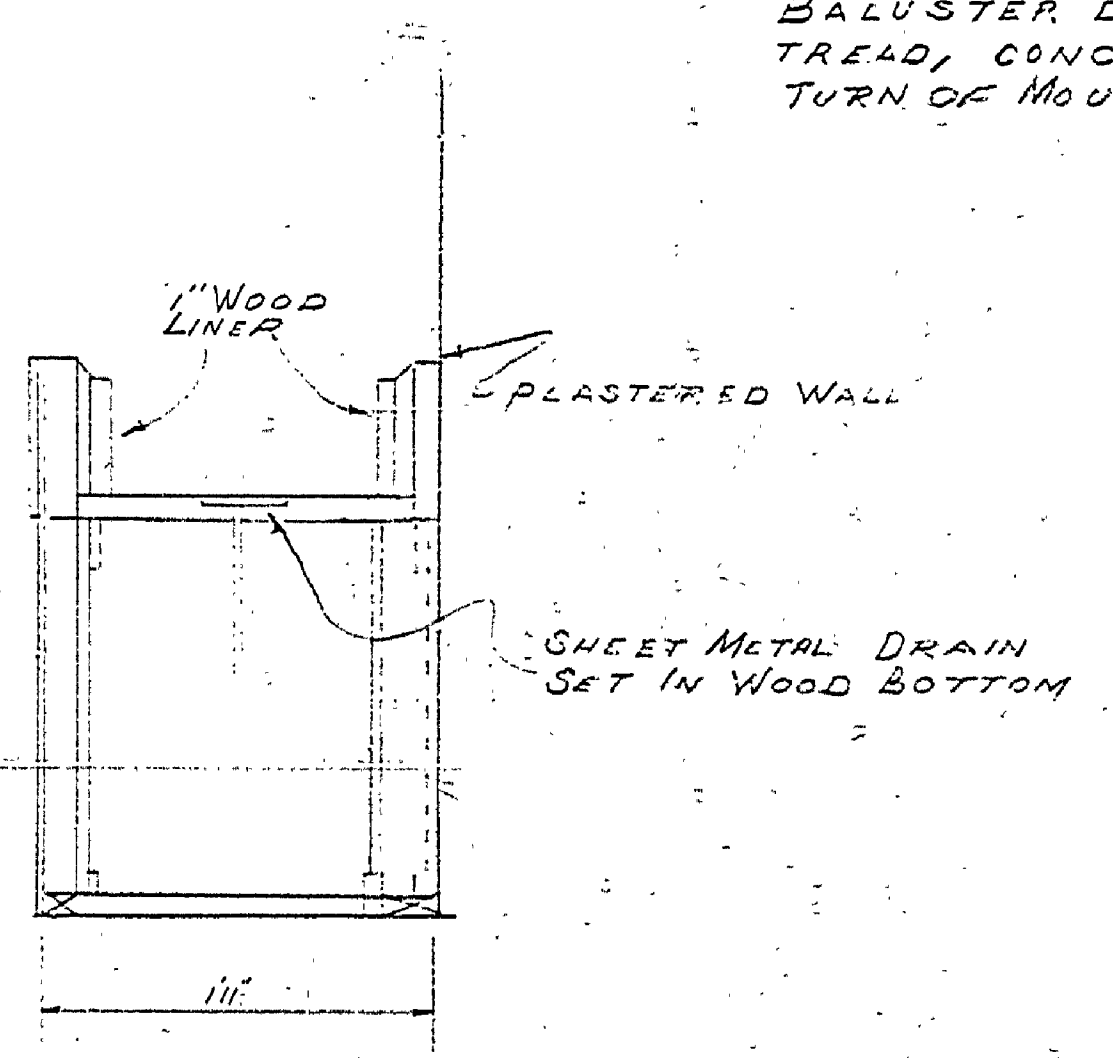


BALUSTER DOVETAILED INTO TREAD, CONCEALED BY RETURN OF MOULDING.

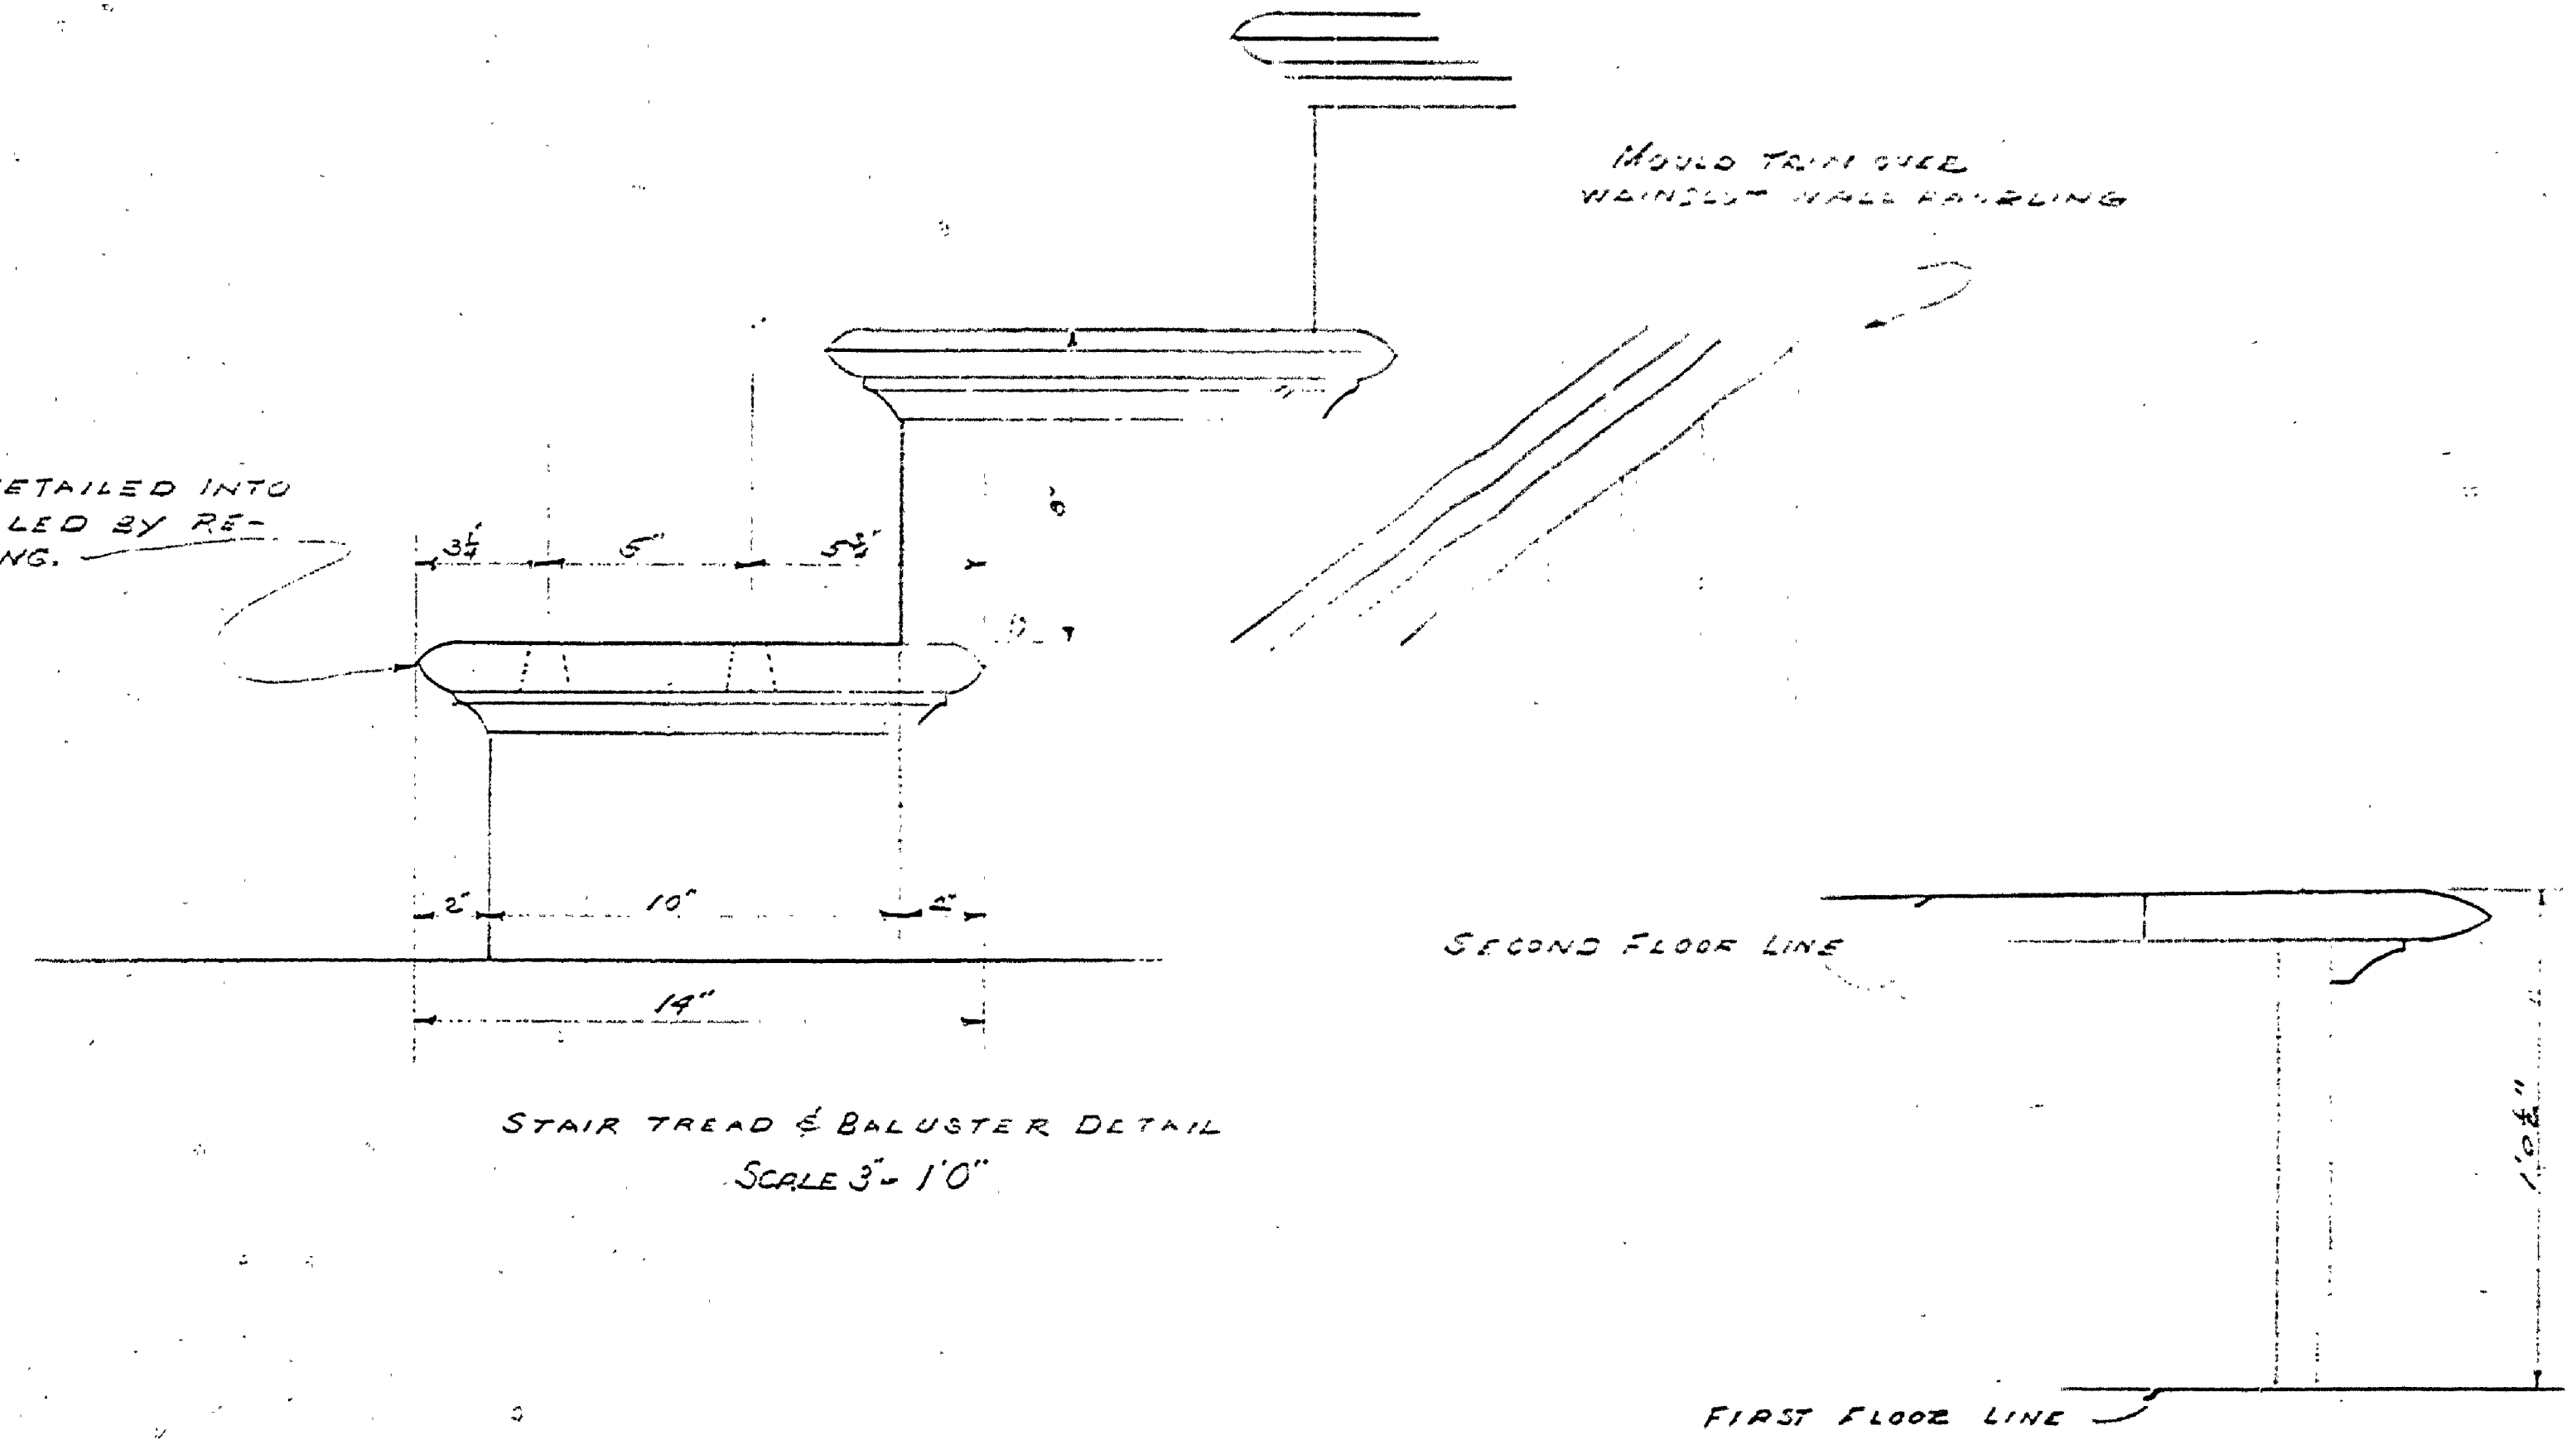

STAIR TREAD & BALUSTER DETAIL  
SCALE 3\"/>

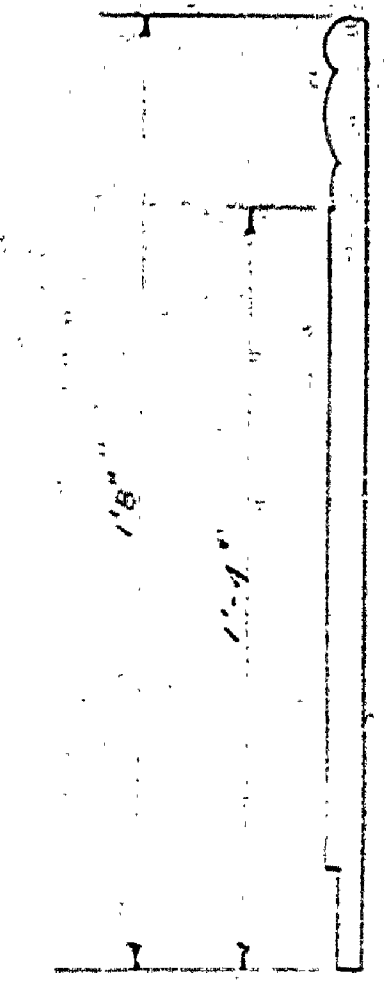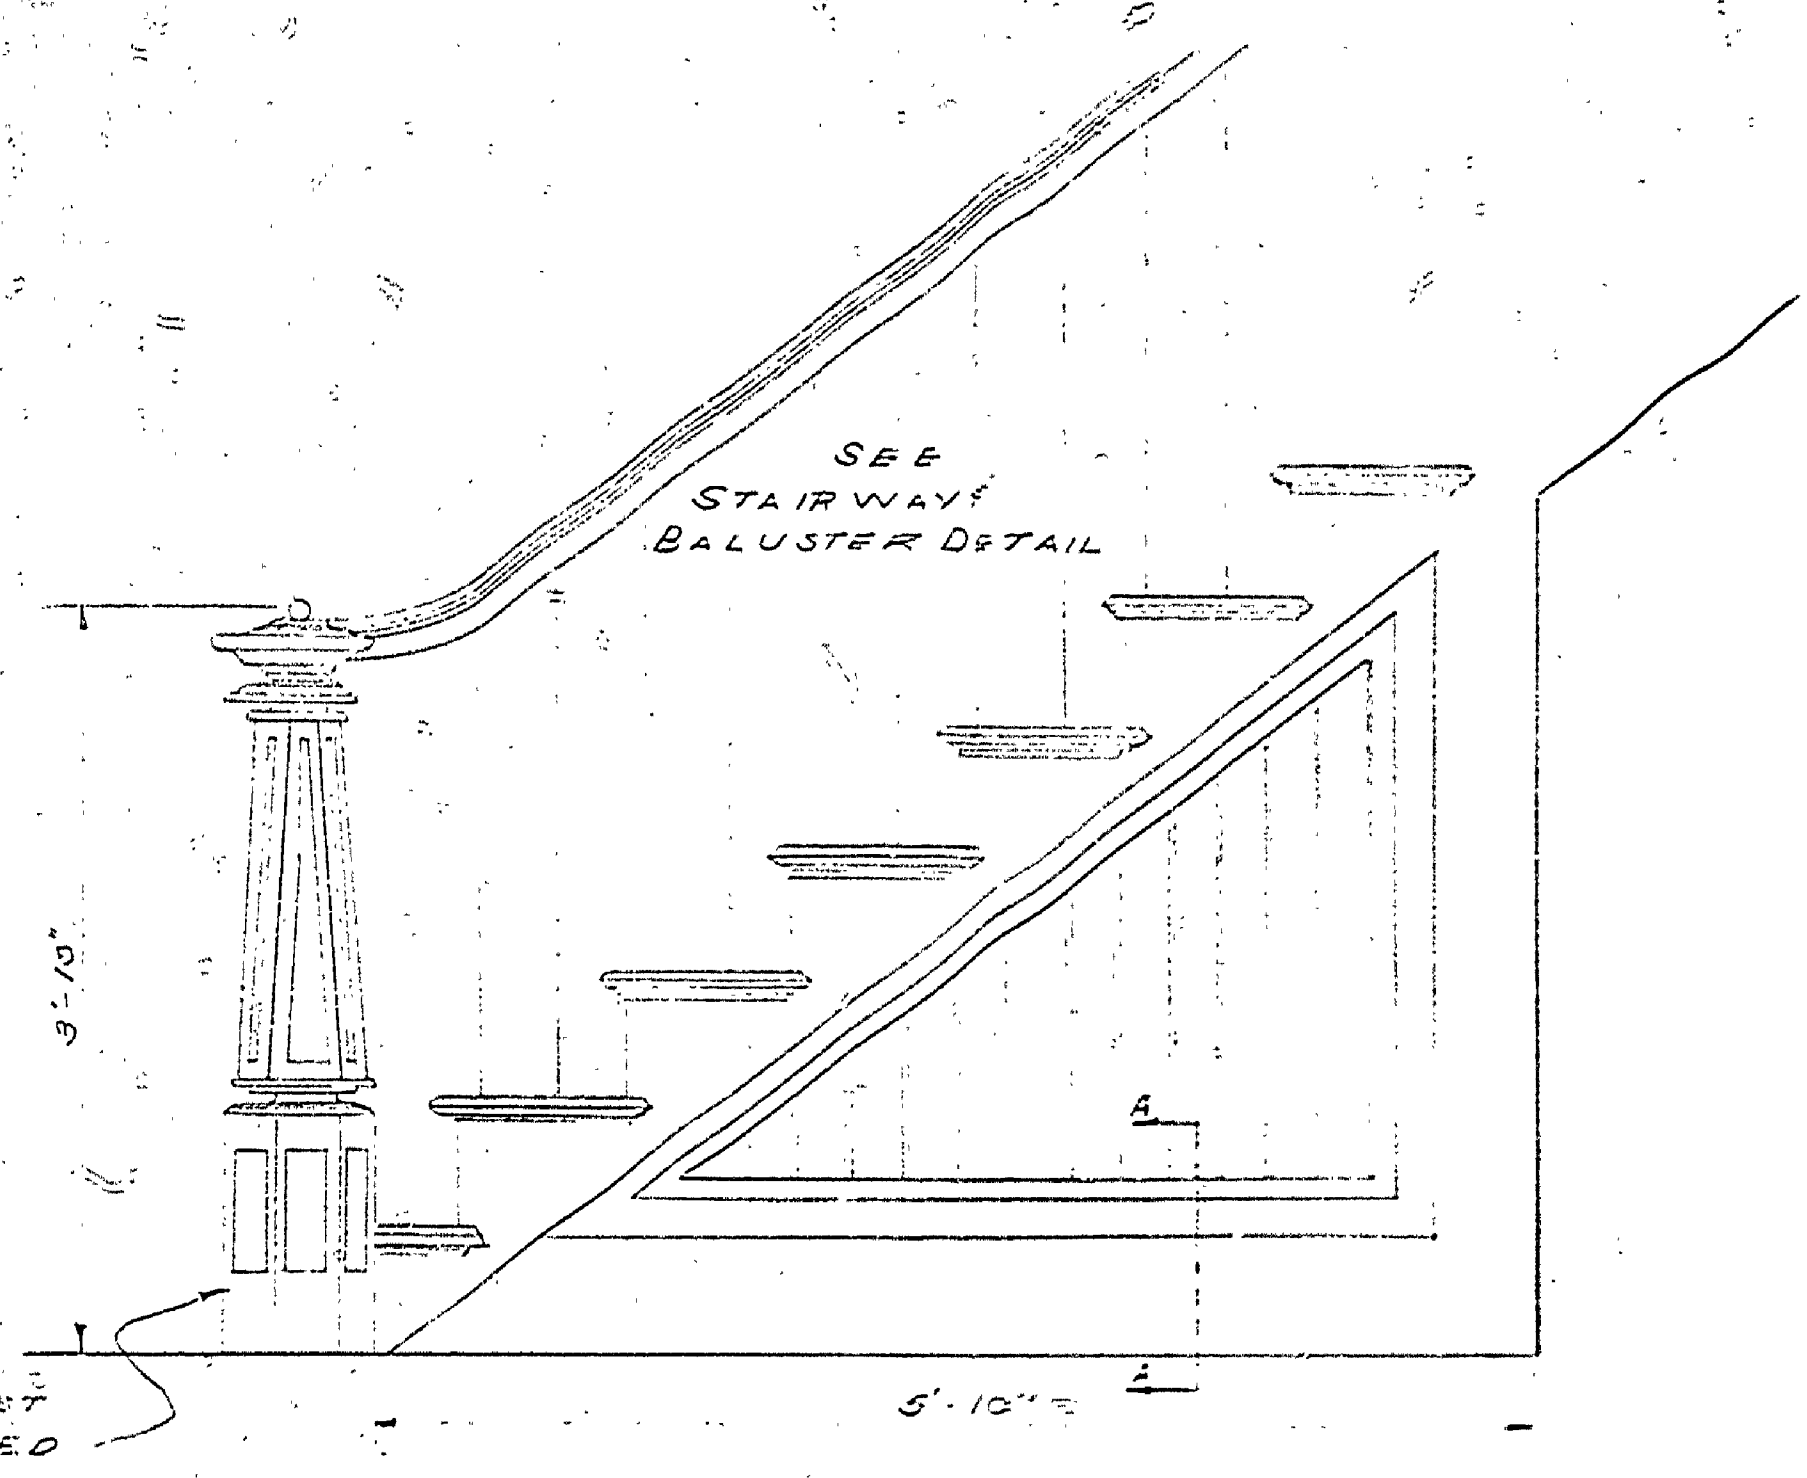

MOULD BOARD TRIM RUNNER  
SCALE 3\"/>

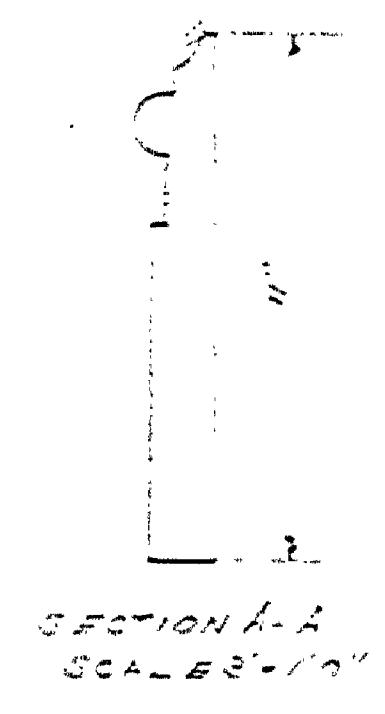

MOULD TRIM OVER WINDOW HALL BALDING