


DESIGNED BY	DATE	REVIEWED	DATE	APPROVED	DATE	NO.	DATE	BY	REVISIONS	DATE	BY
W.A.L.C.	1-12-61	ARCHITECTURAL	1-12-61		1	1			4		
W.A.L.C.		ENGINEERING	4-24-61		2	2			5		
W.A.L.C.		LANDSCAPE	4-24-61		3	3	5-22-61		6		

WINDOW SCHEDULE						DOOR SCHEDULE						ROOM FINISH SCHEDULE					
M/K NO.	TYPE	SIZE	SASH	GLASS	REMARKS	M/K	SIZE	TYPE	GLASS	TRANS.	HARDWARE	REMARKS	RM. NO.	FLOOR	WALL	CIL. WARK.	TRIM
A	D.L.	2'-4" X 7'-12"	2'-4" X 7'-7"	8' X 20'	COUNTER BAL.	Z01	2'-8" X						Z01				
B	D.L.	2'-9 3/4" X			COUNTER BAL.	Z02	2'-1 1/2" X						Z02				
						Z03	2'-1 1/4" X						Z03				

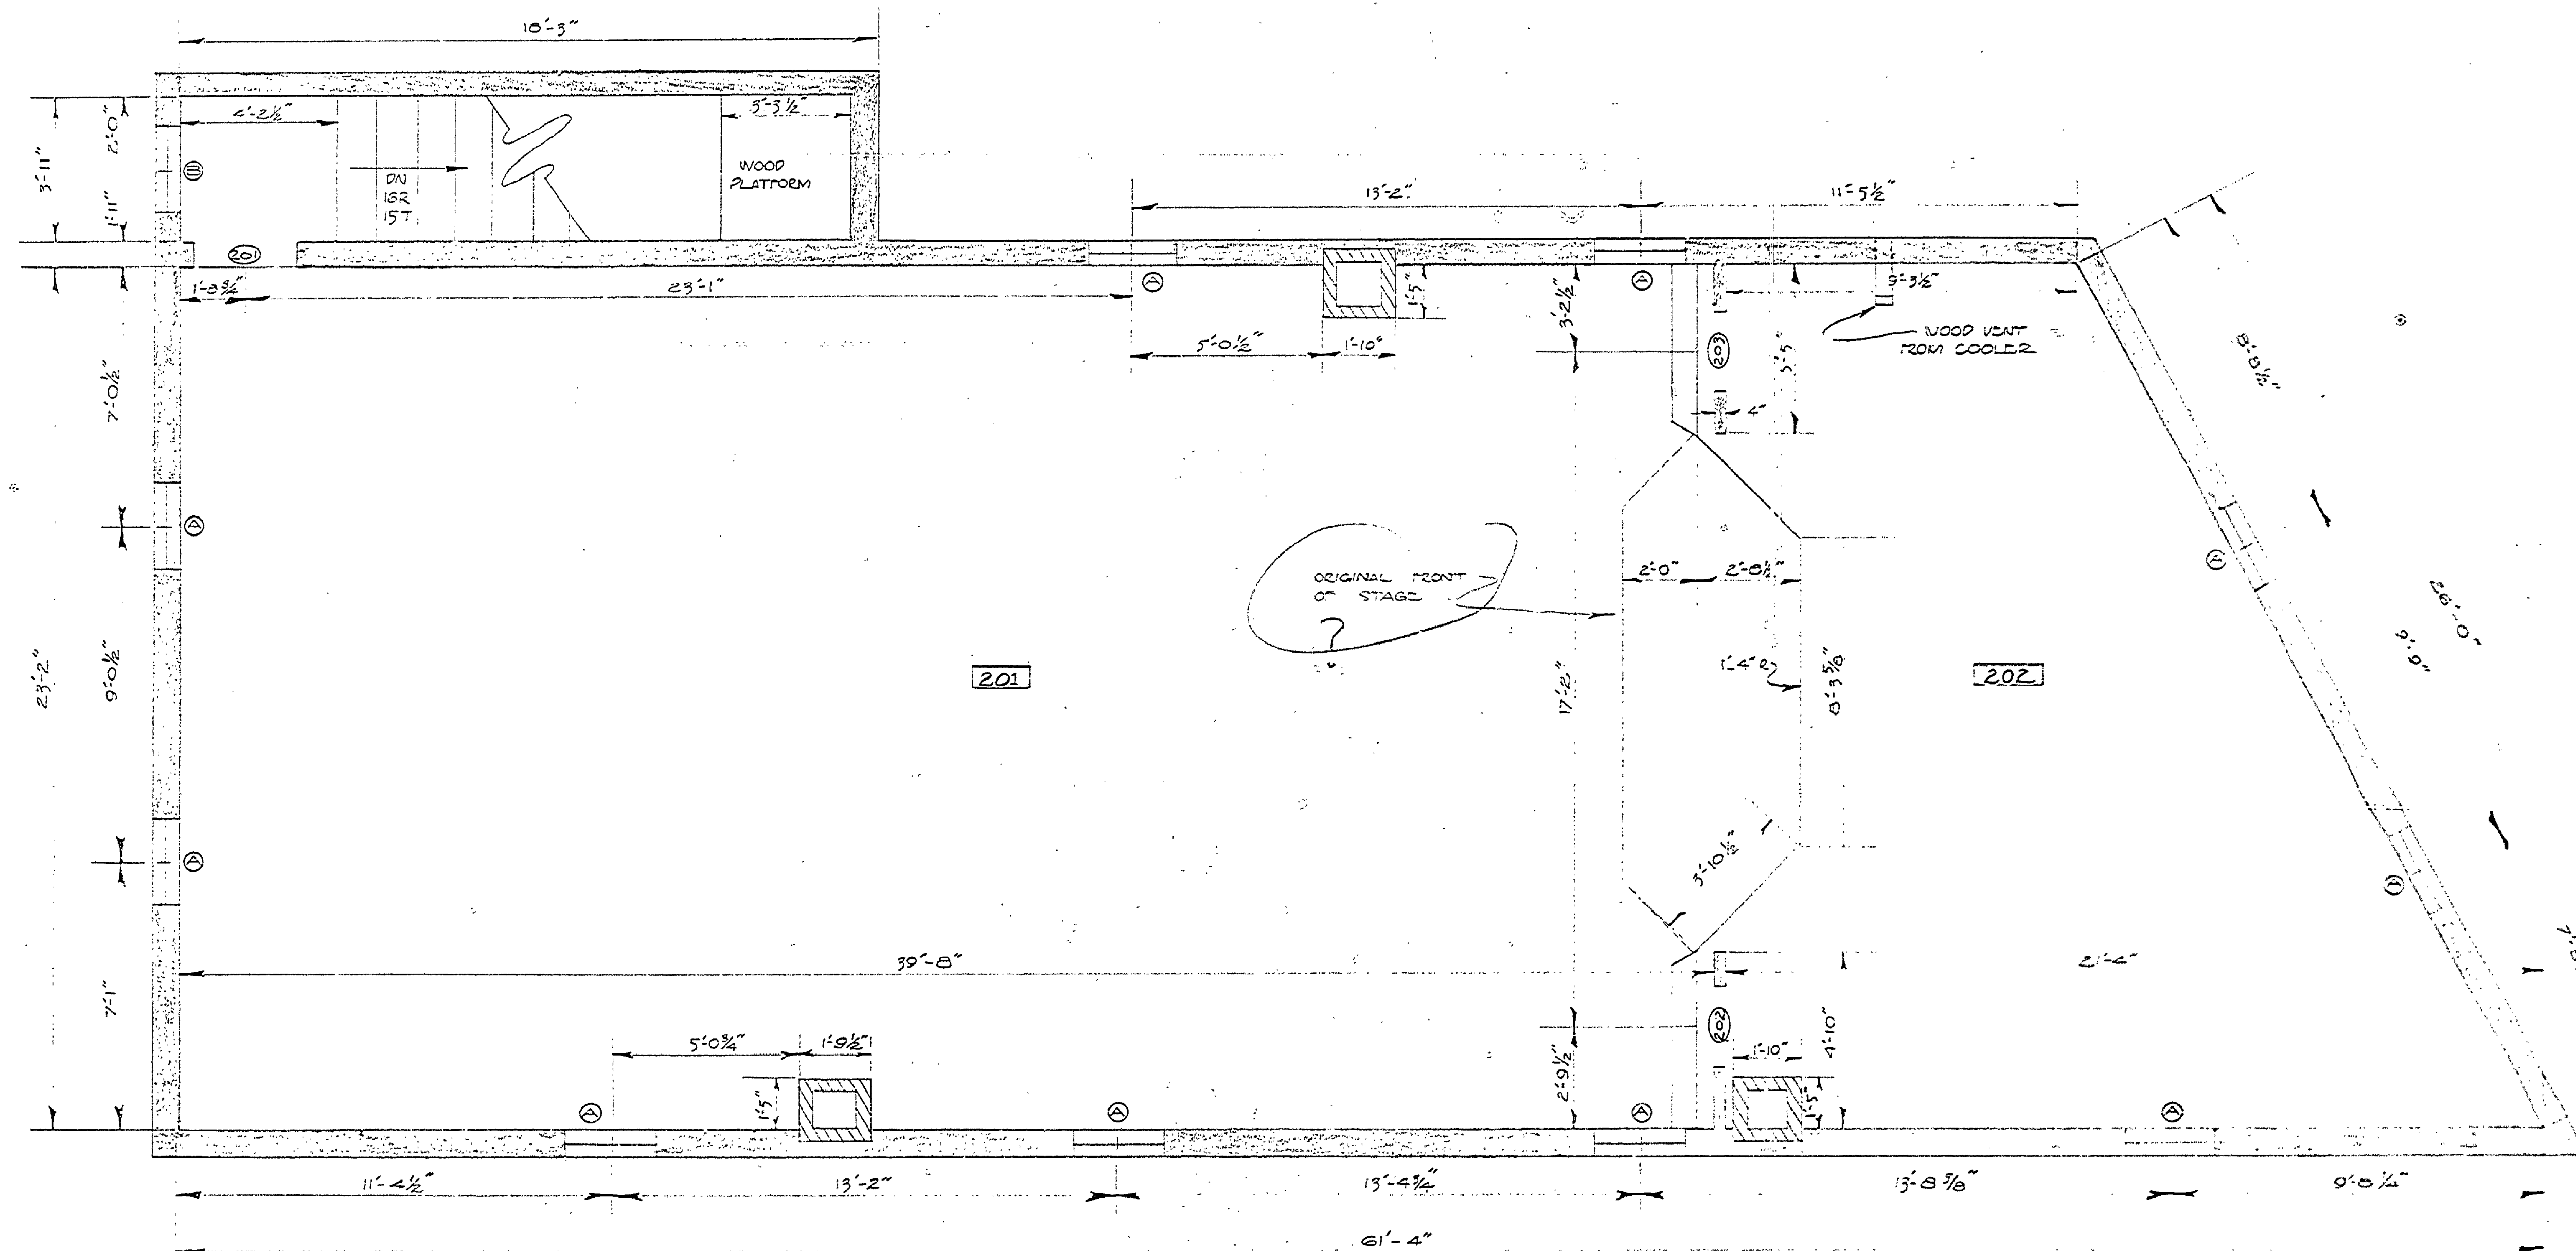

SECOND FLOOR PLAN
SCALE 3/8" = 1'

MICHIGAN
DEPARTMENT OF CONSERVATION
PARKS AND RECREATION DIVISION

MEASURED DRAWING
CIVIL ENGINEER
STATE HISTORICAL MONUMENT
BUILDING NO. 101

SHEET
NO. 3
OF 8

PLAN NO.
A-101