


DESIGNED BY	REVIEWED	DATE	APPROVED	DATE	NO.	DATE	BY
DRAWN BY	ARCHITECTURAL	7-7-77			1		
CHECKED BY	ENGINEERING				2		
	LANDSCAPE				3		
					4		
					5		
					6		

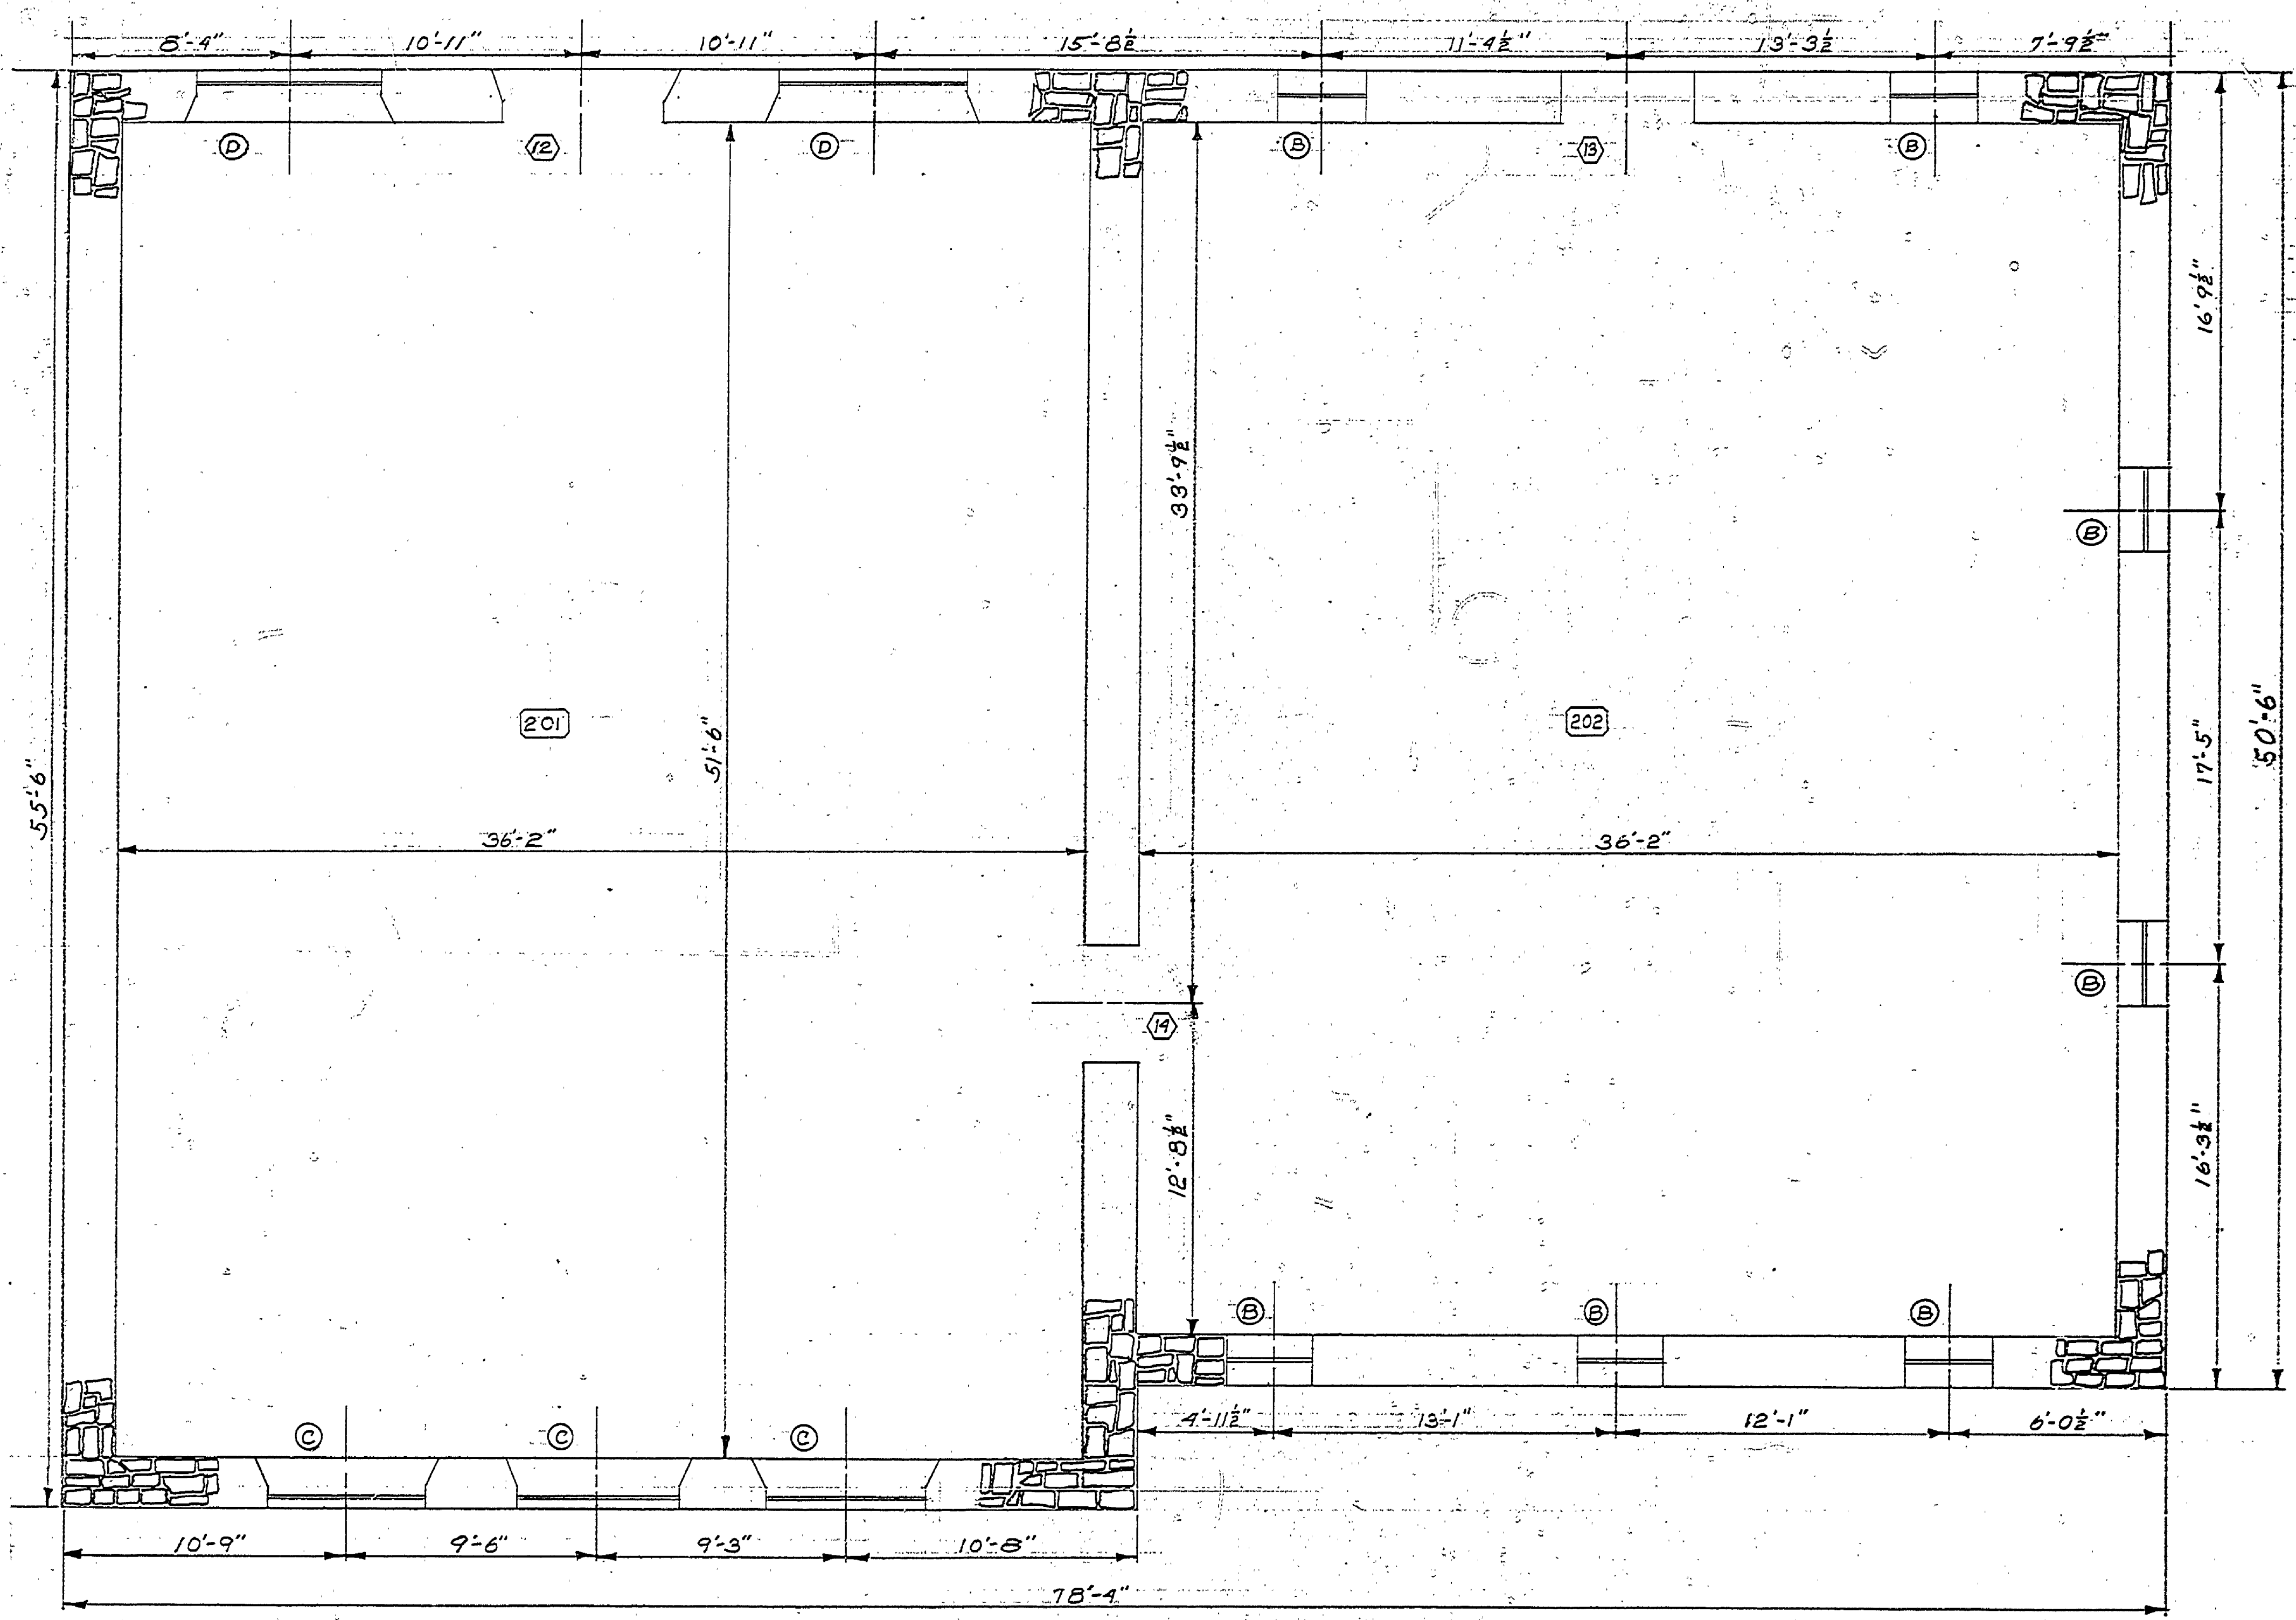

DIMENSION OF DOOR CASEMENT	
12-	6'-0" x 10'-8"
13-	5'-0" x 6'-0"
14-	4'-6" x 6'-0"
DIMENSION OF WINDOW CASEMENT	
B-	3'-3" x 7'-8"
C-	7'-0" x 9'-2"
D-	2'-0" x 9'-2"

FIRST FLOOR PLAN

SCALE - 1/4" = 1'-0"

MICHIGAN
DEPARTMENT OF CONSERVATION
PARKS AND RECREATION DIVISION

MEASURED DRAWING
FAYETTE HISTORICAL TOWNSITE
FAYETTE STATE PARK

SHEET NO. 2 OF 5
PLAN NO. A-10-2