


DATE	DESIGNED BY	DRAWN BY	CHECKED BY	REVIEWED	DATE	APPROVED	DATE	NO.	DATE	BY	REVISIONS
					4-25		1-7-01	1			4
								2			5
								3			6

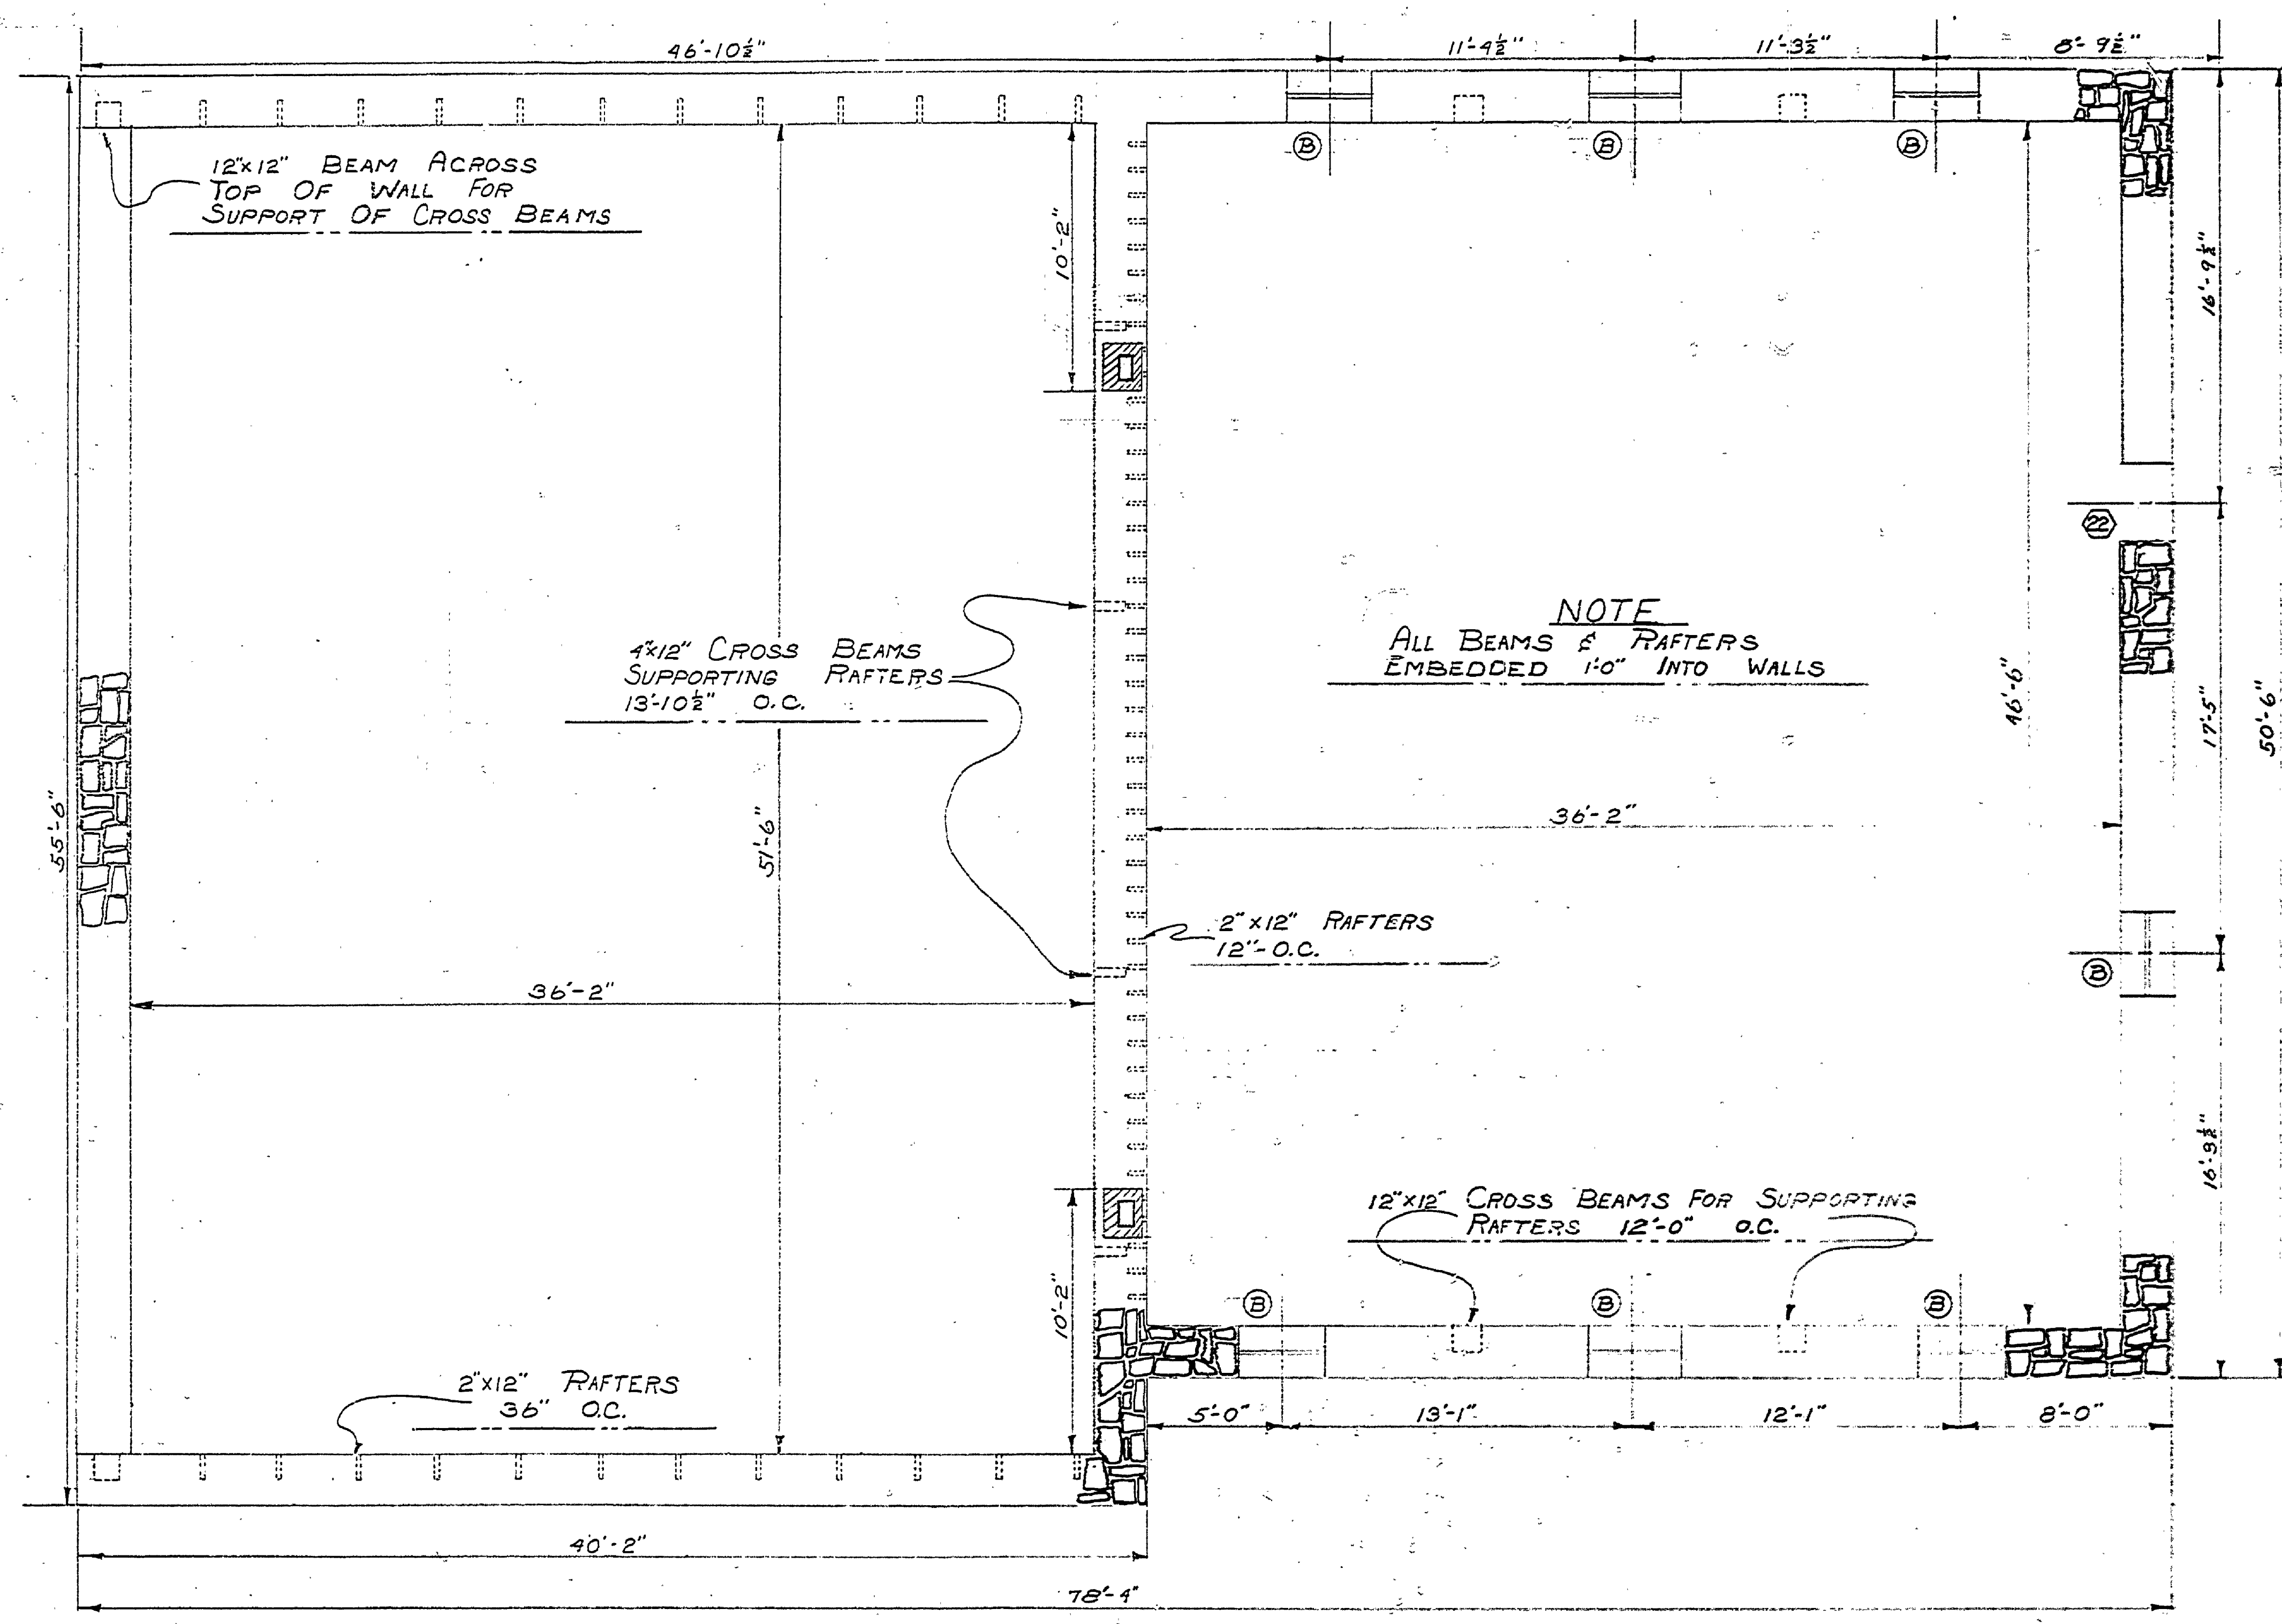

DIMENSION OF DOOR CASEMENT
22- 3'-0" x 6'-8"
DIMENSION OF WINDOW CASEMENT
3'-3" x 7'-8"

**NOTE**  
ALL BEAMS & RAFTERS  
EMBEDDED 1'-0" INTO WALLS

SECOND FLOOR & ROOF PLAN

SCALE -  $\frac{1}{4} = 1'-0"$

MICHIGAN  
DEPARTMENT OF CONSERVATION  
PARKS AND RECREATION DIVISION

MEASURED  
FRYETTE  
DRAWING  
HISTORICAL DRAWING  
FRYETTE  
STATE PARK

SHEET NO. 3 OF 5  
PLAN NO. A-102