



DATE	DESIGNED BY	REVIEWED	DATE	APPROVED	DATE	NO.	DATE	BY
			7-7-47			1		
						2		
						3		

REVISIONS	DATE	BY
4		
5		
6		


DATE	DESIGNED BY	REVIEWED	DATE	APPROVED	DATE	NO.	DATE	BY
						1		
						2		
						3		

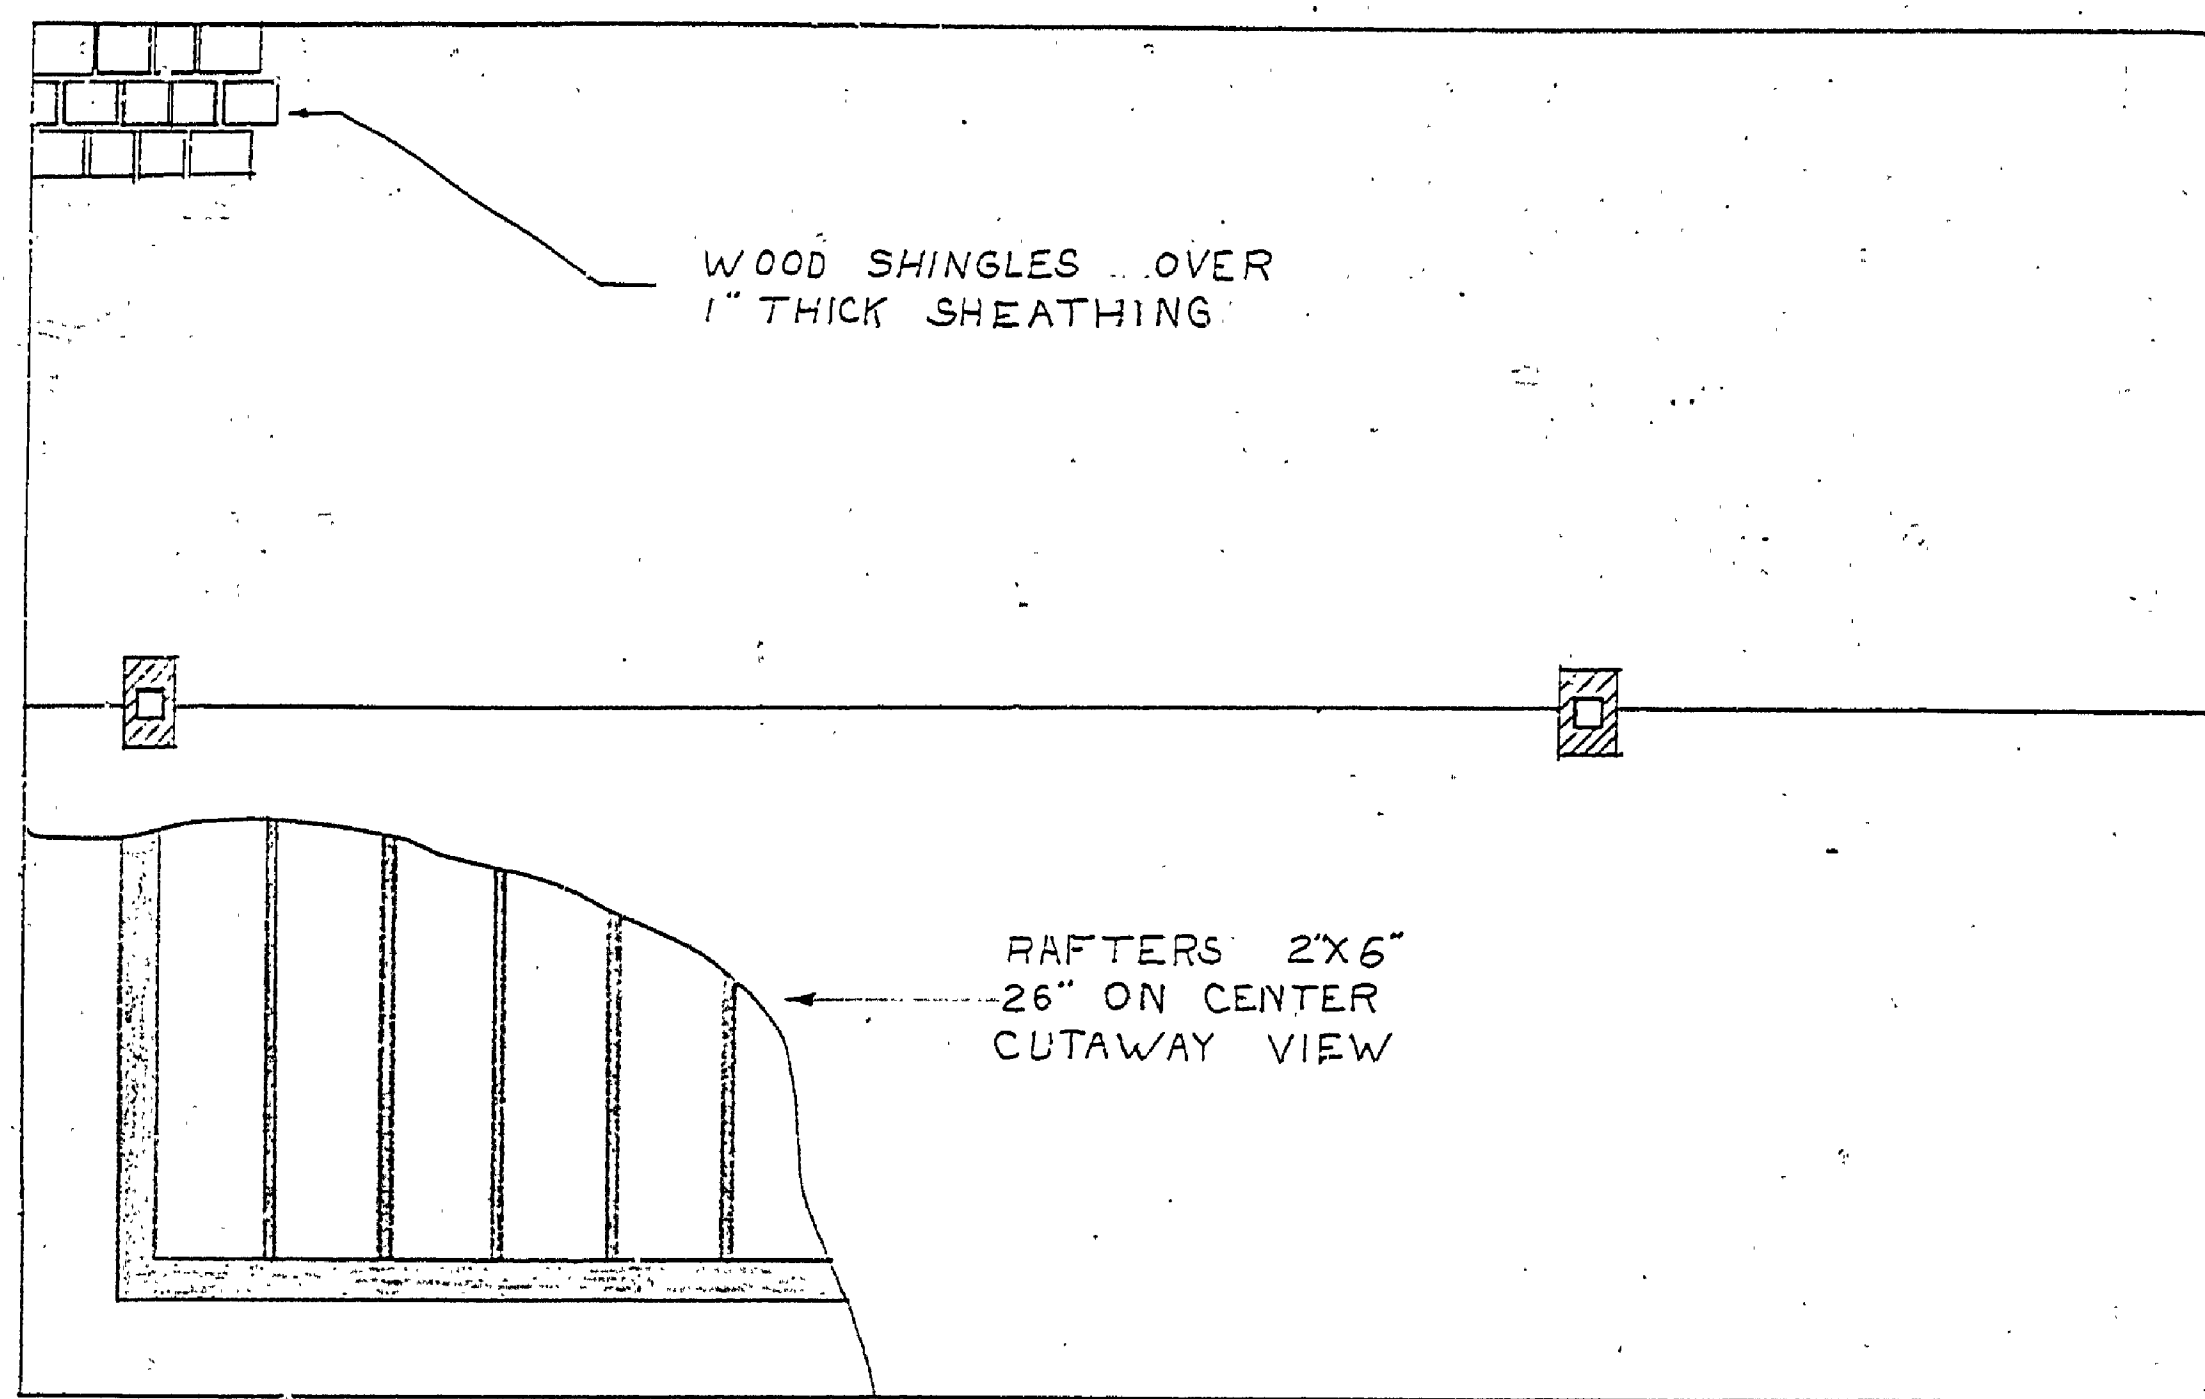

ATTIC & ROOF PLAN

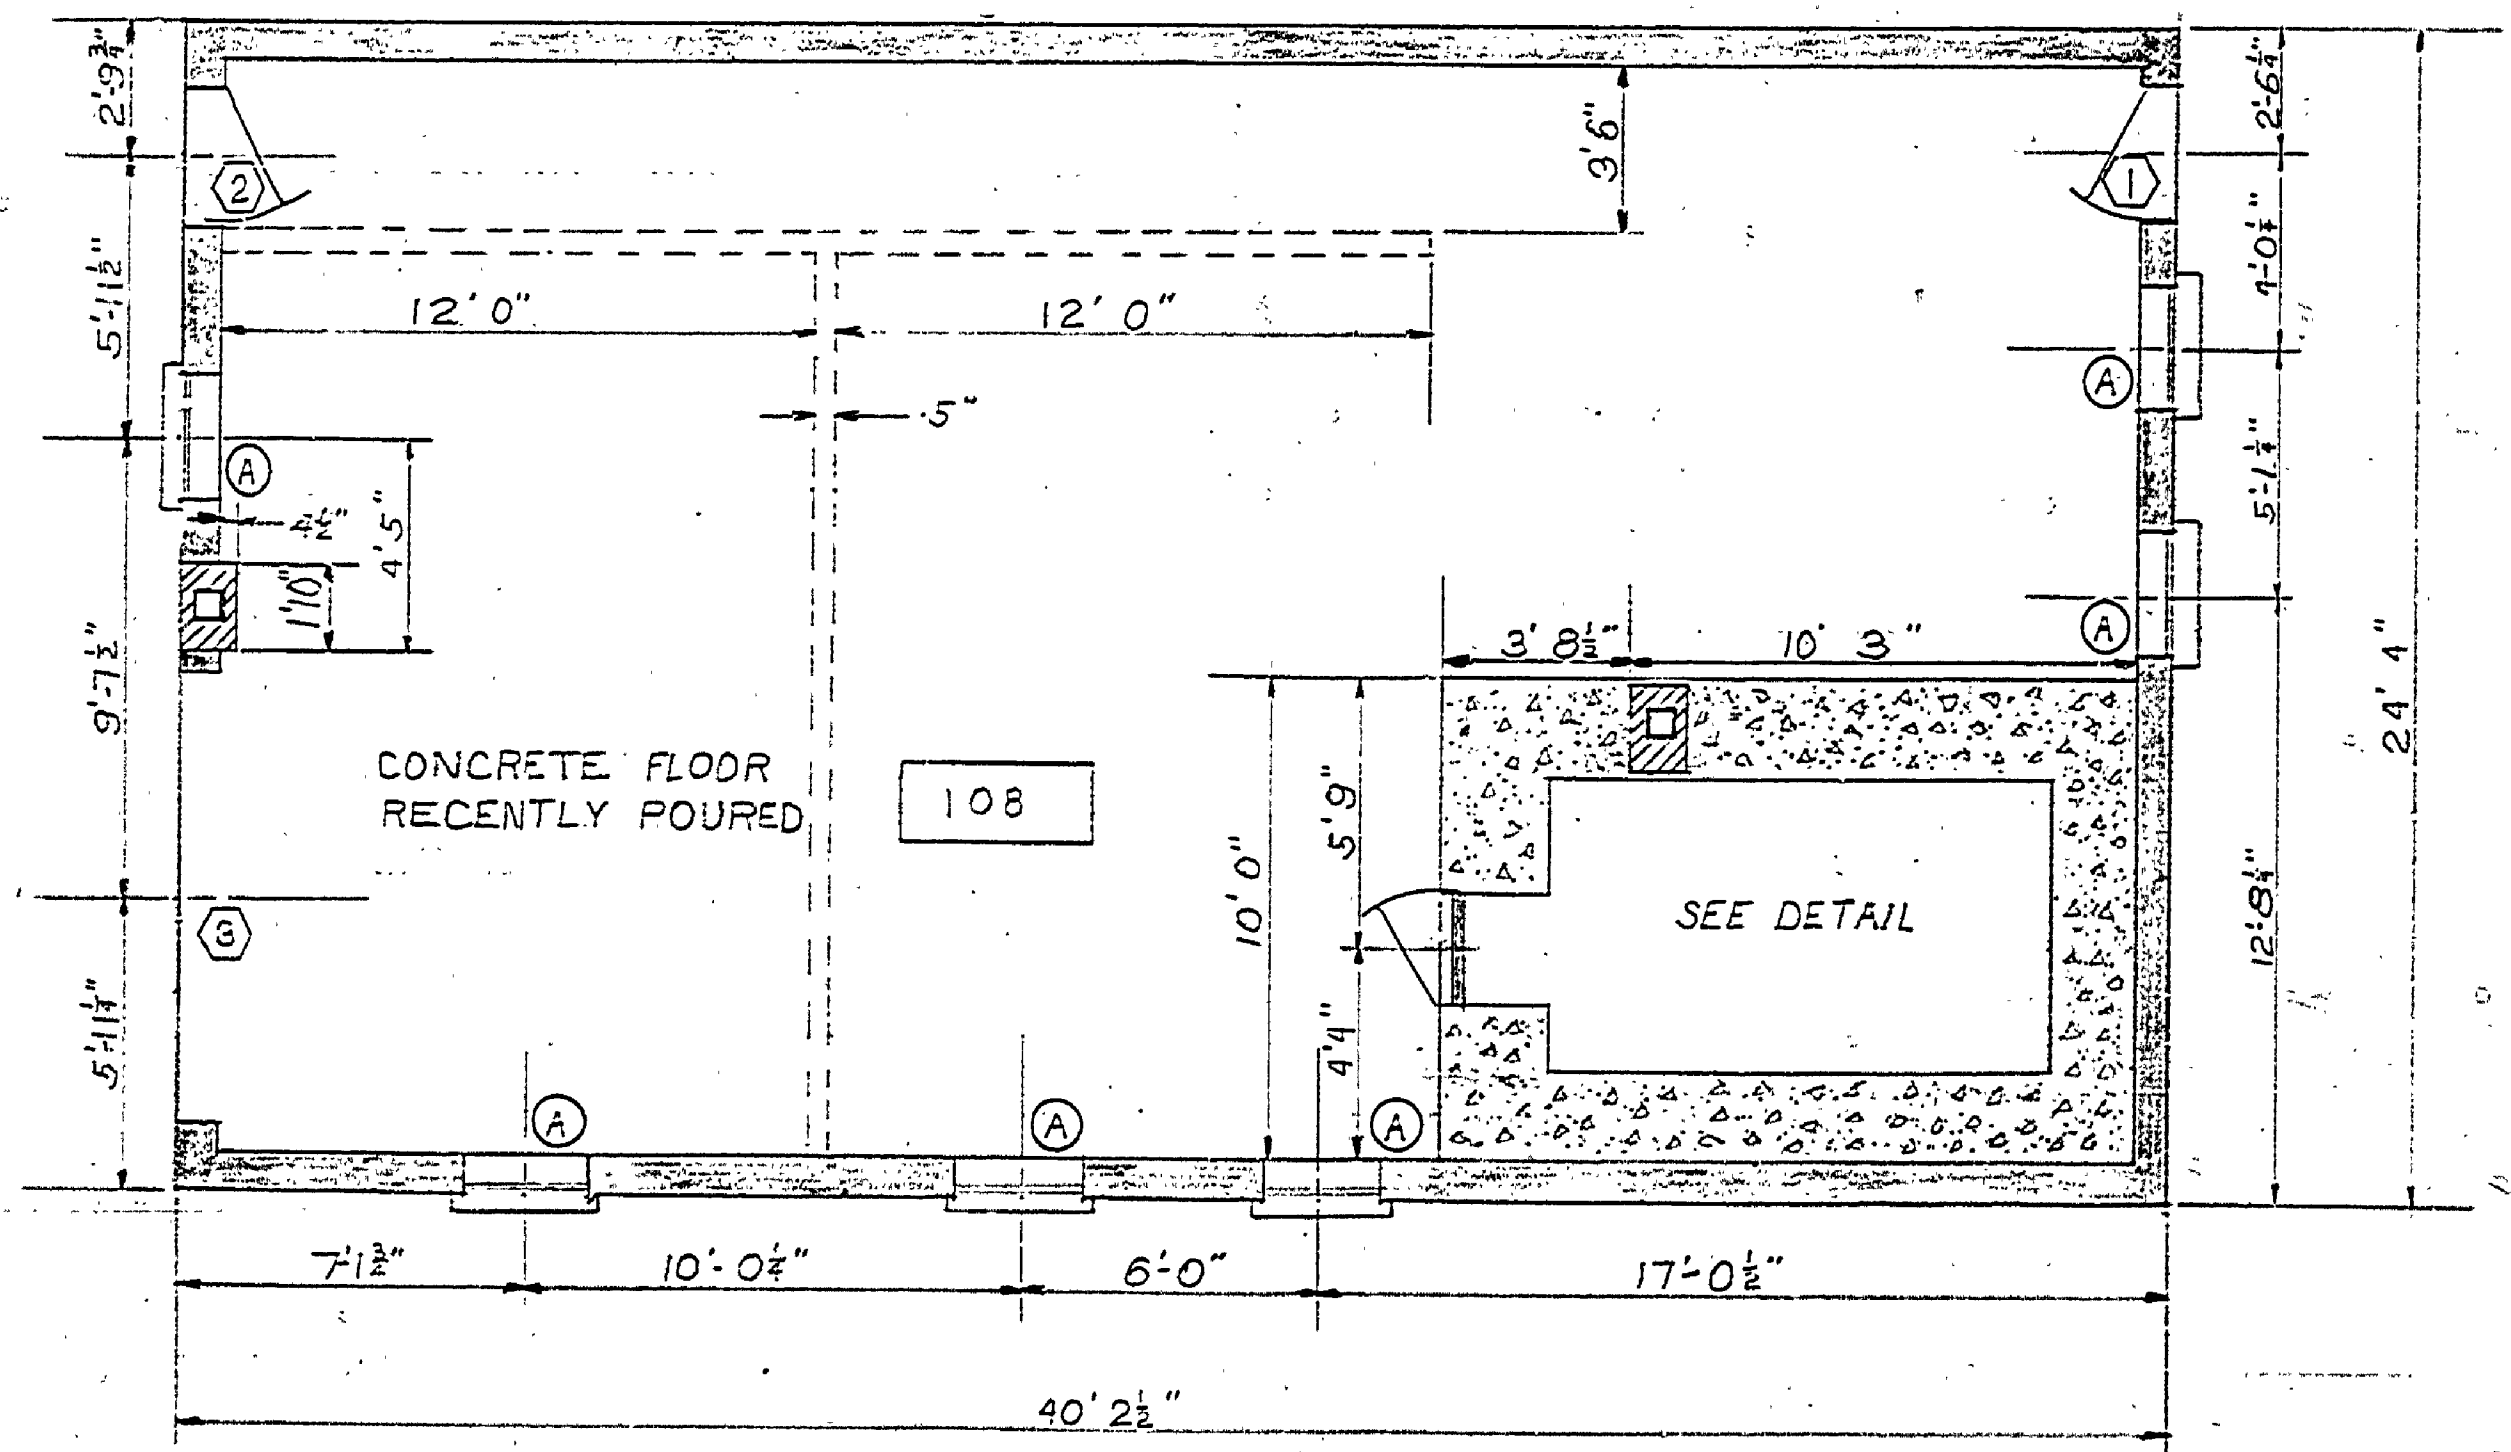

FIRST FLOOR PLAN

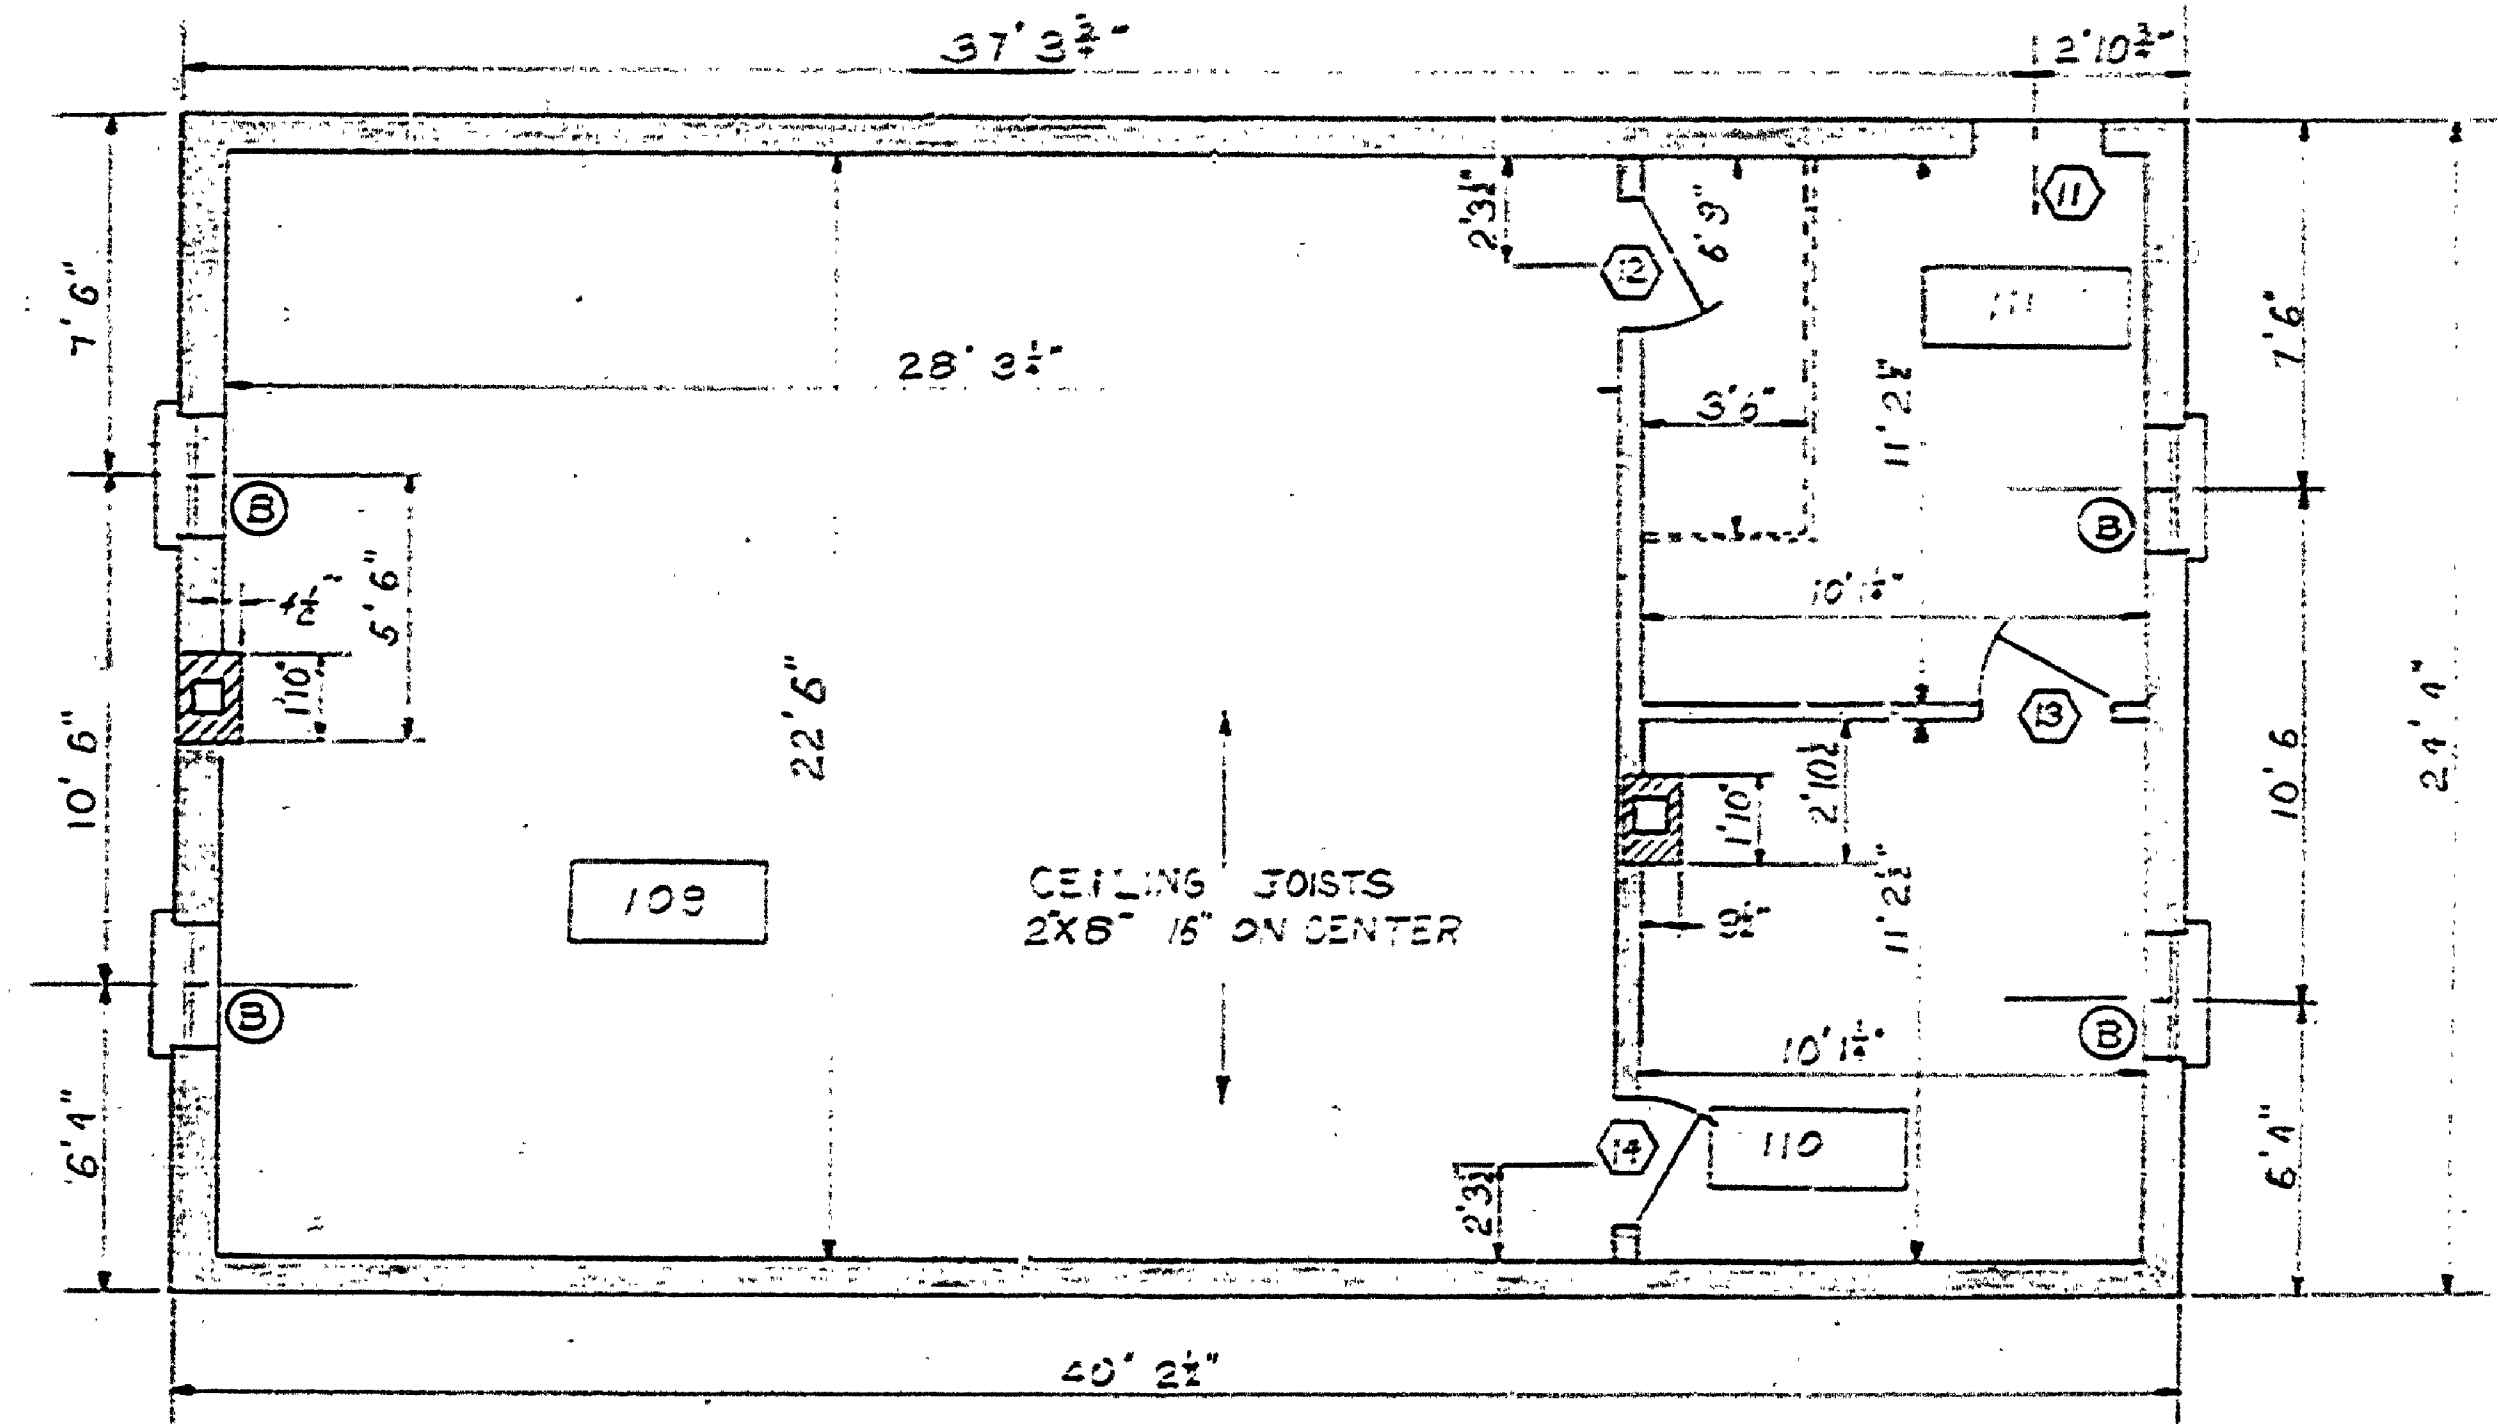

SECOND FLOOR PLAN

Scale 1/4" = 1' 0"

1ST FLOOR DOOR SCHEDULE						
MKS	REQD	SIZE	GLASS	TRANS	TYPE	REMARKS
1	1	2'8" X 6'9"	NONE	NONE	PANEL	
2	1	2'10" X 6'9"	"	YES	"	
3	1	9'10 1/2" X 11'0"	"	"	SLIDING	NOT ORIGINAL

1 1/2 2ND FLOOR WINDOW SCHEDULE						
MKS	REQD	SIZE	TYPE	SASH	GLASS	REMARKS
A	6	2'7" X 5'5 1/2"	D.H.	2'7" X 2'9"	12/8" X 14"	
B	4	"	"	"	"	

2ND FLOOR DOOR SCHEDULE						
MKS	REQD	SIZE	GLASS	TRANS	TYPE	REMARKS
11	1	2'10" X 6'5"	NONE	NONE	PANEL	
12	1	"	"	"	"	
13	1	"	"	"	"	
14	1	"	"	"	"	

TRANSOM SCHEDULE						
MKS	REQD	SIZE	REMARKS			
2	1	3'10" X 14"				

MICHIGAN DEPARTMENT OF CONSERVATION PARKS AND RECREATION DIVISION

MEASURED DRAWING FAYETTE HISTORICAL TOWNSITE FAYETTE STATE PARK

SHEET NO. 1 OF 3 PLAN NO. A-108