



DESIGNED BY	DATE	REVIEWED	DATE	APPROVED	DATE	NO.	DATE	REVISIONS	DATE	BY
		ARCHITECTURAL	1/7/44			1.		4		
		ENGINEERING				2.		5		
		LANDSCAPE				3.		6		

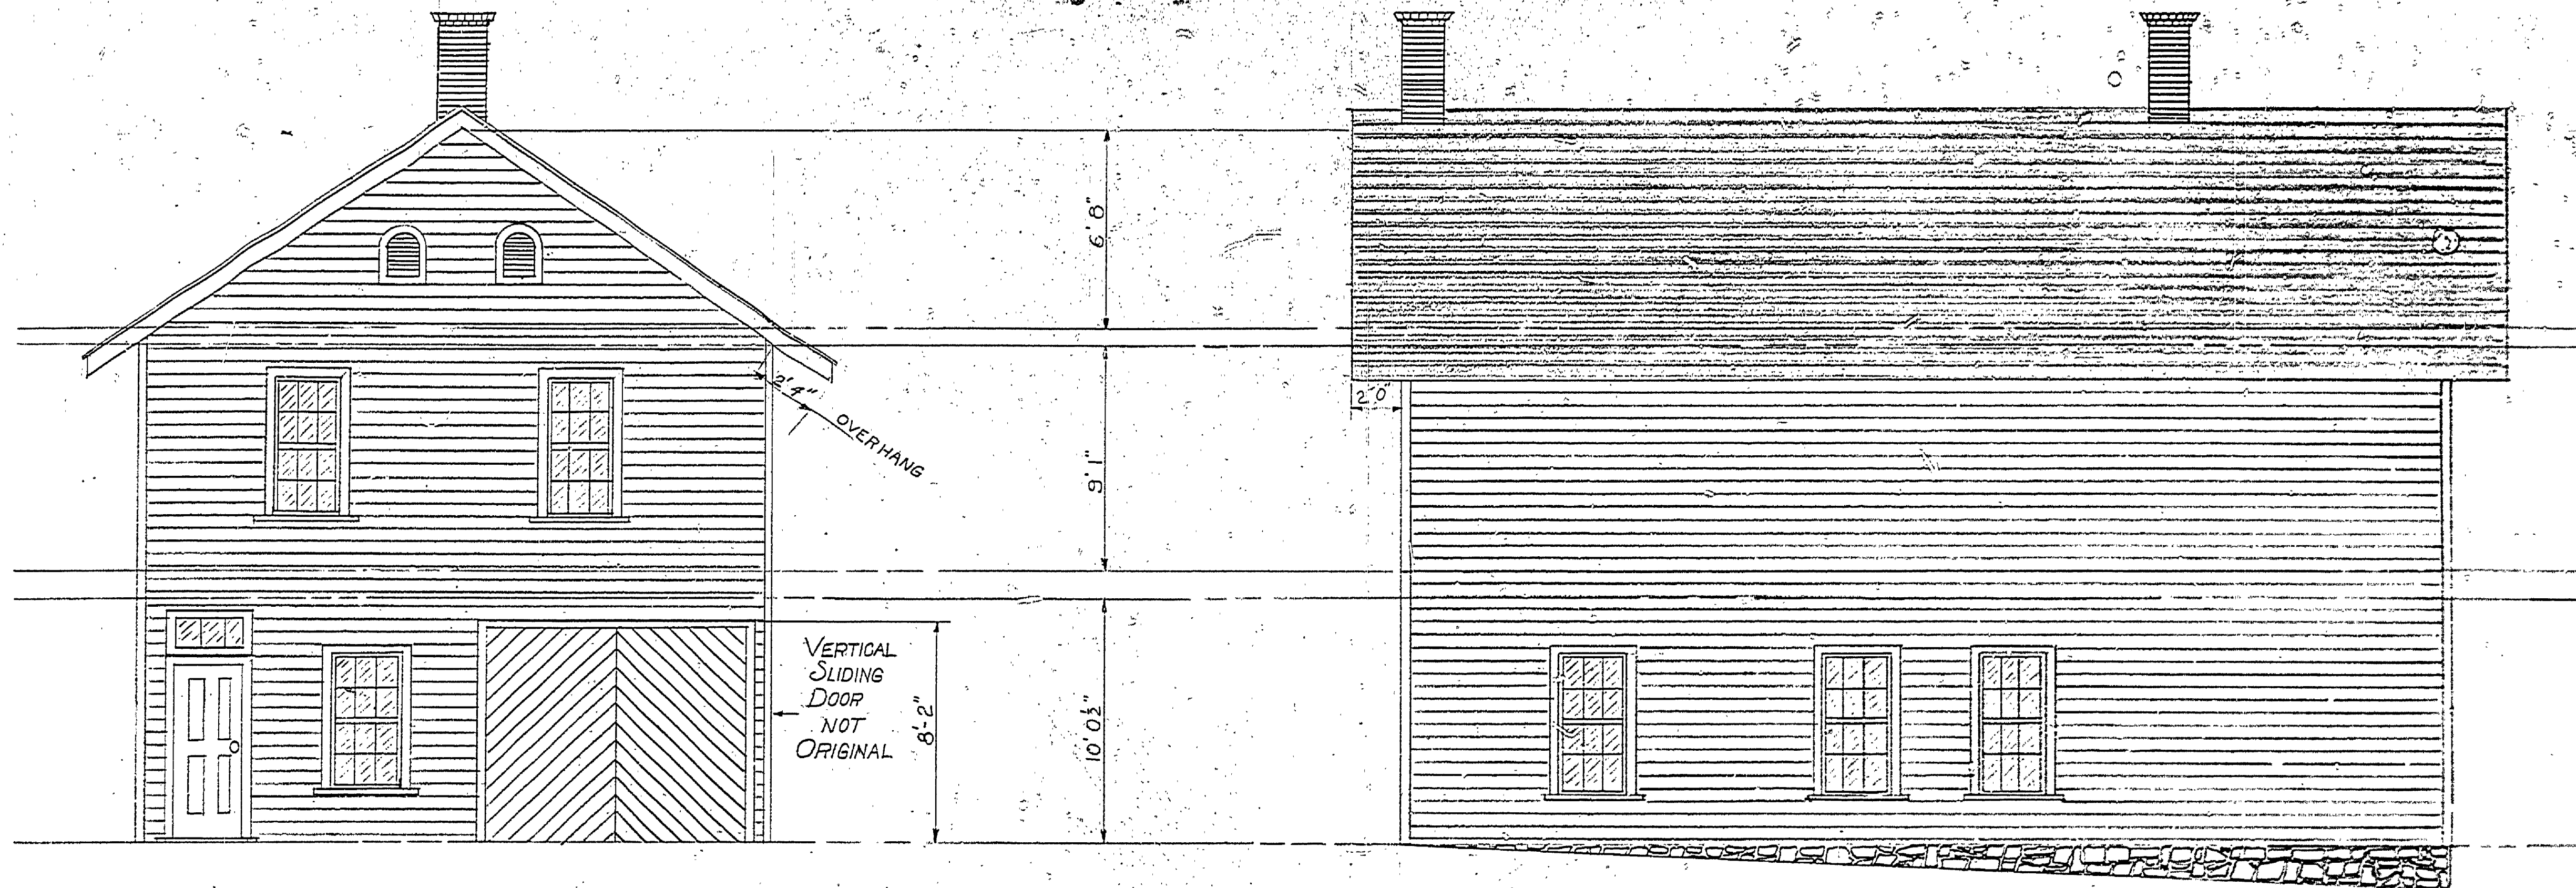

SOUTHWEST ELEVATION

NORTHWEST ELEVATION

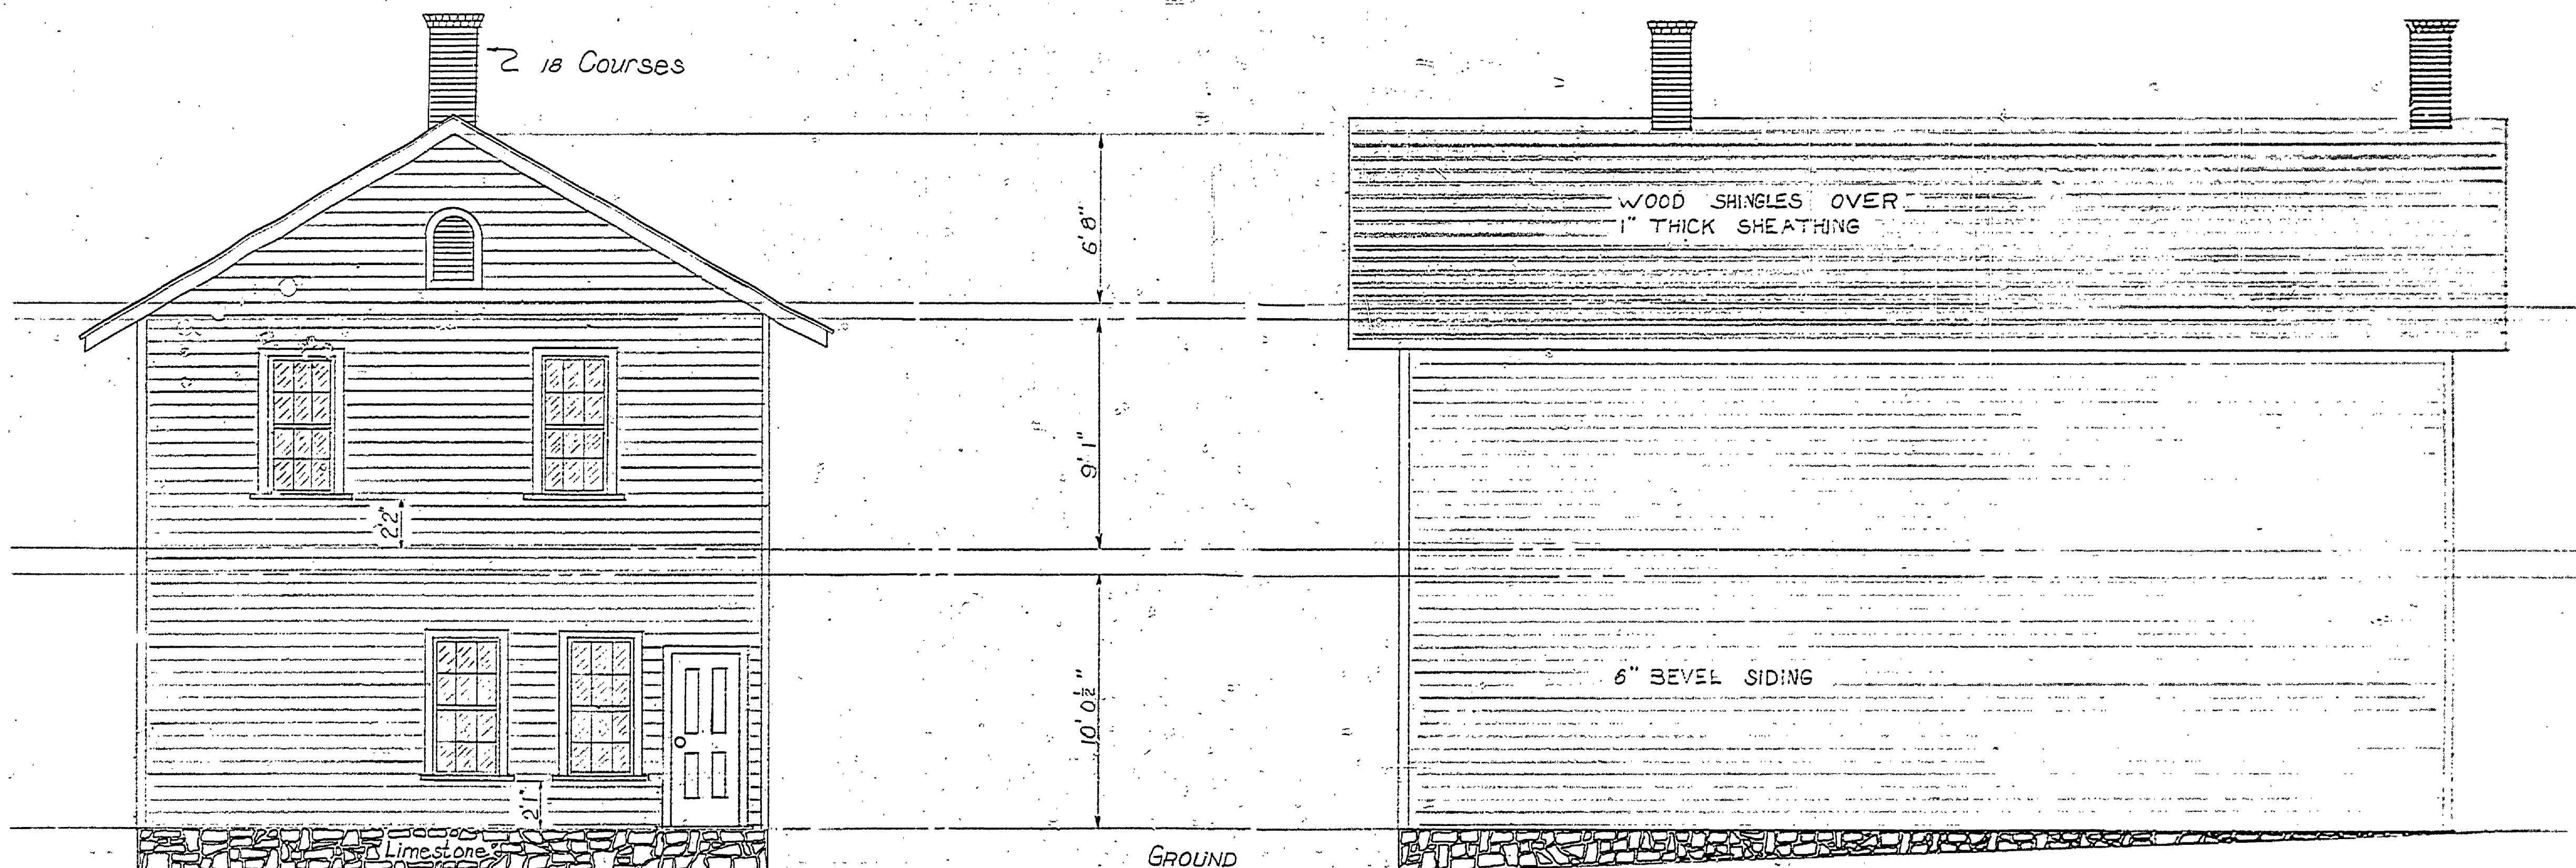

NORTHEAST ELEVATION

SOUTHEAST ELEVATION

GROUND LEVEL
DEPTH OF FOUNDATION UNKNOWN

Scale $\frac{1}{4} = 1'0''$

MICHIGAN
DEPARTMENT OF CONSERVATION
PARKS AND RECREATION DIVISION

MEASURED DRAWING
FAYETTE HISTORICAL TOWNSITE
FAYETTE STATE PARK

SHEET
NO. 2
OF 3

PLAN NO.
A-100