


Govt. Lot #1, Section 4, T.38N. R.19W.
Location of Fish House

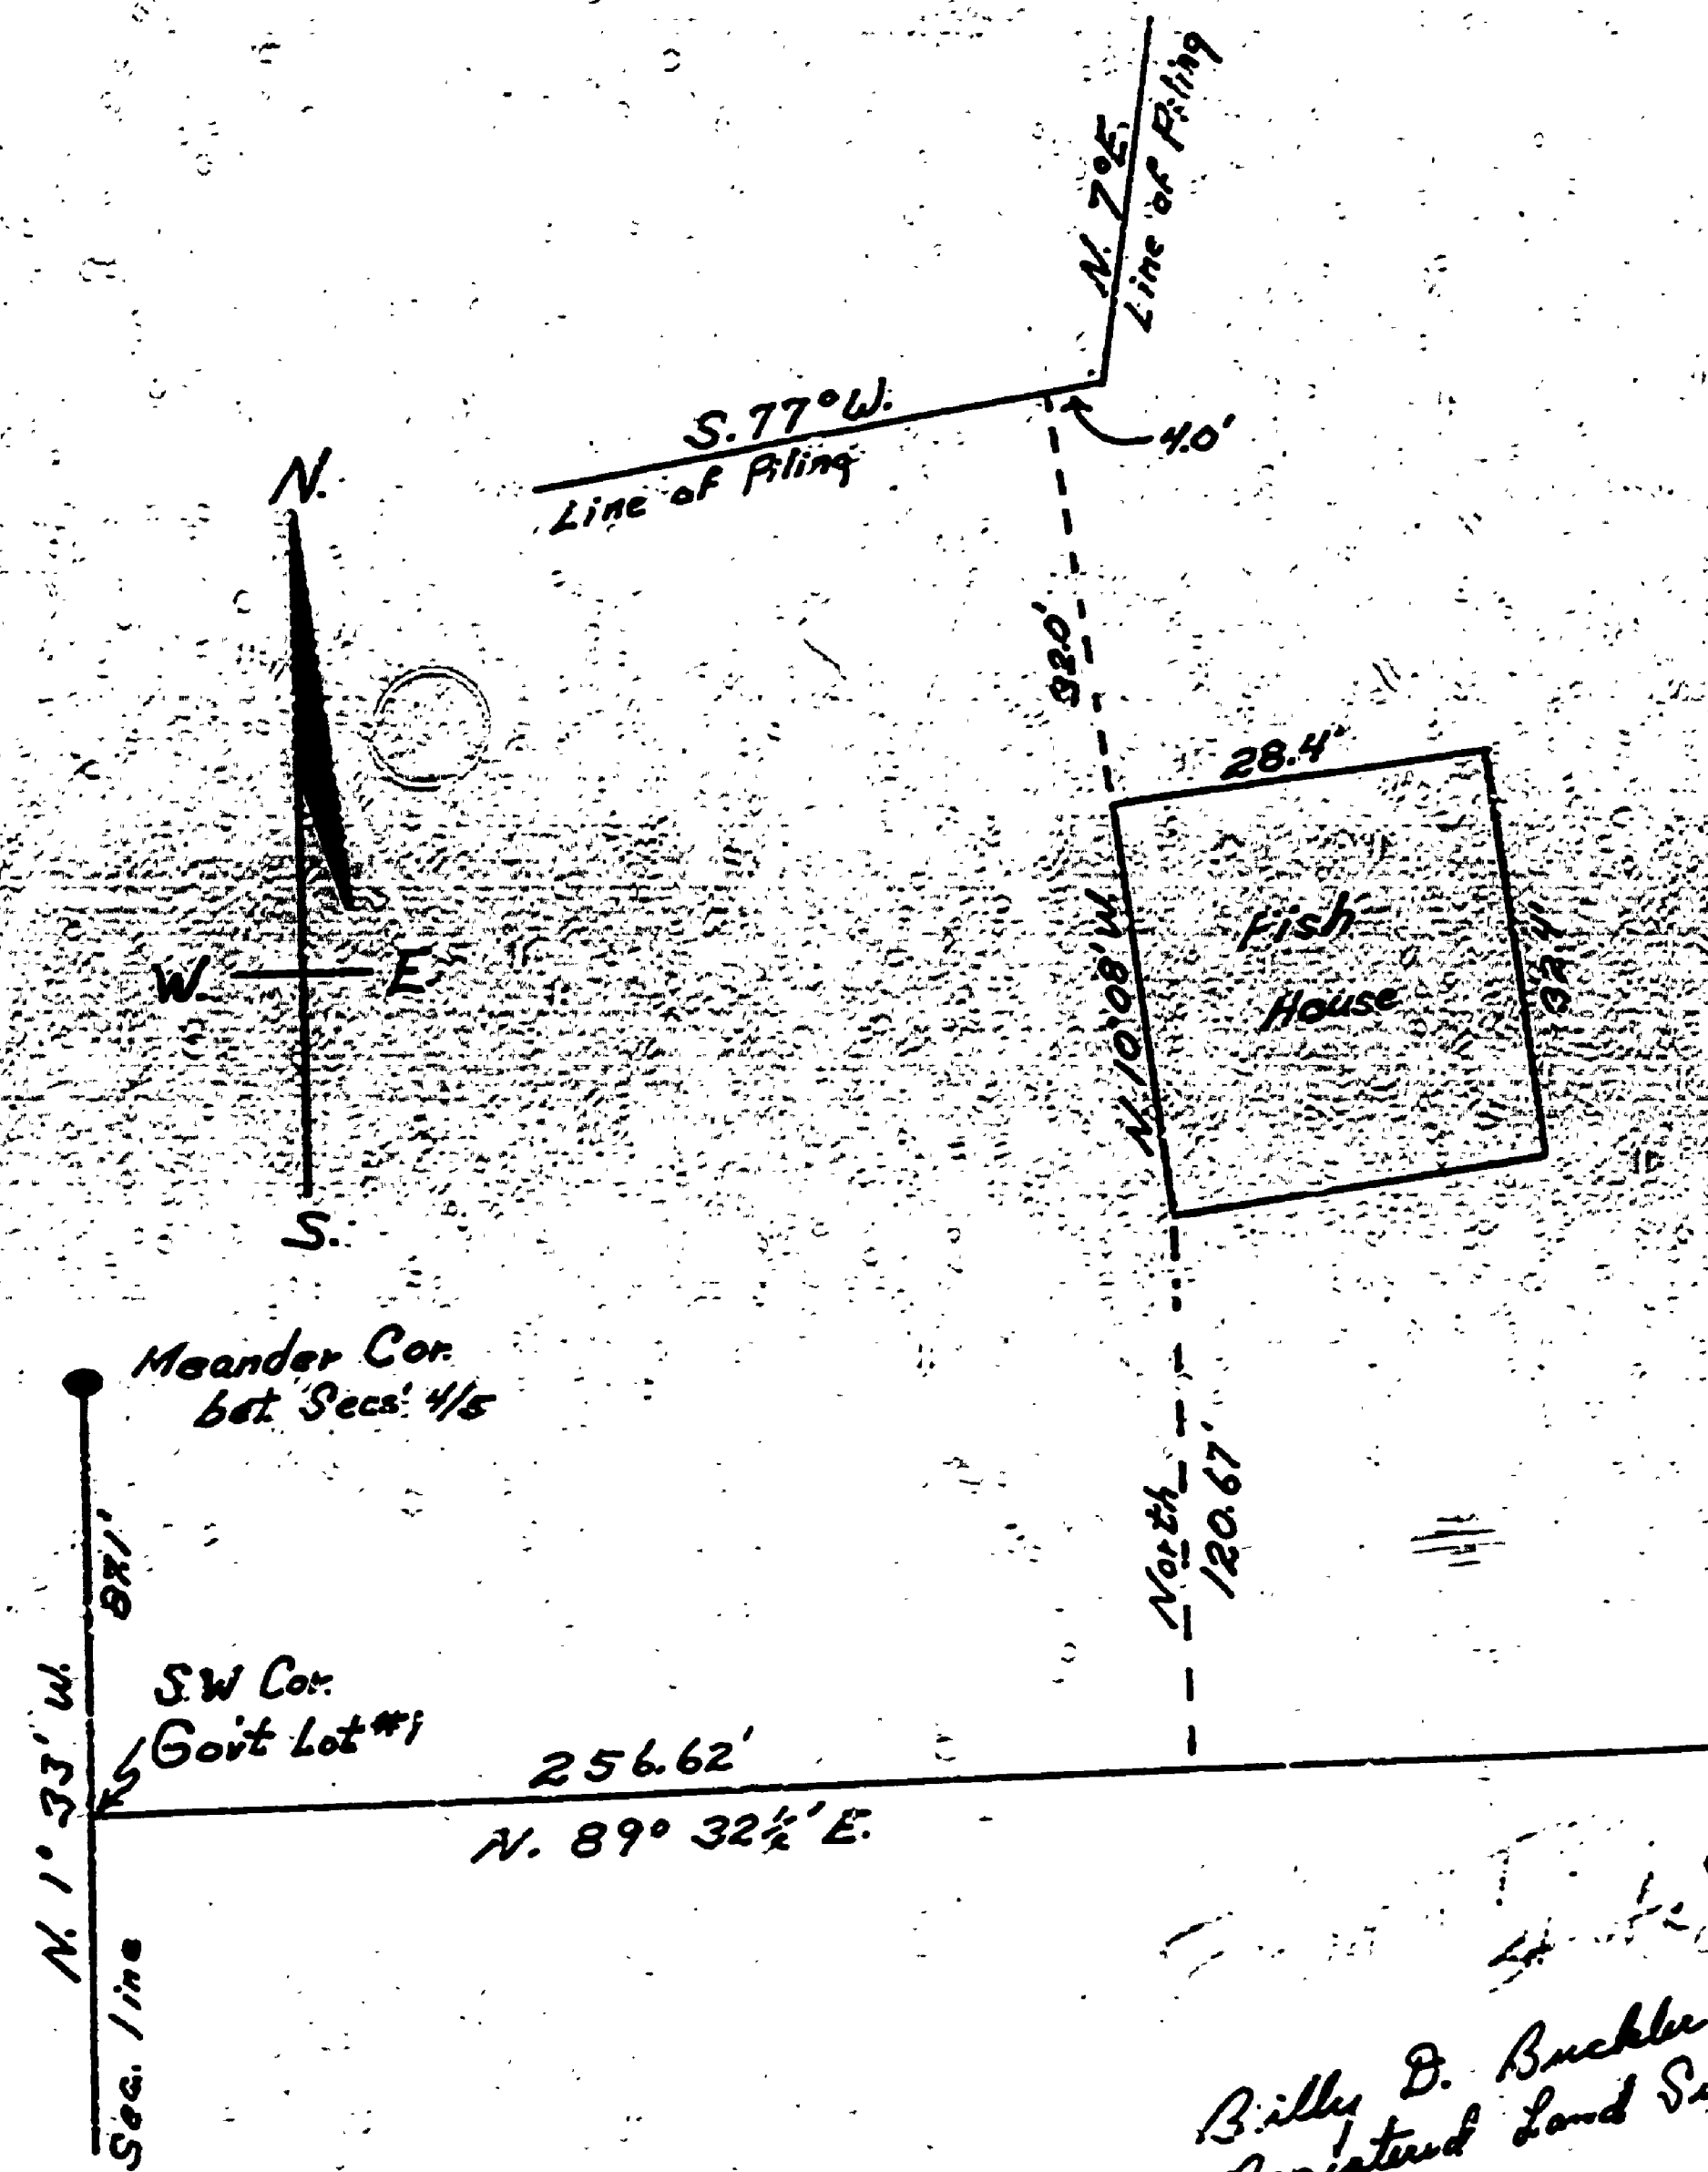

Billie D. Buckler
Registered Land Surveyor
8887.
11/13/21
R-5