
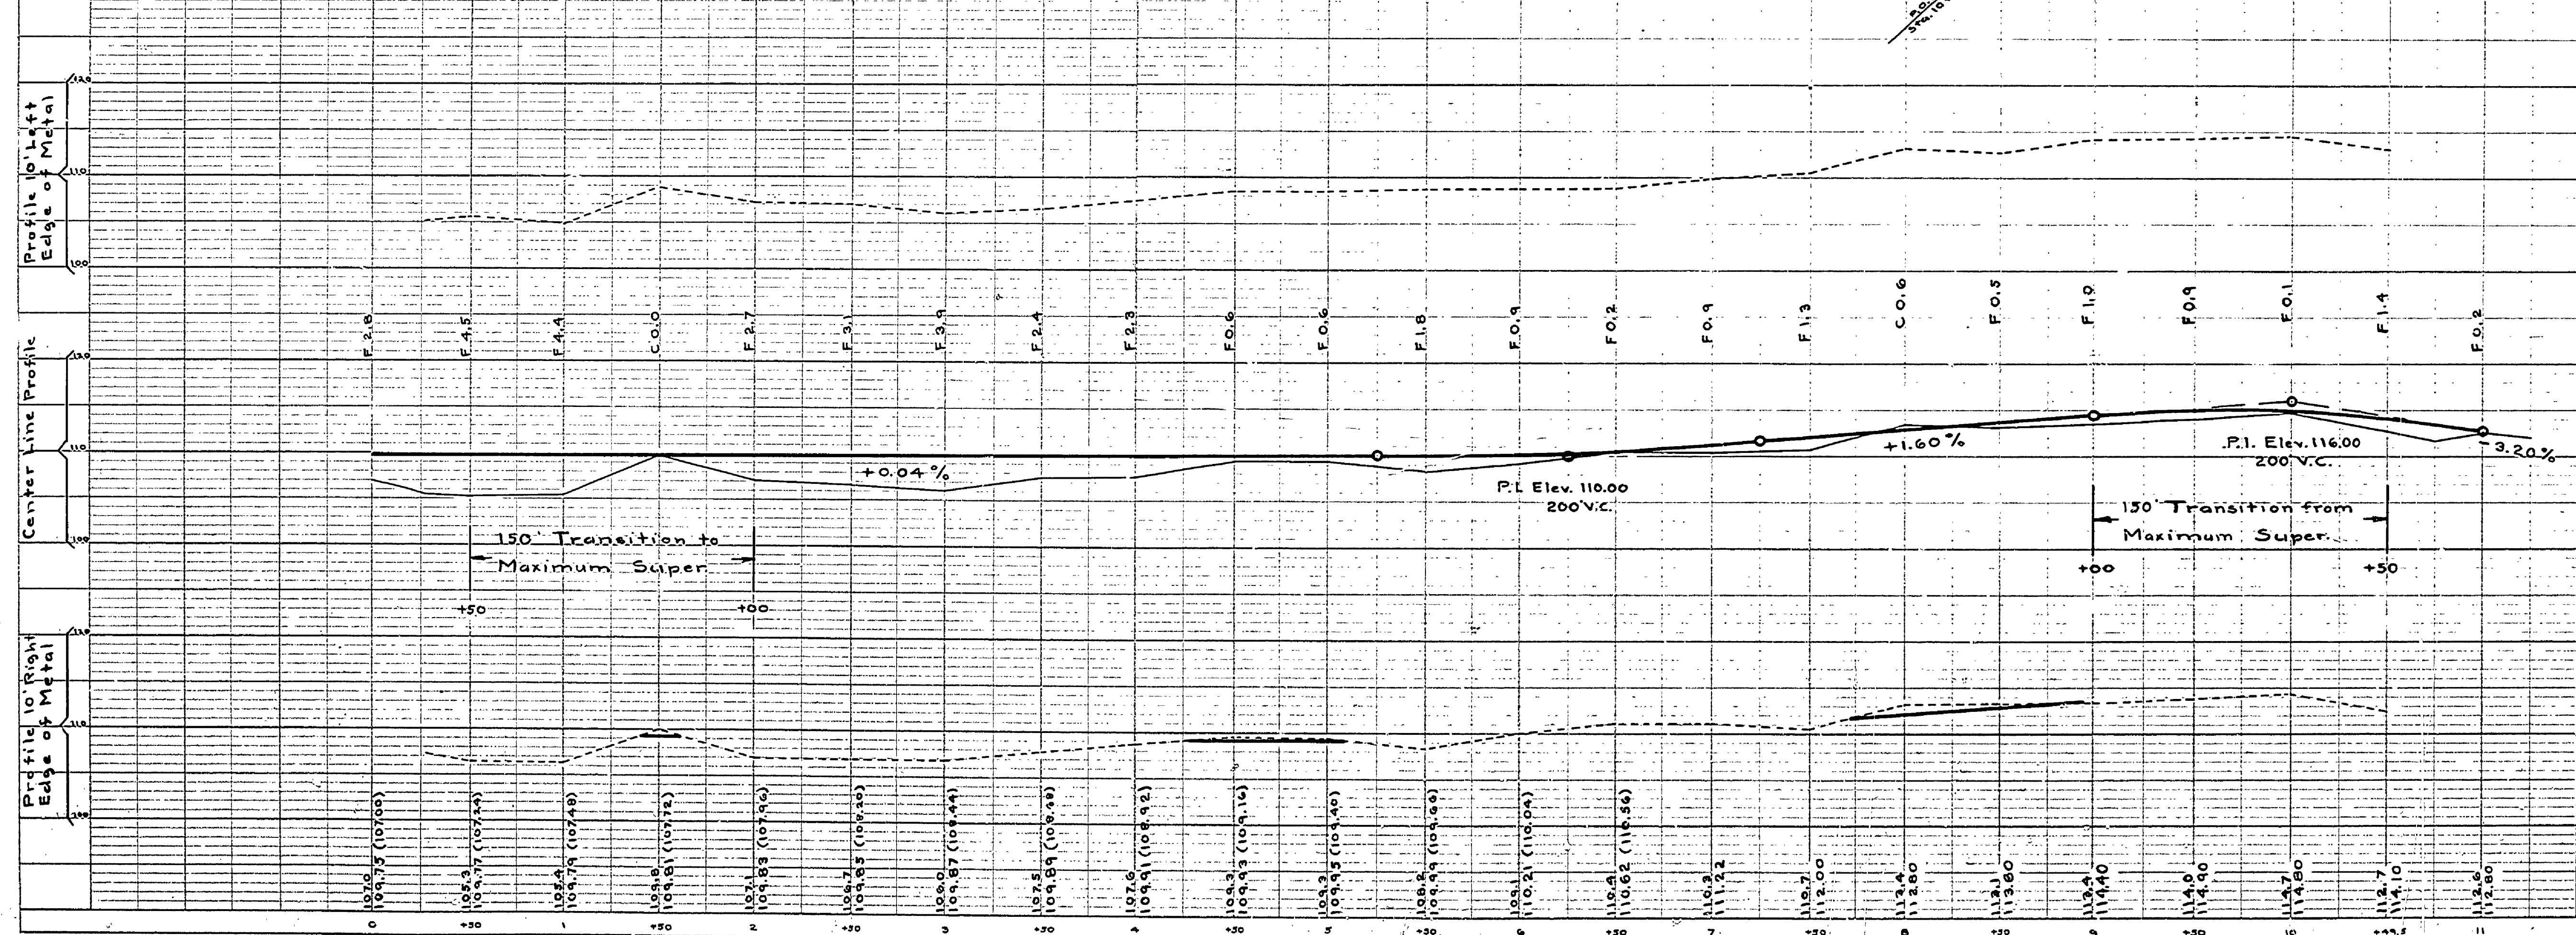
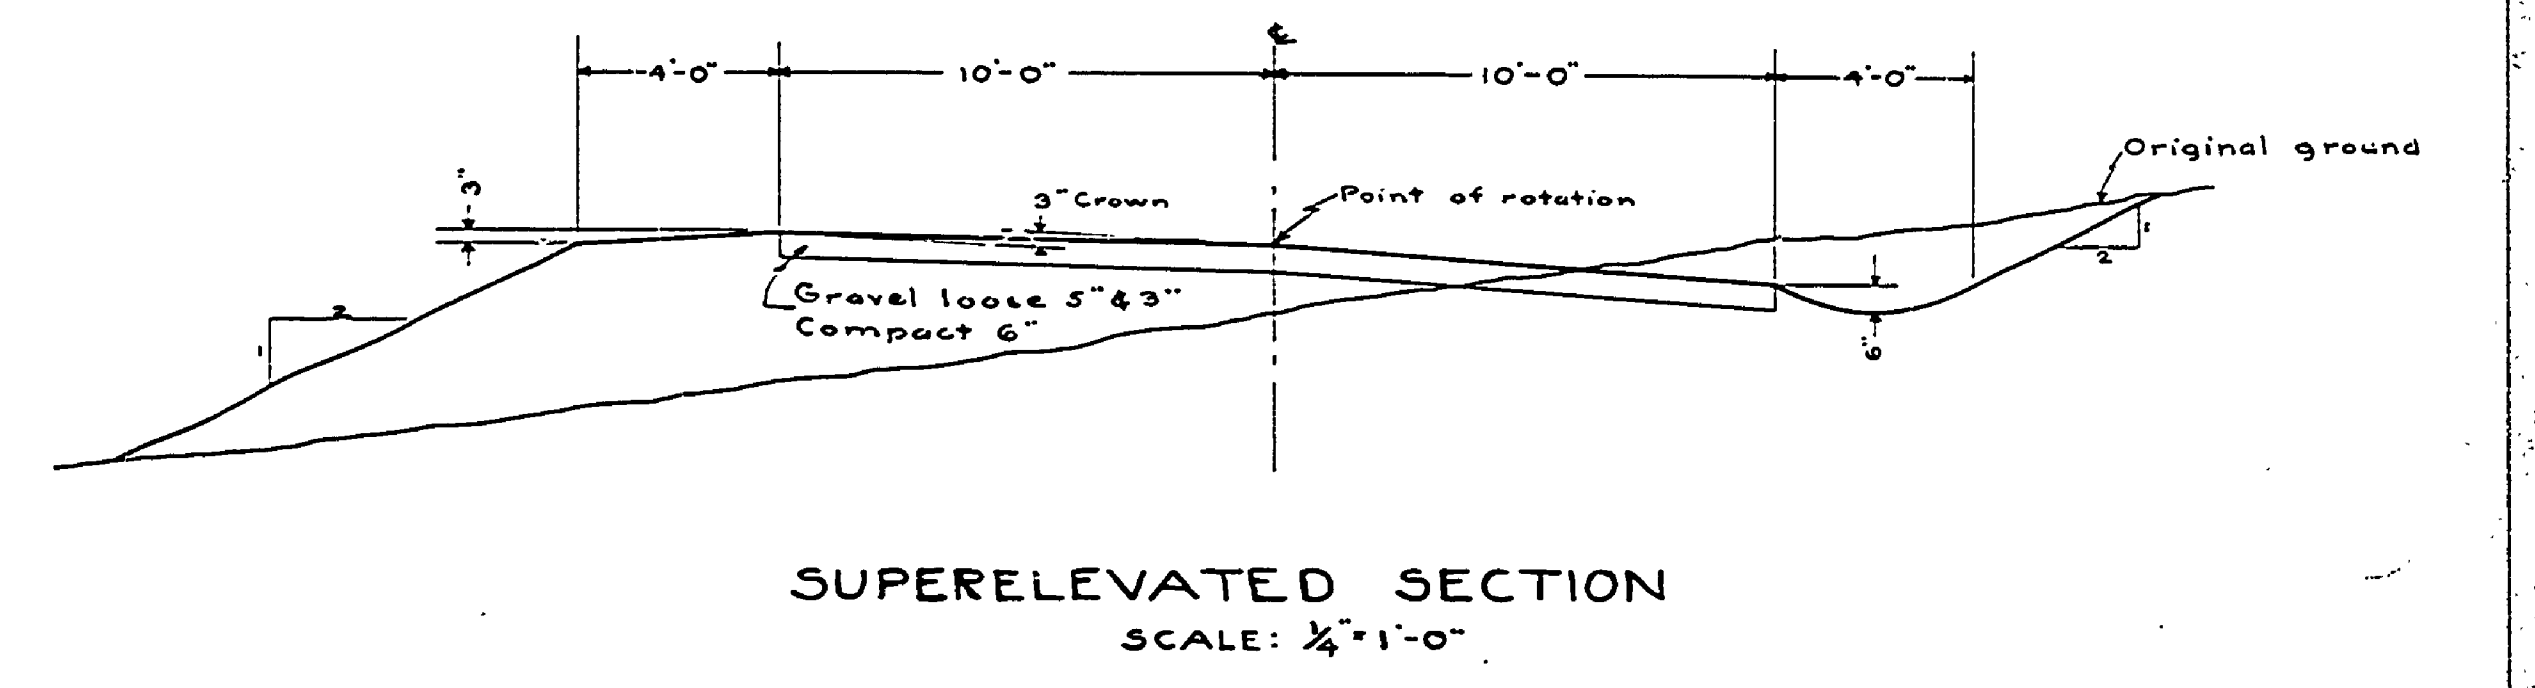
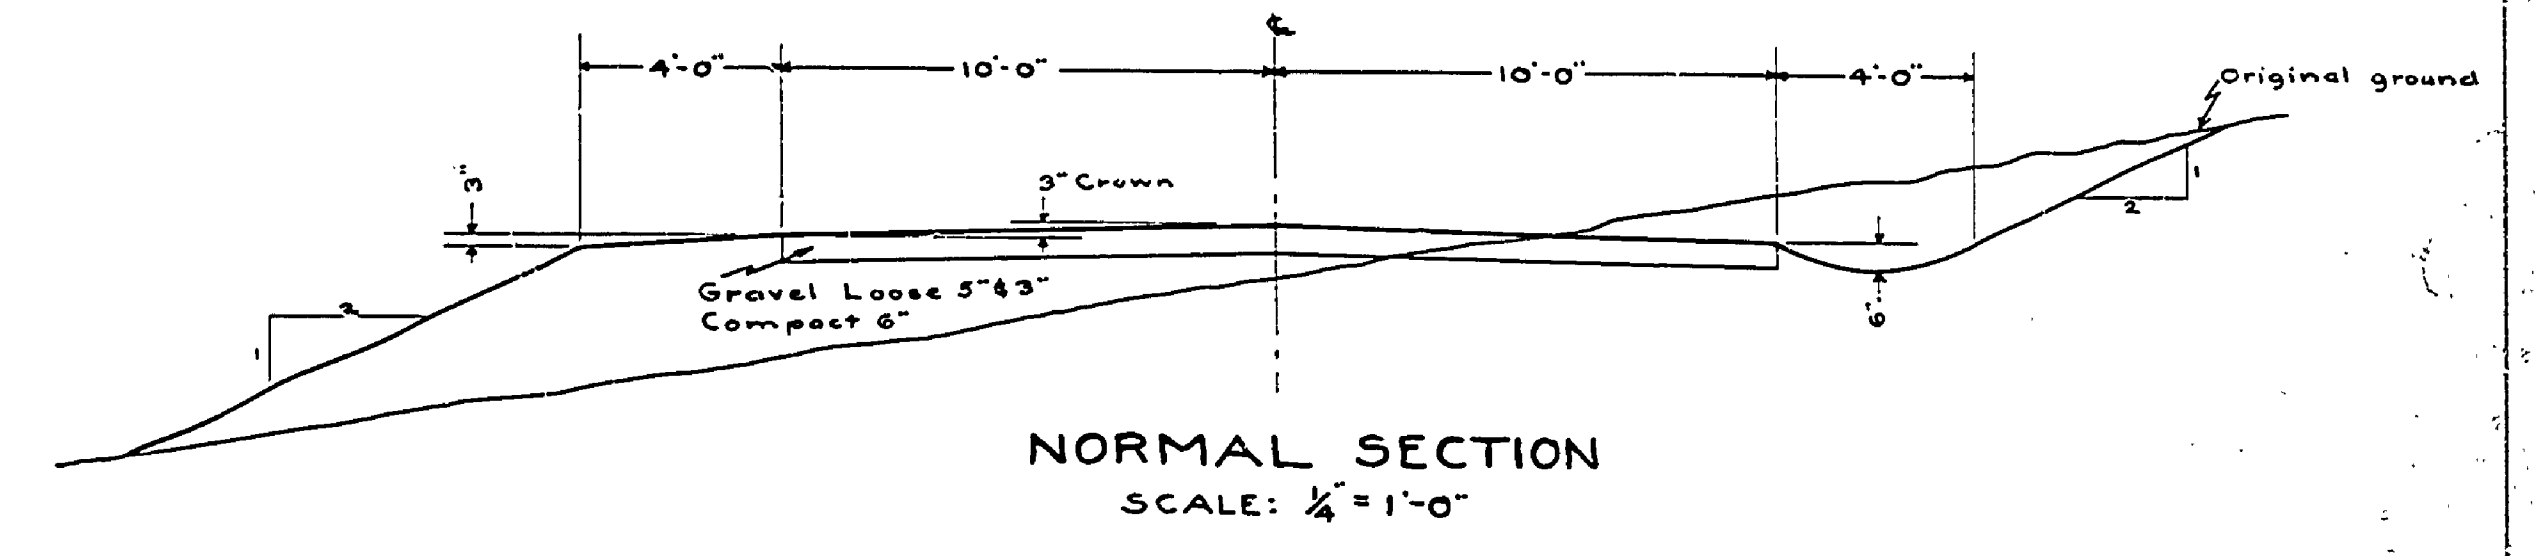


DATE: _____ BY: _____
 SURVEYED: _____
 GRADES CHECKED: _____
 STRUCTURE INDICATED: _____
 PLAN
 NOTE BOOK NO. _____

DATE: _____ BY: _____
 SURVEYED: _____
 GRADES CHECKED: _____
 STRUCTURE INDICATED: _____
 PROFILE
 NOTE BOOK NO. _____

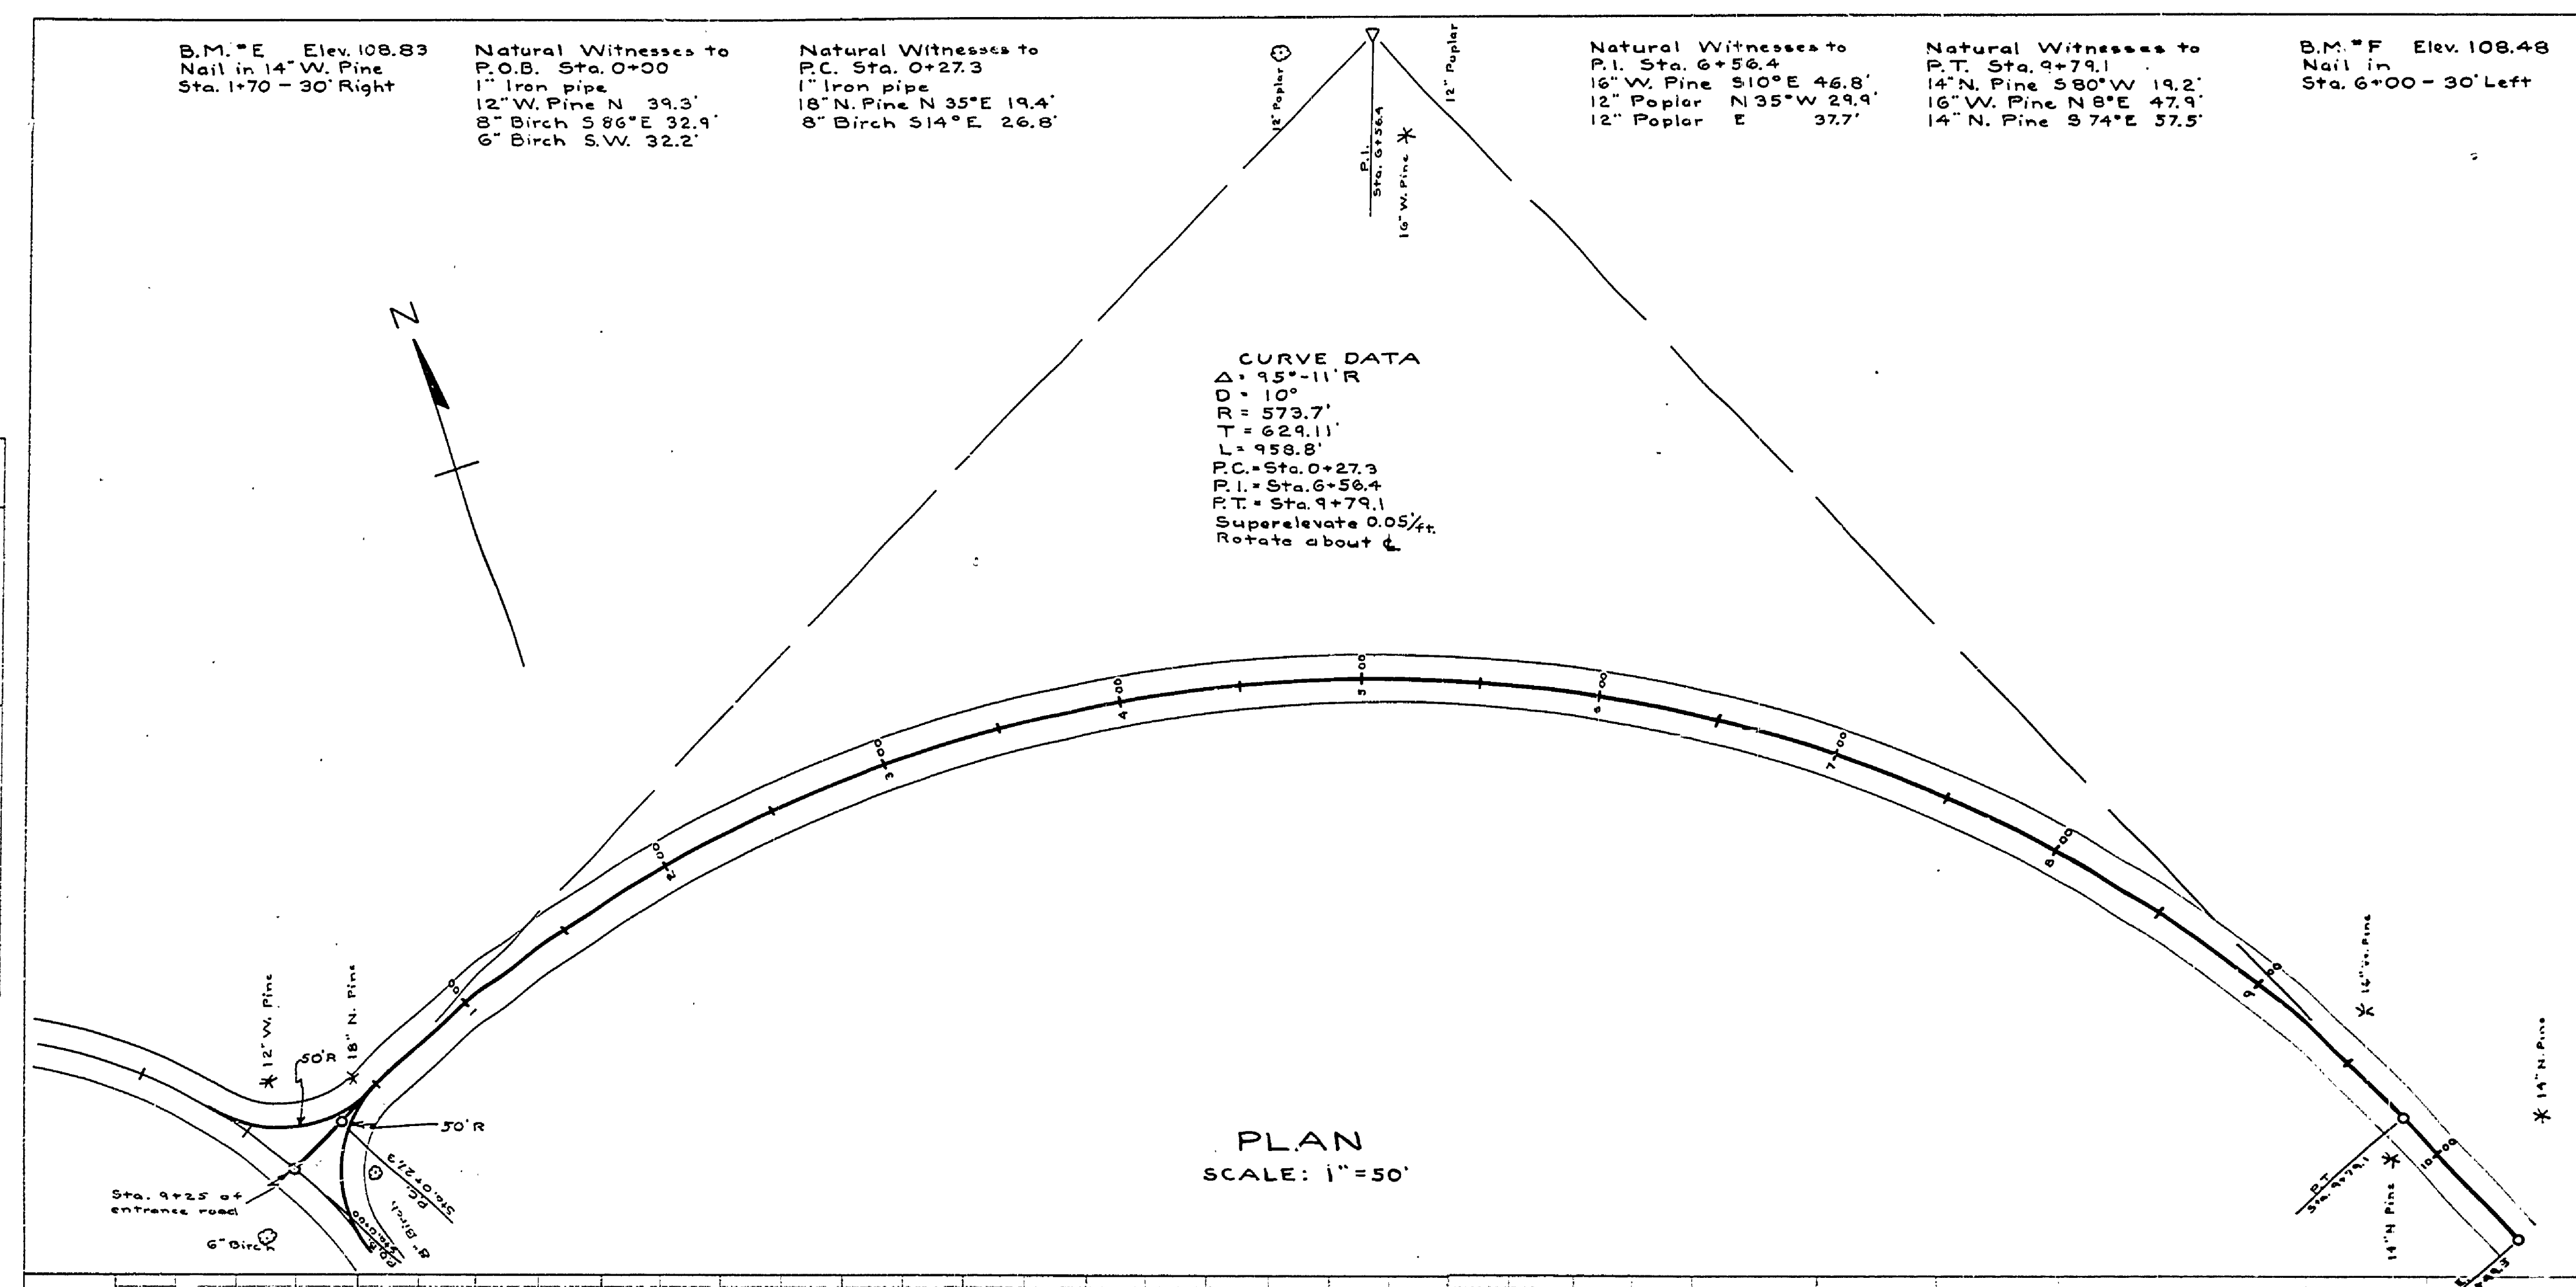

NOTE: Whenever the elevations of the metal on the revised plans differ from those on the original plans the original elevations are shown in parenthesis.

MICHIGAN DEPARTMENT OF CONSERVATION
STATE PARKS DIVISION

DESIGNED BY: FORT WILKINS STATE PARK
CHECKED BY: ENTRANCE ROAD
PREPARED AND APPROVED BY: _____
APPROVED BY: _____

DATE: 11-20-30