


DATE	REVIEWED	DATE	APPROVED	DATE	NO.	DATE	BY	REVISIONS
Feb '64	ARCHITECTURAL	4-11-64		1	1/1/65	DHC	ADDED SANITATION STATION	4
Feb '64	ENGINEERING	1-1-64		2				5
May '64	LANDSCAPE	1-1-64		3				6

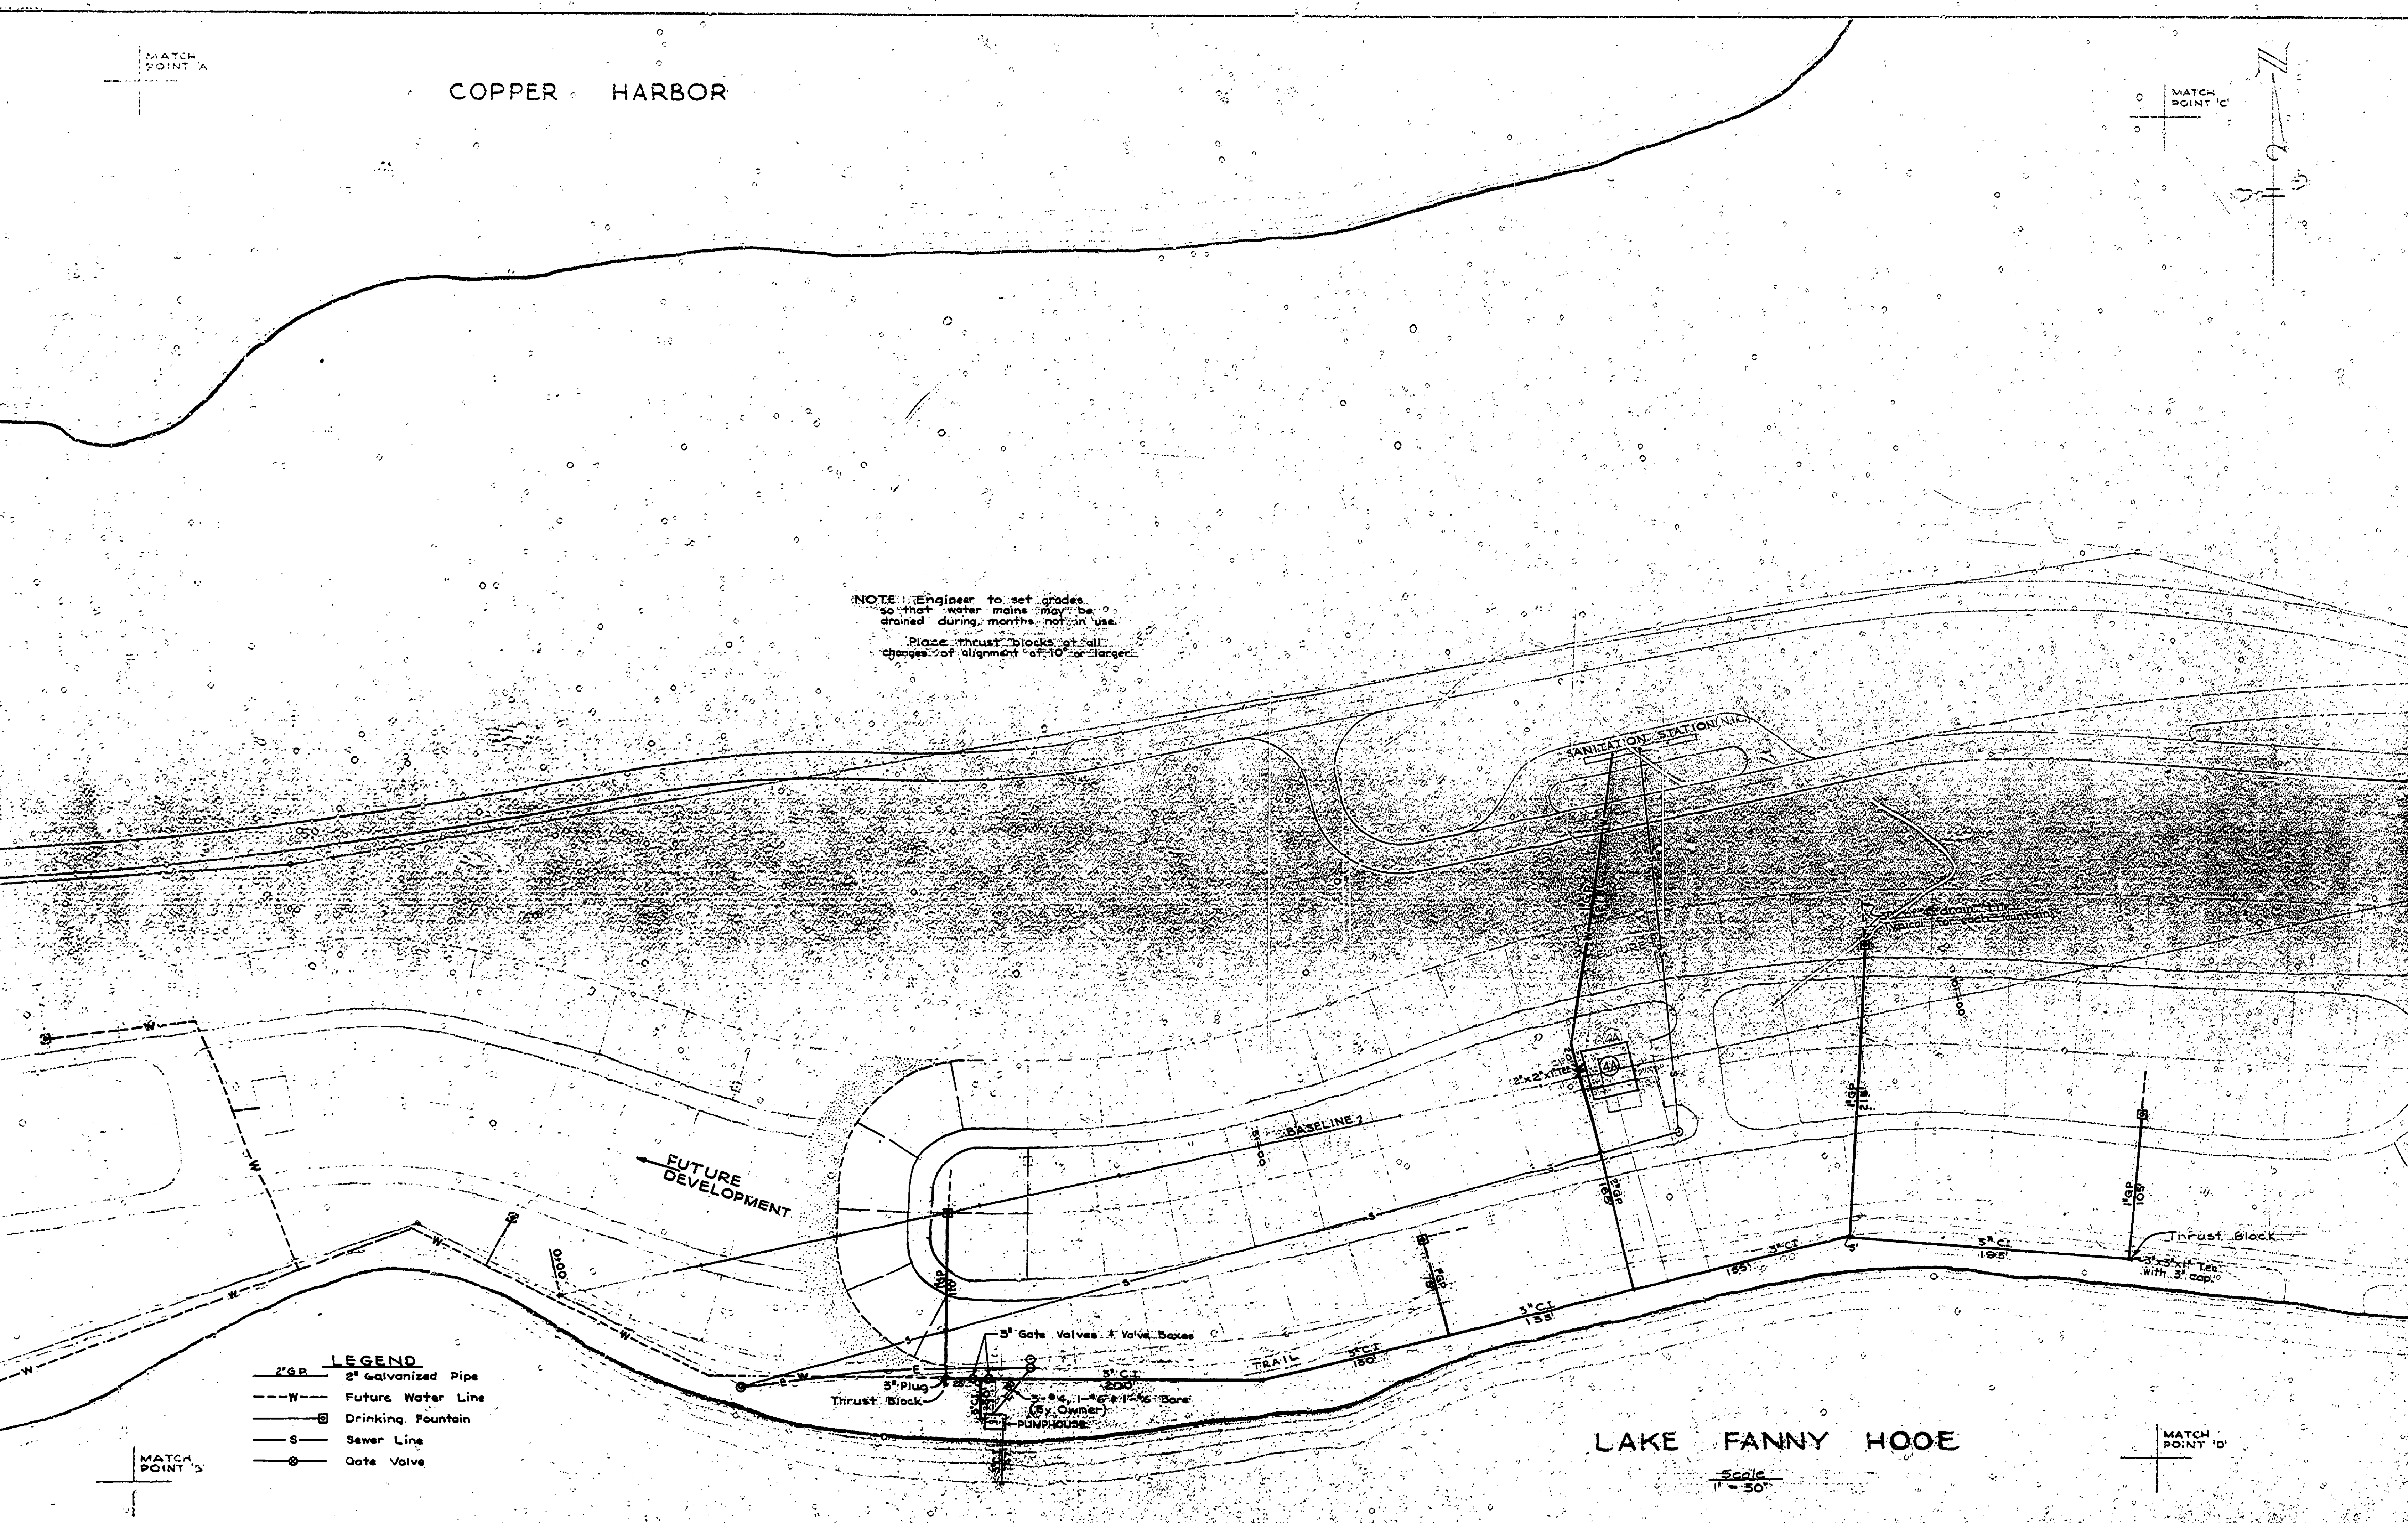

NOTE: Engineer to set grades so that water mains may be drained during months not in use. Place thrust blocks at all changes of alignment of 10° or larger.

- LEGEND**
- 2" G.P. 2" Galvanized Pipe
  - - - W - Future Water Line
  - ⊠ Drinking Fountain
  - - - S - Sewer Line
  - ⊙ Gate Valve

LAKE FANNY HOOE

Scale  
1" = 50'