



SECTION B-B

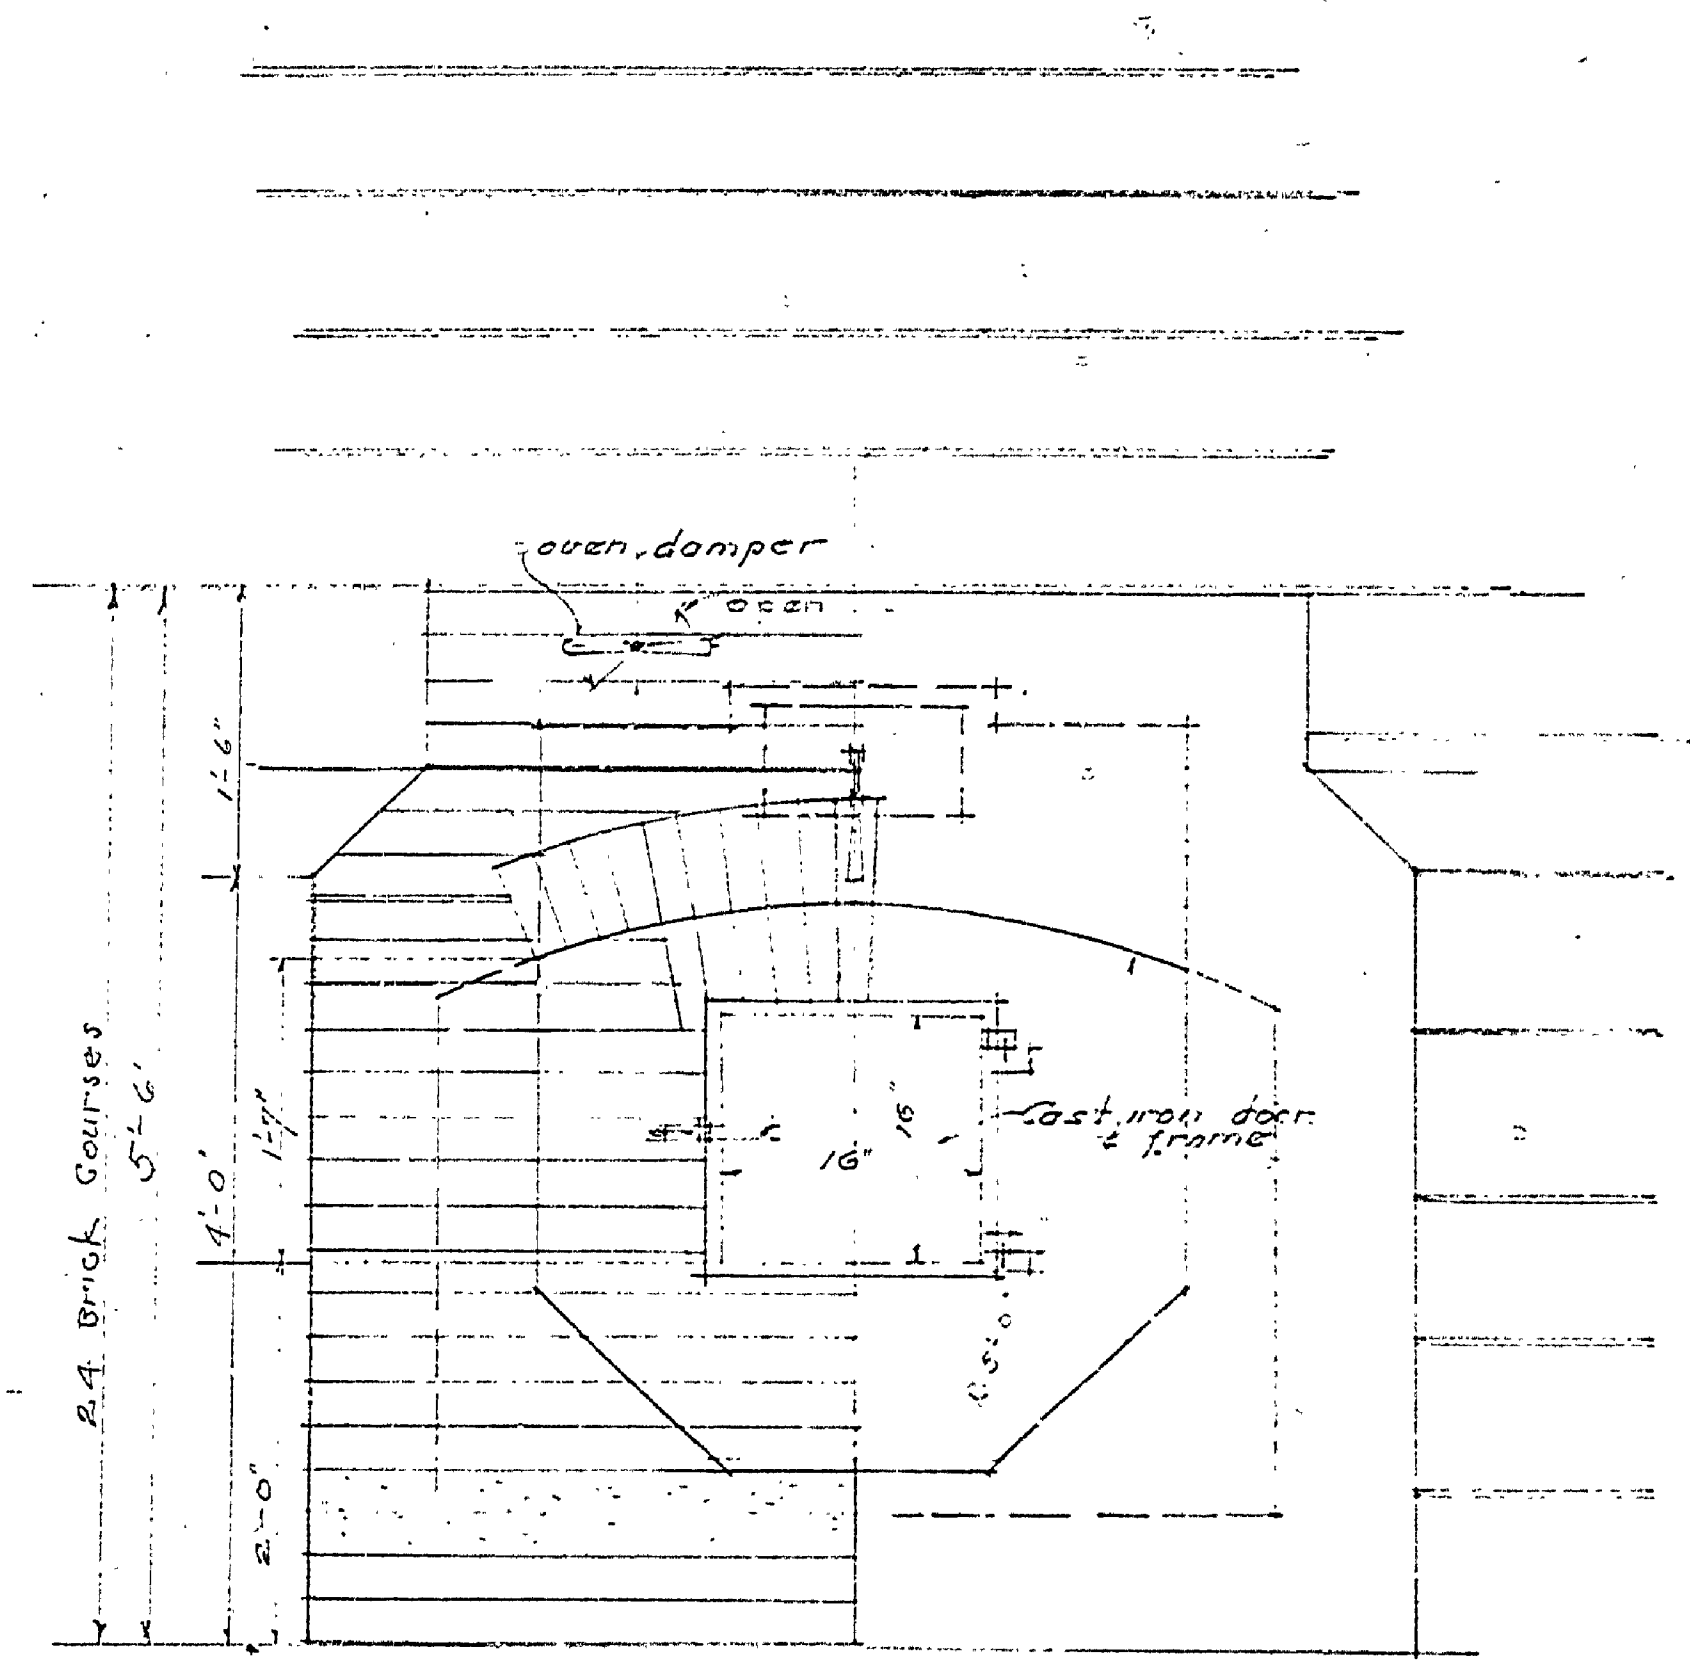


ELEVATION INSIDE BUILDING

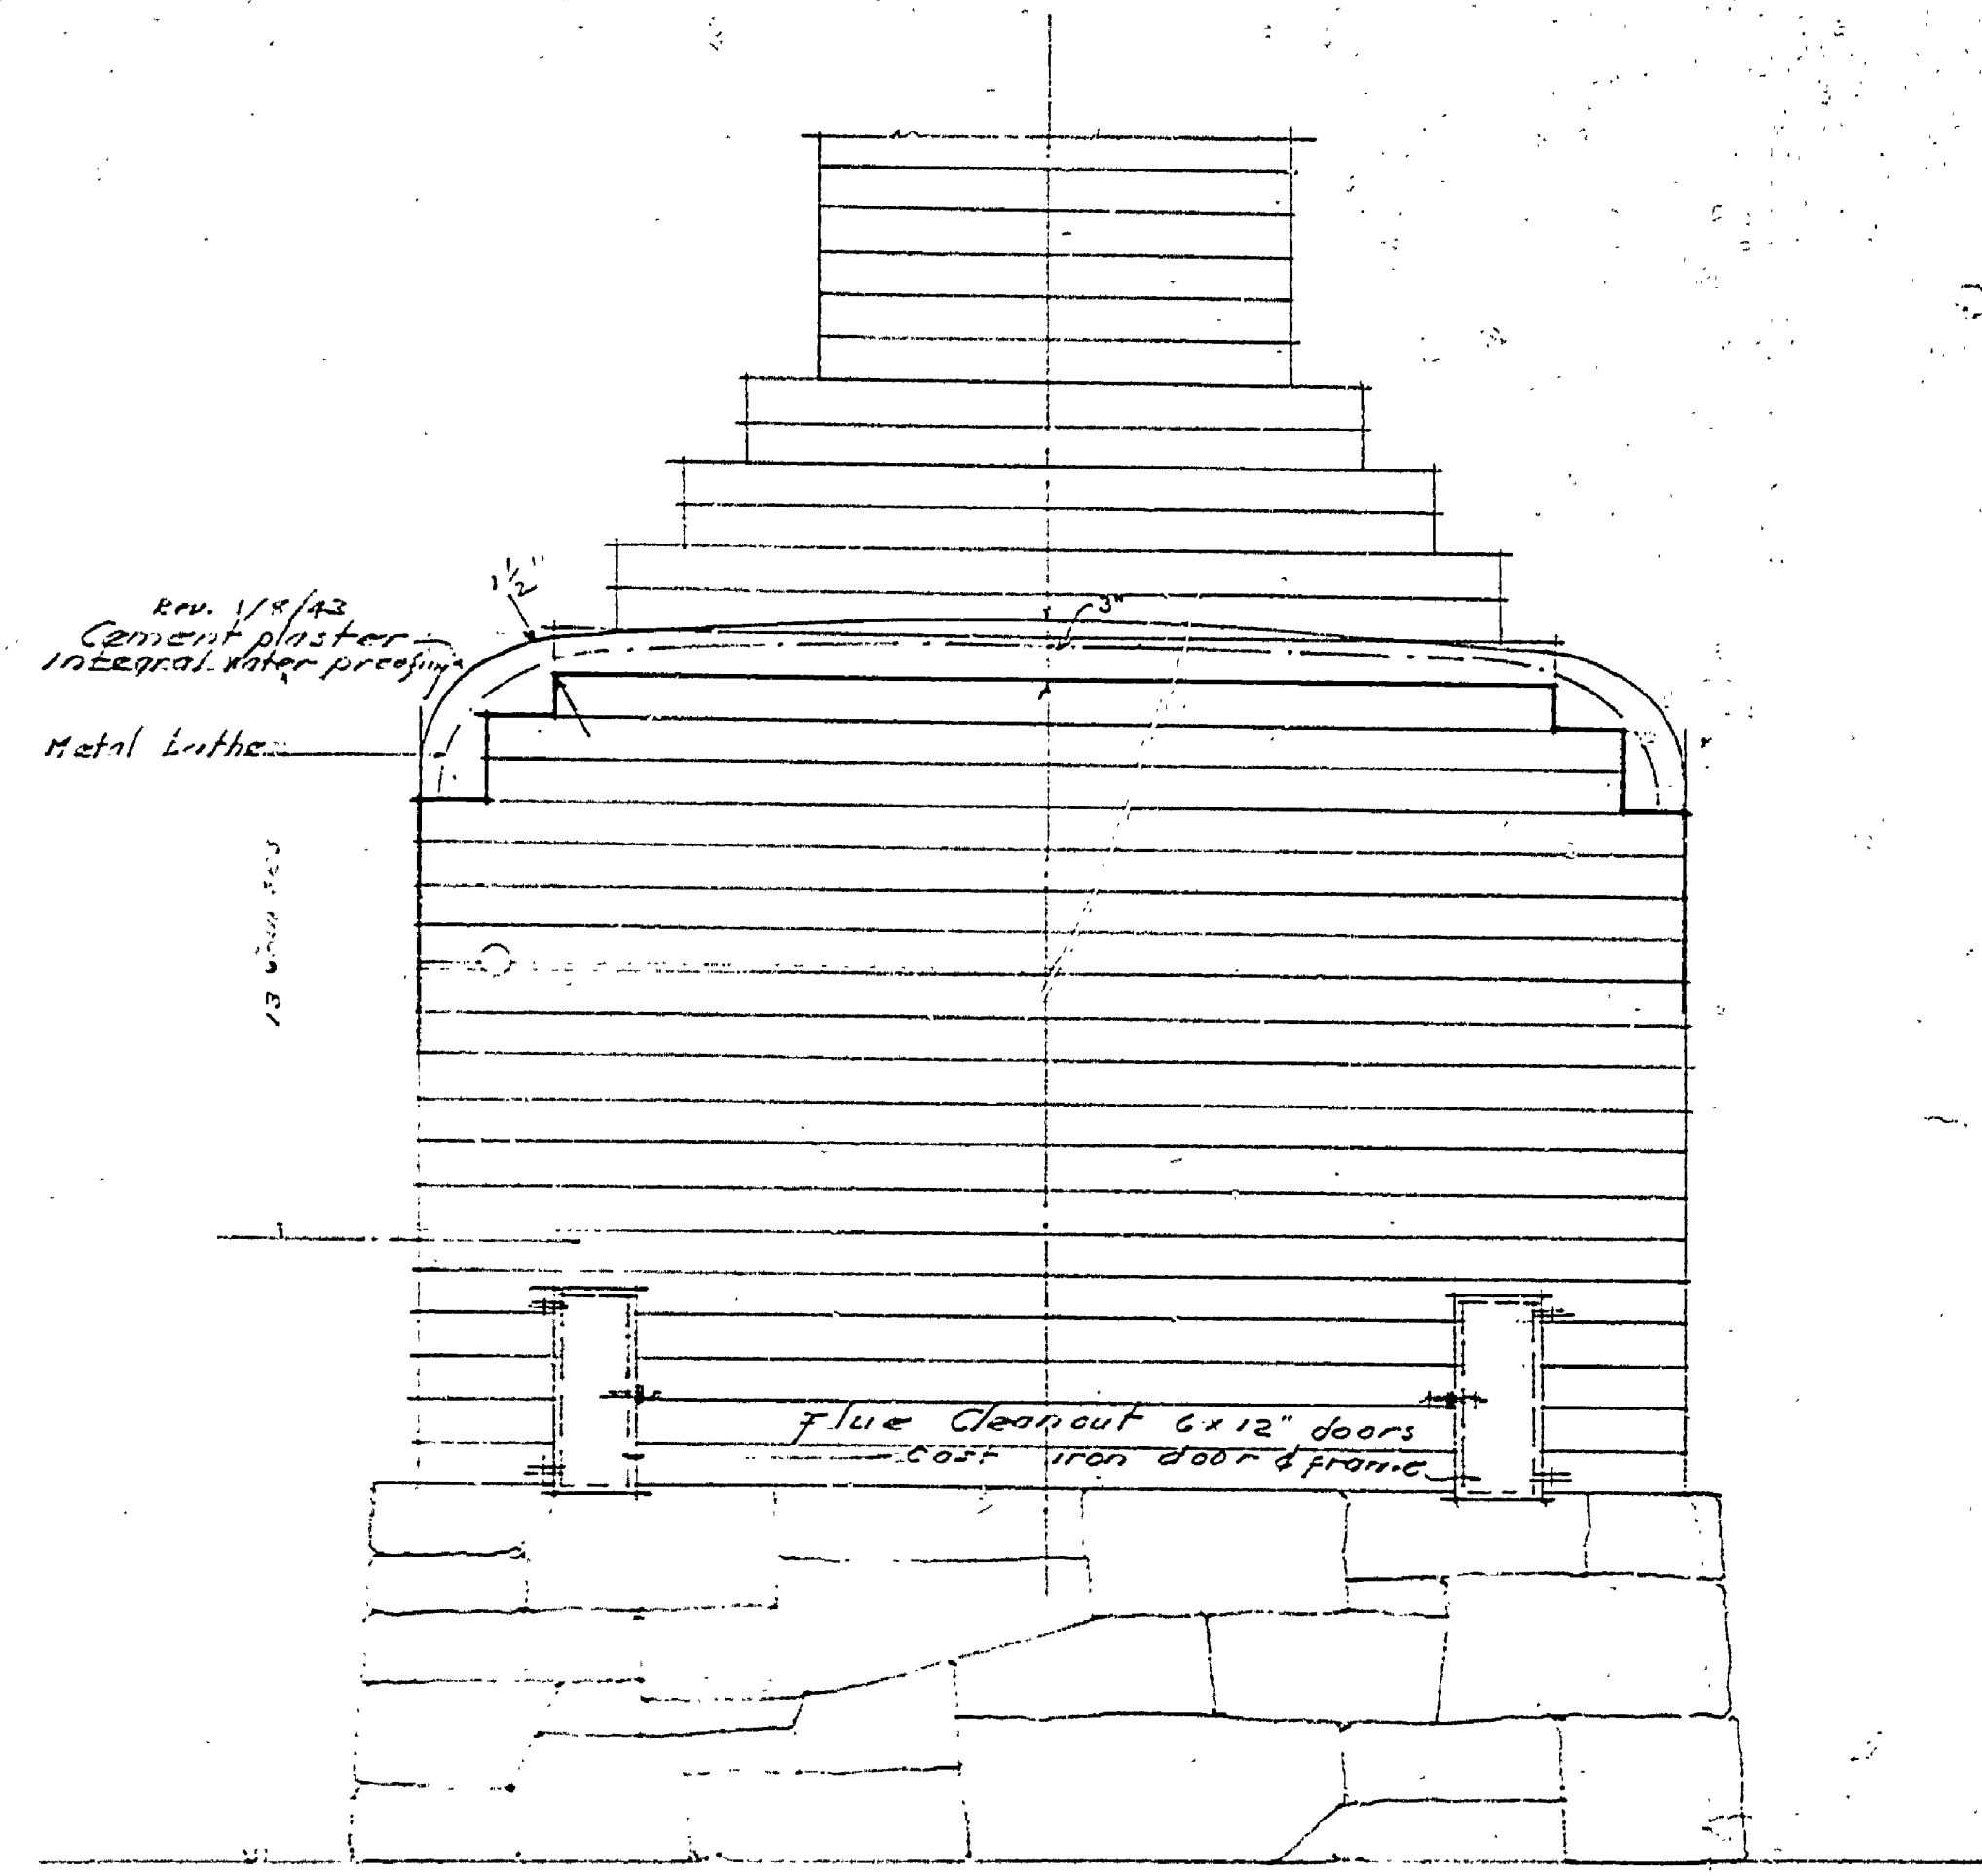


REAR ELEVATION

SCALE 1/4" = 1'-0"

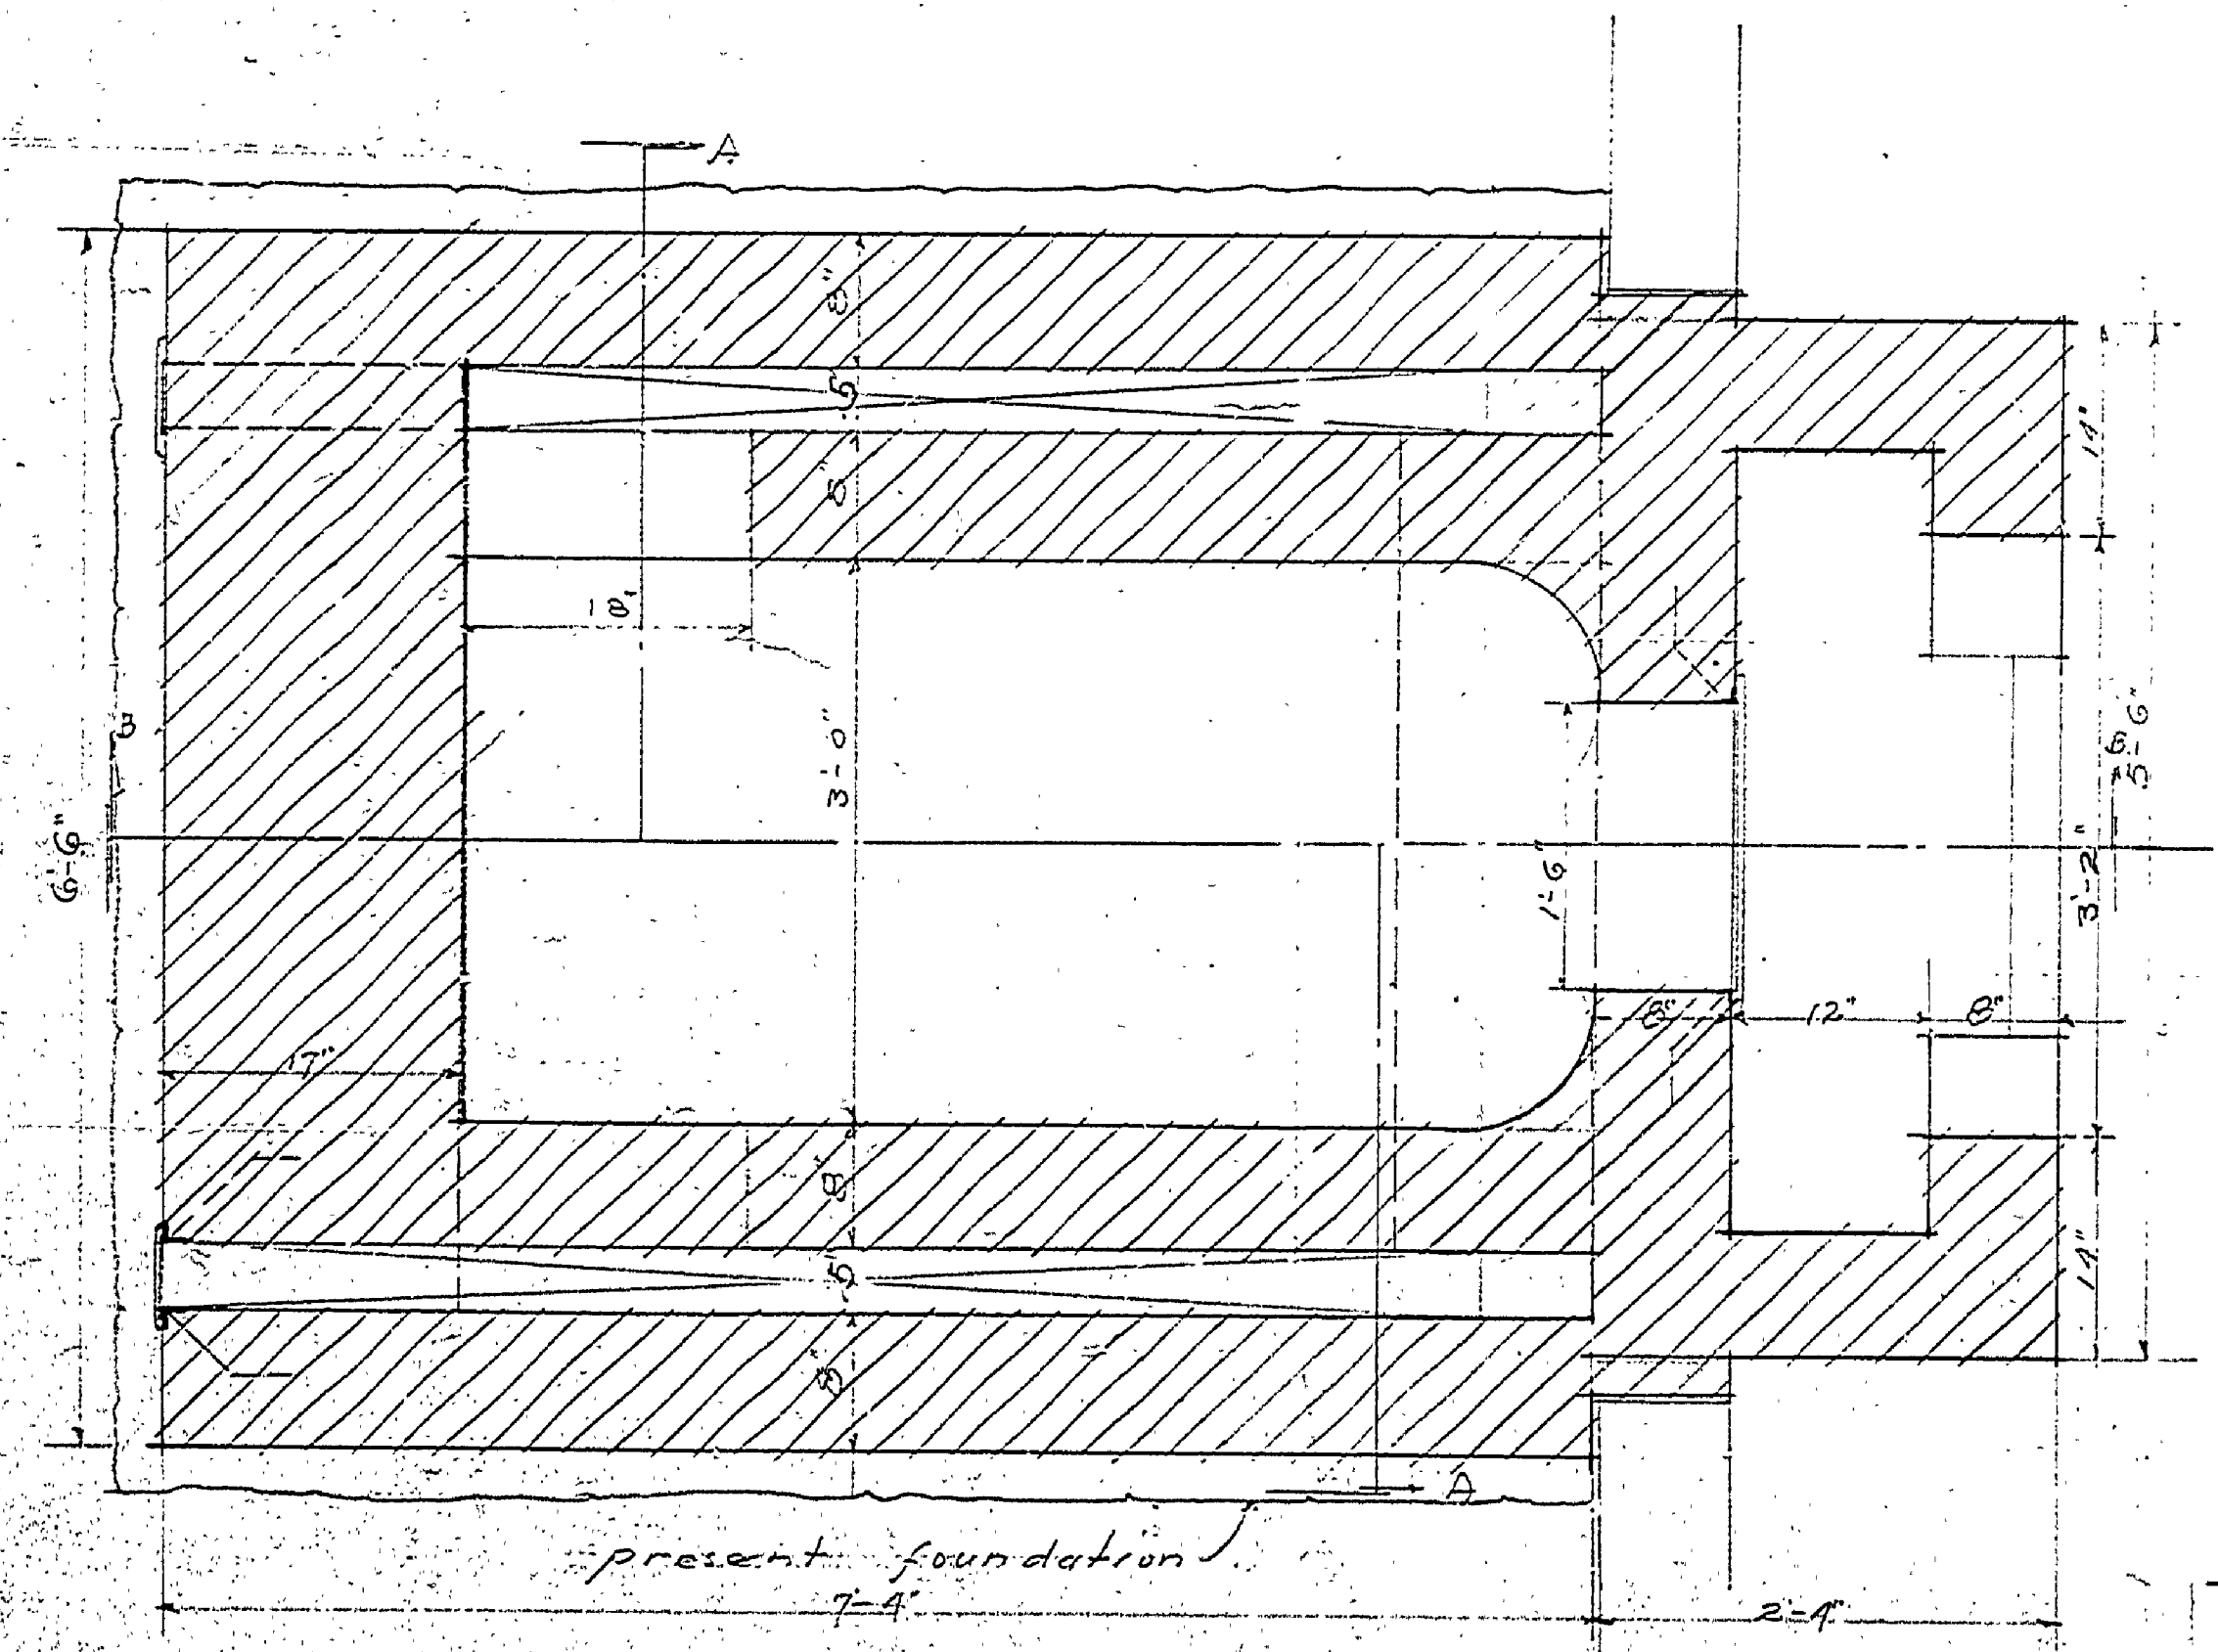

SECTION A-A

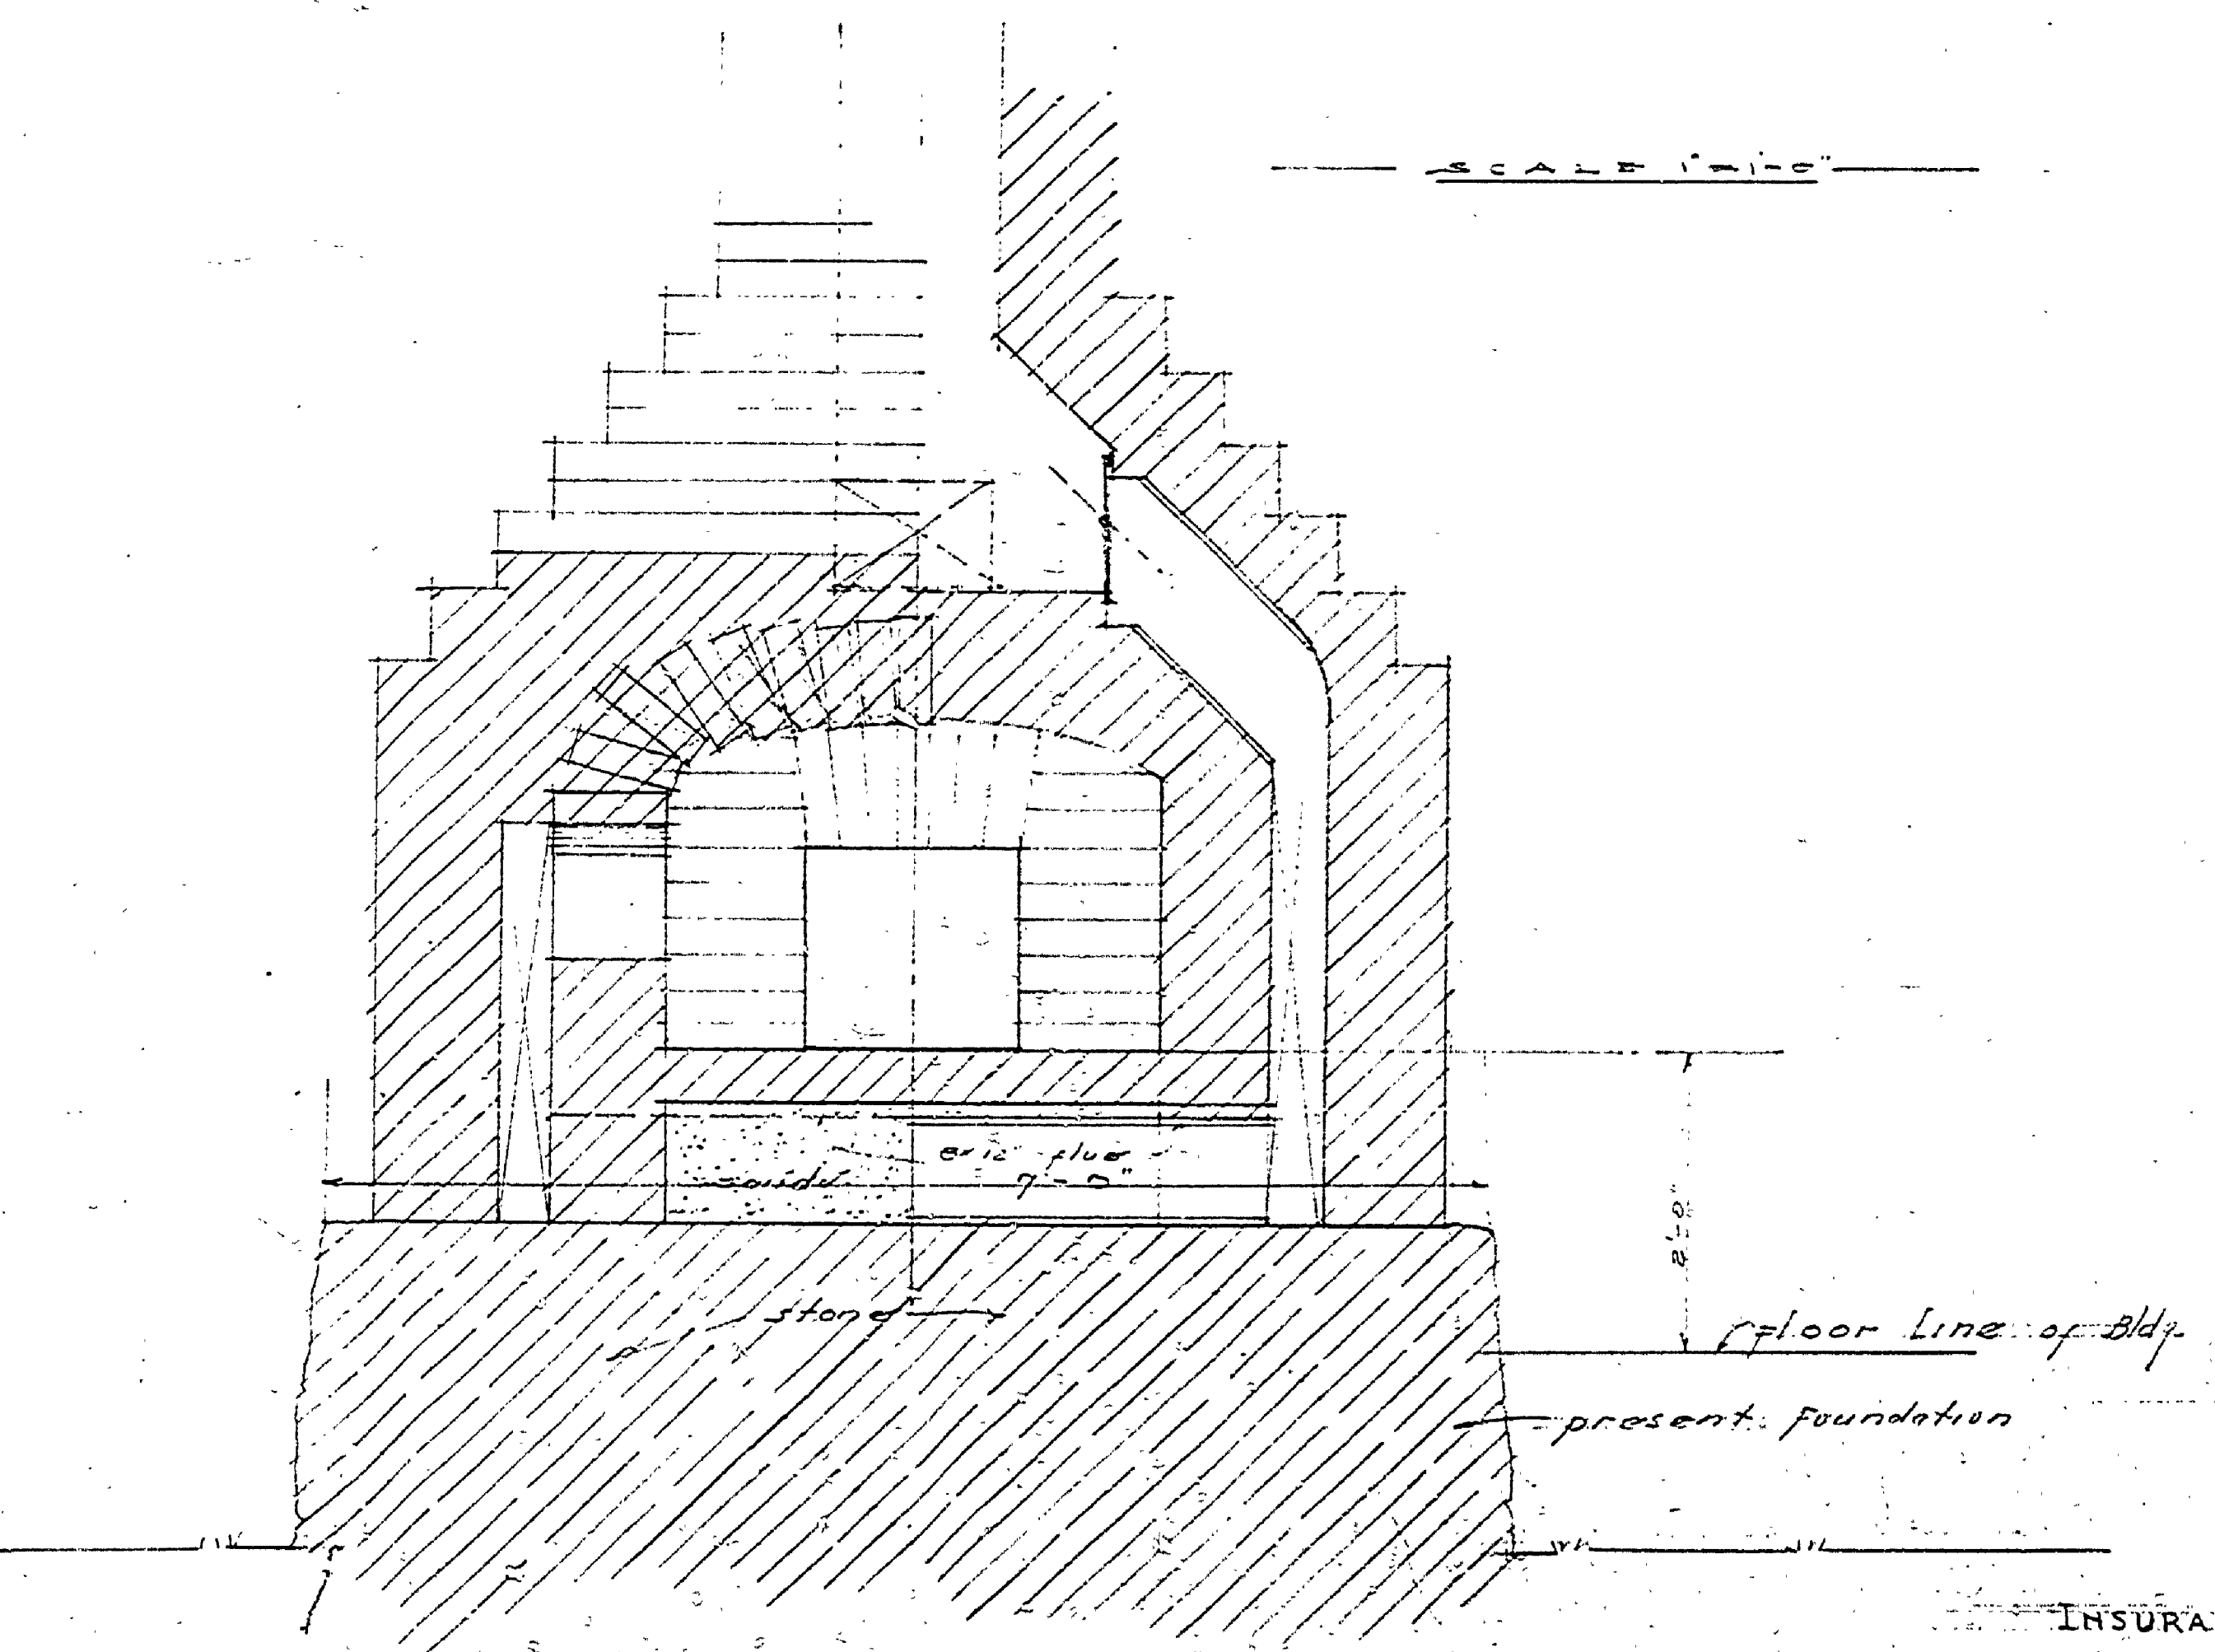

INSURANCE No. 6

A-108-a

MICHIGAN DEPARTMENT OF CONSERVATION PARKS DIVISION		
DRAWN BY C. P. H.	BAKE OVEN DETAILS	PLAN No. 25 Sheet 28 of 33
TRACED BY E. J. WILKINS	E. J. WILKINS	REVISION AS SHOWN
CHECKED BY E. J. WILKINS	E. J. WILKINS	DATE OCT. 20, 1926
APPROVED BY CHIEF OF PARKS DIVISION		DATE