


CHECK ON LOCATION


CHECK ON LOCATION

SCALE 1" = 1'-0"

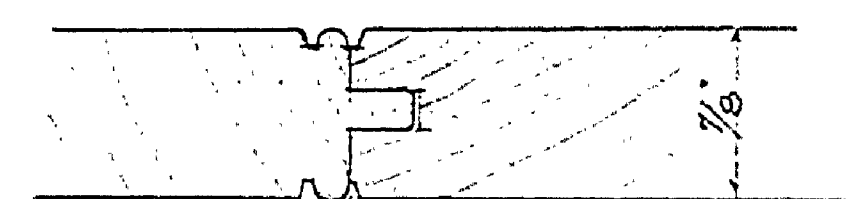

F.S. SECTION A-A


DETAIL OF DOOR FOR SECOND FLOOR & CLOSETS

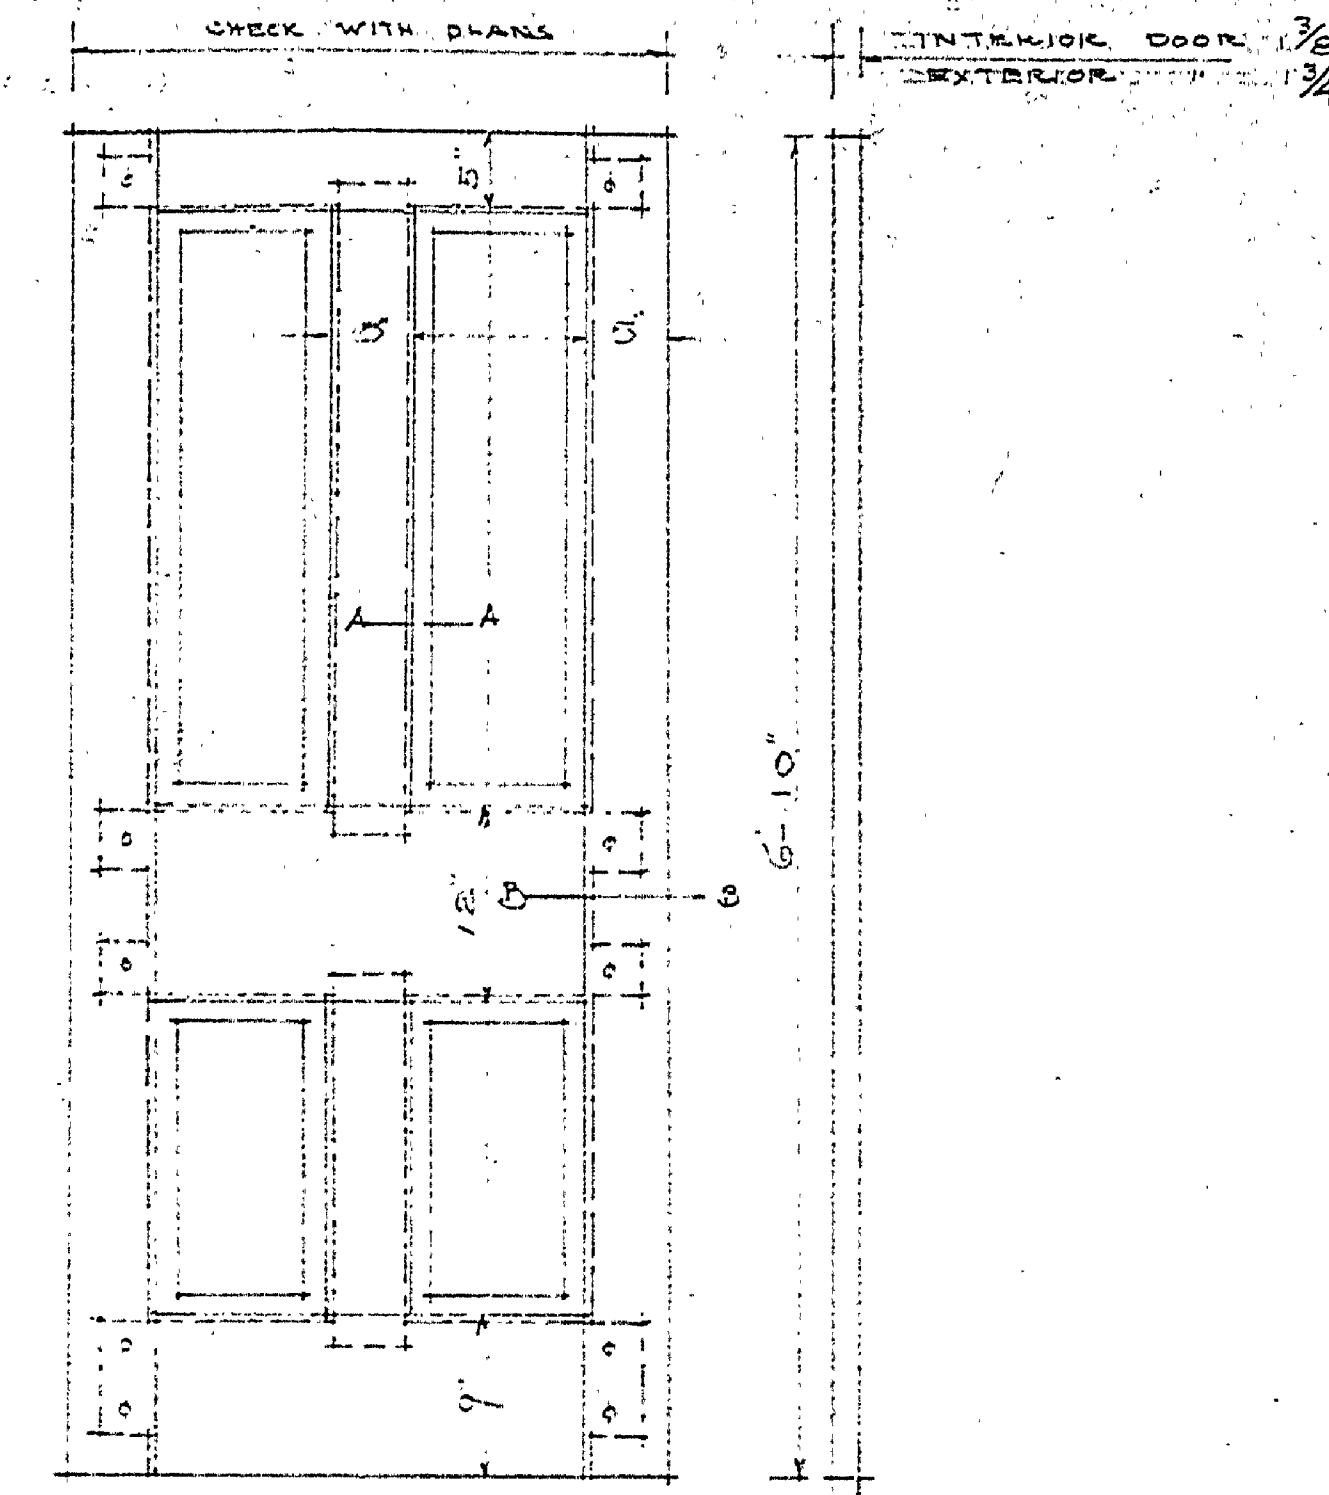


CHECK WITH PLANS

INTERIOR DOOR 7/8"  
EXTERIOR DOOR 1 1/4"

SCALE 1" = 1'-0"

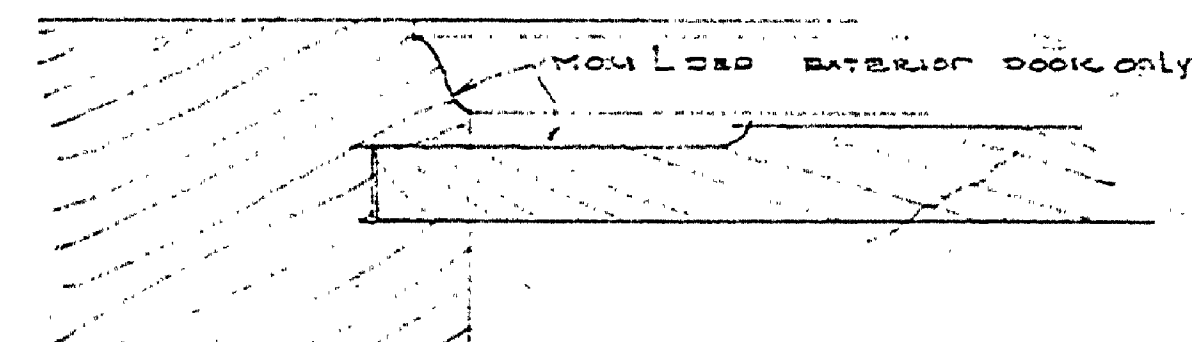

F.S. SECTION A-A

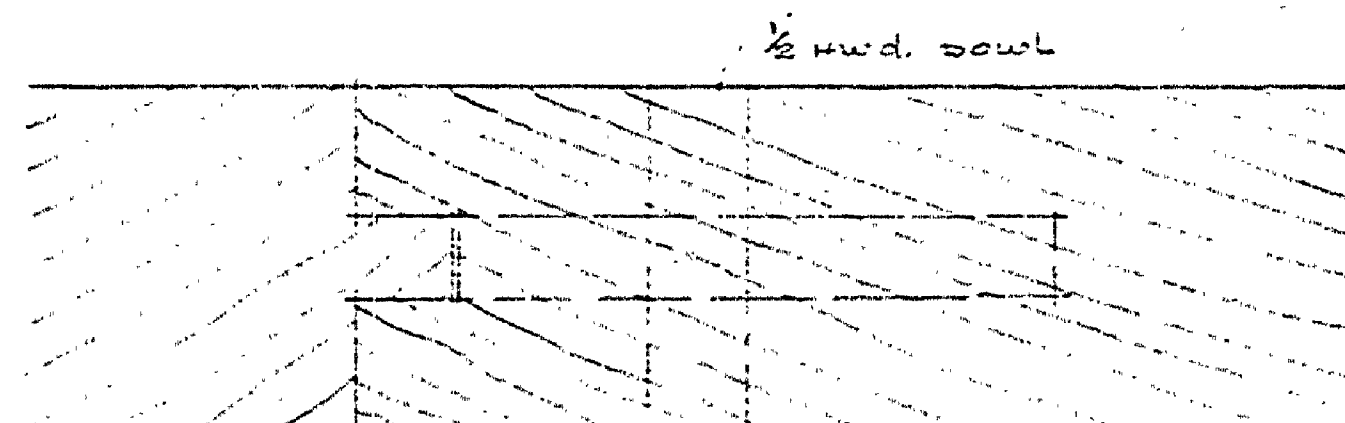

F.S. SECTION B-B

EXTERIOR & INTERIOR DOOR DETAIL

MICHIGAN DEPARTMENT OF CONSERVATION DARKS DIVISION		
DRAWN BY	E. FORT WILKINS	PLANS 14
SCALE	MEASURED DRAWINGS	SCALE
TRACED BY	TYPICAL DETAILS	DATE
APPROVED BY	DOOR	DATE
APPROVED BY	OFFICE OF THE DARKS DIVISION	DATE

INSURANCE No. 14

A-108-e