


BRUNING 8170	NO.	DATE	BY
1	1		
2	2		
3	3		

REVISIONS	NO.	DATE	BY
4	4		
5	5		
6	6		


APPROVED BY	DATE	REVIEWED BY SECTIONS
<i>J.P.R.</i>	8-4-60	ARCHITECTURAL
ASSISTANT CHIEF IN CHARGE	8-4-60	ENGINEERING
OF DESIGN	8-4-60	LANDSCAPE

DRAWN BY	DATE
<i>E.J.P.</i>	11 July 1960


CHECKED BY
<i>E.J.P.</i>

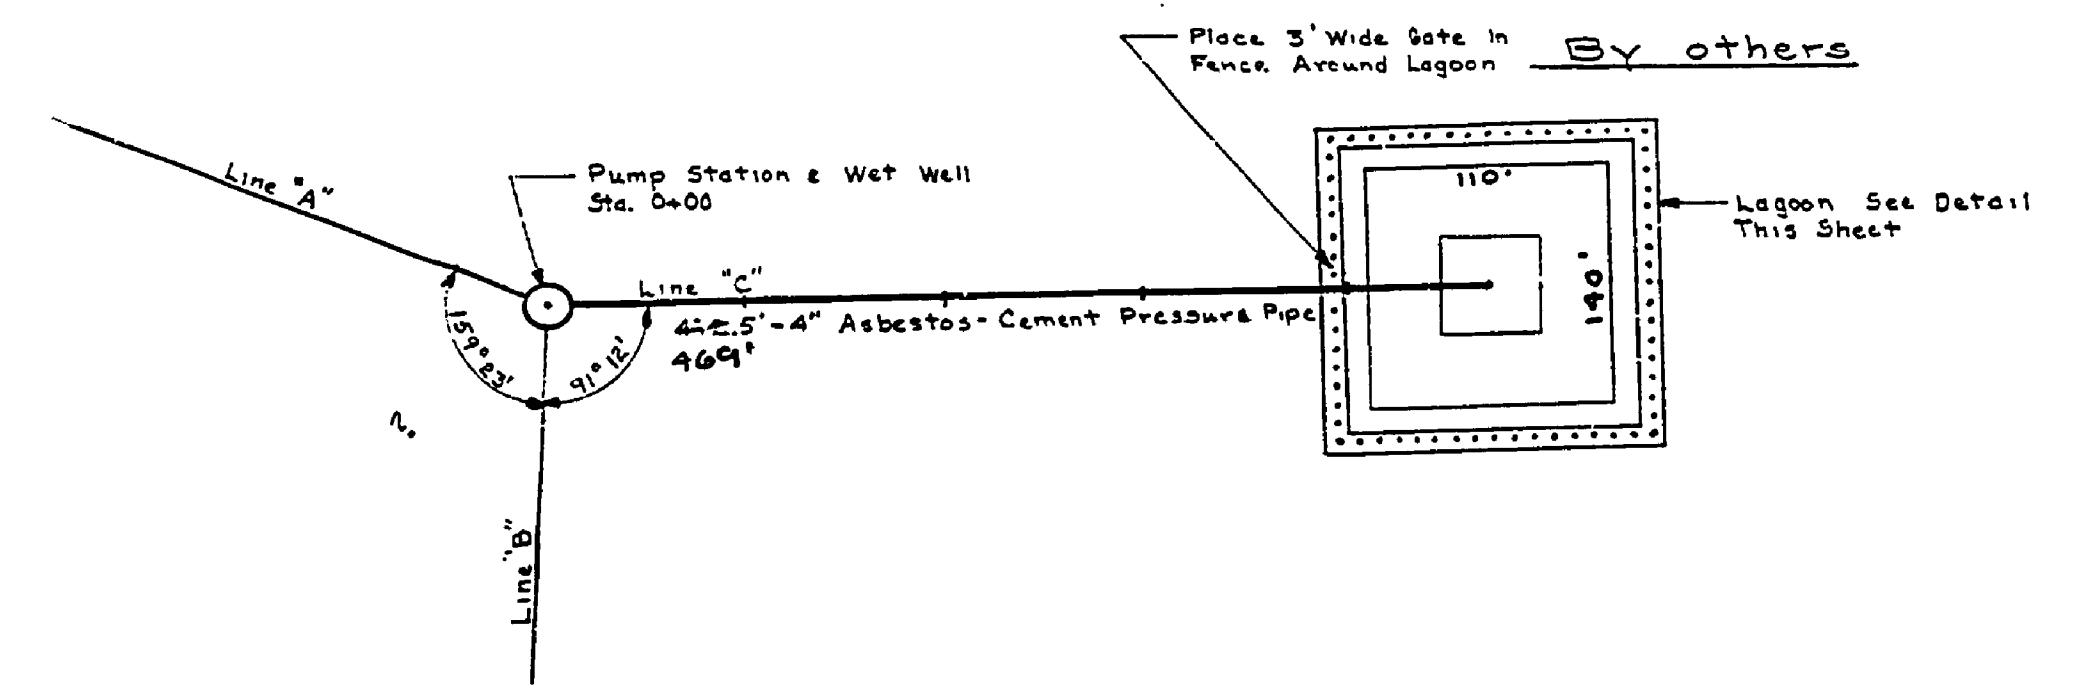

PLAN
Scale 1" = 100'

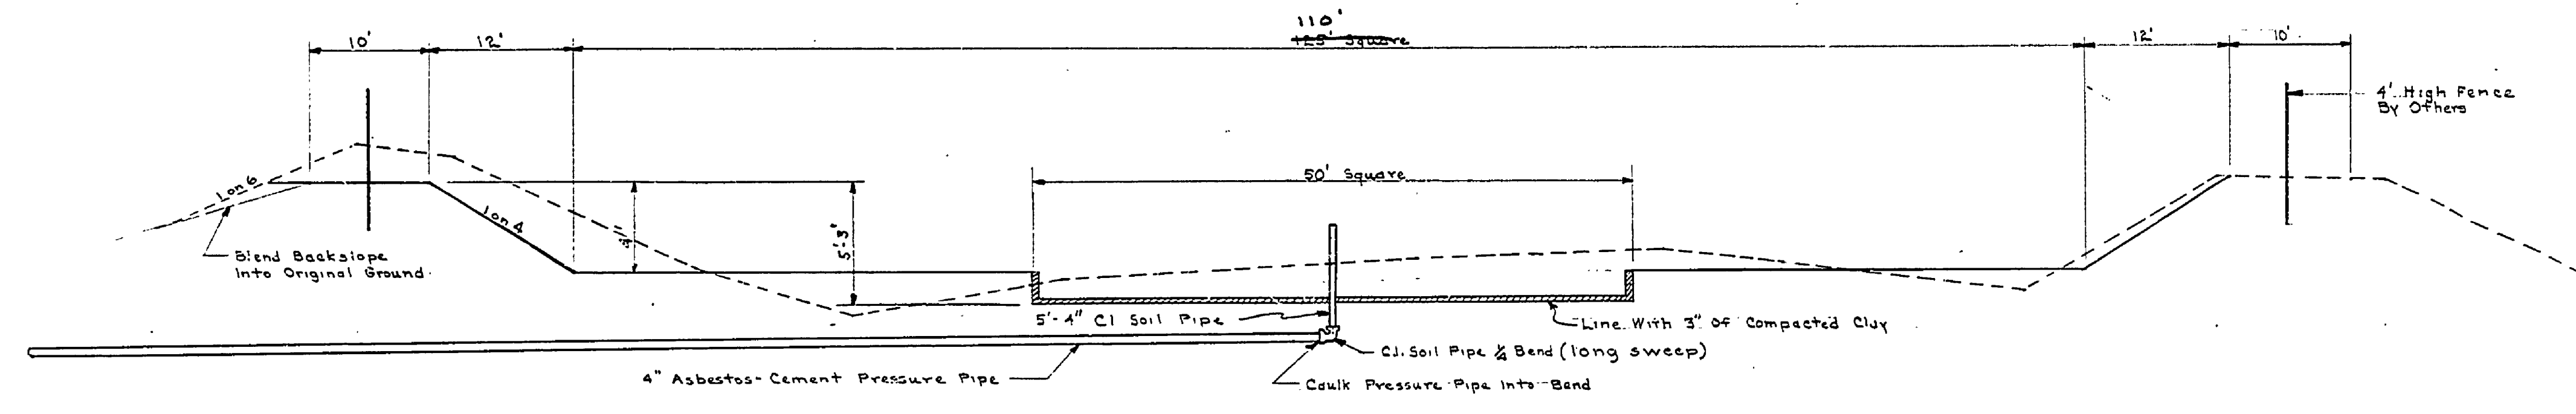

SECTION
LAGOON DETAIL
Scale: Hor. 1" = 10'
Ver. 1" = 5'

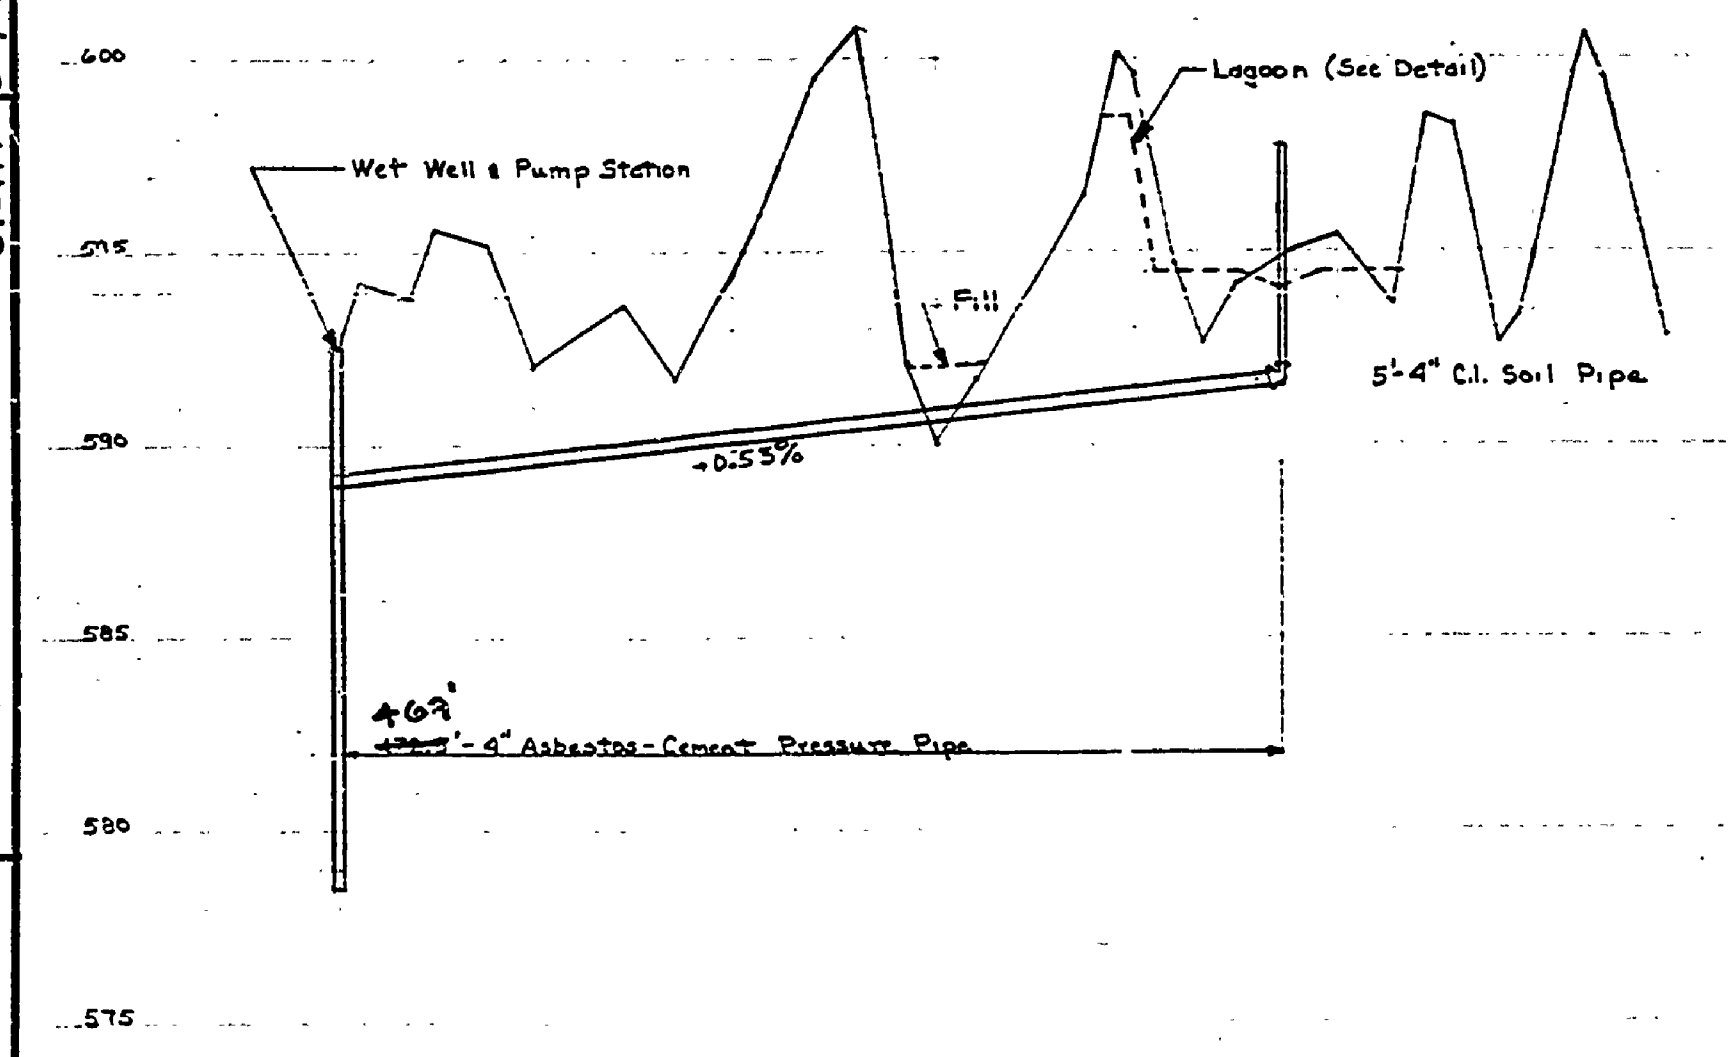

LINE C'

PROFILE
Scale: Hor. 1" = 100'
Ver. 1" = 5'

MICHIGAN
DEPARTMENT OF CONSERVATION
PARKS AND RECREATION DIVISION

SLEEPER STATE PARK
CENTRAL SEWAGE DISPOSAL SYSTEM
Scale As Shown

SHEET
NO. 3
OF 6

PLAN NO.
E-117