


NOTE: Shut-off valve in service box. Open faucet on fountain and pump air through sniffer valve for winter shut down.

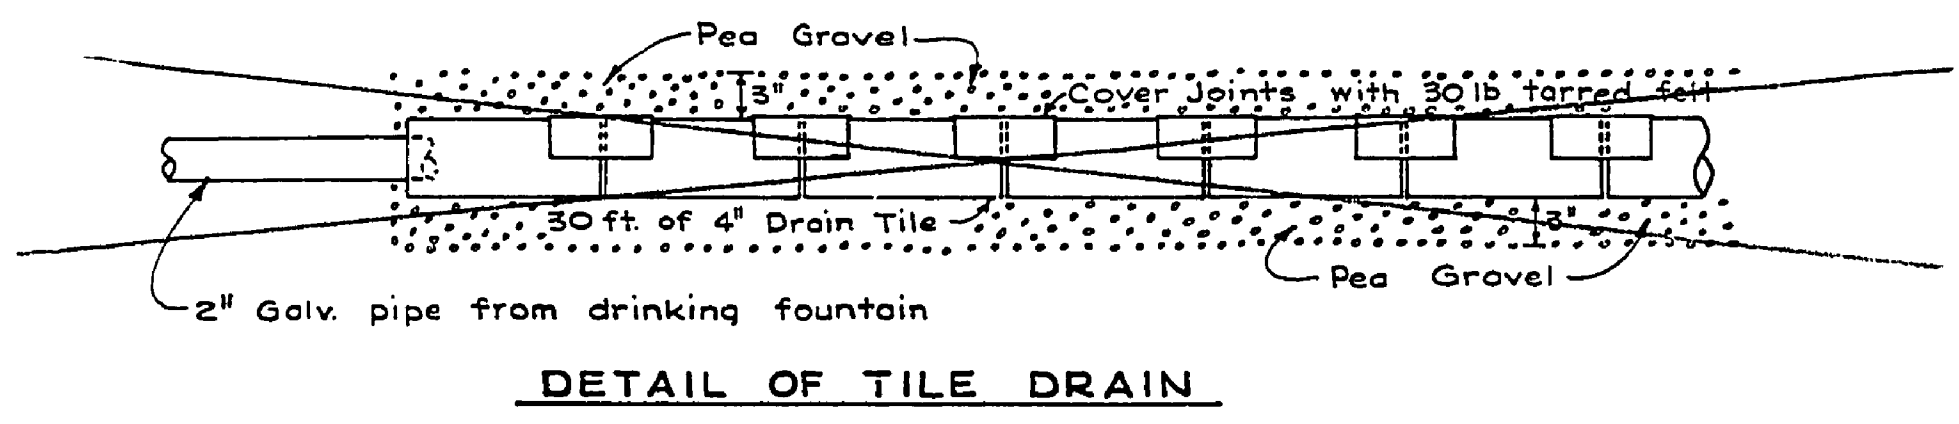

SURVEYED BY	DRAWN BY	COTE	NO.	DATE	BY	REVISIONS	NO.	DATE	BY	REVISIONS
DESIGNED BY BARKER	Oct '61	CHECKED BY W.H.E.	1.	Sept '60			3.			
	DATE		2.	9-65			4.			

MICHIGAN DEPARTMENT OF CONSERVATION

DRINKING FOUNTAIN PLAN

SHEET NO. \_\_\_\_\_ OF \_\_\_\_\_  
SLEEPER STATE PARK  
FOR PROJECT NO. PA999-3972-376-031  
SHEET 6 OF 8 PLAN NO. E-118