




LEGEND

EXIST. CAMPSITE BOUNDARY ———

CAMPSITE BOUNDARY REMOVED - - - - -

PROPOSED CAMPSITE BOUNDARY - · - · -

NUMBER OF CAMPSITE REMOVED 24

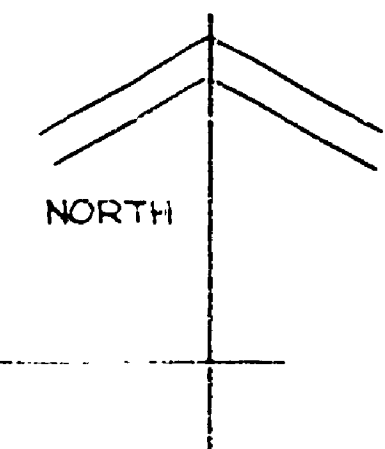

NOTE

21 CAMPSITES ARE ELIMINATED LEAVING A TOTAL OF 152 SITES ON THE WEST SIDE OF THE ENTRANCE

REVIEWED BY: James Home 6-6-74
 IN CHARGE - PLANNING AND DESIGN DATE

APPROVED BY: [Signature] 6-10-74
 CHIEF - PARKS DIVISION DATE

DESIGNED BY O.L.M.	DRAWN BY O.L.M.	NO. 1	DATE 6-2-74	BY	REVISIONS	NO. 1	DATE	BY	REVISIONS	MICHIGAN DEPARTMENT OF NATURAL RESOURCES	CAMPGROUND IMPROVEMENTS WEST SIDE SHEET TITLE	AREA OR PARK SLEEPER STATE PARK	PROJECT	PROJECT NO.	SHEET 1 OF 1	PLAN NO. L-112
-----------------------	--------------------	-------	-------------	----	-----------	-------	------	----	-----------	--	---	------------------------------------	---------	-------------	--------------	----------------