


REVISED FLOOR PLAN

Scale 1/4"=1'-0"

NOTE: For Elevations See Sheets 4 & 7 of Plans sent Nov. 6<sup>th</sup> 1932.

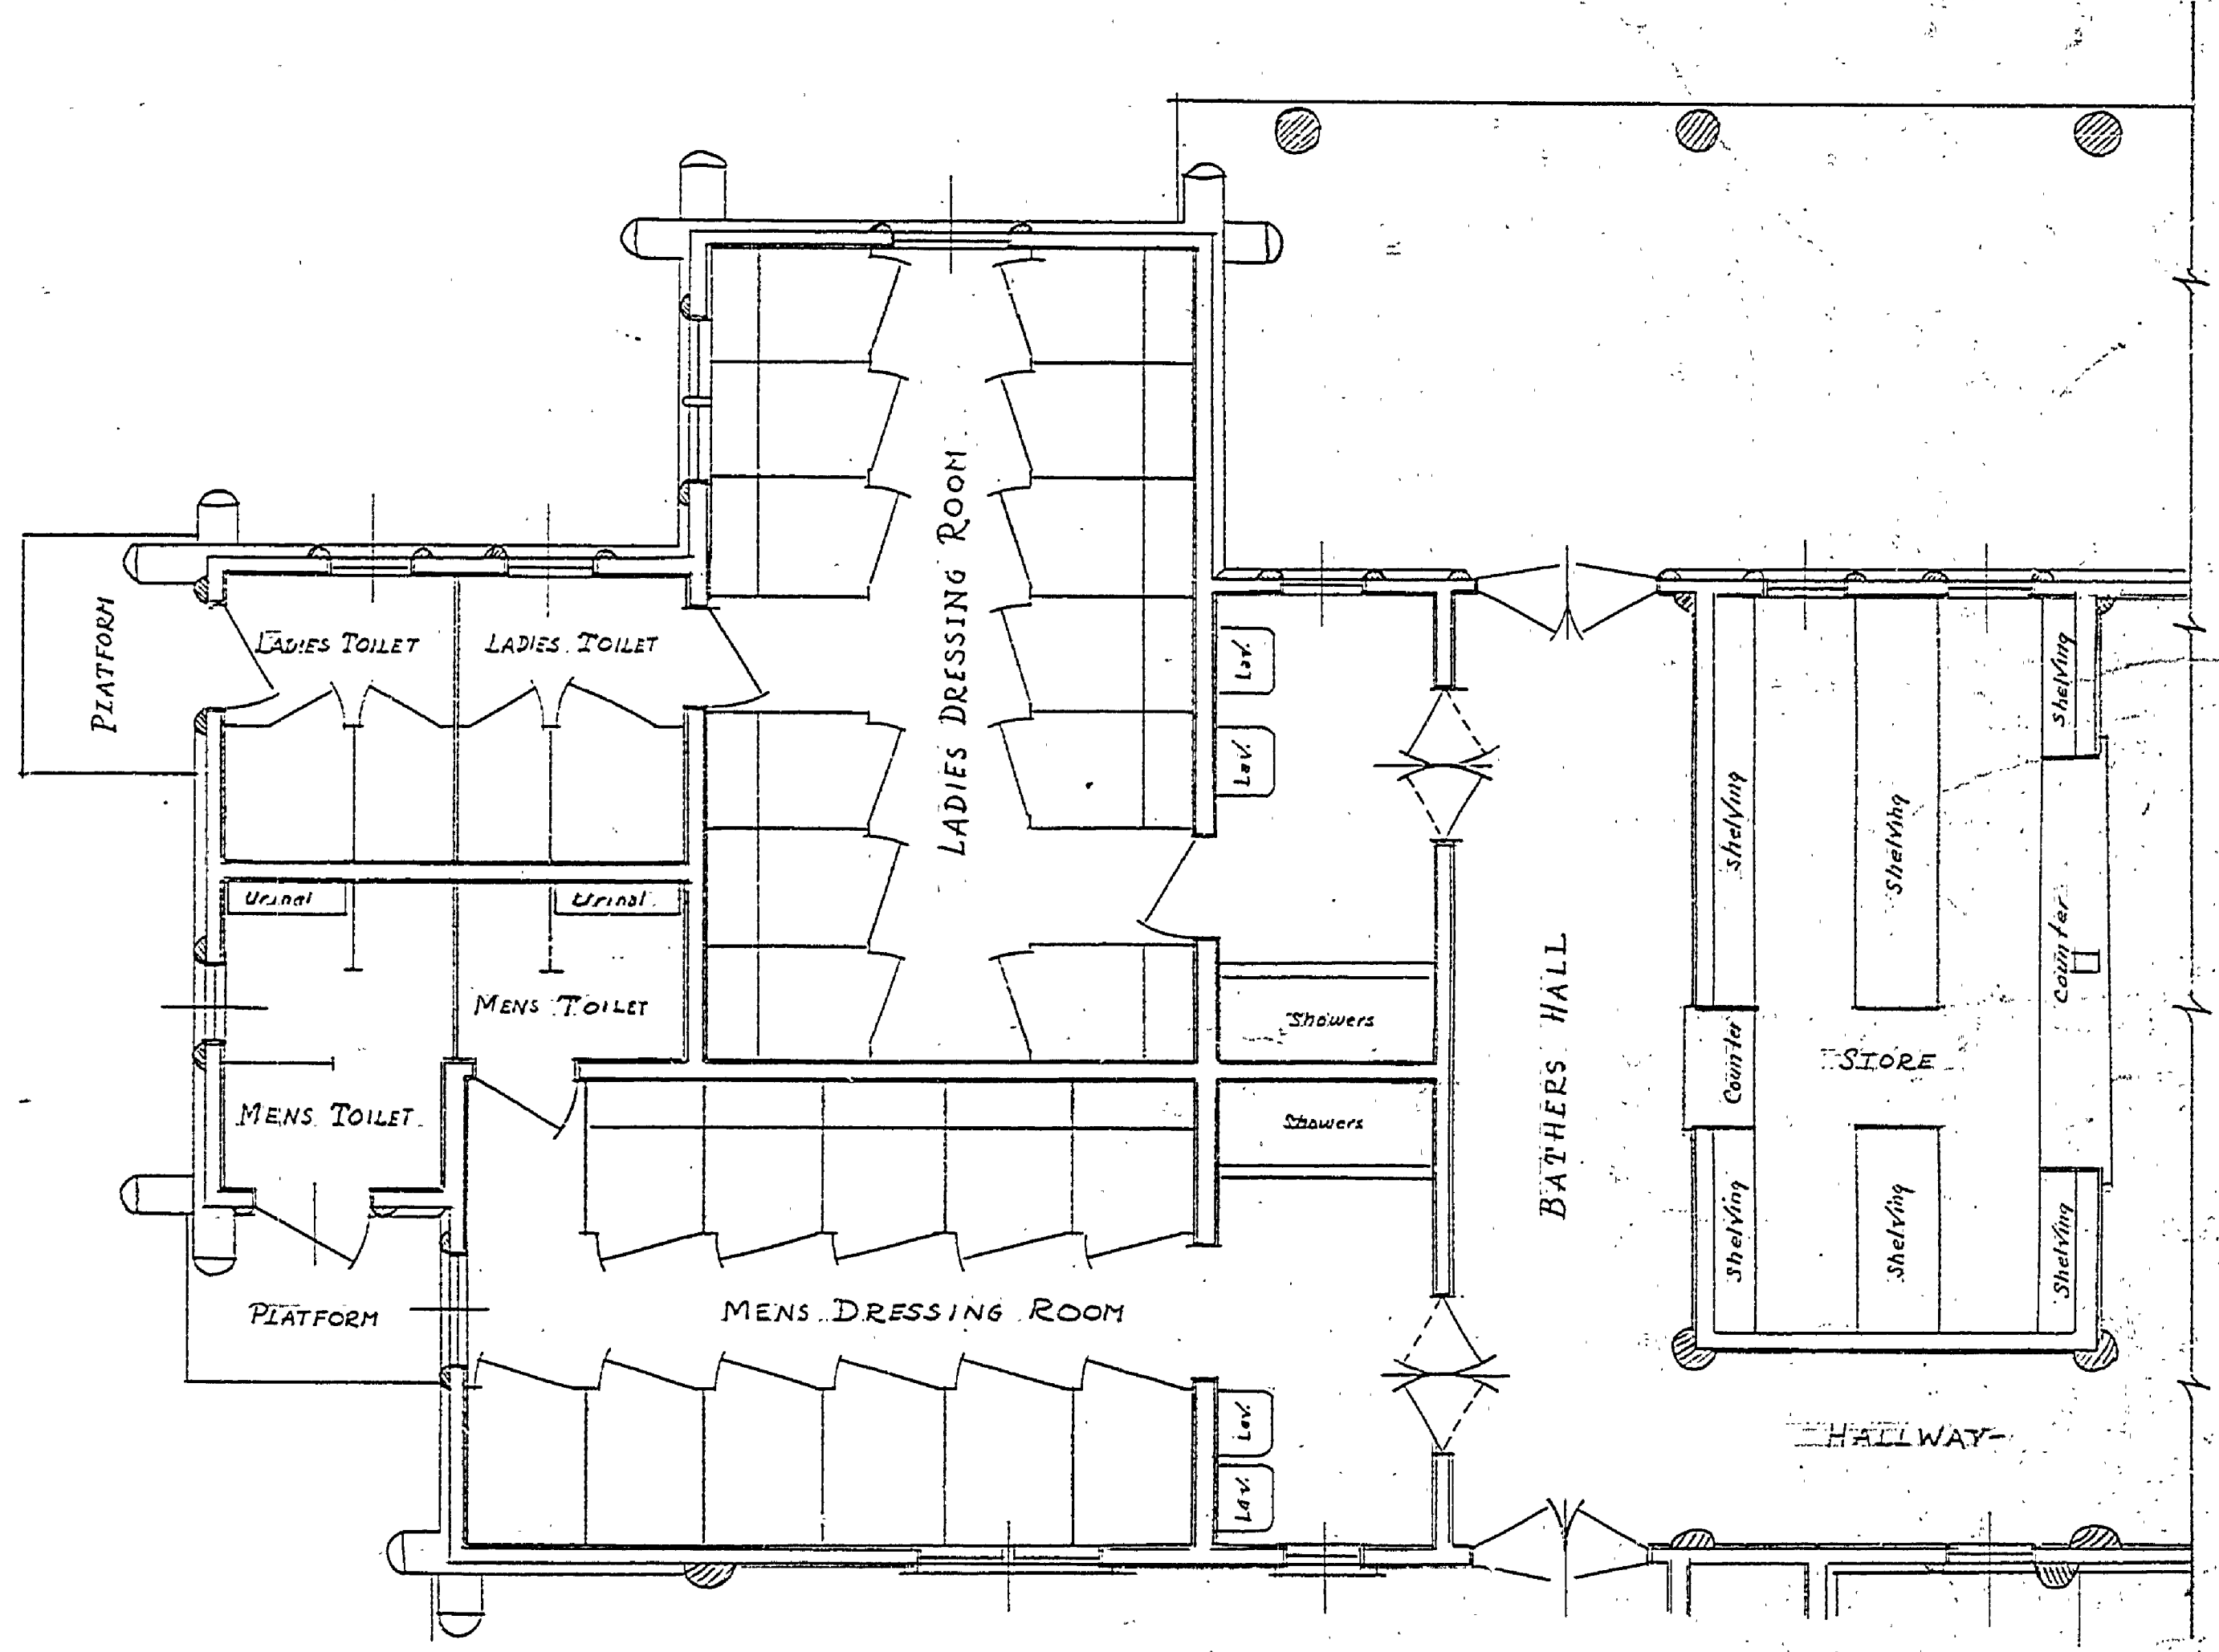

ORIGINAL FLOOR PLAN

Scale 1/4"=1'-0"

NOTE: For Elevations See Sheets 4 & 5 of Plans sent Sept. 18<sup>th</sup> 1932.

NOTE OF CHANGES IN PLANS

OF

PAVILION

FOR HIGGINS LAKE & YOUNG'S STATE PARKS

Date: Nov. 10<sup>th</sup> 1932

EBH:JSCW

Sheet 7

INSURANCE No. 1  
MASTER PLAN BLDG. # 4

CHANGES: 1. Urinals Relocated On Dwg. To conform with Structural, 10-9-32

117-101