


HIGGINS LAKE

DESIGNED BY	DRAWN BY	CHECKED BY	DATE	REVIEWED	DATE	APPROVED	DATE	NO.	DATE	BY	REVISIONS
E.H.G.	E.H.G.	E.H.G.	4-1-62	W.L.C.	4-1-62	<i>[Signature]</i>	4-1-62	1	4-1-62	E.H.G.	Replaces Plan No. E-49 Dated Jan. 1961
E.H.G.	S.P.P.	S.P.P.	4-1-62	S.P.P.	4-1-62	<i>[Signature]</i>	4-1-62	2	4-1-62	S.P.P.	Revised As Constructed
E.H.G.	E.J.P.	E.J.P.	4-1-62	E.J.P.	4-1-62	<i>[Signature]</i>	4-1-62	3	4-1-62	E.J.P.	
								4			
								5			
								6			

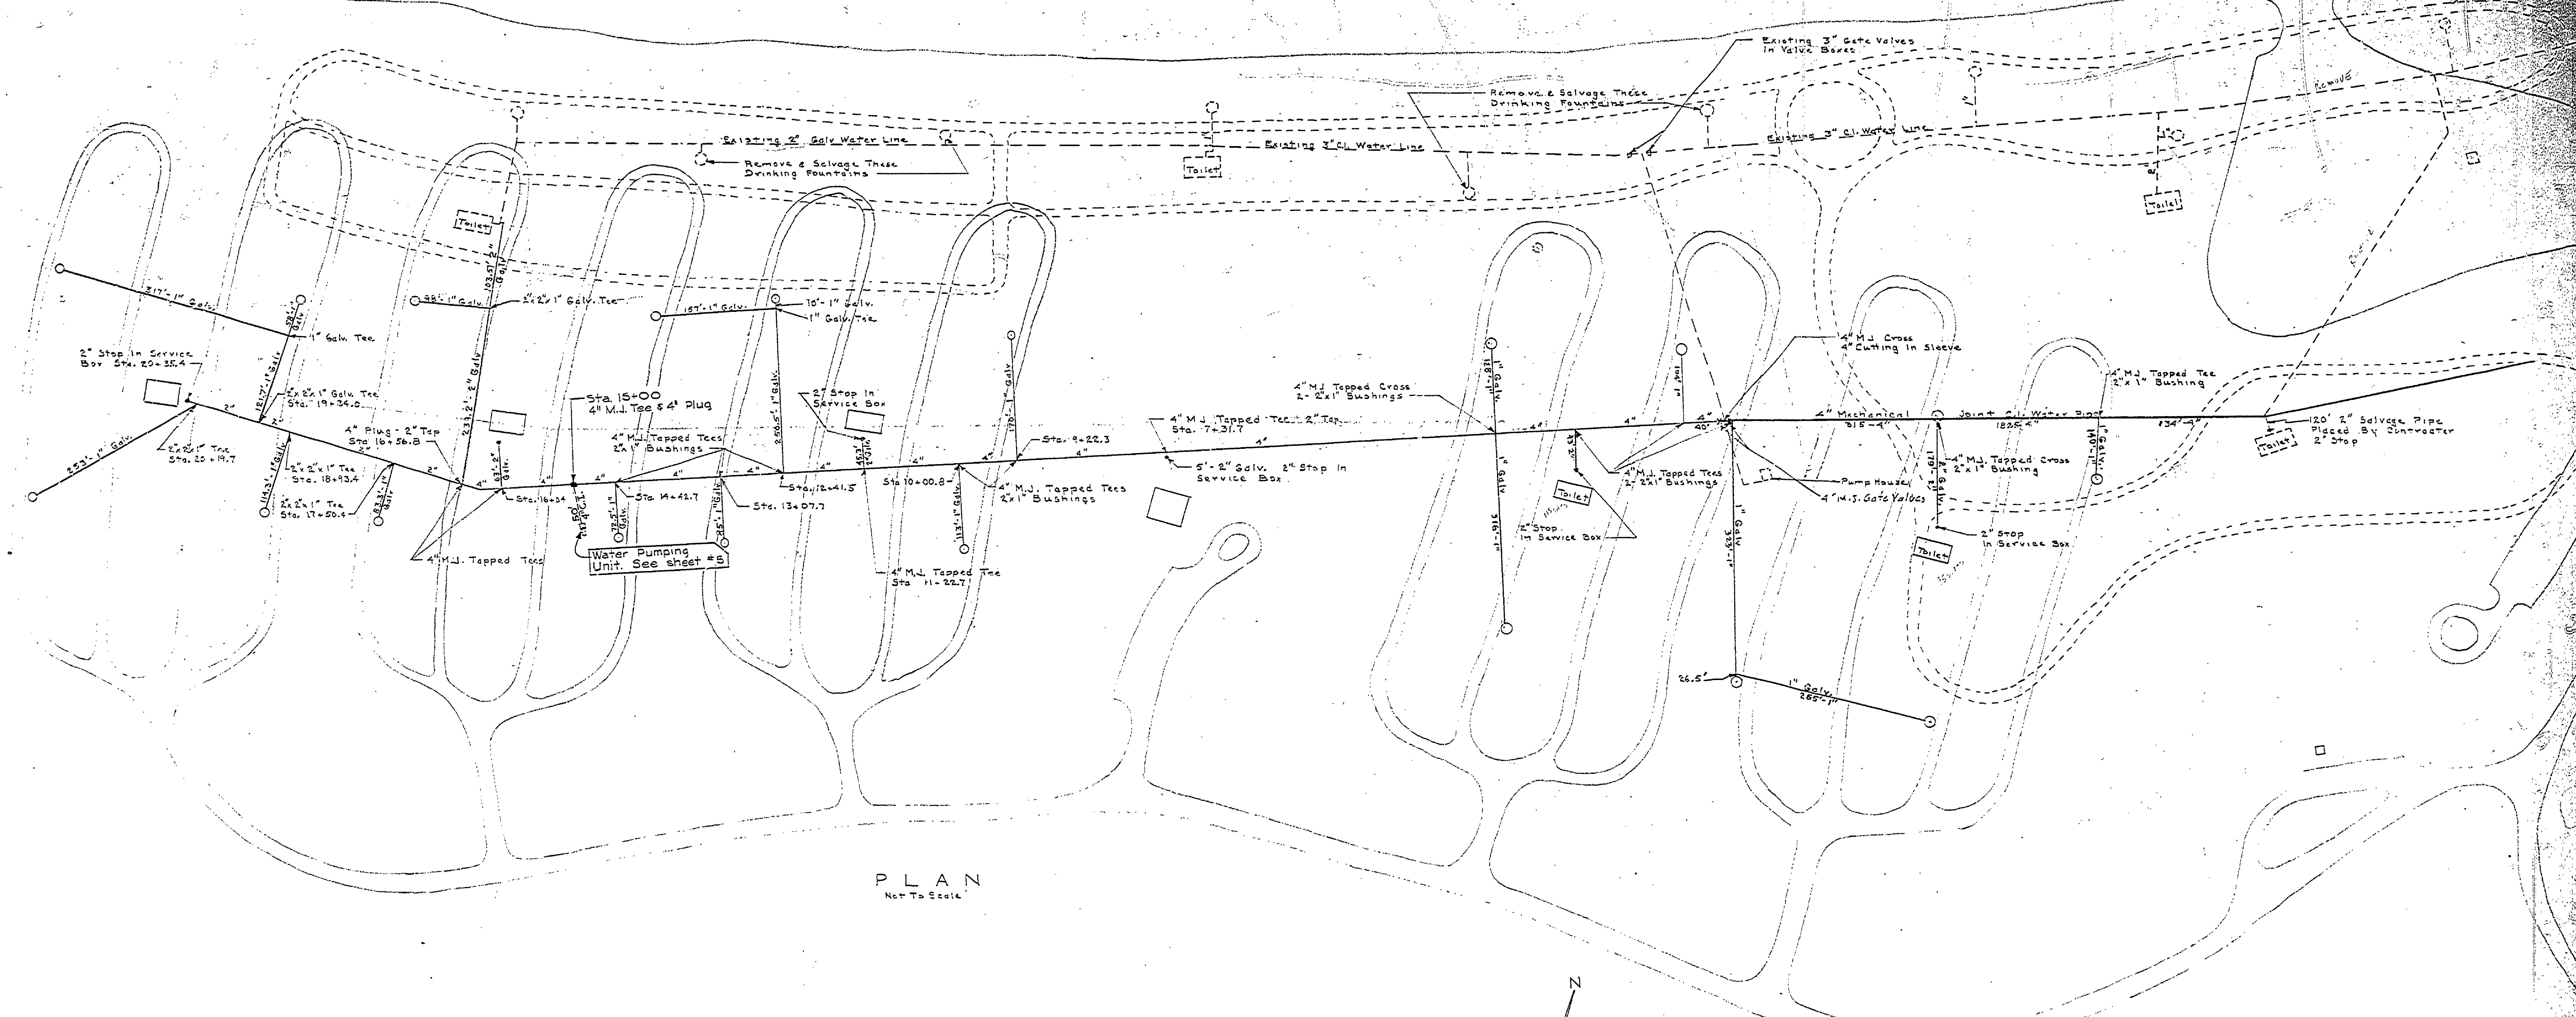

PLAN
Not To Scale

- KEY**
- Existing Construction
 - - - Proposed Construction (Completed 1962)
 - Existing Drinking Fountains
 - Proposed Drinking Fountain

NOTES: All Water Lines Are To Be Laid With 2 Min. 24" x 4" 90° Cover Unless Noted Existing Lines And Fountains Are To Be Left In Place.

