

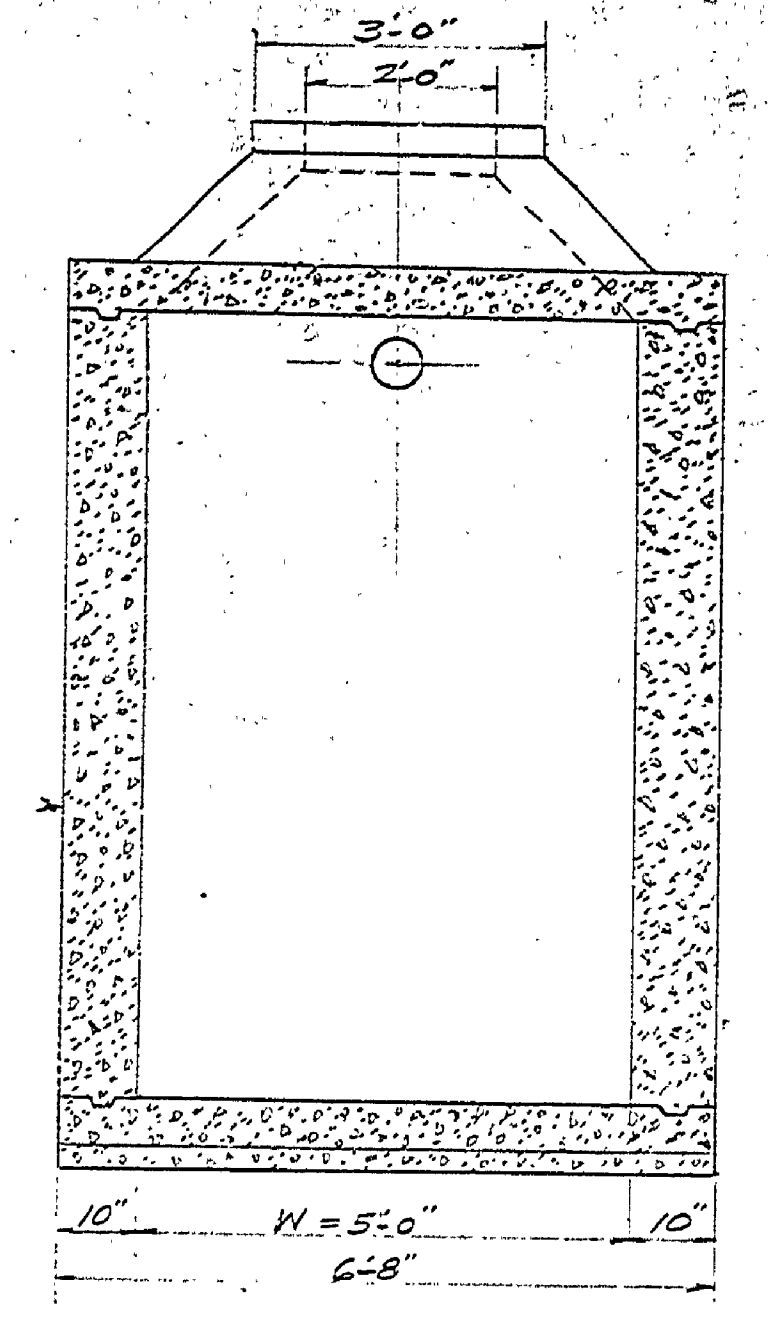
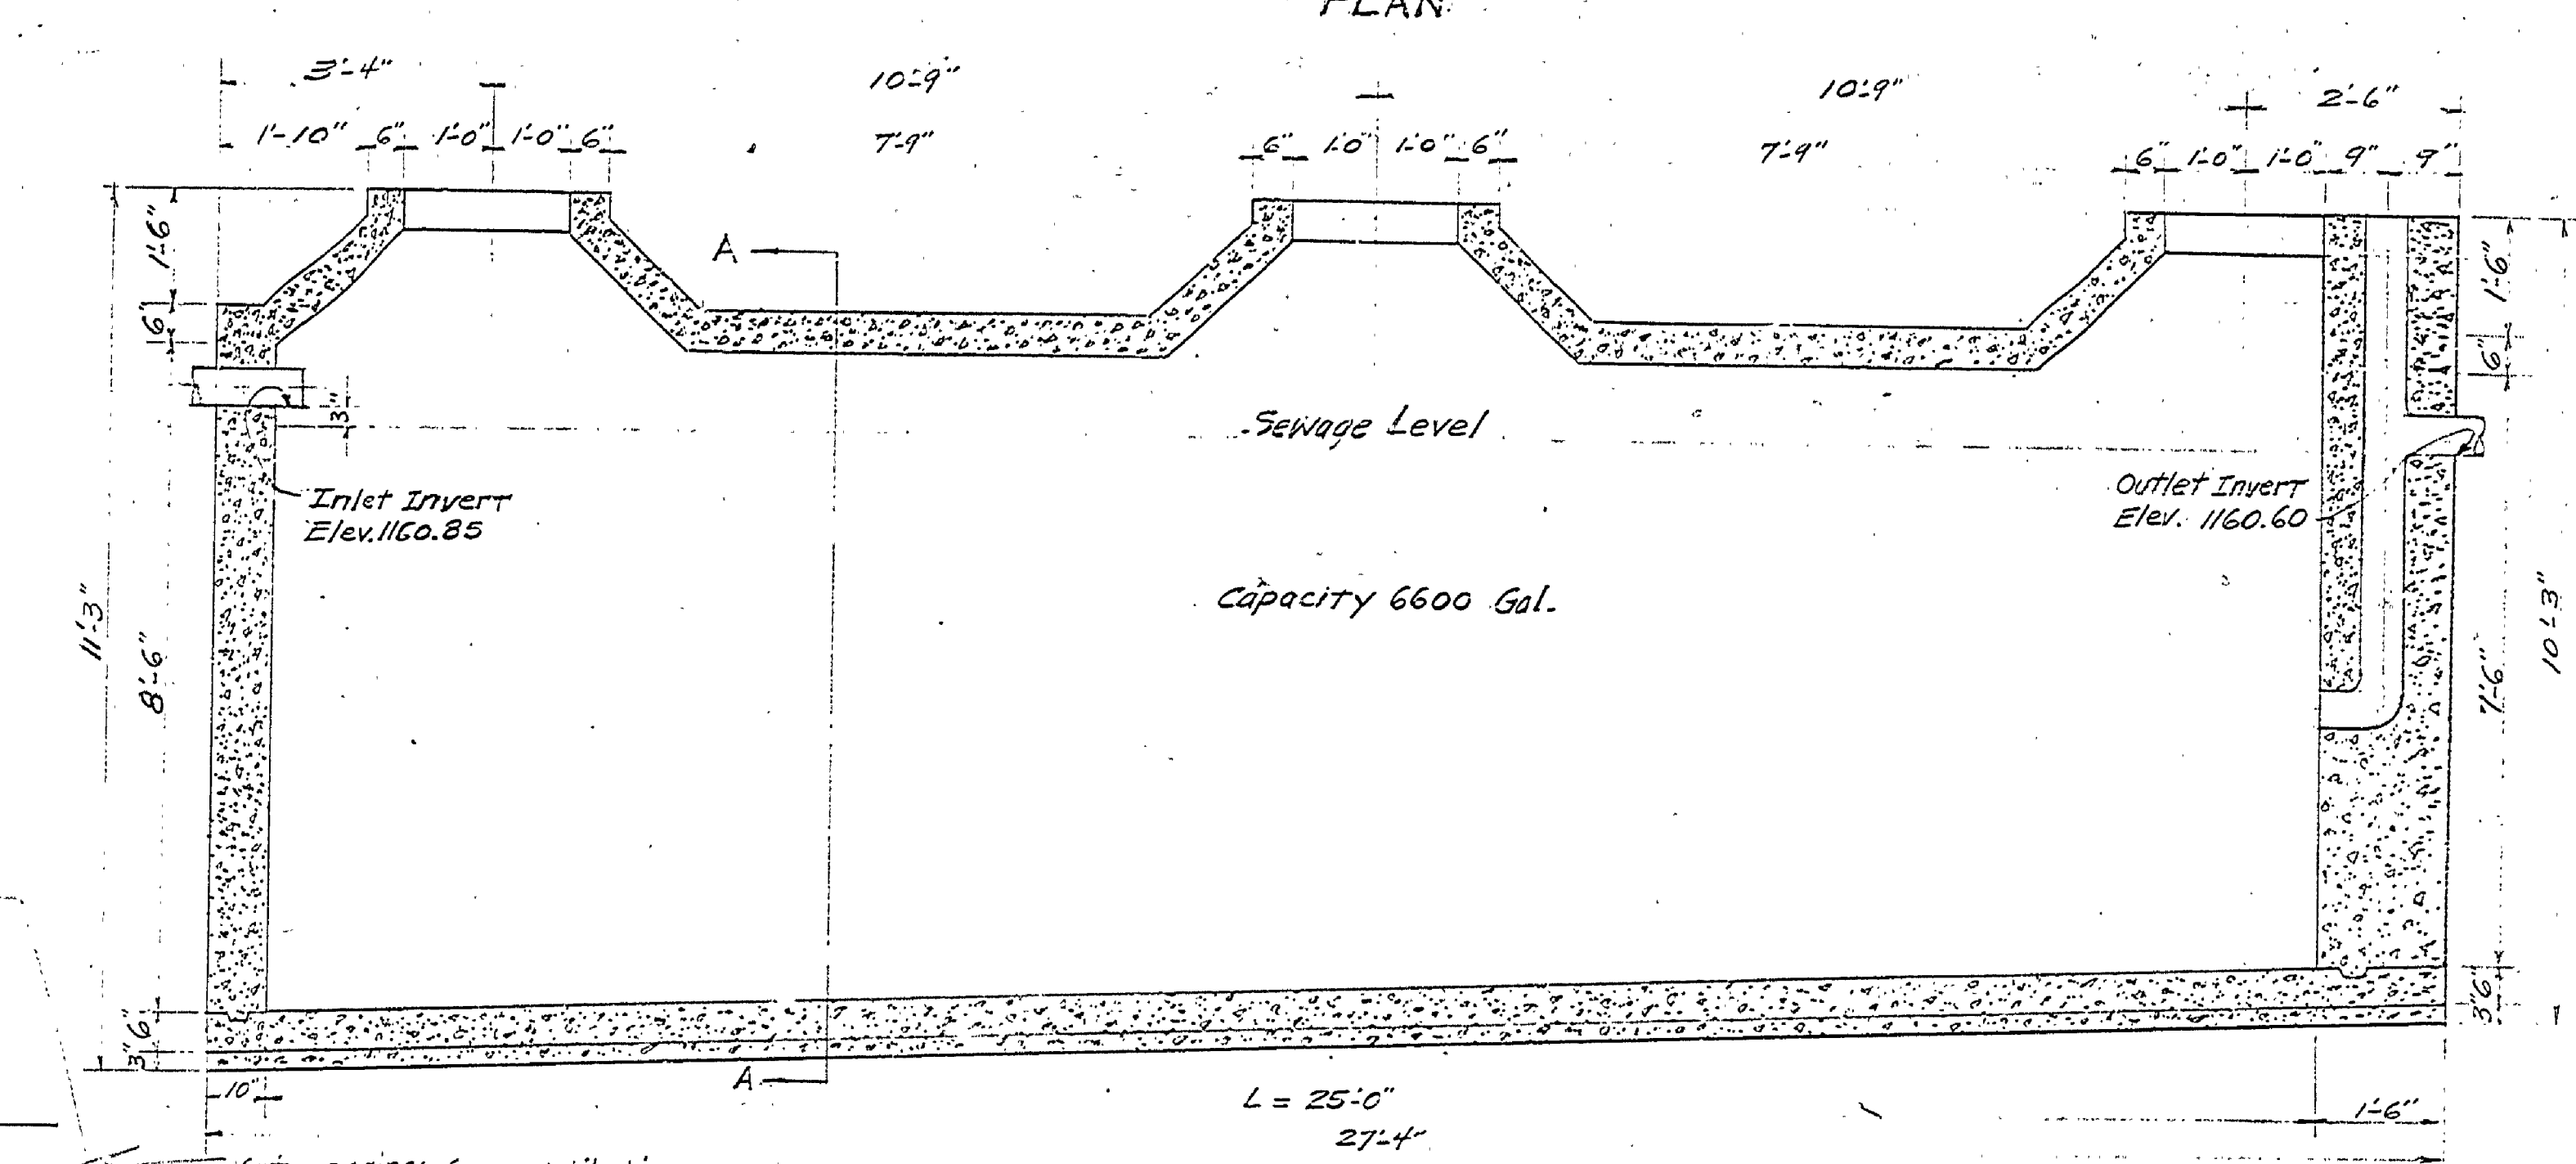
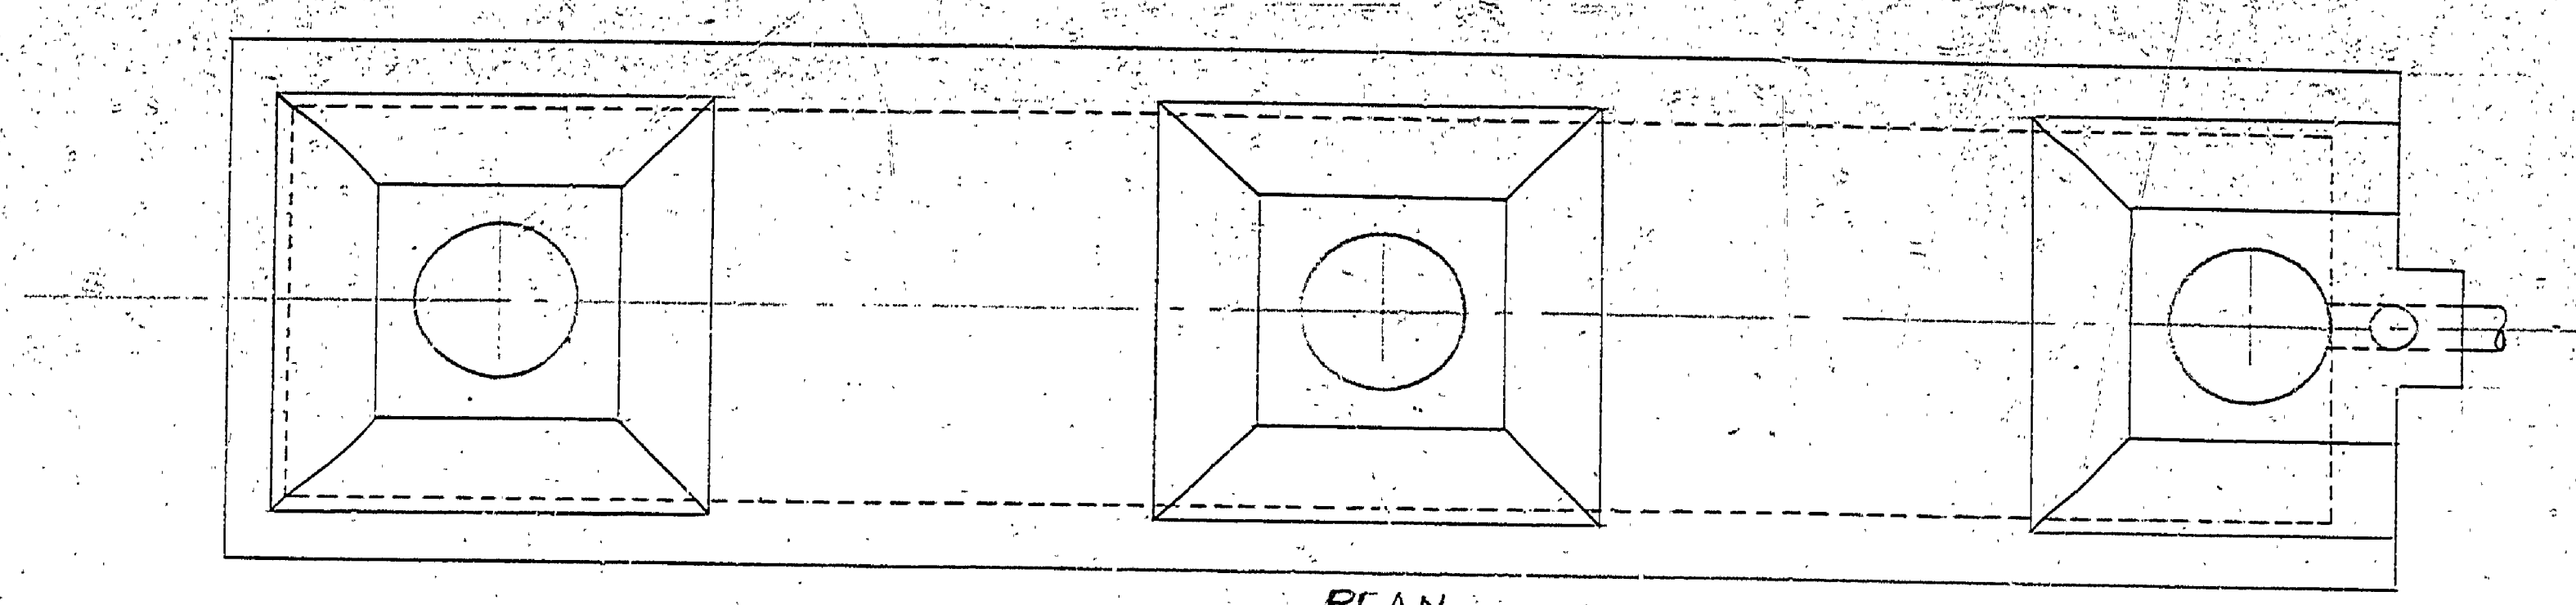
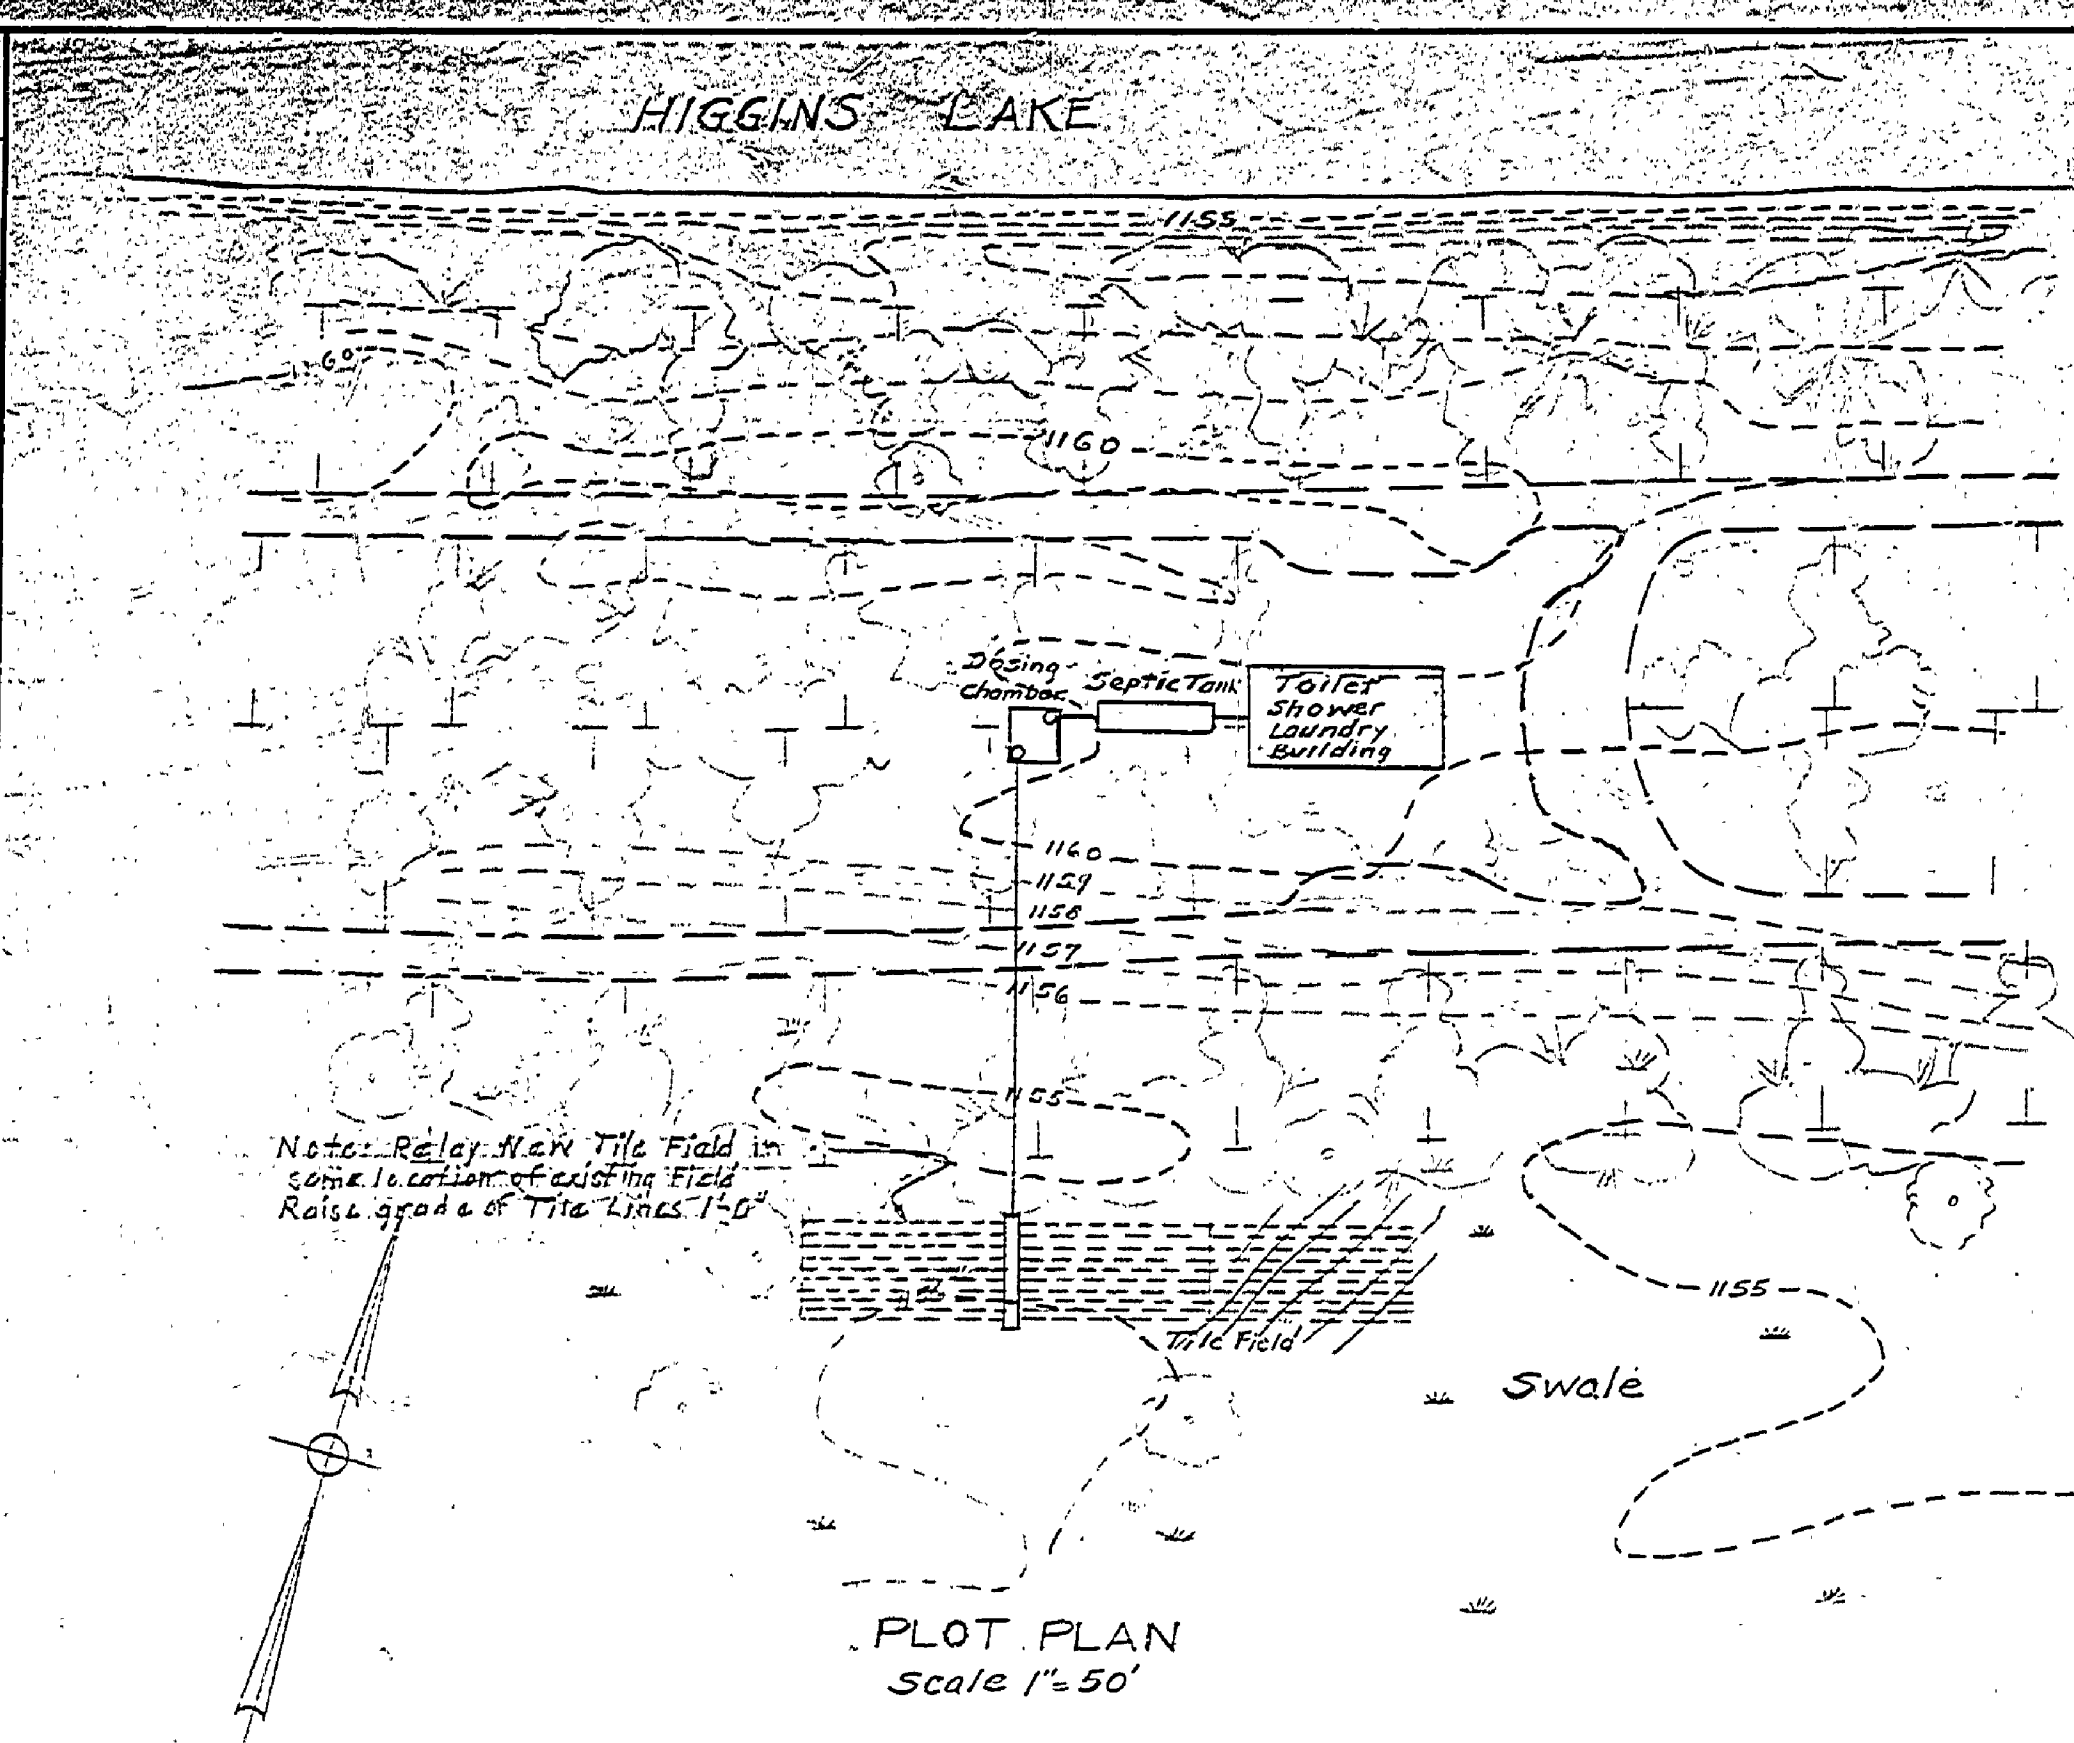
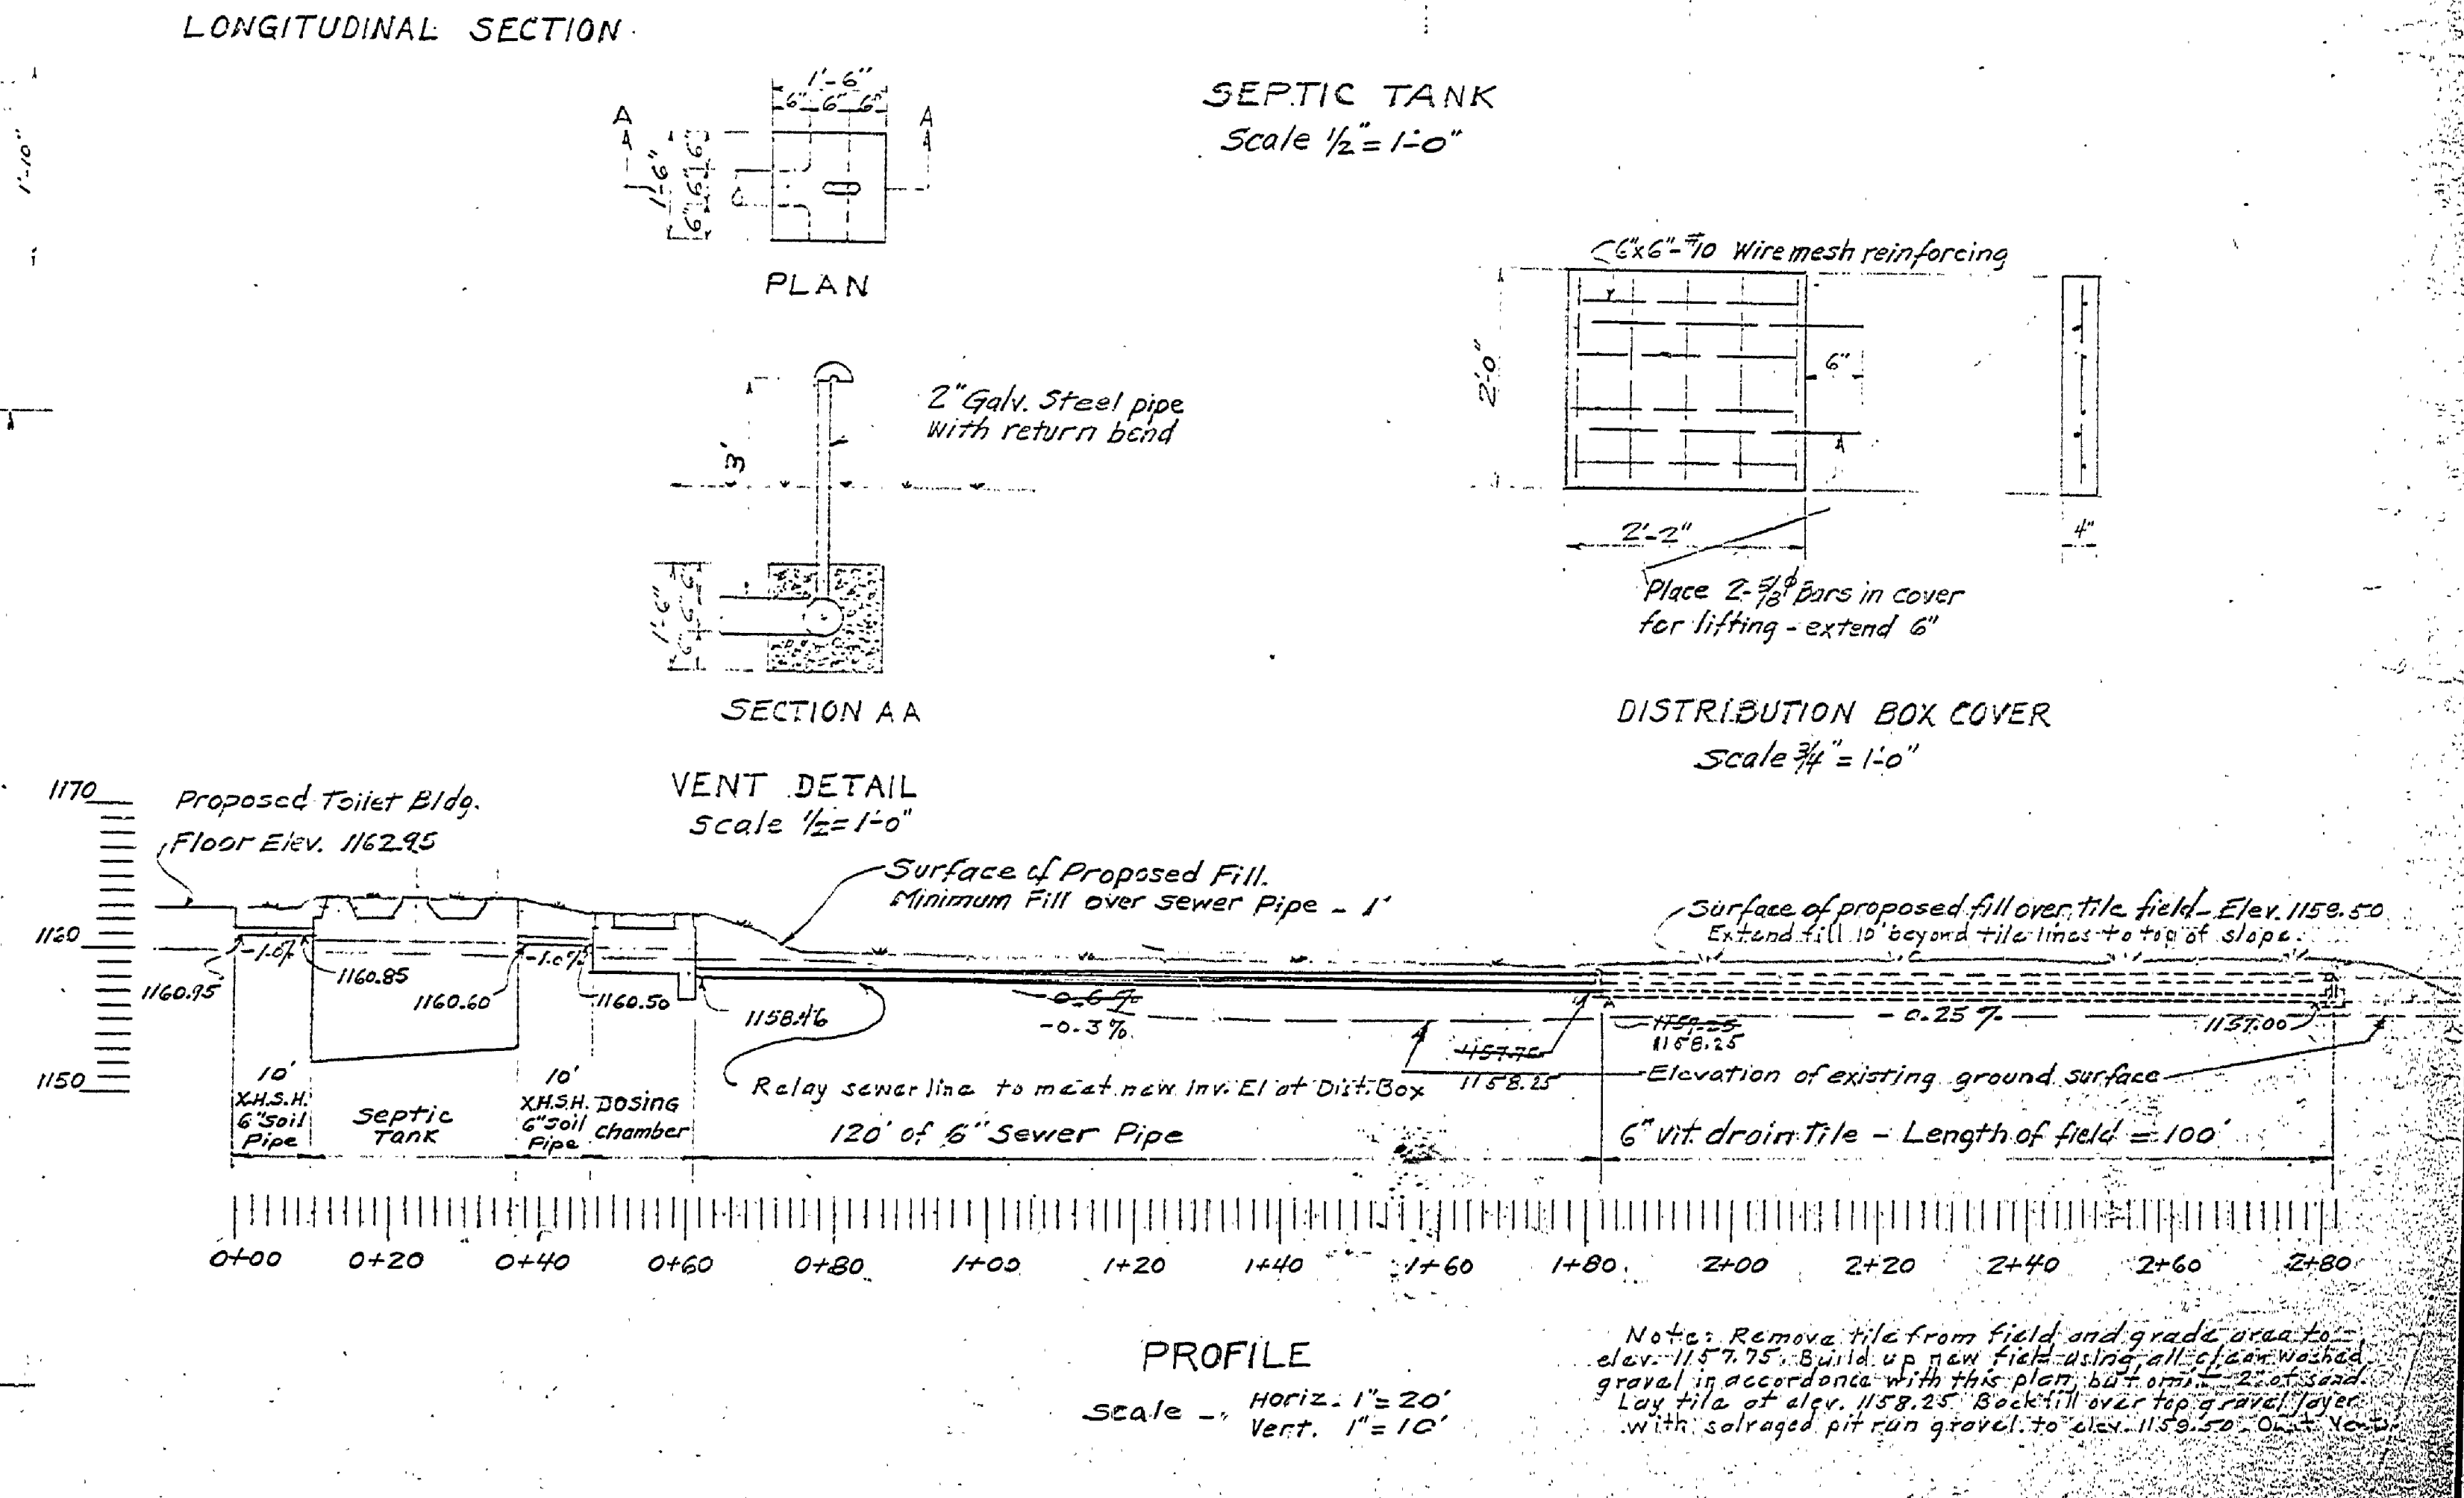
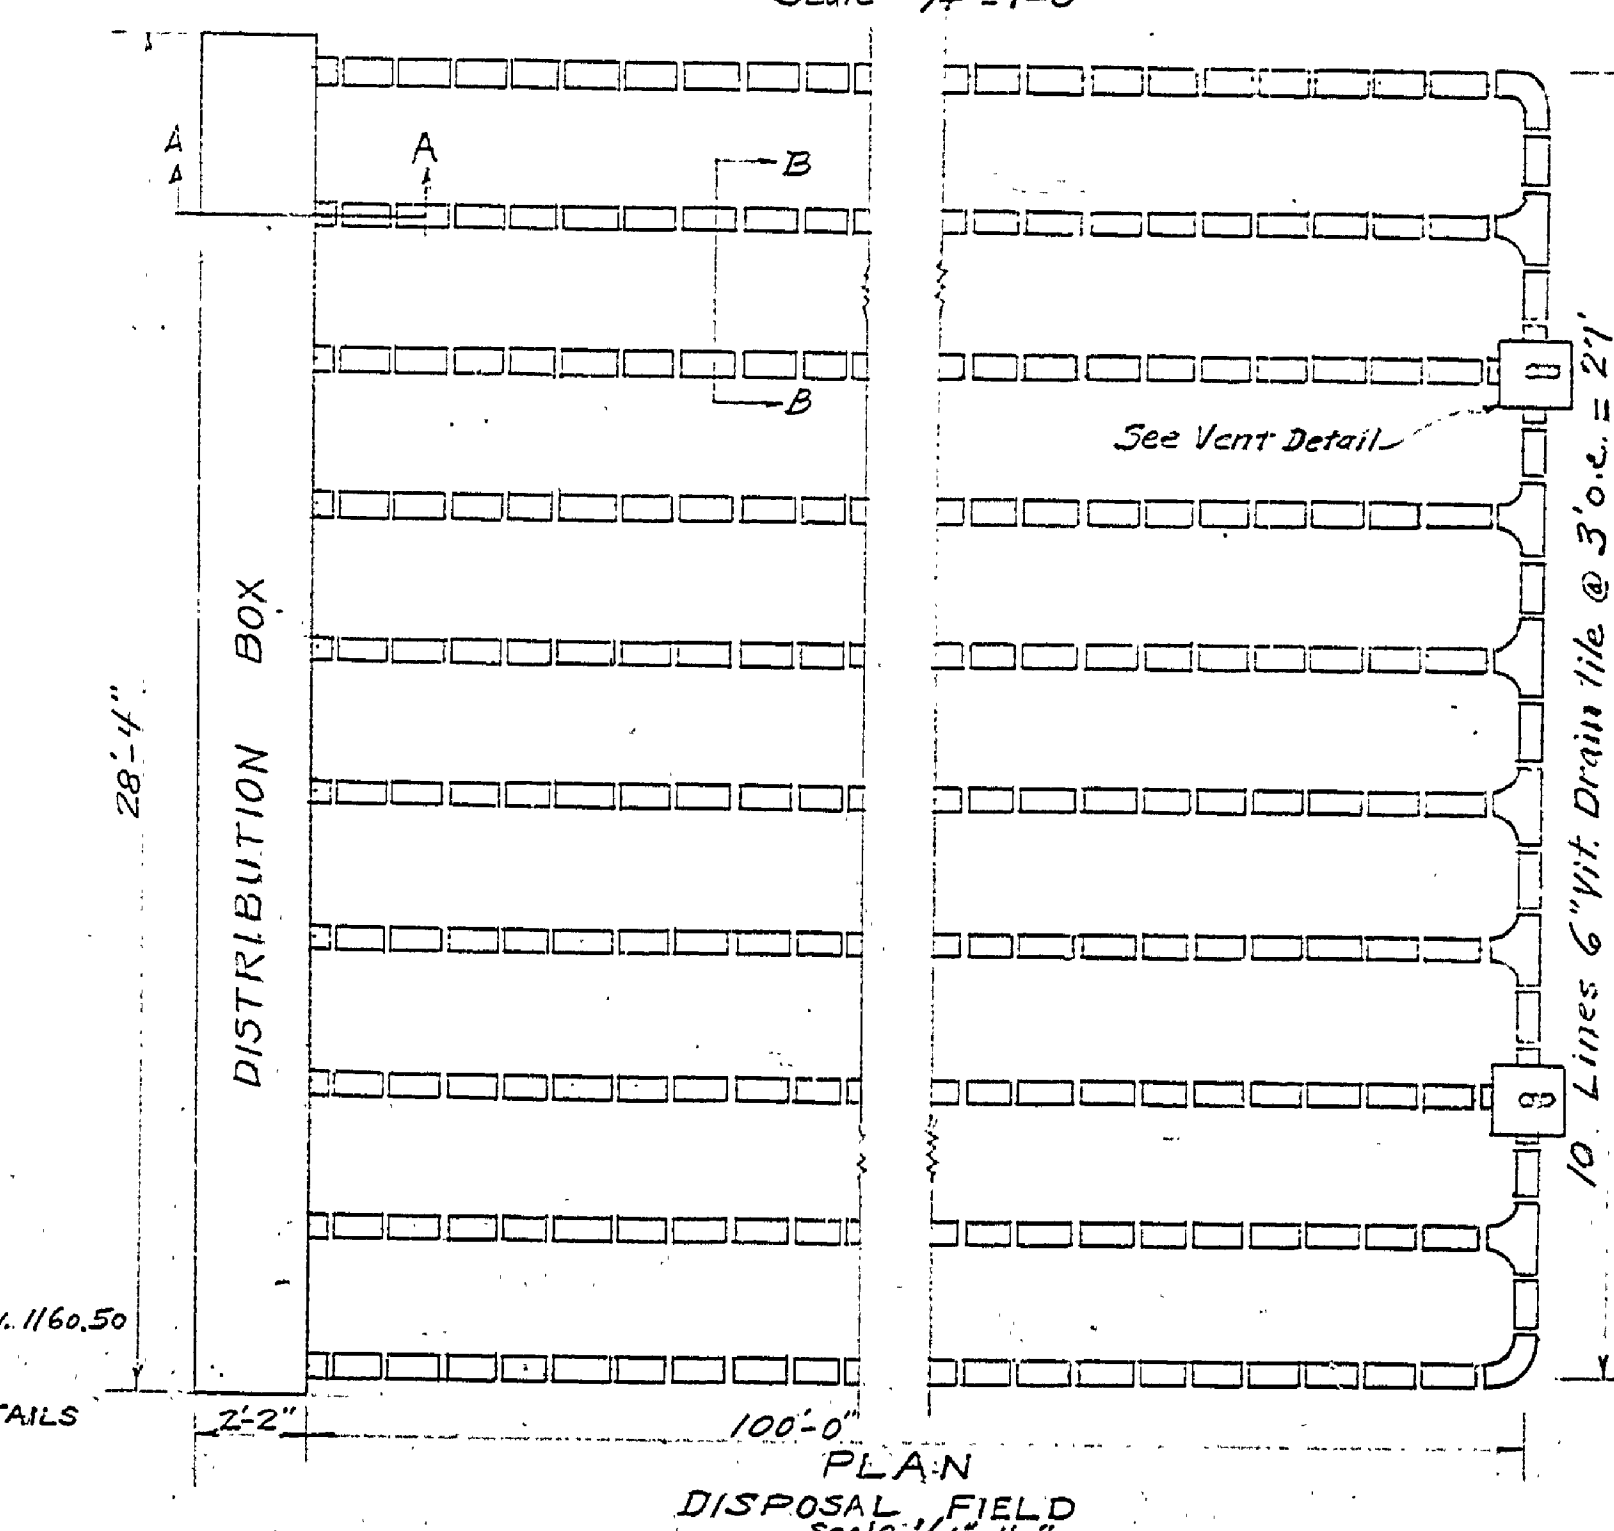
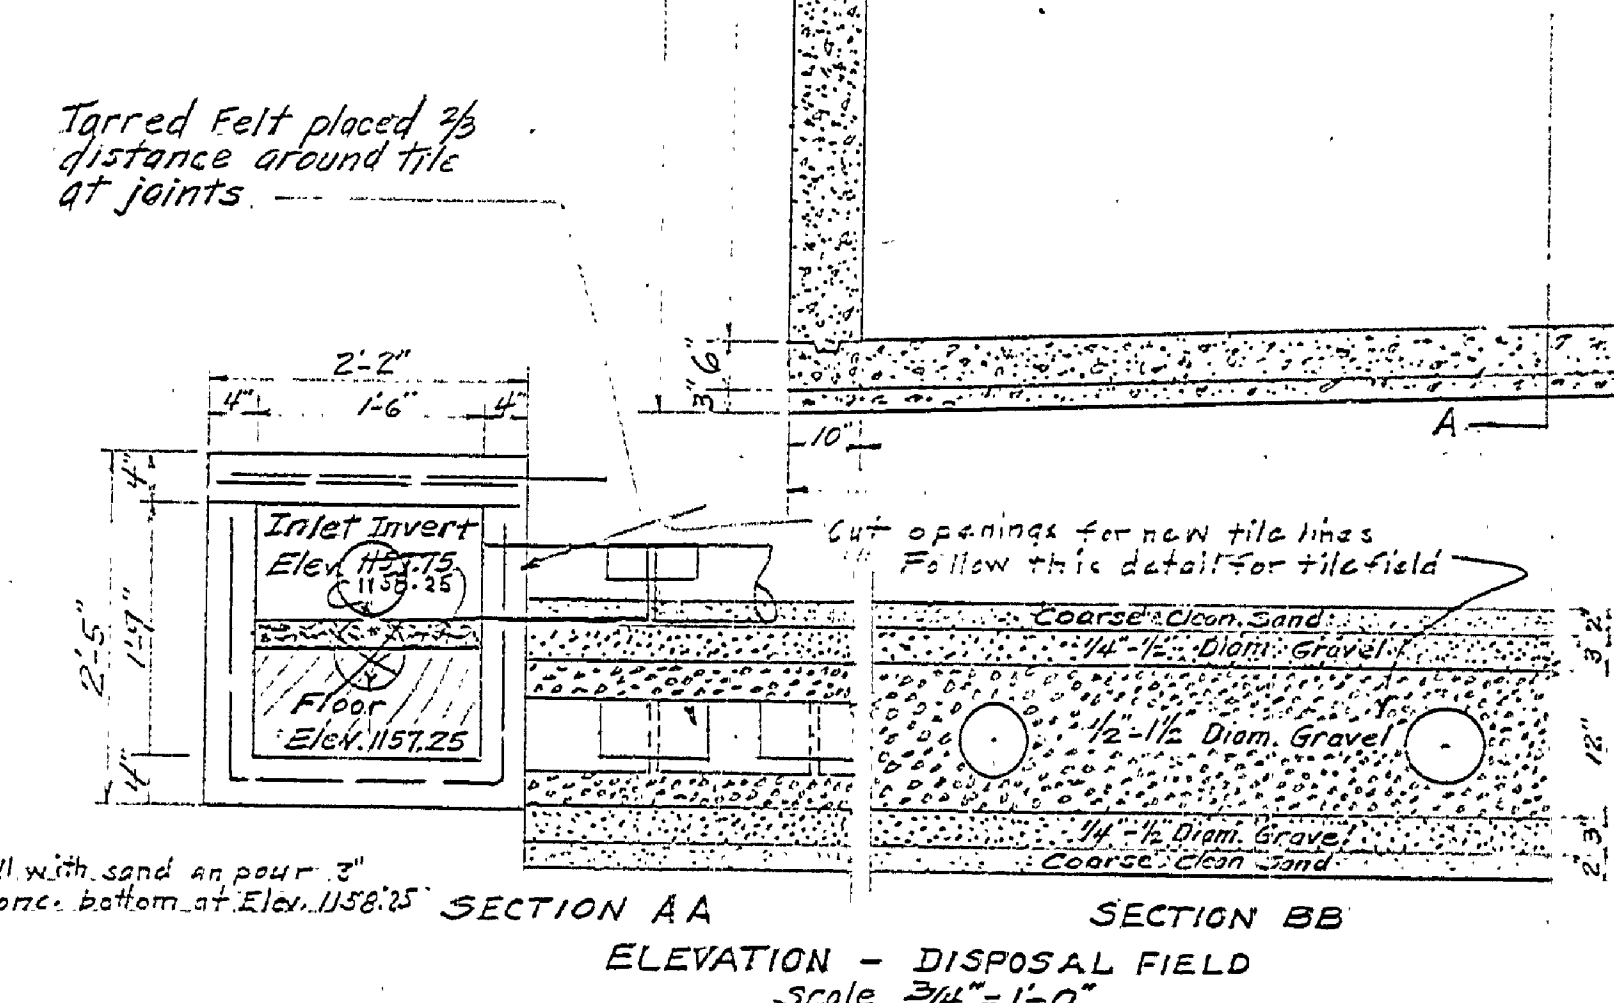



NO.	DATE	BY	REVISIONS
1	10-11-50	E.R.P.	Revised Tile Field
2			
3			
4			
5			
6			

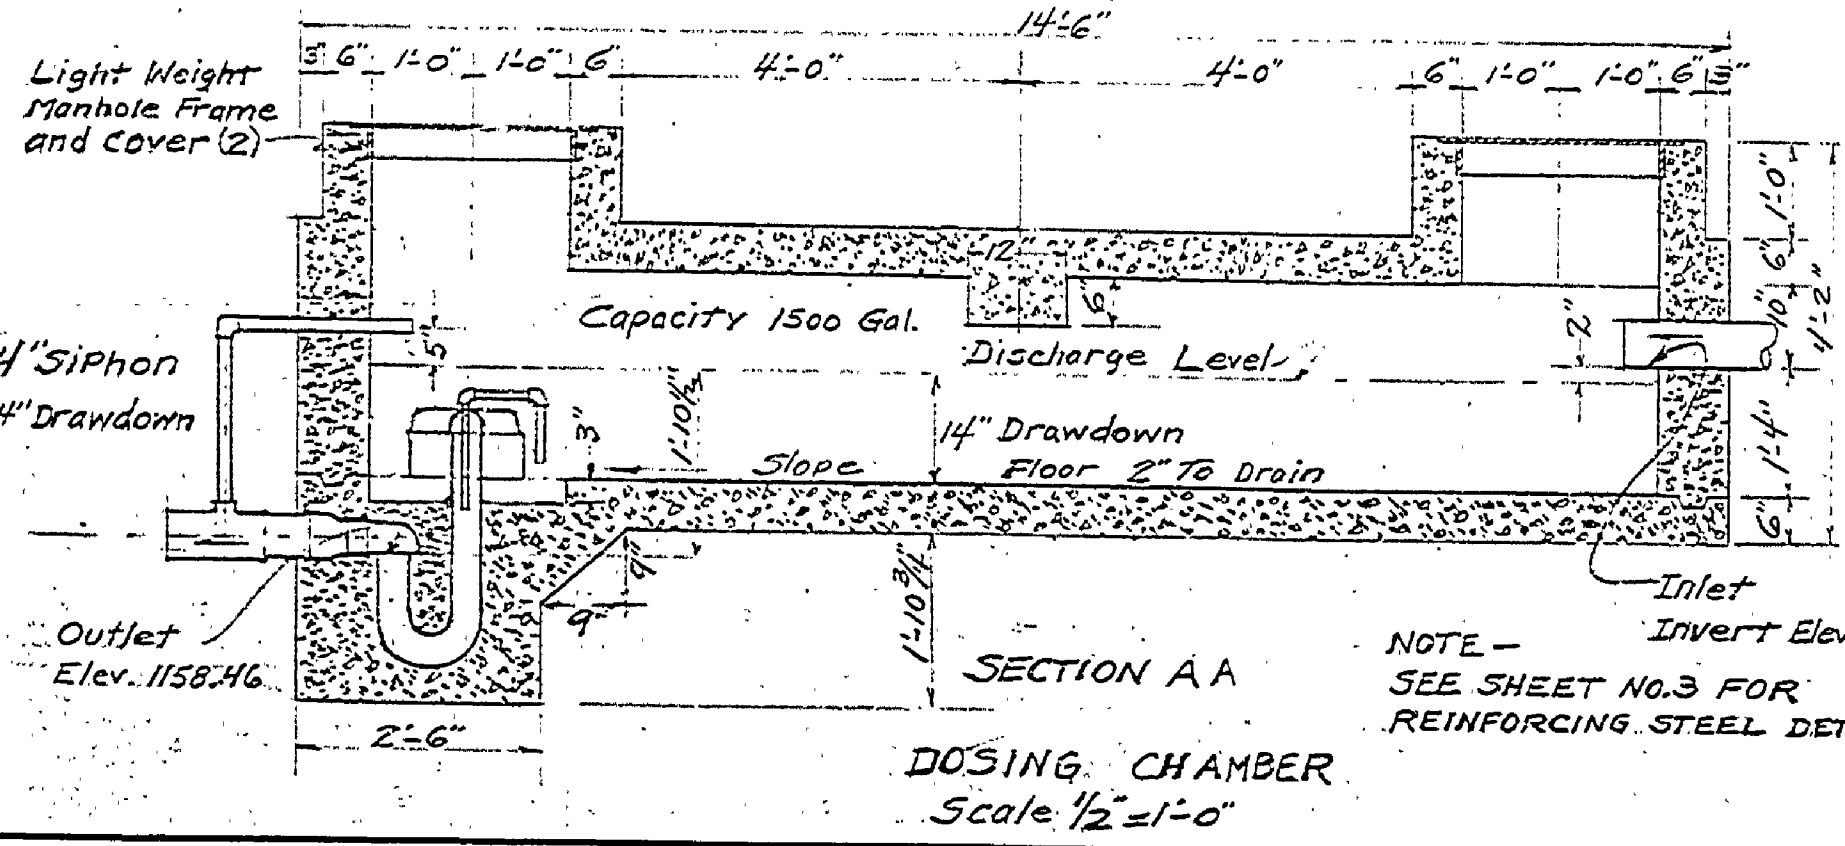

NOTE - SEE SHEET NO. 2 FOR REINFORCING STEEL DETAILS

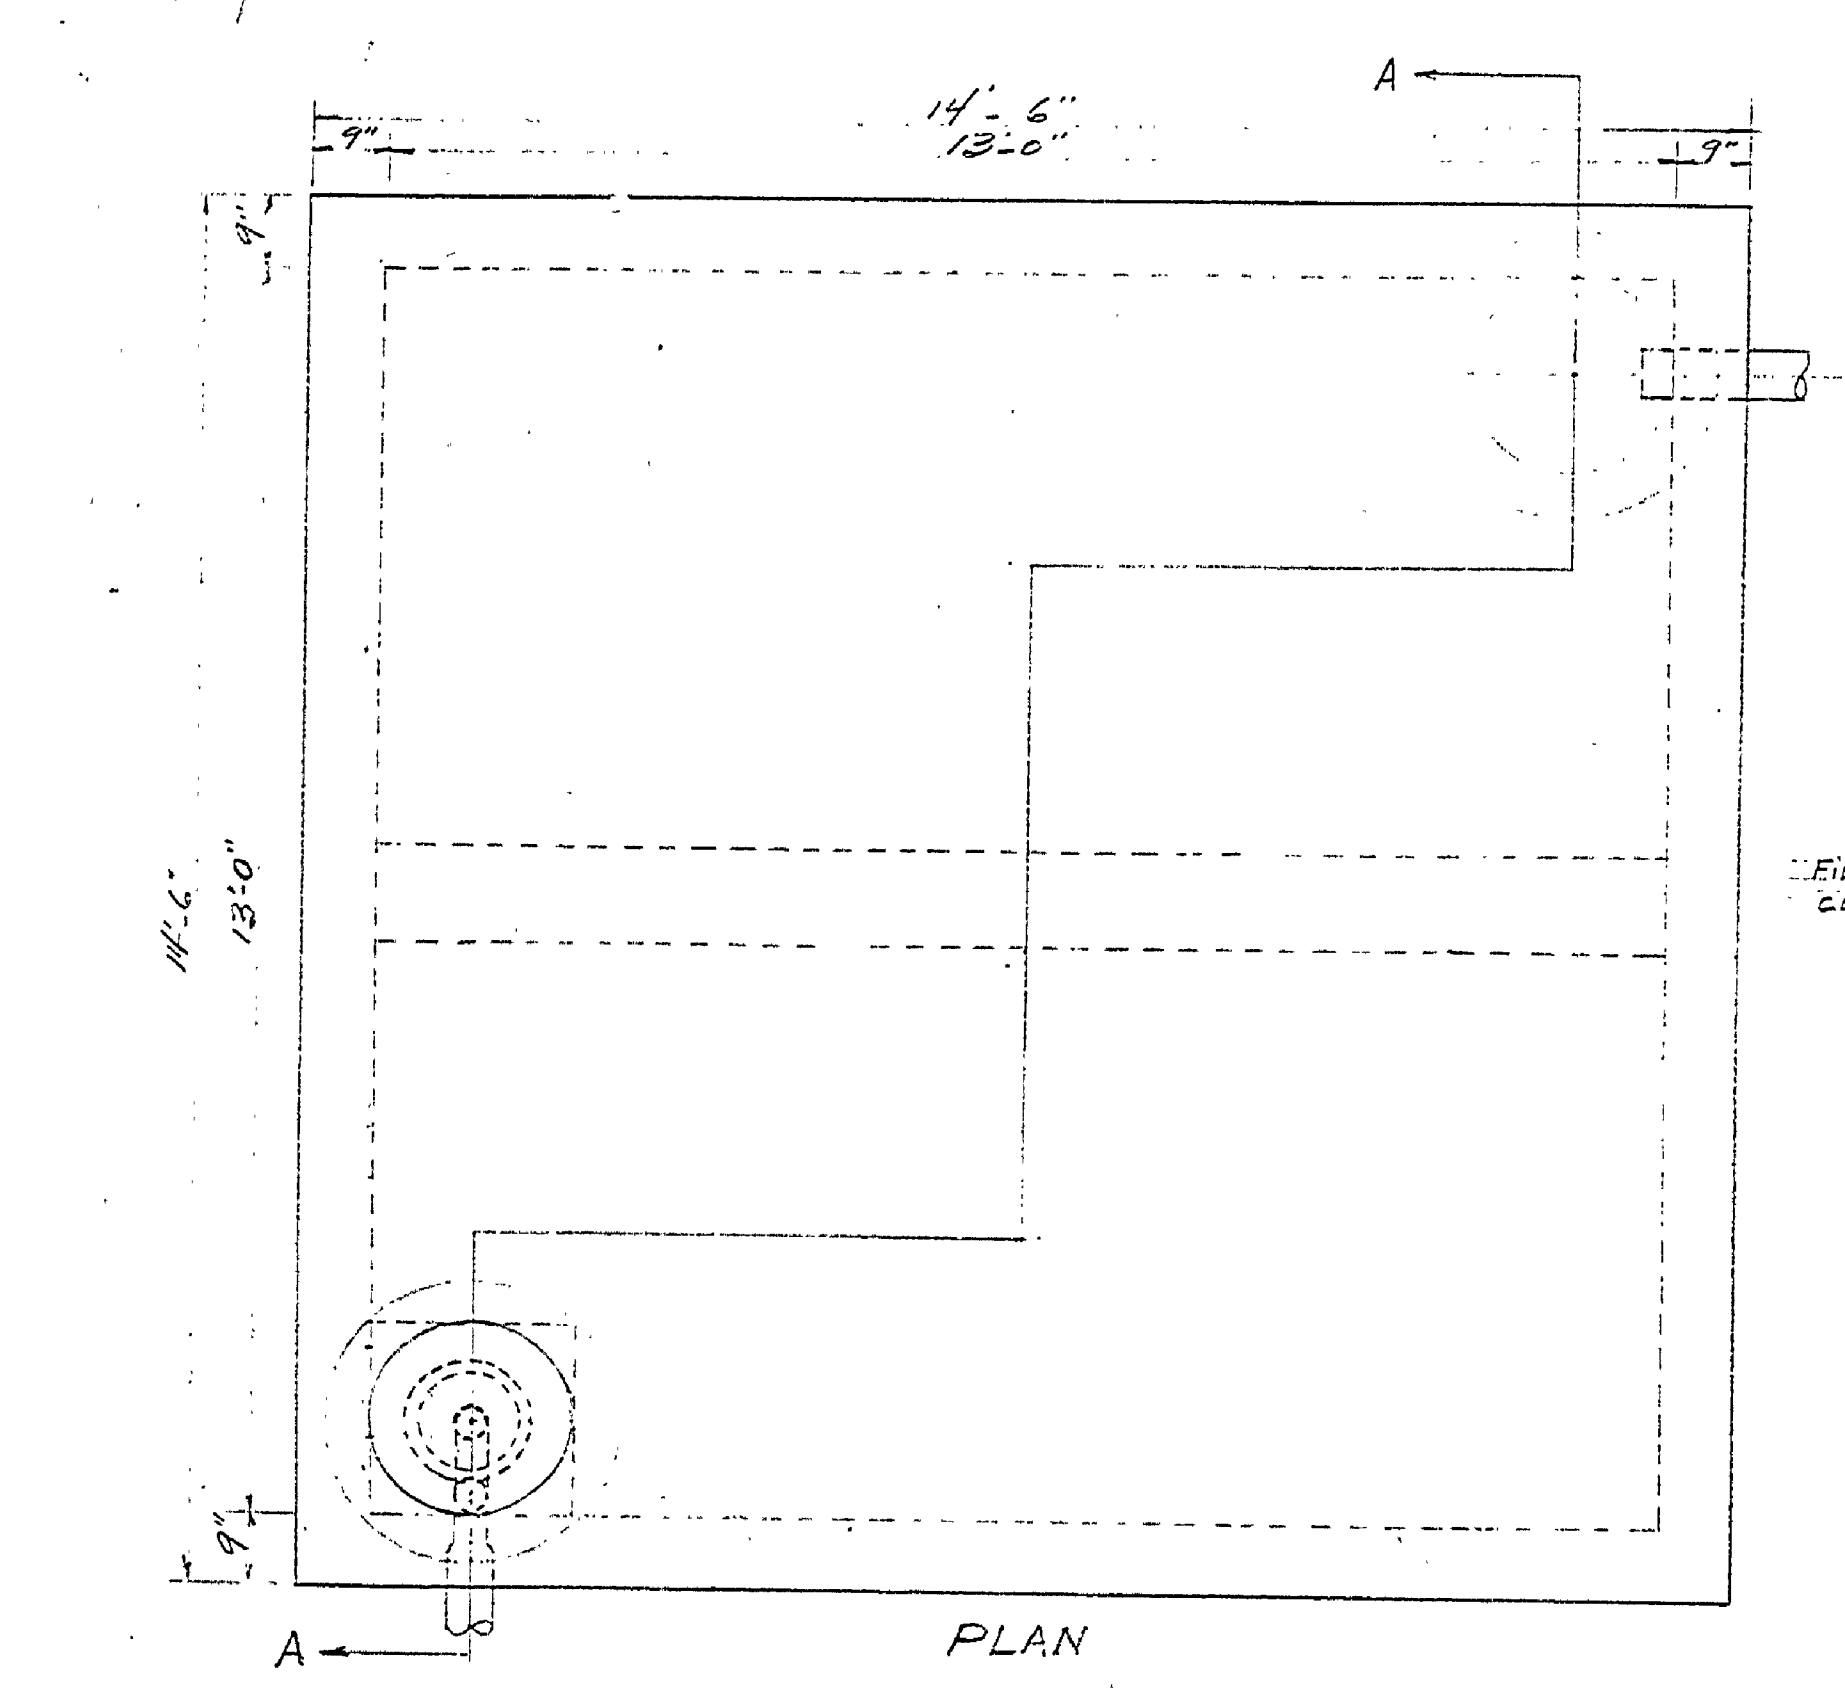

SEPTIC TANK Scale 1/2"=1'-0"

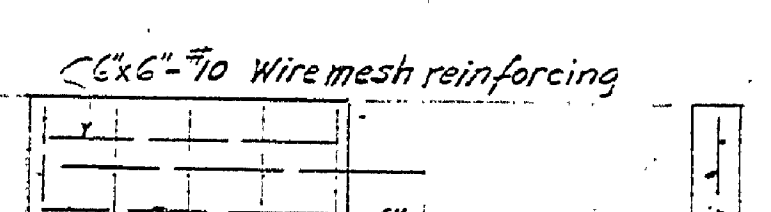

DISTRIBUTION BOX COVER Scale 3/4"=1'-0"



VENT DETAIL Scale 1/2"=1'-0"

CAMP GROUND TOILET-SHOWER-LAUNDRY BUILDING

MICHIGAN DEPARTMENT OF CONSERVATION PARKS AND RECREATION DIVISION

HIGGINS LAKE STATE PARK SEWAGE DISPOSAL SYSTEM SCALE - AS SHOWN

SHEET NO. 1 OF 3	PLAN NO. E-102
------------------	----------------