


DATE	BY	REVISIONS
4 Dec. 1961	E.S.D.	1 This system abandoned See E-10
		2 Systems left in place
		3
		4
		5
		6


NO.	DATE	BY
1	1-1-57	J.R.
2	3-20-57	H.C.H.
3	1-3-57	V.F.R.

APPROVED BY	DATE	REVIEWED BY SECTIONS
<i>[Signature]</i>	1-1-57	ARCHITECTURAL
ASSISTANT CHIEF IN CHARGE	3-20-57	ENGINEERING
OF DESIGN	1-3-57	LANDSCAPE

DRAWN BY	DATE
B.D.S.	4 Dec. 1961
CHECKED BY	
E. J. P.	

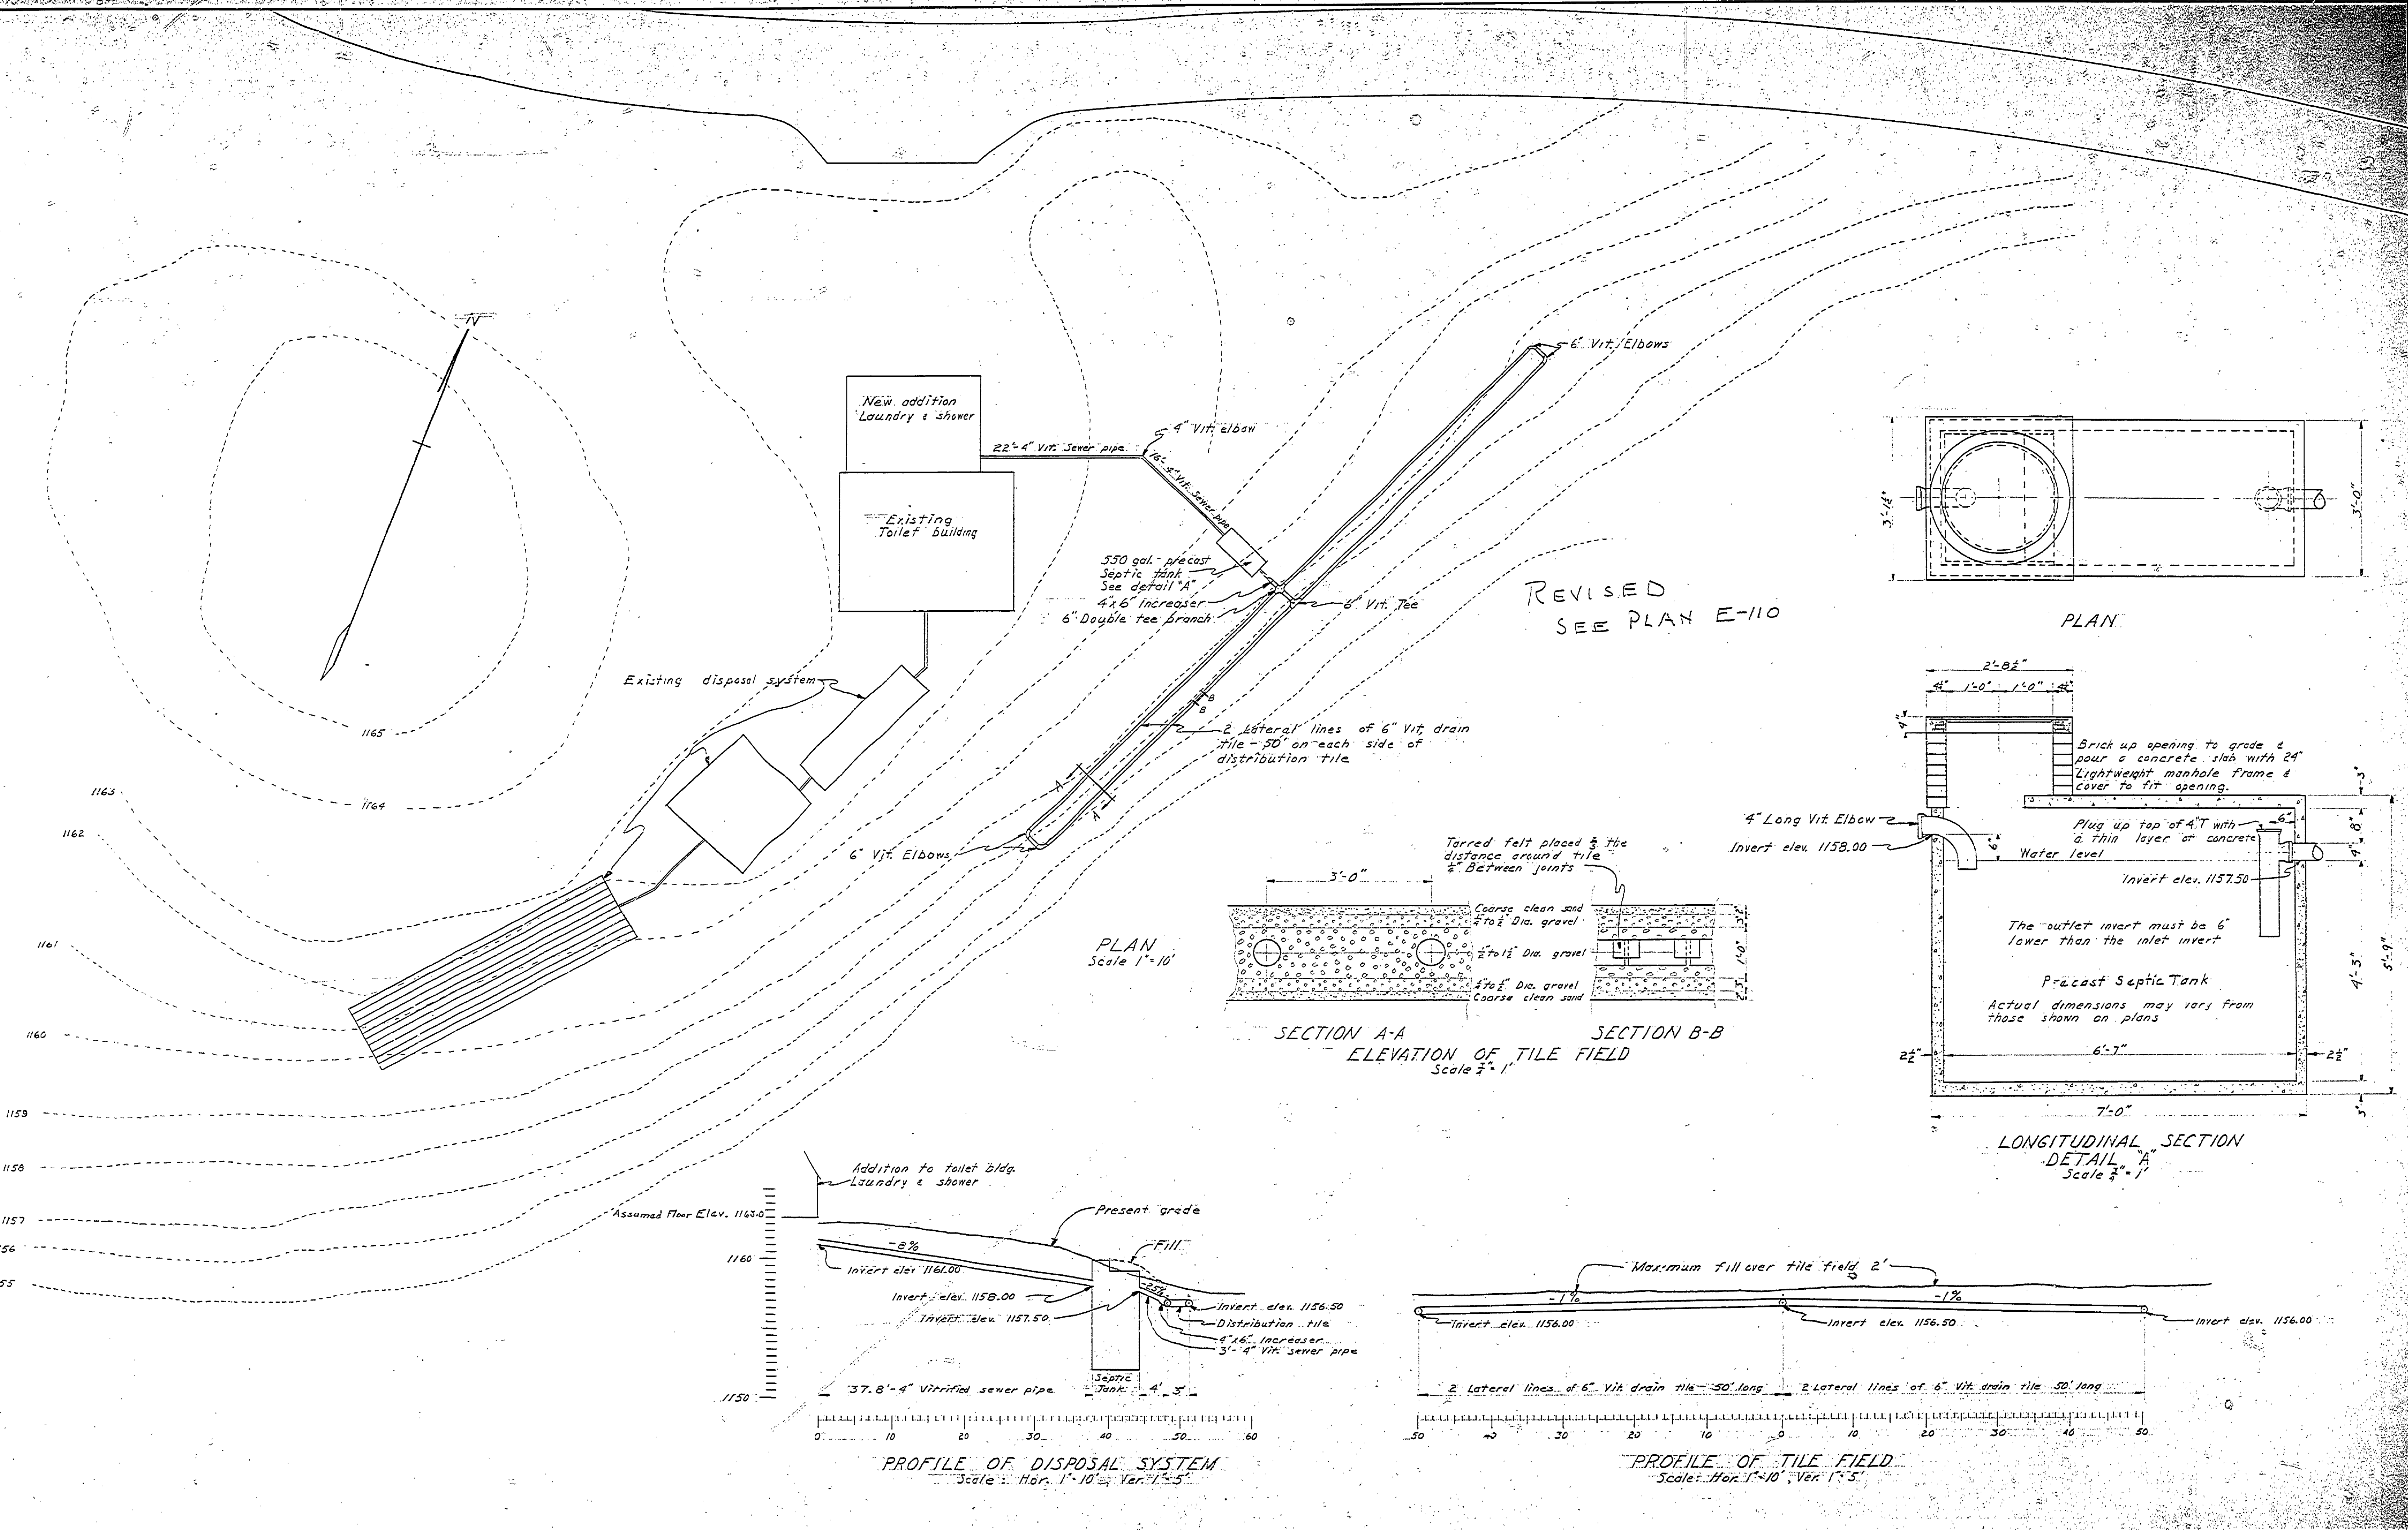

PLAN
Scale 1"=10'

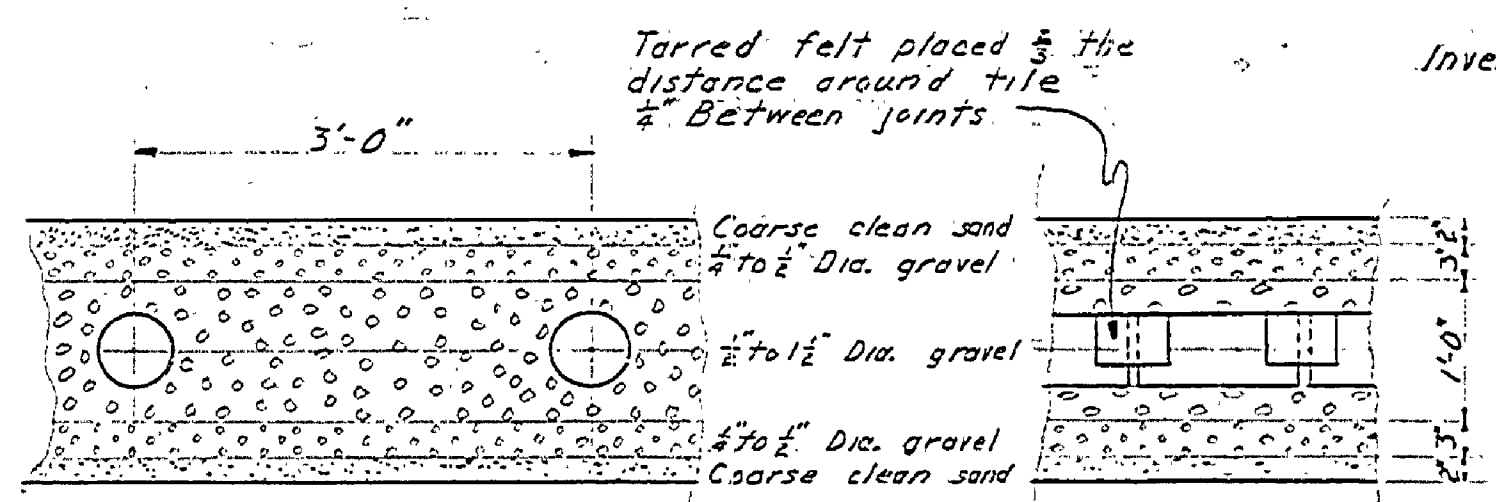

SECTION B-B
ELEVATION OF TILE FIELD
Scale 3/4"=1'

