
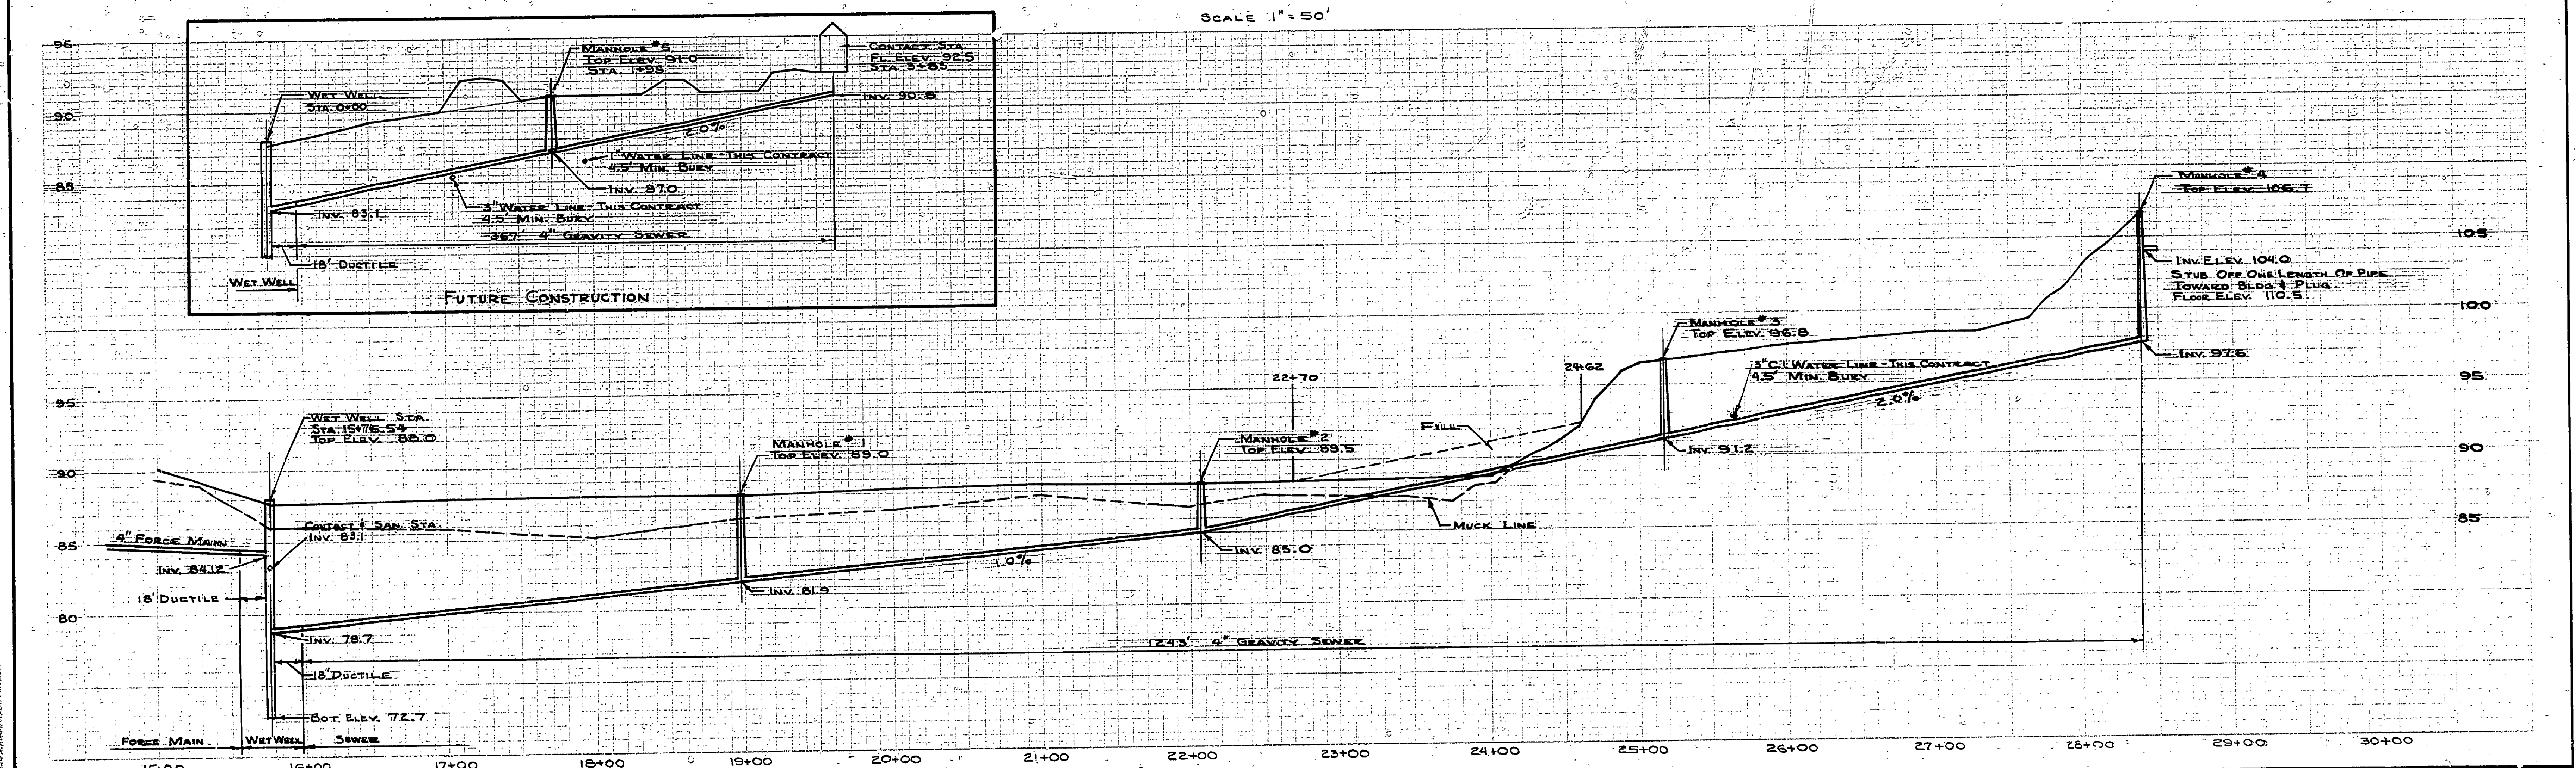


NOV. 2, 1969  
 ELEV. 86.89  
 15' 0" DIA. 15' 0" STA. 23+58  
 CAMPBELL ROAD

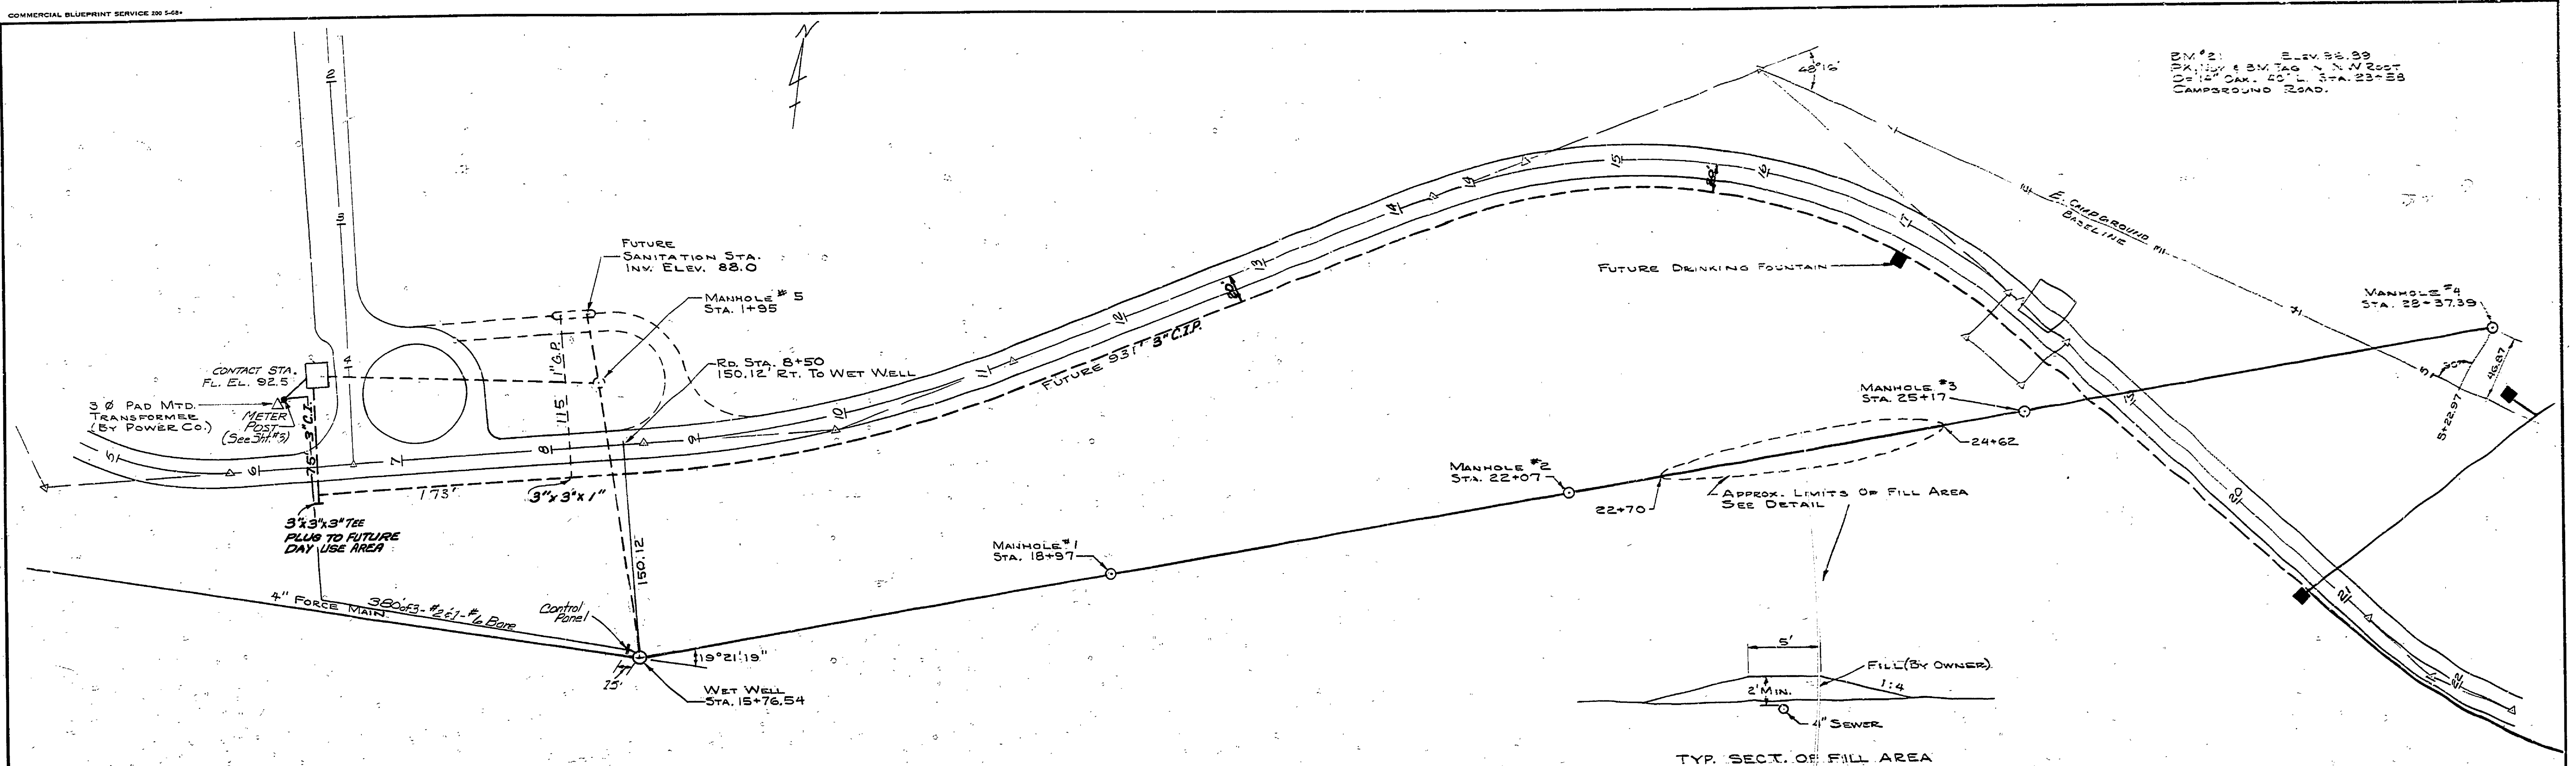

SURVEYED BY V. McCANN	DESIGNED BY H. McRELL	8-69	CHECKED BY	DATE	NO.	DATE	BY	REVISIONS	NO.	DATE	BY	REVISIONS	MICHIGAN DEPARTMENT OF CONSERVATION	GRAVITY SEWER & WATER SYSTEM	SHEET NO. OF FOR PROJECT NO. 0108	HIGGINS LAKE NORTH SHEET 6 OF 10 PLAN NO. E-104
					1.	6-70	RHM	REVISED WET WELL ELECTRICAL	3.							
					2.				4.							